

[illegible]

BRYAN MILLER
 REGISTERED
No.
PE1200386
 STATE OF
 INDIANA
 PROFESSIONAL ENGINEER

REPRESENTS AS A RETRACEMENT OR
 ORIGINAL BOUNDARY SURVEY, A ROLITH
 SURVEY OR A SURVEYOR LOCATION
 REPORT.

CERTIFIED: 04/04/25


THIS DRAWING IS NOT INTENDED TO BE REPRESENTED AS A RETRACEMENT OR ORIGINAL BOUNDARY SURVEY, A ROUTE SURVEY OR A SURVEYOR LOCATION REPORT.

STOEPPELWERTH

1965 East 106th Street, Fishers, IN 46038-2505
phone: 317.849.5935 fax: 317.849.5942

MADISON COUNTY, INDIANA

SANITARY SEWER PLAN & PROFILES

CORRIE SPRINGS




SECTION 1

MADISON COUNTY, INDIANA

INGALLS



DRAWN BY: RPL	CHECKED BY: KRG
------------------	--------------------

C501
S & A JOB NO.
104869FOR-S1

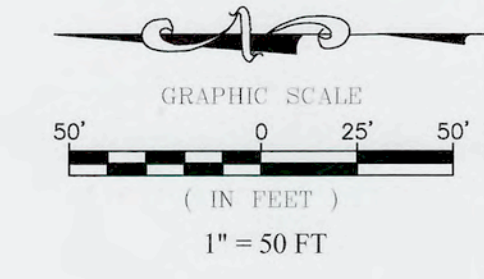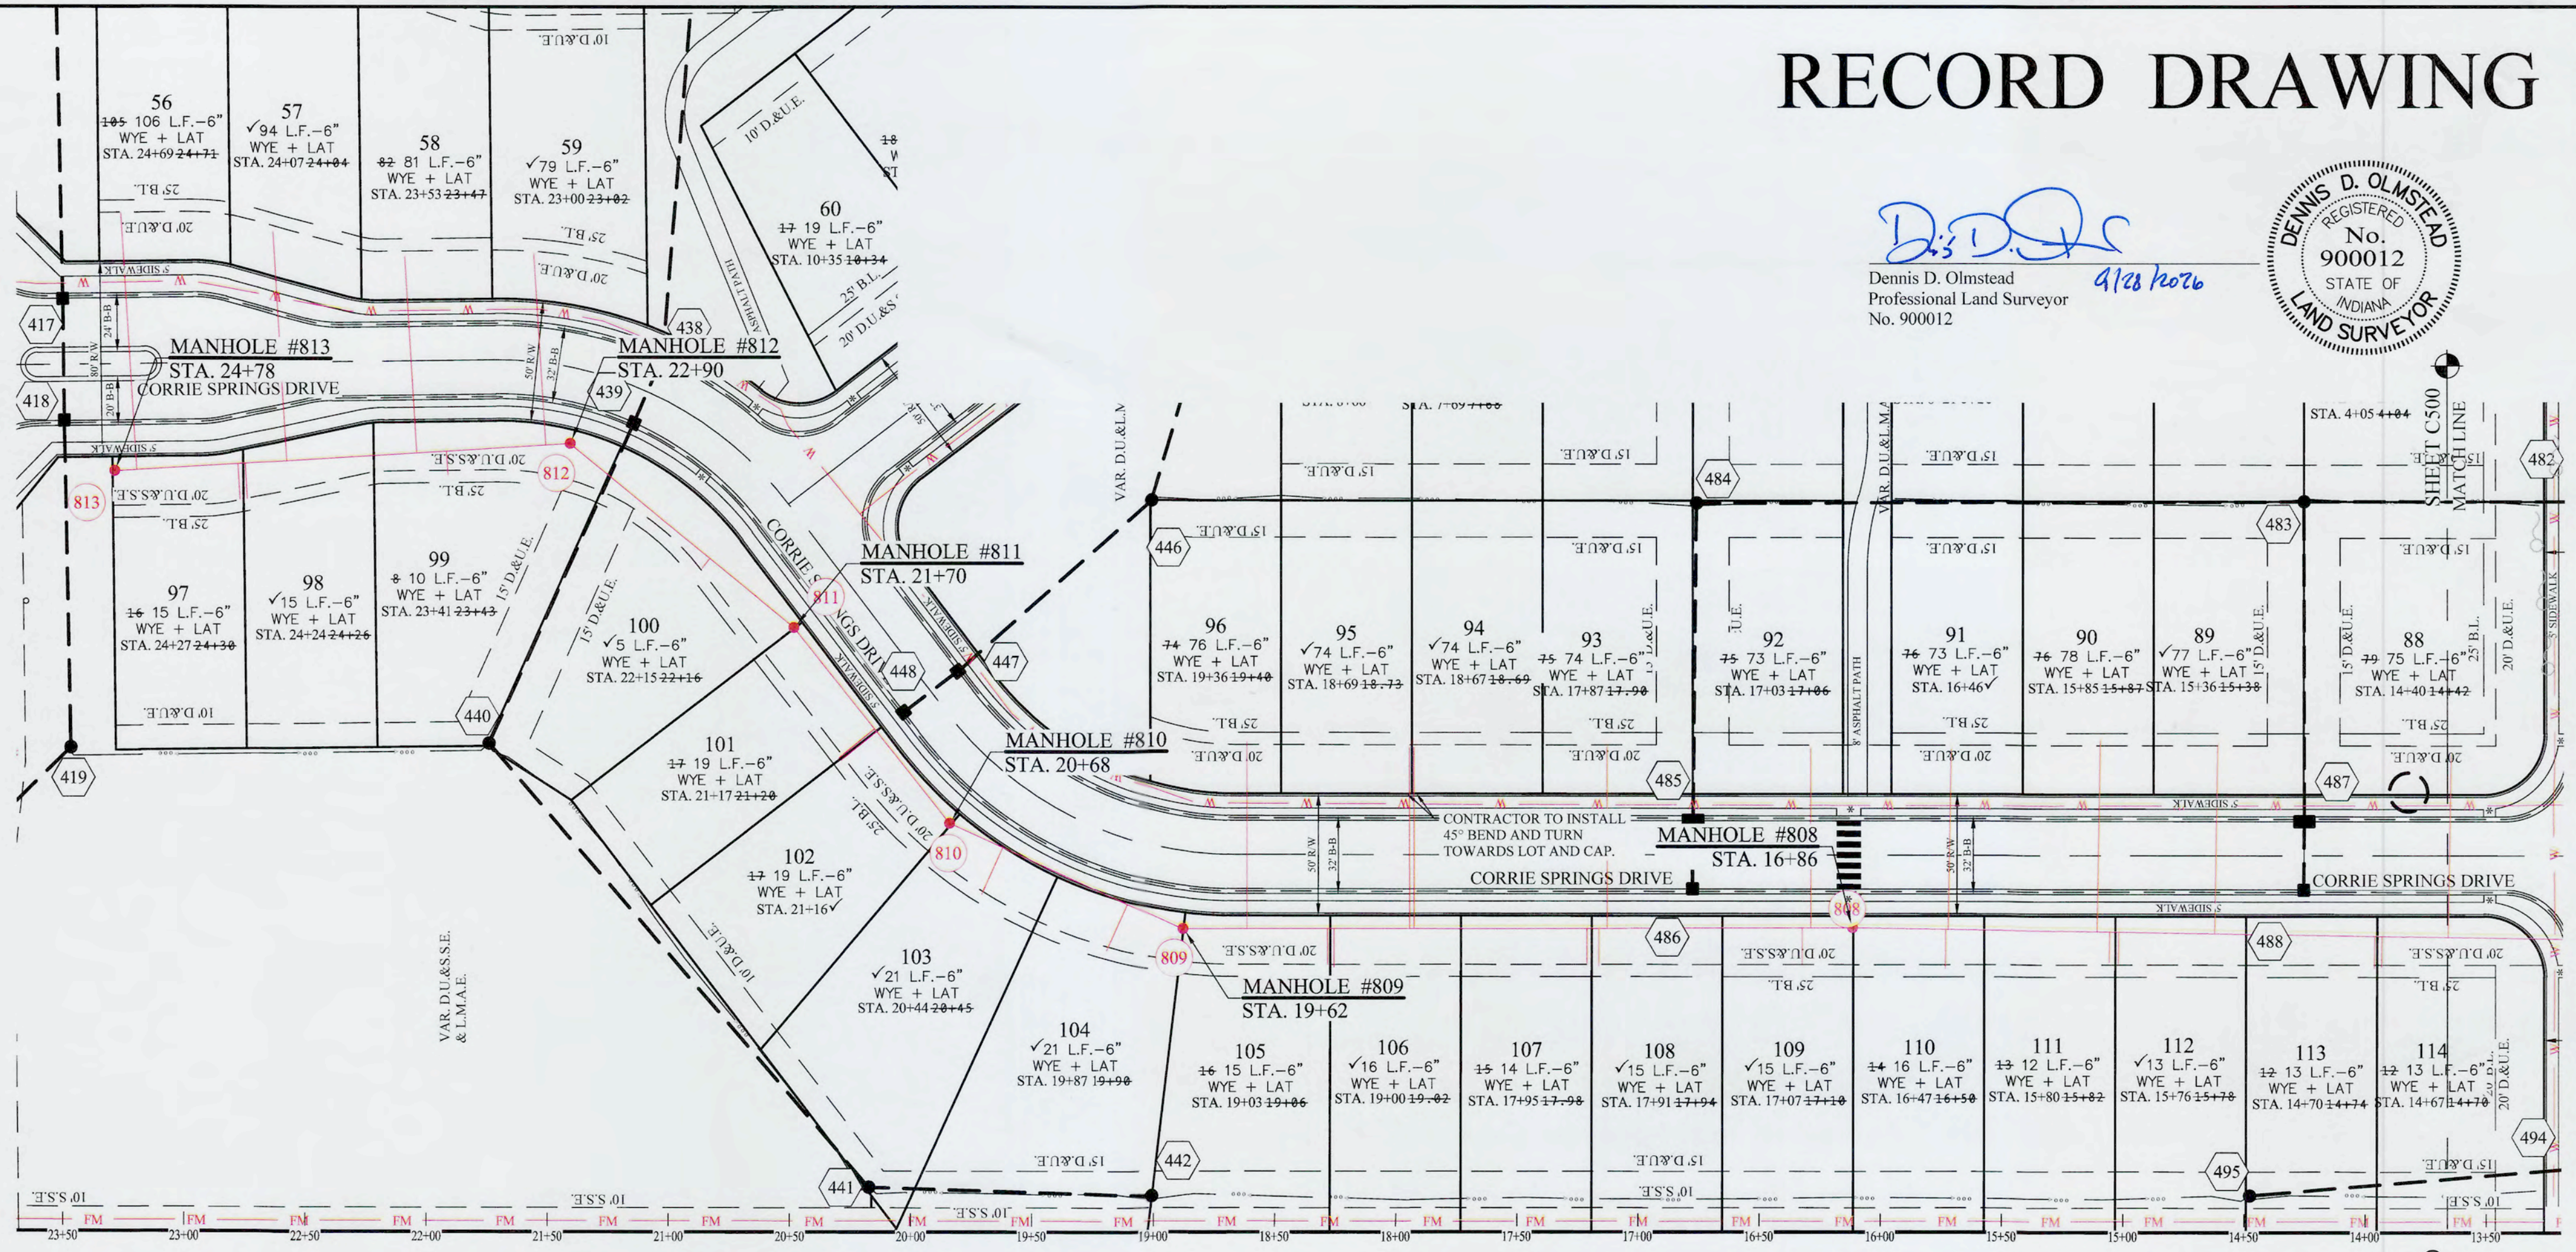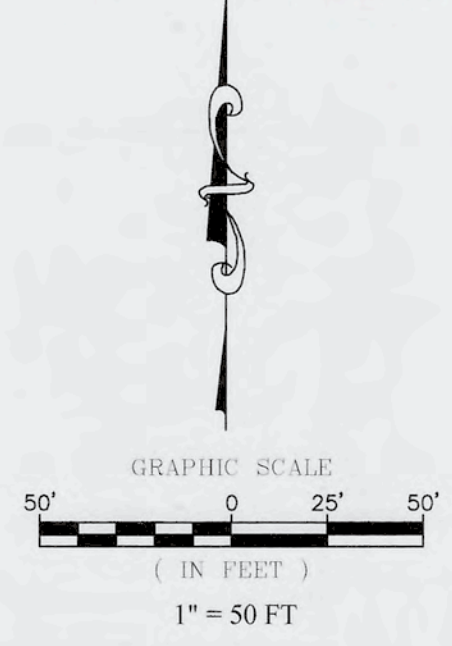

SHEET C500
MATCH LINE

 SHEET C500
MATCH LINE

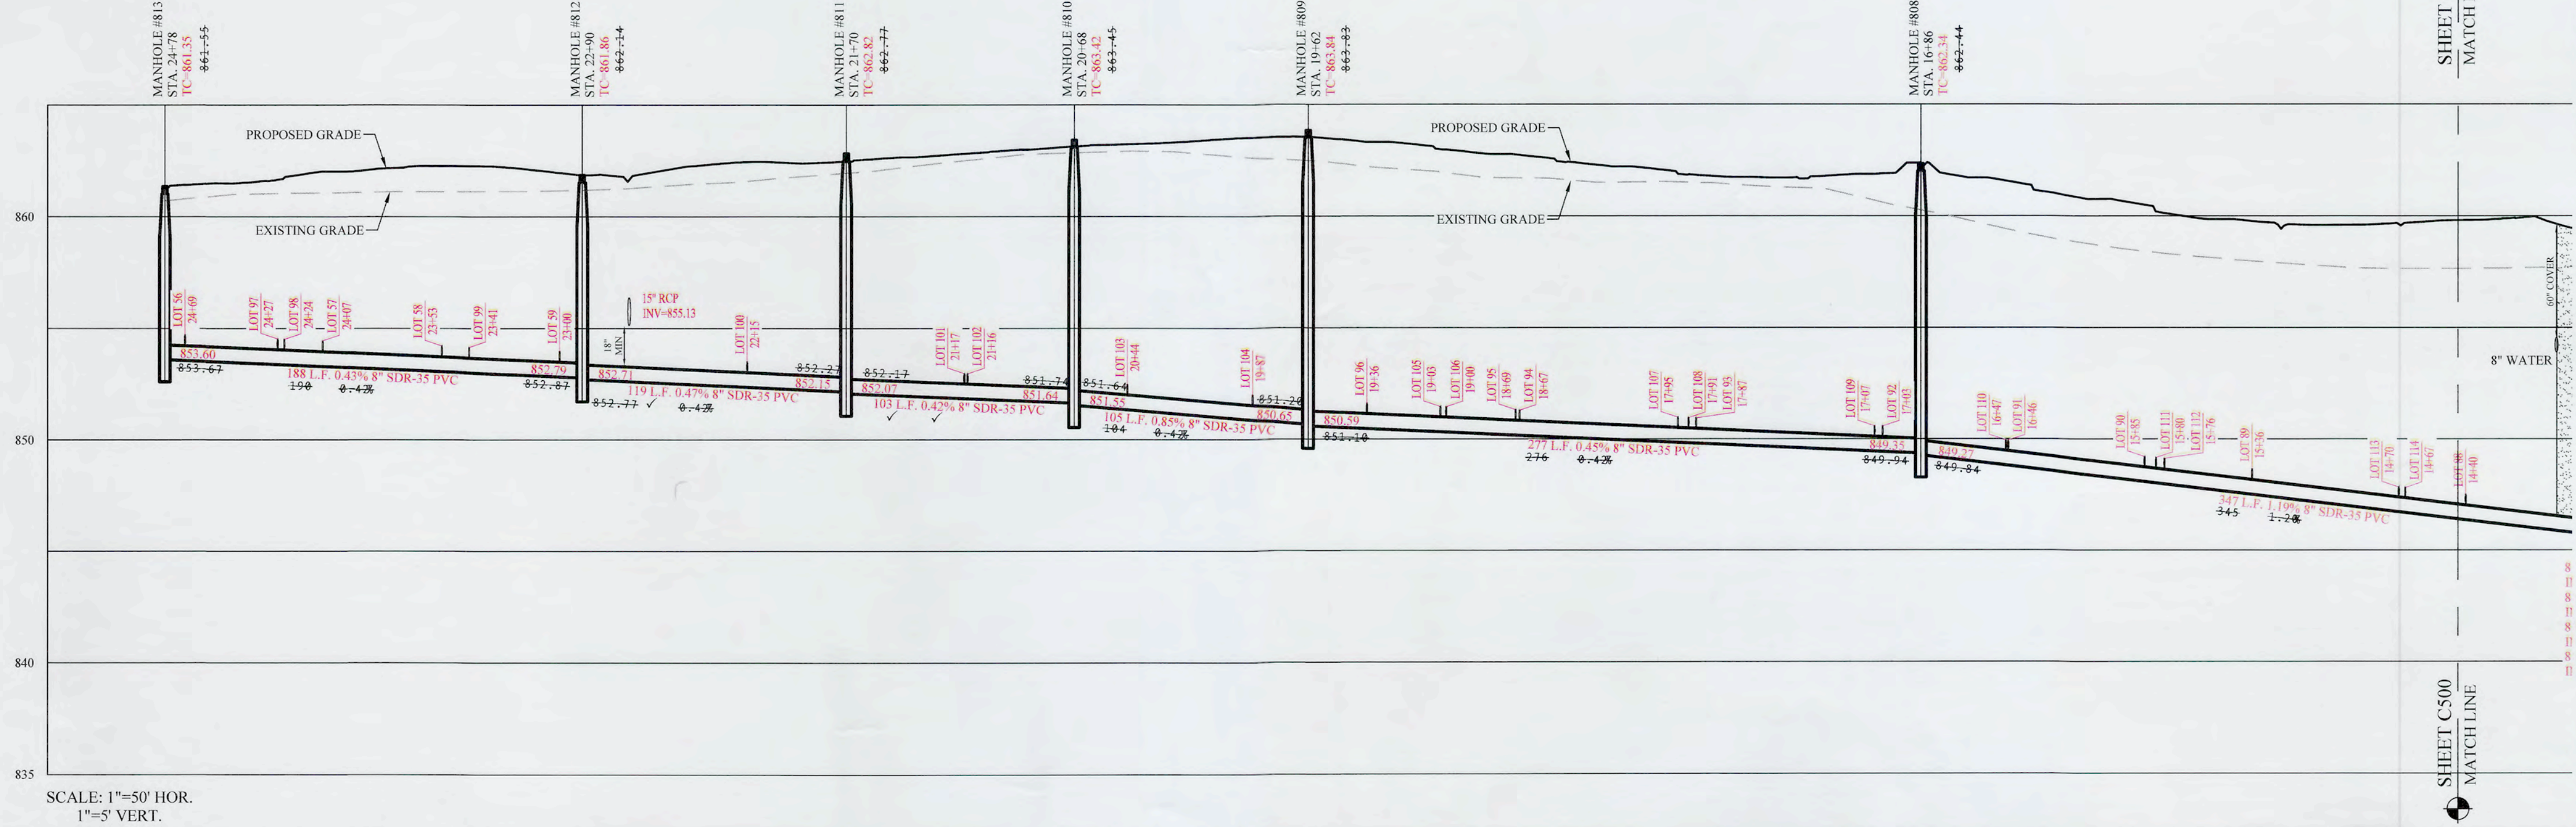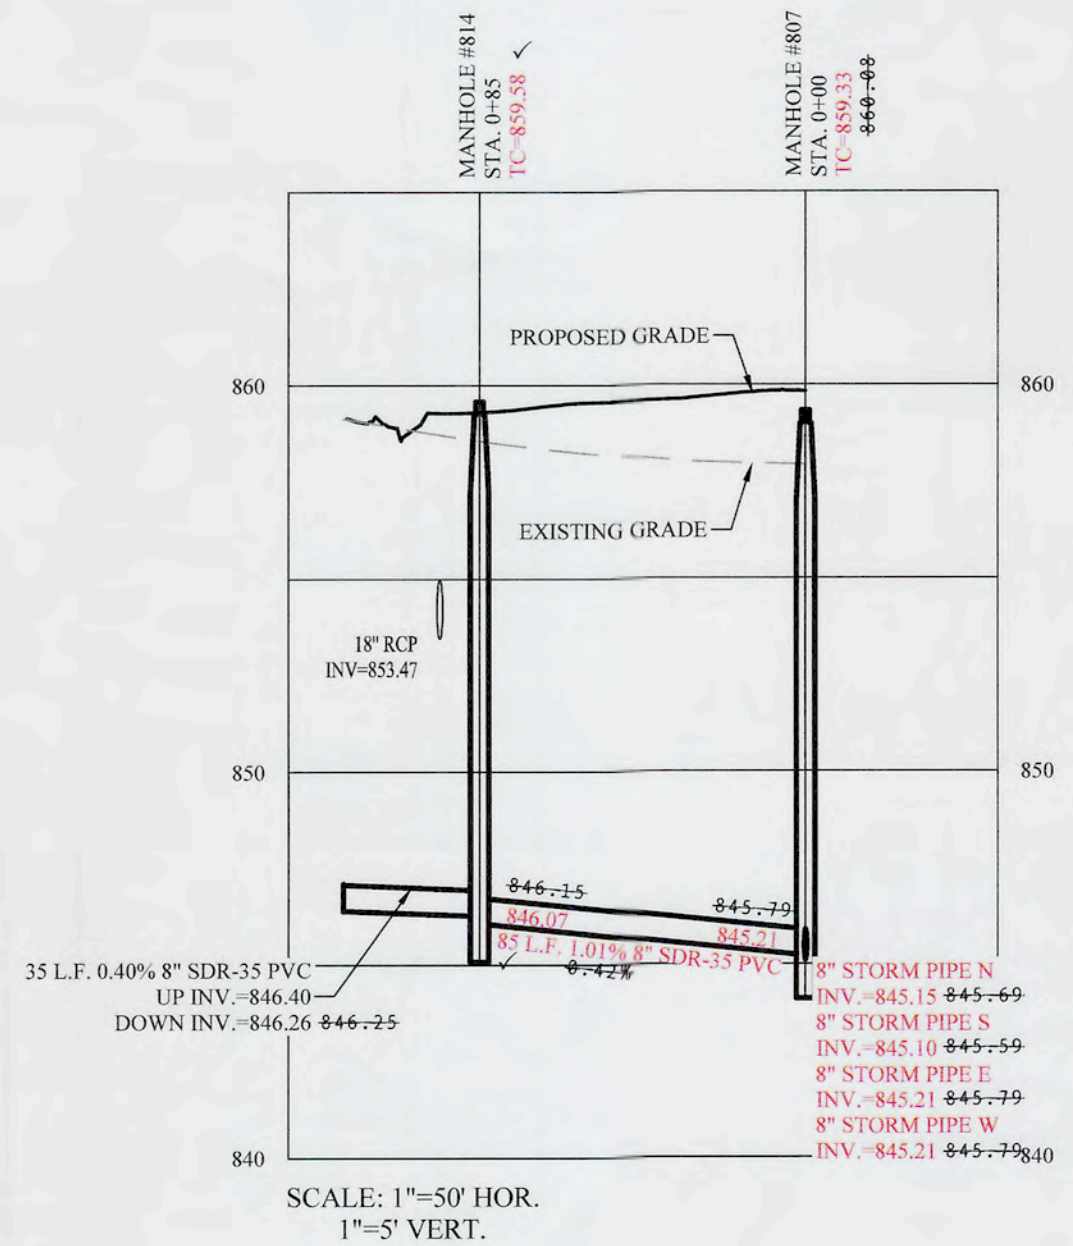

File Name: S:\104869\FOR-S1\DWG\500 - Sanitary Plan & Profile.dwg - C501
Modified / By: September 28, 2026 12:50:37 PM / meavans
Plotted / By: September 28, 2026 12:51:22 PM / Michael Evans