


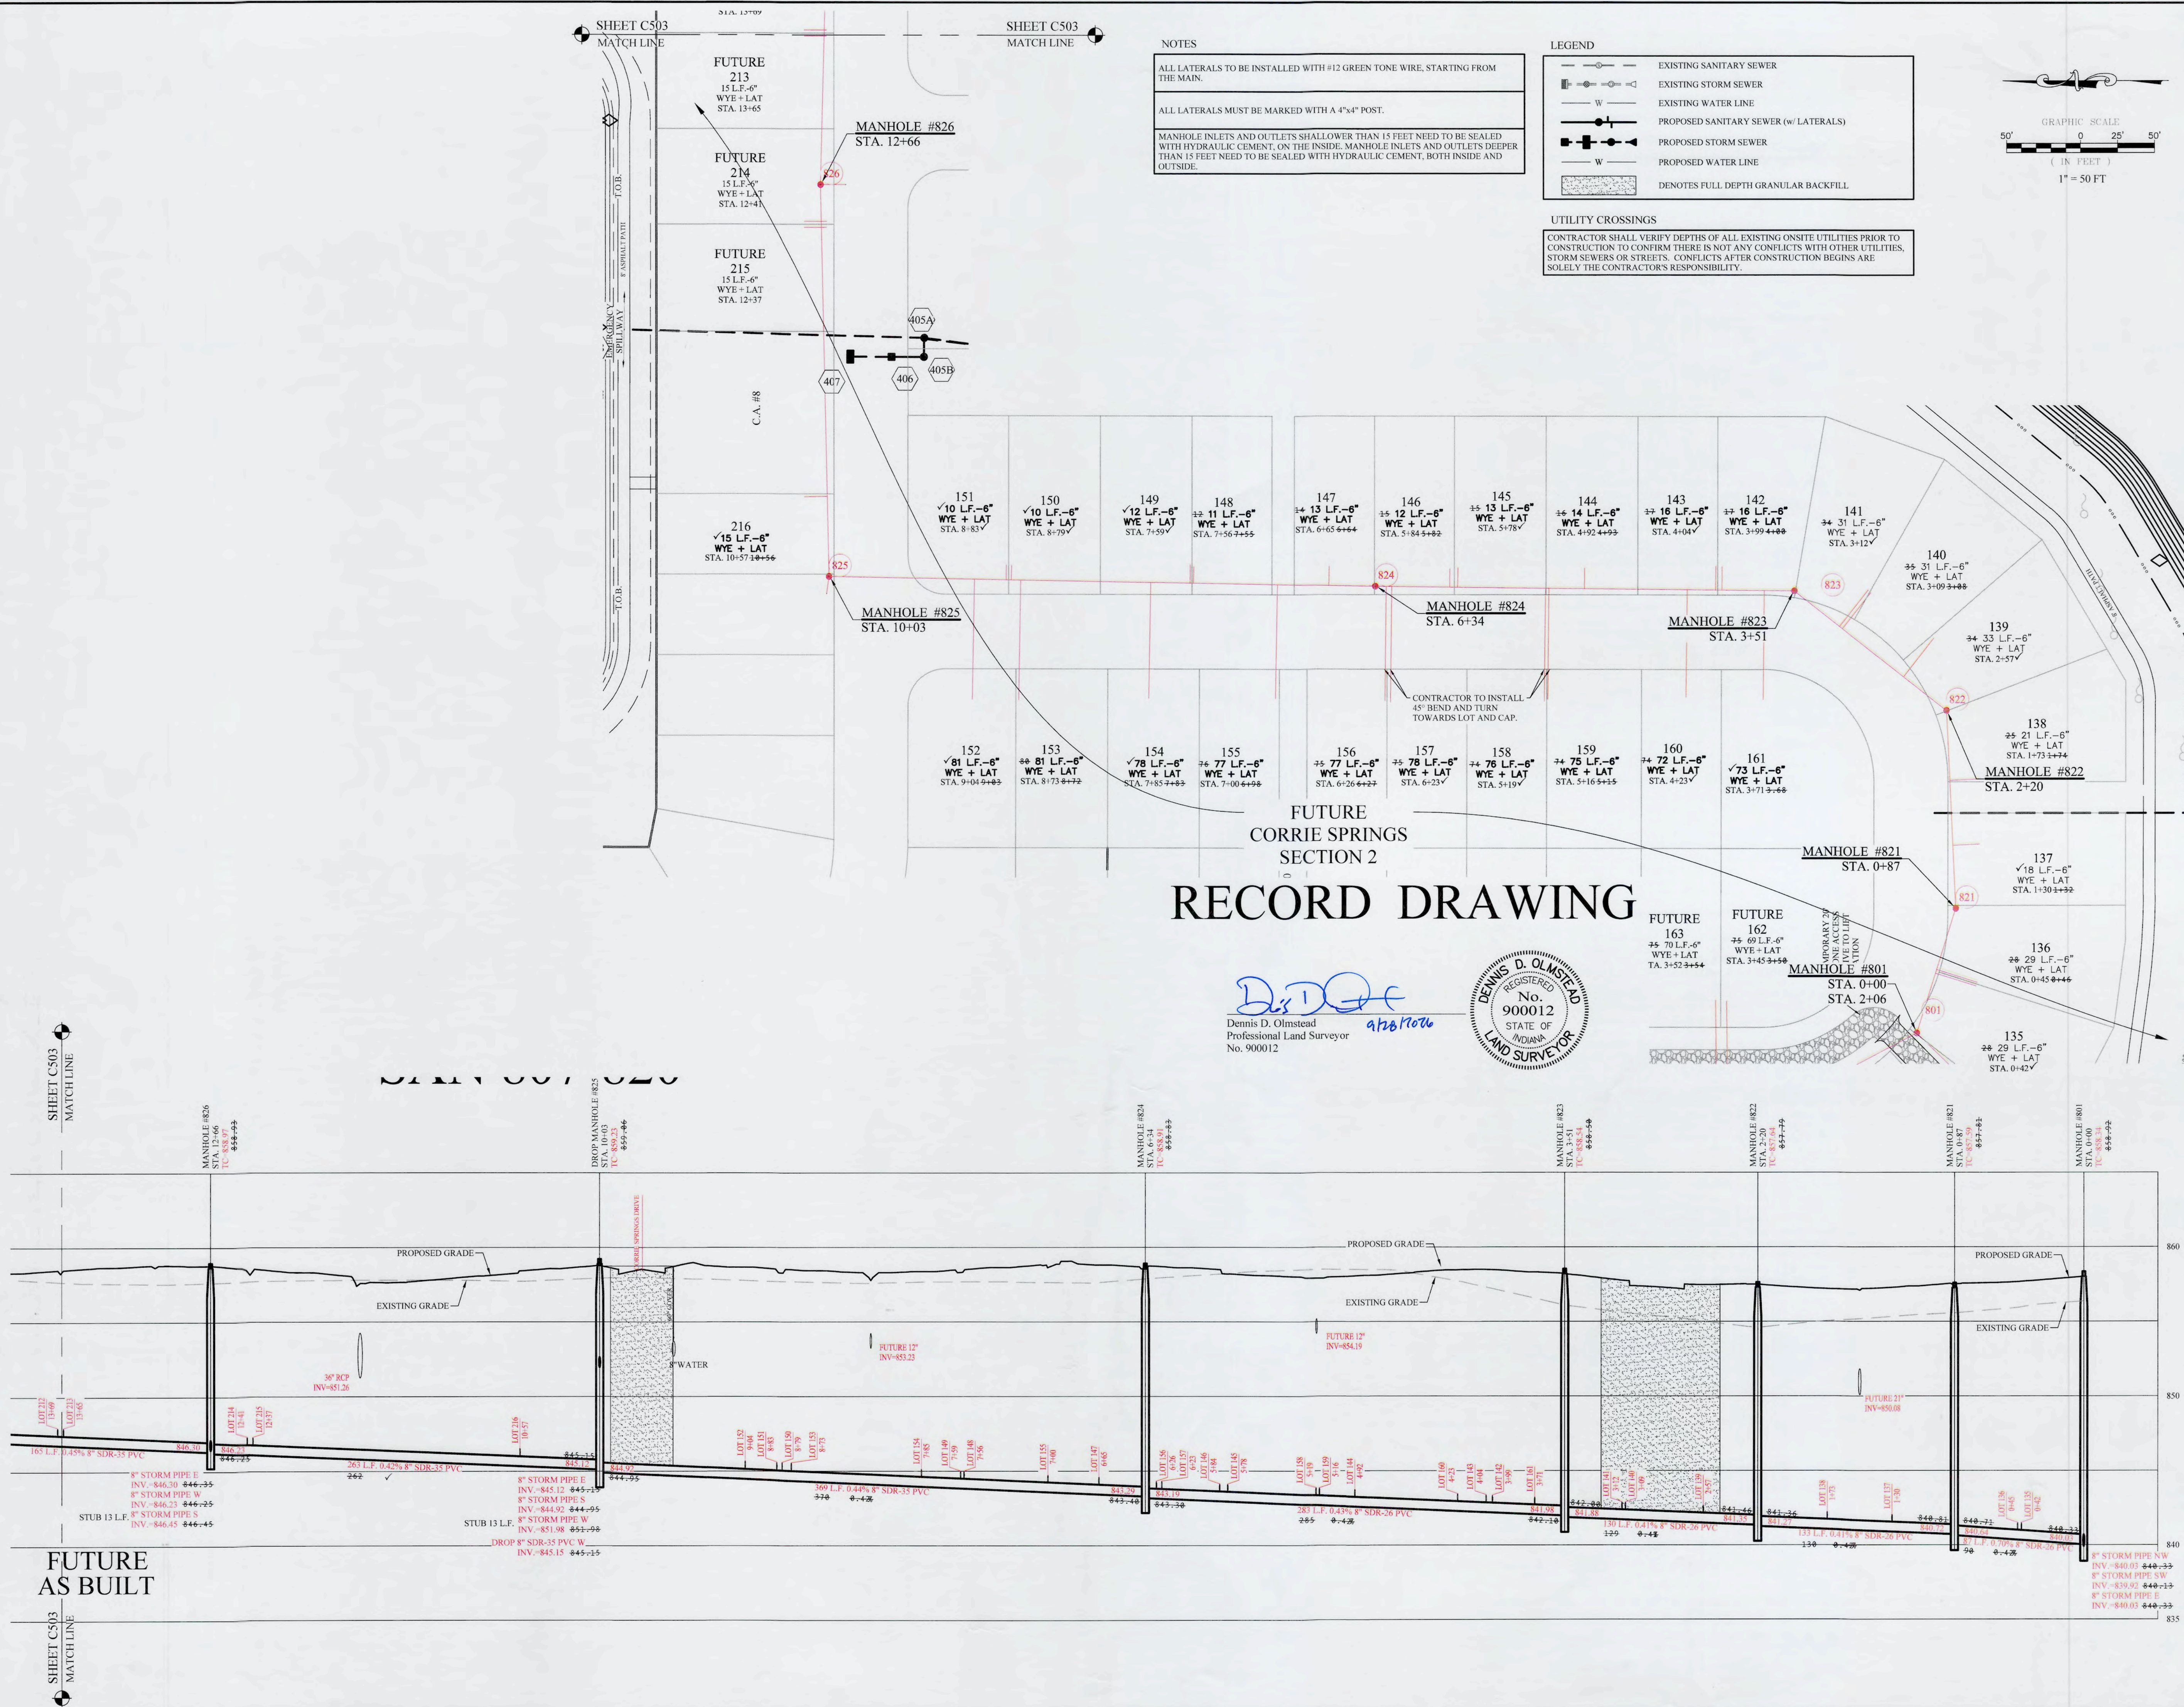

NOTES

ALL LATERALS TO BE INSTALLED WITH #12 GREEN TONE WIRE, STARTING FROM THE MAIN.

ALL LATERALS MUST BE MARKED WITH A 4"x4" POST.


MANHOLE INLETS AND OUTLETS SHALLower THAN 15 FEET NEED TO BE SEALED WITH HYDRAULIC CEMENT. ON THE INSIDE. MANHOLE INLETS AND OUTLETS DEEPER THAN 15 FEET NEED TO BE SEALED WITH HYDRAULIC CEMENT, BOTH INSIDE AND OUTSIDE.

LEGEND

EXISTING SANITARY SEWER
EXISTING STORM SEWER
EXISTING WATER LINE
PROPOSED SANITARY SEWER (w/ LATERALS)
PROPOSED STORM SEWER
PROPOSED WATER LINE
DENOTES FULL DEPTH GRANULAR BACKFILL

UTILITY CROSSINGS

CONTRACTOR SHALL VERIFY DEPTHS OF ALL EXISTING ONSITE UTILITIES PRIOR TO CONSTRUCTION TO CONFIRM THERE IS NOT ANY CONFLICTS WITH OTHER UTILITIES, STORM SEWERS OR STREETS. CONFLICTS AFTER CONSTRUCTION BEGINS ARE SOLELY THE CONTRACTOR'S RESPONSIBILITY.

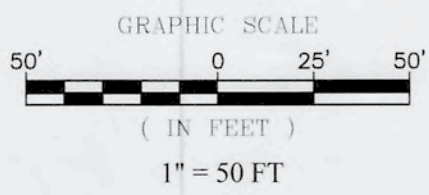

PAI	KG	CDW	GM	BY
AS BUILT - SANITARY MAIN & LATERALS	REVISED PER ICRW COMMENTS	REVISED PIPE MATERIAL	REVISED PER REVIEW COMMENTS	REVISIONS
09/28/26	06/04/25	05/09/25	04/30/25	DATE

THIS DRAWING IS NOT INTENDED TO BE USED FOR ANY OTHER PURPOSES THAN THE ORIGINAL BOUNDARY SURVEY, A ROUTE SURVEY OR A SURVEYOR LOCATION REPORT.

CERTIFIED: 04/04/25

STOEPPELWERTH
ALWAYS ON
7965 East 106th Street, Fishers, IN 46038-2505
phone: 317.849.5955 fax: 317.849.5942

REGISTERED PROFESSIONAL ENGINEER
No. PE1200386
STATE OF INDIANA

Sanitary Sewer Plan & Profiles
CORRIE SPRINGS
SECTION 1

DRAWN BY: RPL
CHECKED BY: KRG

SHEET NO. **C502**
S.E.A. JOB NO. 104889FOR-S1