



File Name: S:\104869FOR-S\DWG\C500 - Sanitary Plan & Profile.dwg - C506
Plotted By: September 28, 2023 12:53:07 PM / Michael Evans

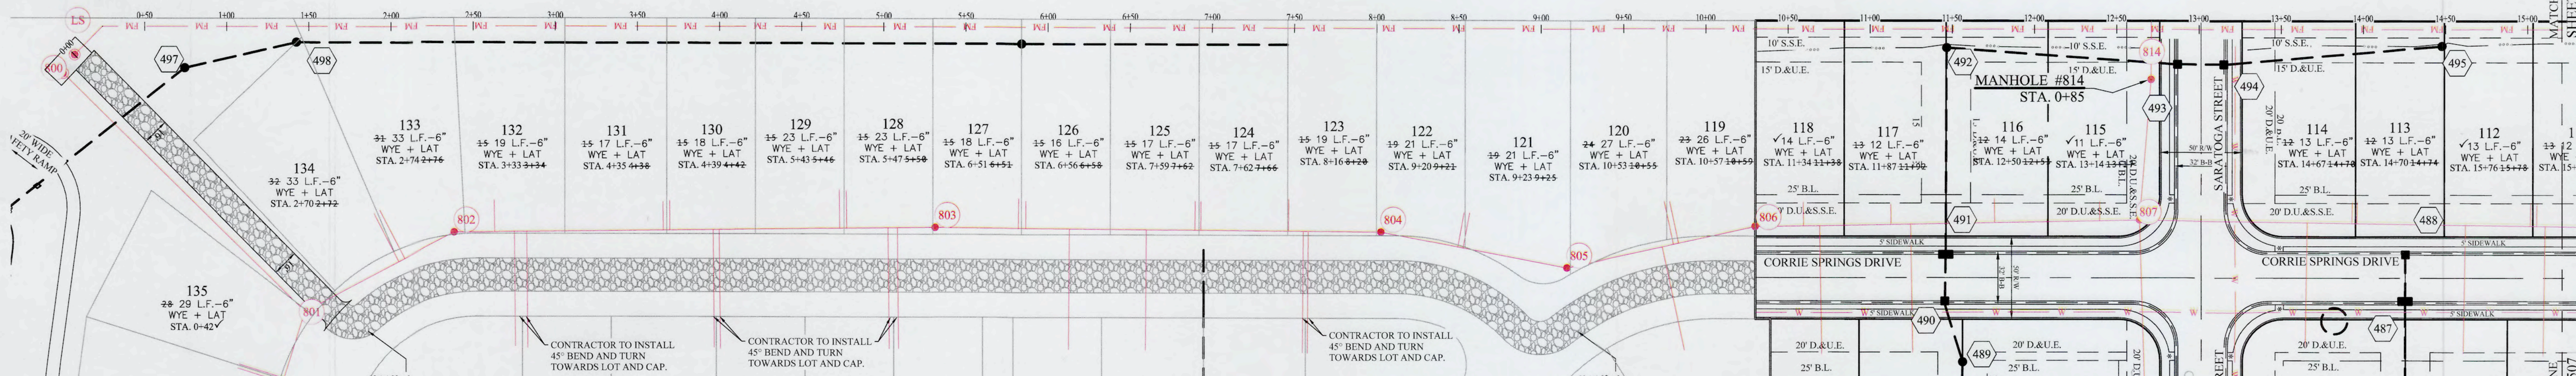

LEGEND	
	EXISTING SANITARY SEWER
	EXISTING STORM SEWER
	EXISTING WATER LINE
	PROPOSED SANITARY SEWER (w/ LATERALS)
	PROPOSED STORM SEWER
	PROPOSED WATER LINE
	DENOTES FULL DEPTH GRANULAR BACKFILL


UTILITY CROSSINGS
CONTRACTOR SHALL VERIFY DEPTHS OF ALL EXISTING ONSITE UTILITIES PRIOR TO CONSTRUCTION TO CONFIRM THERE IS NOT ANY CONFLICTS WITH OTHER UTILITIES, STORM SEWERS OR STREETS. CONFLICTS AFTER CONSTRUCTION BEGINS ARE SOLELY THE CONTRACTOR'S RESPONSIBILITY.

NOTES
ALL LATERALS TO BE INSTALLED WITH #12 GREEN TONE WIRE, STARTING FROM THE MAIN.
ALL LATERALS MUST BE MARKED WITH A 4"x4" POST.
MANHOLE INLETS AND OUTLETS SHALLower THAN 15 FEET NEED TO BE SEALED WITH HYDRAULIC CEMENT, ON THE INSIDE. MANHOLE INLETS AND OUTLETS DEEPER THAN 15 FEET NEED TO BE SEALED WITH HYDRAULIC CEMENT, BOTH INSIDE AND OUTSIDE.

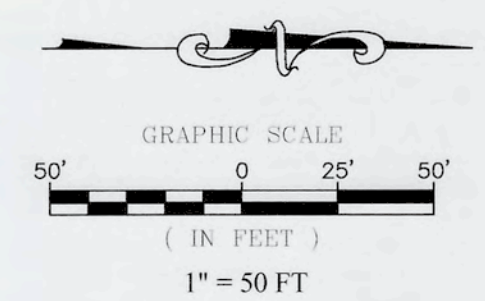

RECORD DRAWING

D.D.O.
Dennis D. Olmstead
Professional Land Surveyor
No. 900012

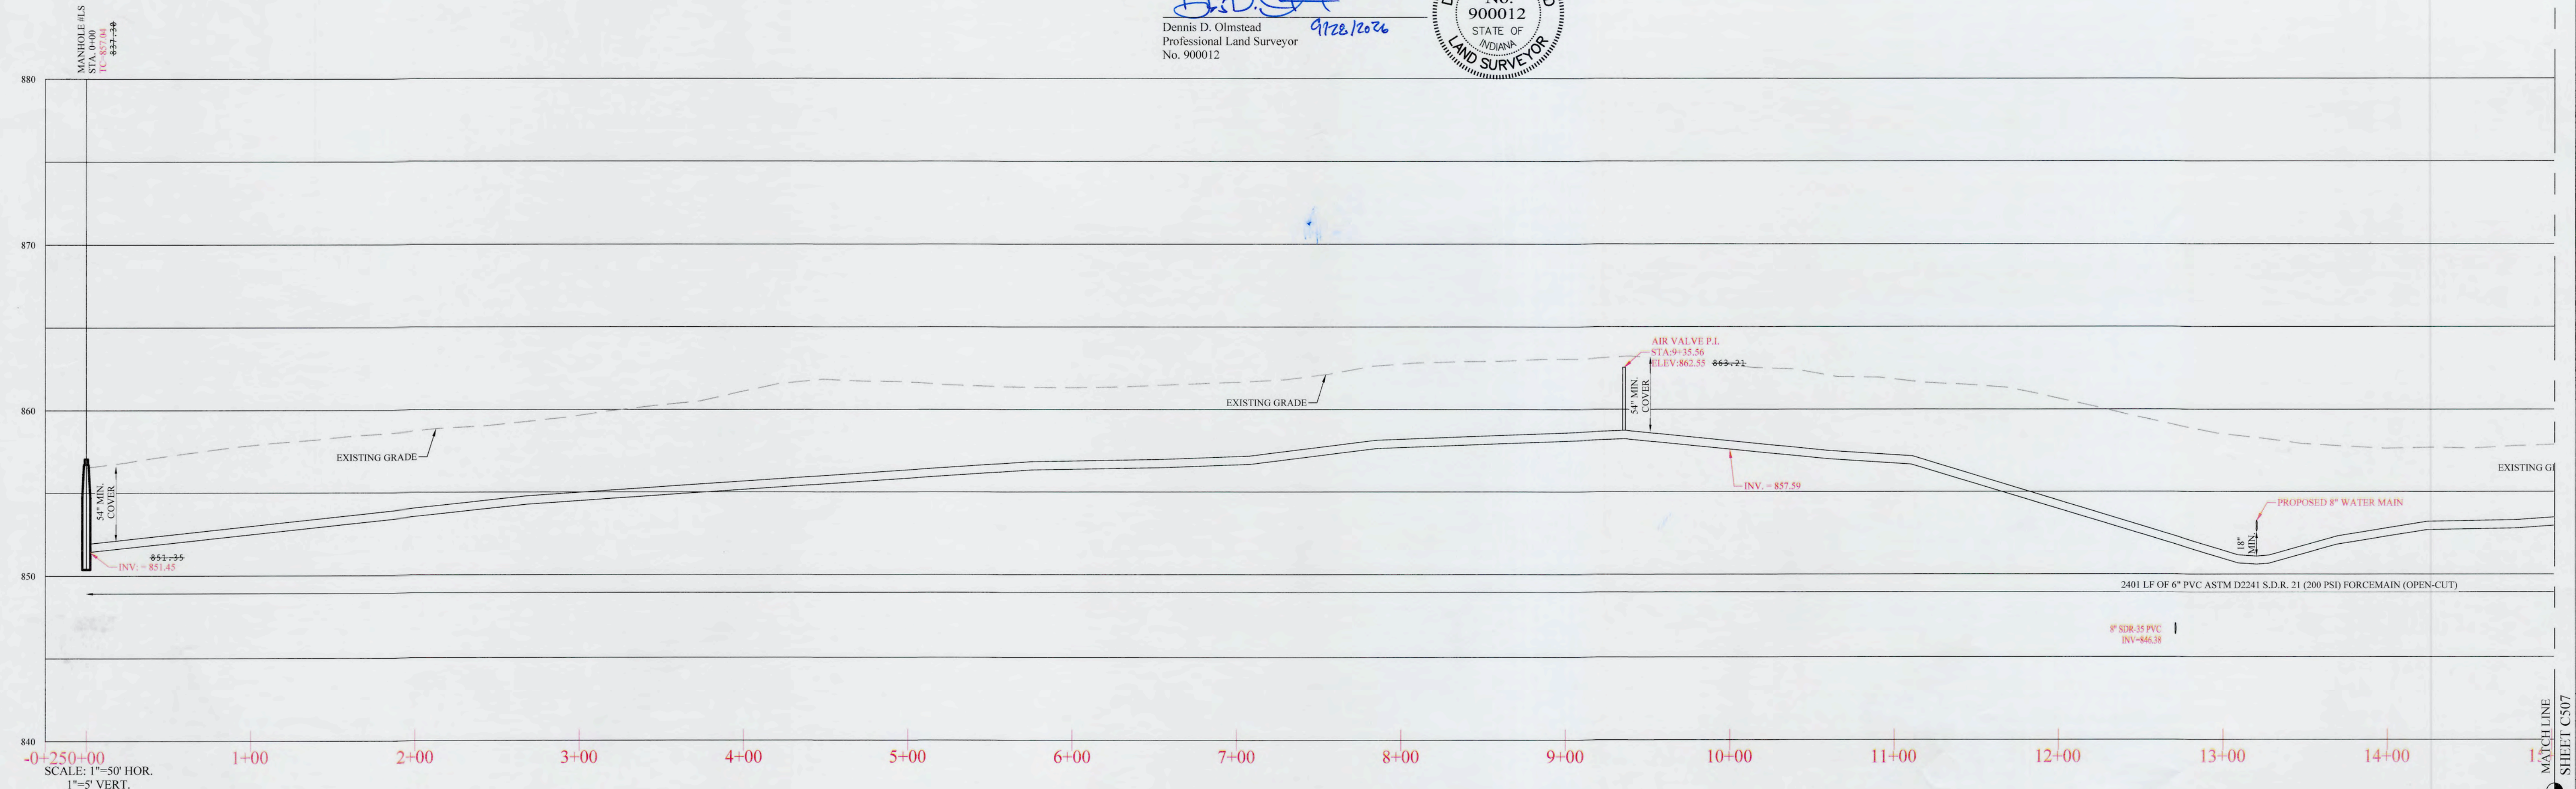

STOEPPELWERTH
ALWAYS ON
7965 East 106th Street, Fishers, IN 46038-2505
phone: 317.849.5955 fax: 317.849.5942

SANITARY SEWER PLAN & PROFILES
CORRIE SPRINGS
SECTION 1

INGALLS
MADISON COUNTY, INDIANA

DRAWN BY: RPL
CHECKED BY: KRG
SHEET NO. C506
S&A JOB NO. 104869FOR-S1

DATE 04/04/25
MARK
BY
REVISIONS
AS BUILT - FORCE MAIN
GEM
REVISED PER REVIEW COMMENTS
PAH

THIS DRAWING IS NOT INTENDED TO BE
USED FOR ANY PURPOSE OTHER THAN THE
ORIGINAL BOUNDARY SURVEY, A ROUTE
SURVEY OR A SURVEYOR LOCATION
REPORT.
CERTIFIED: 04/04/25
[Signature]

BRAND MILLER BROWN
REGISTERED
No. PE1200386
STATE OF INDIANA
PROFESSIONAL ENGINEER