




RECORD DRAWING

D.D.O.
Dennis D. Olmstead
Professional Land Surveyor
No. 900012
9/26/2026

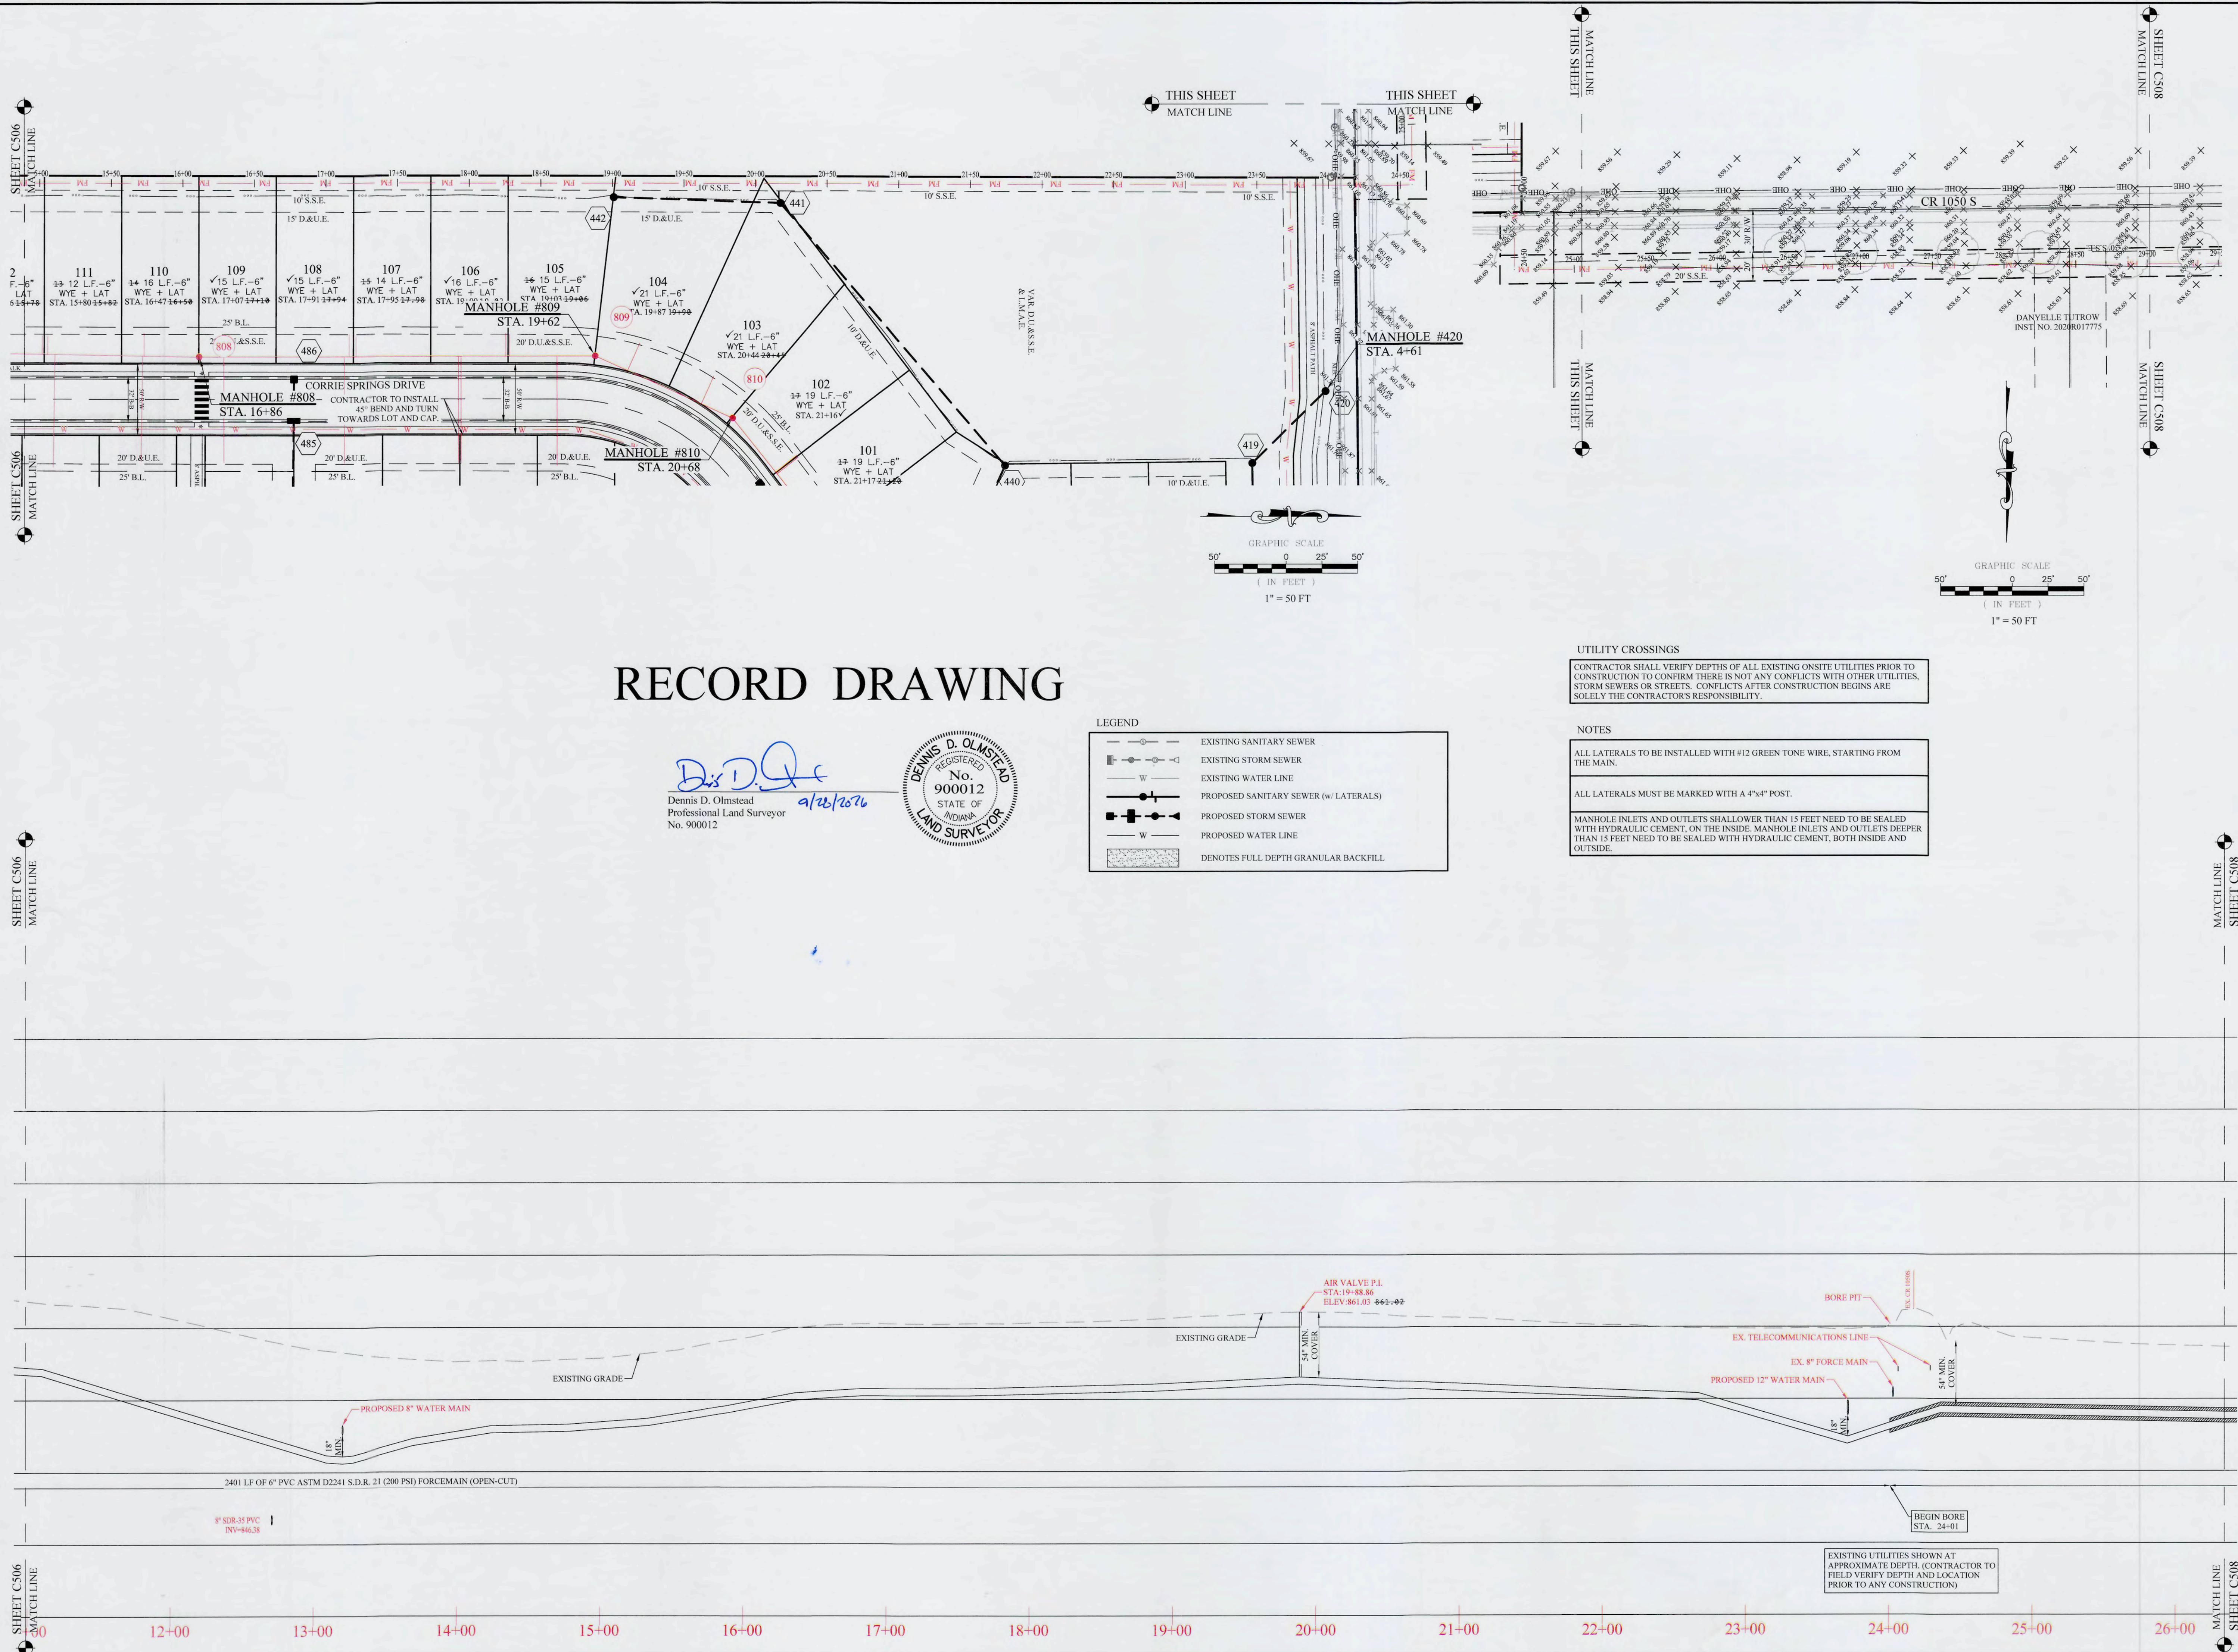

LEGEND	
	EXISTING SANITARY SEWER
	EXISTING STORM SEWER
	EXISTING WATER LINE
	PROPOSED SANITARY SEWER (w/ LATERALS)
	PROPOSED STORM SEWER
	PROPOSED WATER LINE
	DENOTES FULL DEPTH GRANULAR BACKFILL

UTILITY CROSSINGS

CONTRACTOR SHALL VERIFY DEPTHS OF ALL EXISTING ONSITE UTILITIES PRIOR TO CONSTRUCTION TO CONFIRM THERE IS NOT ANY CONFLICTS WITH OTHER UTILITIES, STORM SEWERS OR STREETS. CONFLICTS AFTER CONSTRUCTION BEGINS ARE SOLELY THE CONTRACTOR'S RESPONSIBILITY.

NOTES

ALL LATERALS TO BE INSTALLED WITH #12 GREEN TONE WIRE, STARTING FROM THE MAIN.

ALL LATERALS MUST BE MARKED WITH A 4"x4" POST.

MANHOLE INLETS AND OUTLETS SHALLower THAN 15 FEET NEED TO BE SEALED WITH HYDRAULIC CEMENT, ON THE INSIDE. MANHOLE INLETS AND OUTLETS DEEPER THAN 15 FEET NEED TO BE SEALED WITH HYDRAULIC CEMENT, BOTH INSIDE AND OUTSIDE.

SANITARY SEWER PLAN & PROFILES

CORRIE SPRINGS

SECTION 1

INGALLS MADISON COUNTY, INDIANA

DRAWN BY: RPL
CHECKED BY: KRK
SHEET NO. C507
S&A JOB NO. 104869FOR-S1

STOEPPELWERTH

ALWAYS ON
7965 East 10th Street, Fishers, IN 46038-2505
phone: 317.849.5935 fax: 317.849.5942

THIS DRAWING IS NOT INTENDED TO BE REPRESENTED AS A RETRACEMENT OR SURVEY OR A SURVEYOR LOCATION REPORT.
CERTIFIED: 04/04/25
DANIELLE T. TITROW
INST. NO. 2026R017775
REGISTERED
No. PE11200386
STATE OF INDIANA
PROFESSIONAL ENGINEER

BY	MARK	DATE	REVISIONS
PAH		09/28/26	AS BUILTS - FORCE MAIN
GEM		04/30/25	REVISED PER REVIEW COMMENTS