




RECORD DRAWING

D.D.O.
Dennis D. Olmstead
Professional Land Surveyor
No. 900012
9/28/2026

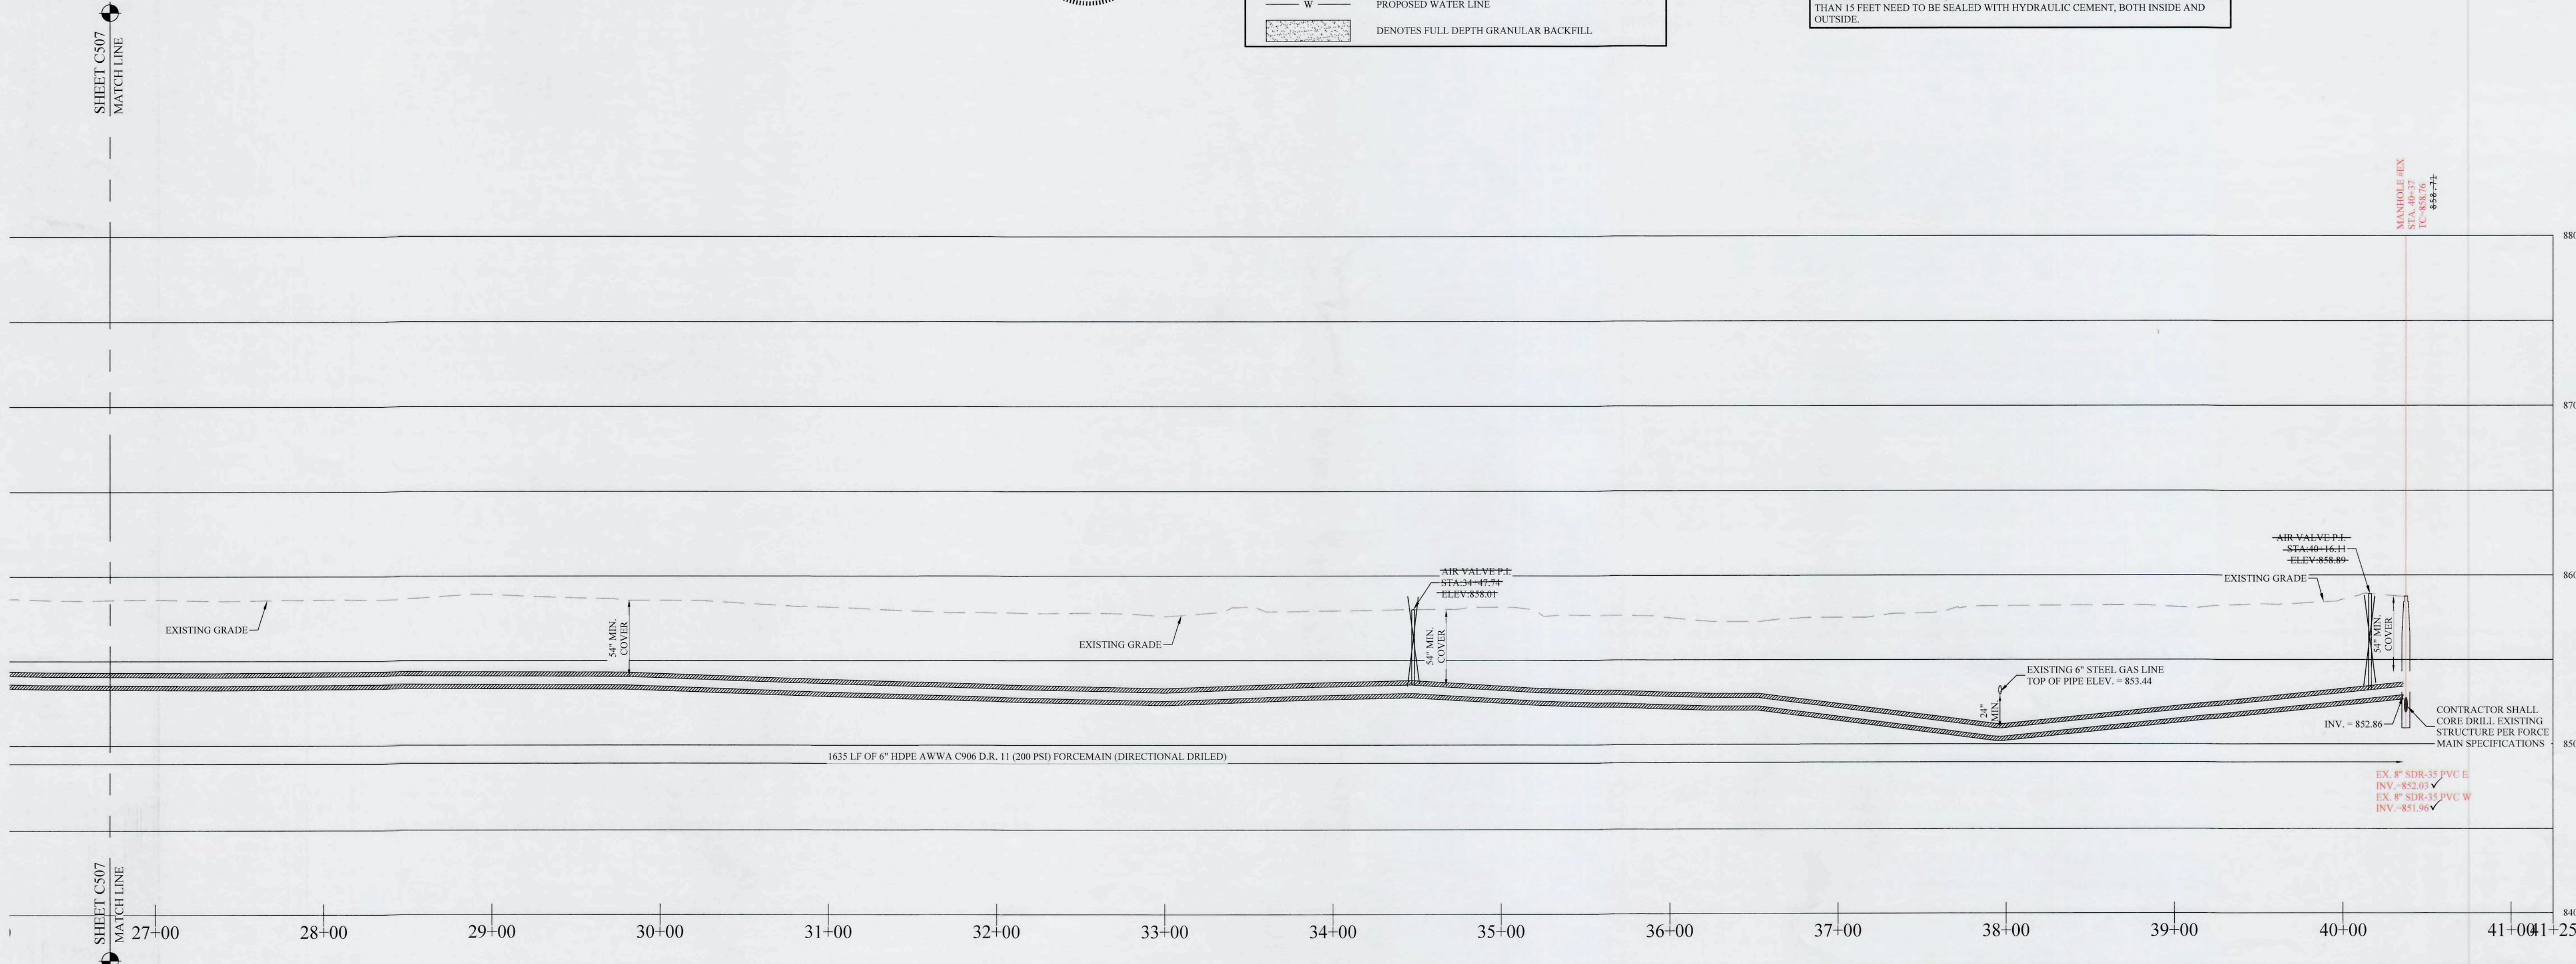

LEGEND	
	EXISTING SANITARY SEWER
	EXISTING STORM SEWER
	EXISTING WATER LINE
	PROPOSED SANITARY SEWER (w/ LATERALS)
	PROPOSED STORM SEWER
	PROPOSED WATER LINE
	DENOTES FULL DEPTH GRANULAR BACKFILL

UTILITY CROSSINGS


CONTRACTOR SHALL VERIFY DEPTHS OF ALL EXISTING ONSITE UTILITIES PRIOR TO CONSTRUCTION TO CONFIRM THERE IS NOT ANY CONFLICTS WITH OTHER UTILITIES, STORM SEWERS OR STREETS. CONFLICTS AFTER CONSTRUCTION BEGINS ARE SOLELY THE CONTRACTOR'S RESPONSIBILITY.

NOTES

ALL LATERALS TO BE INSTALLED WITH #12 GREEN TONE WIRE, STARTING FROM THE MAIN.

ALL LATERALS MUST BE MARKED WITH A 4"x4" POST.

MANHOLE INLETS AND OUTLETS SHALLower THAN 15 FEET NEED TO BE SEALED WITH HYDRAULIC CEMENT, ON THE INSIDE. MANHOLE INLETS AND OUTLETS DEEPER THAN 15 FEET NEED TO BE SEALED WITH HYDRAULIC CEMENT, BOTH INSIDE AND OUTSIDE.

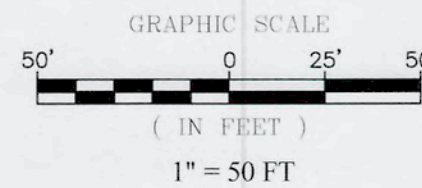

SANITARY SEWER PLAN & PROFILES


CORRIE SPRINGS

SECTION 1

STOEPPELWERTH

ALWAYS ON

7945 East 106th Street, Fishers, IN 46038-2505
phone: 317.849.5905 fax: 317.849.5942

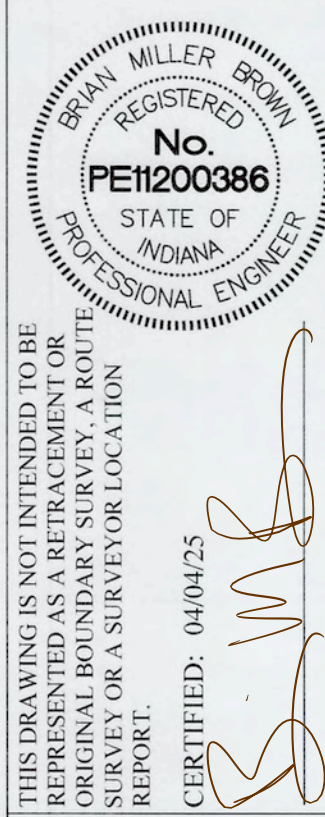

CERTIFIED: 04/04/25

DATE	MARK	REVISIONS
09/28/26		AS BUILT - FORCE MAIN
04/30/25		REVISED PER REVIEW COMMENTS
		PAH
		GEM
		BY