
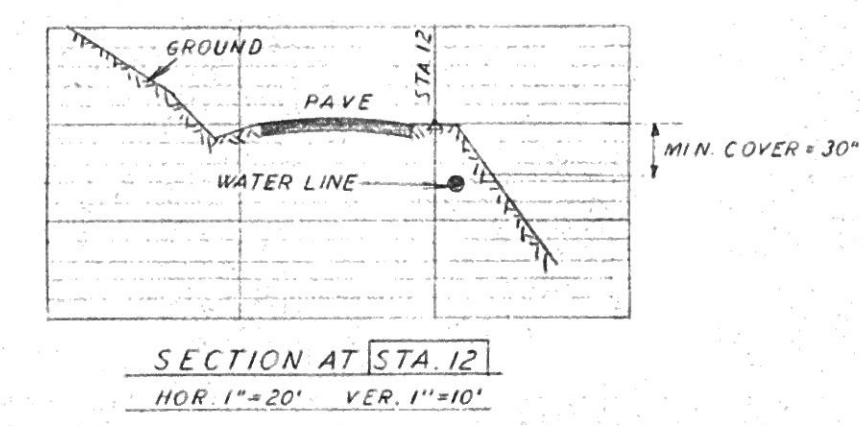
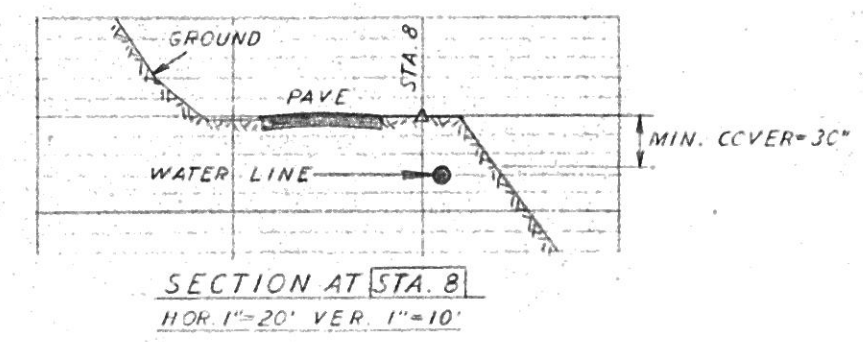
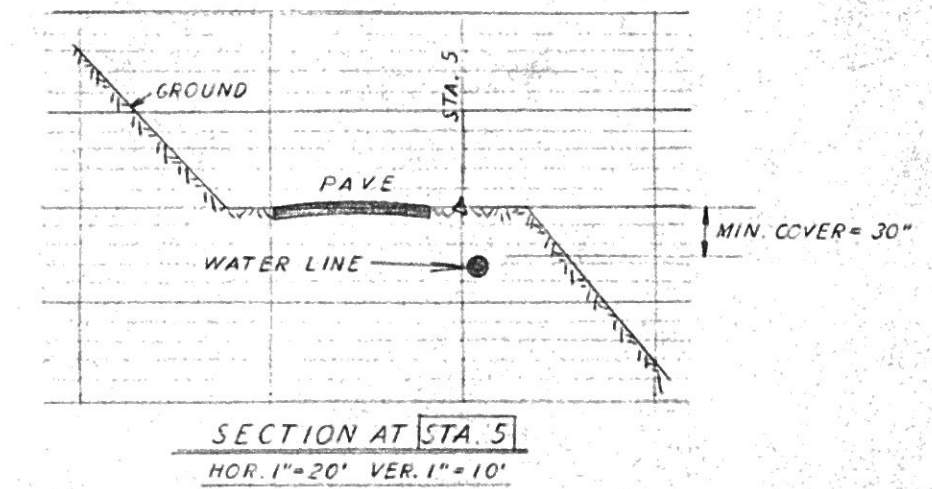


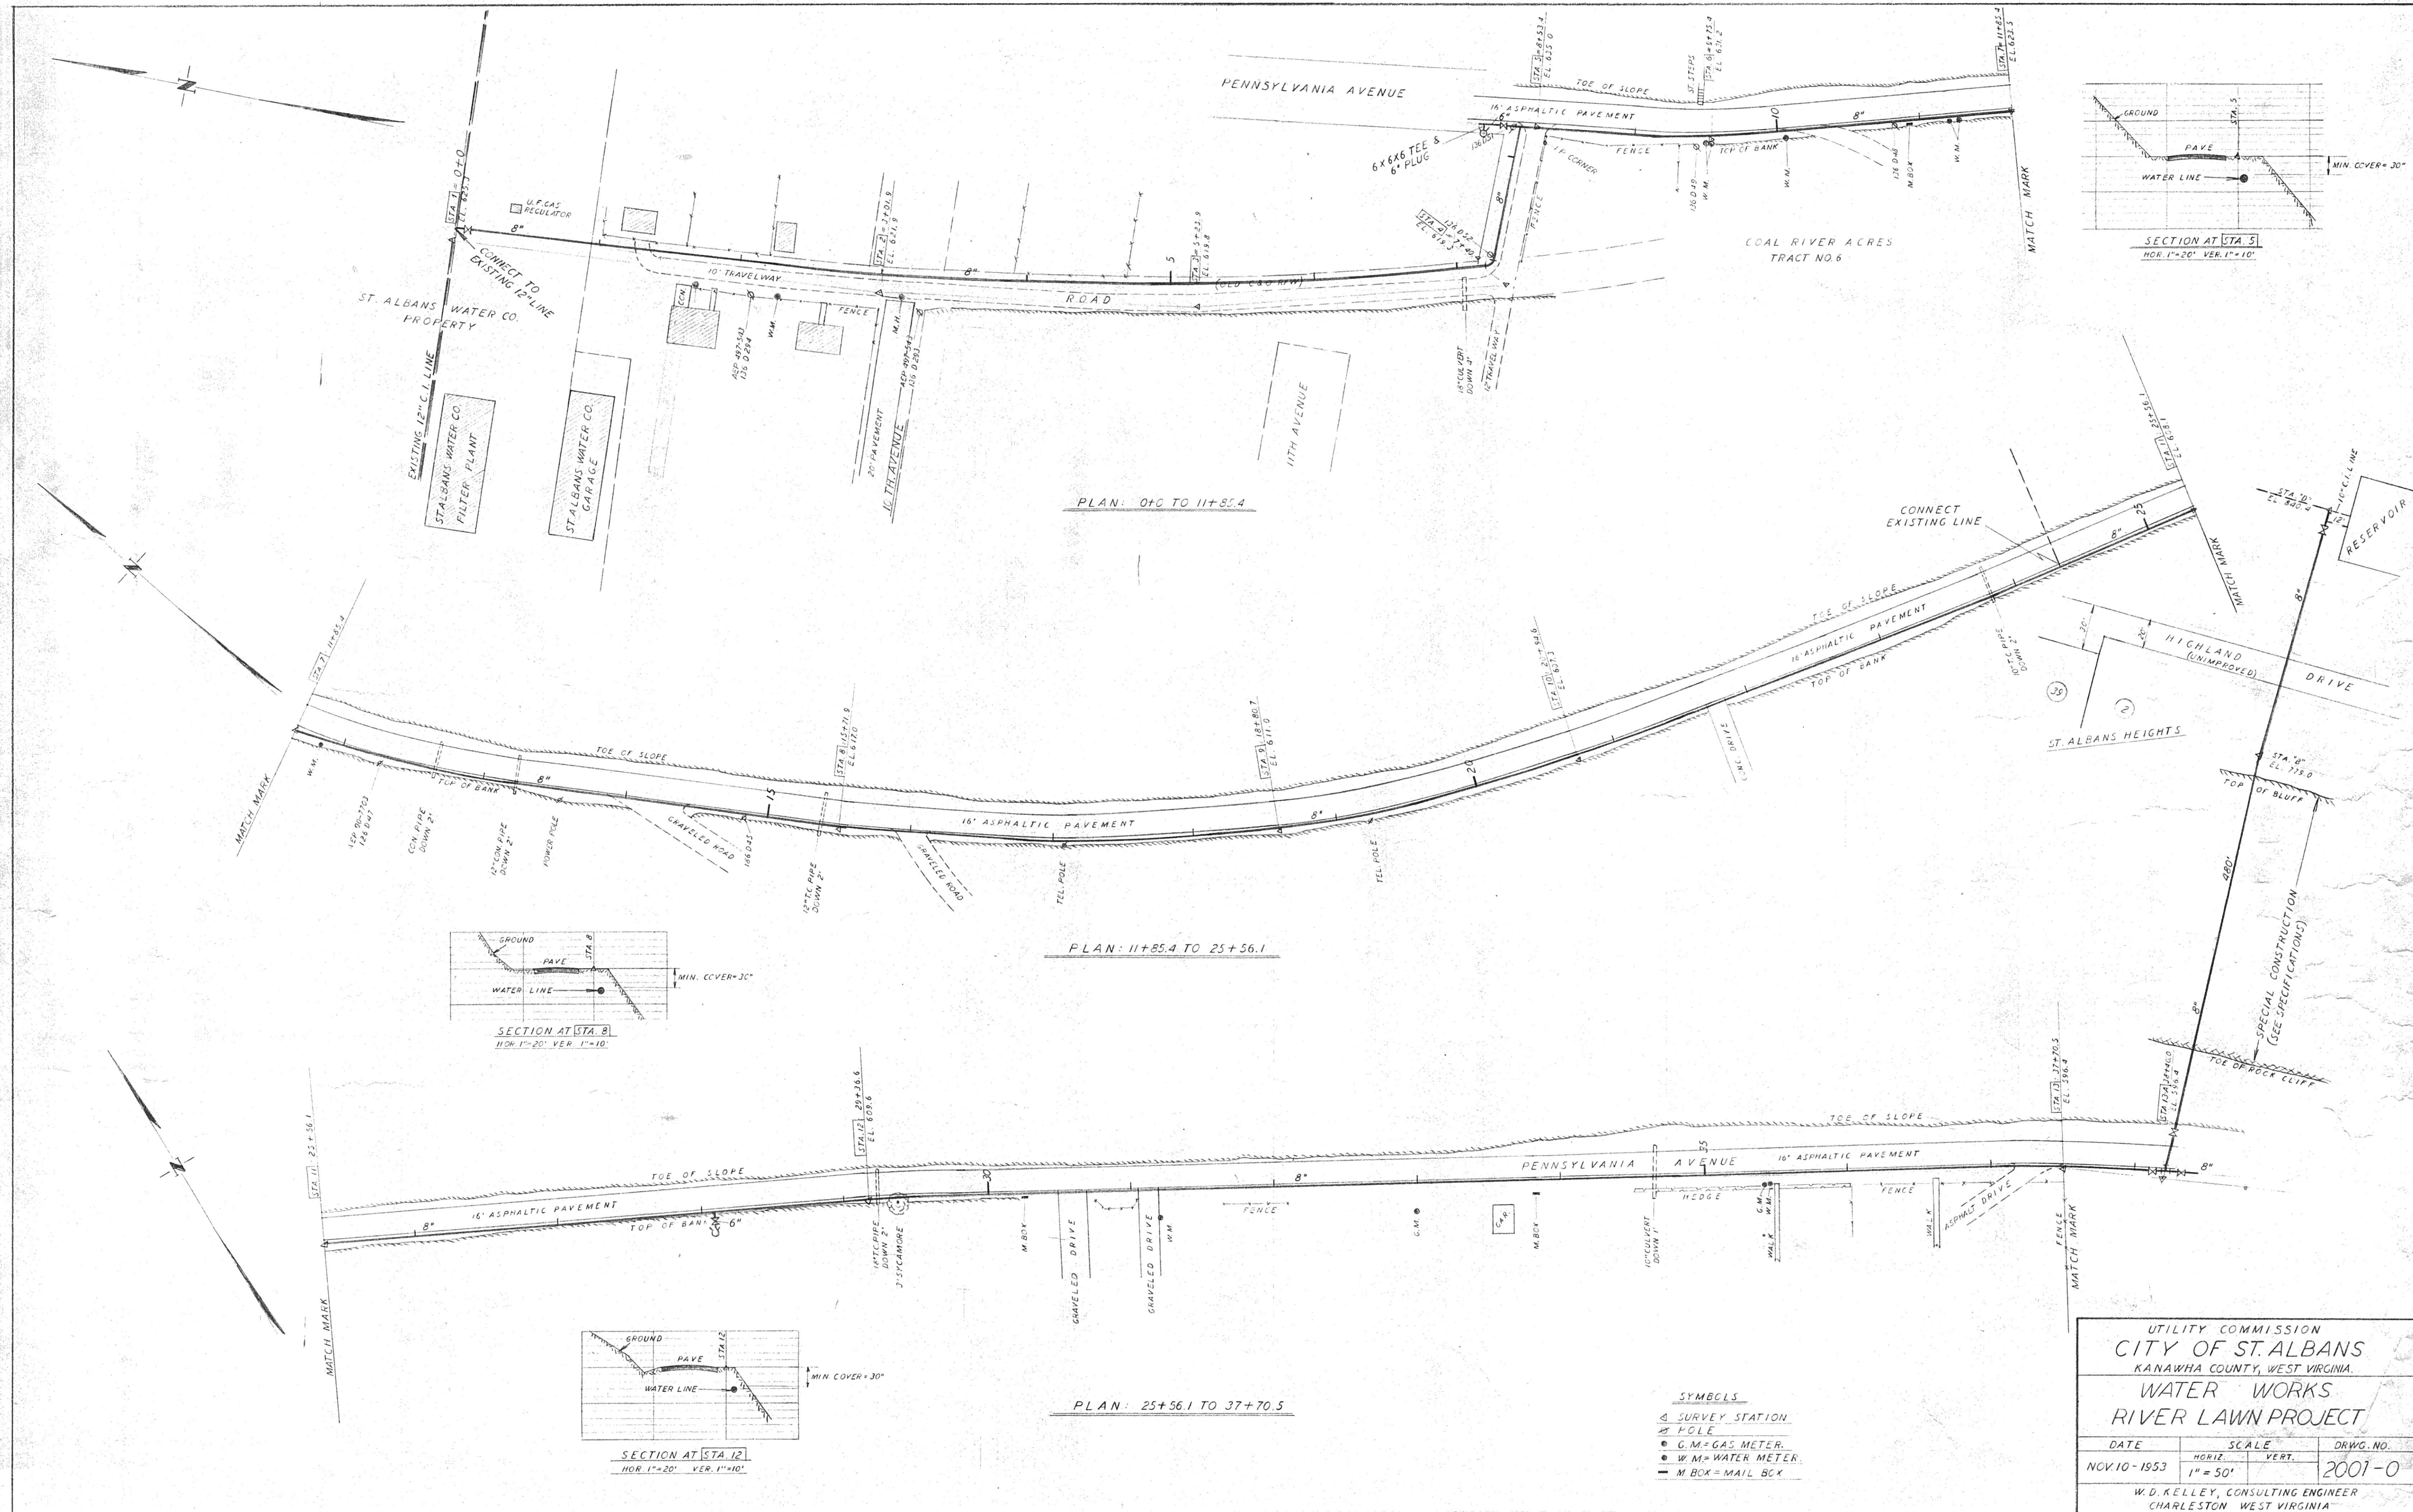

- SYMBOLS**
- ▲ SURVEY STATION
 - HOLE
 - G.M. = GAS METER
 - W.M. = WATER METER
 - M.BOX = MAIL BOX

UTILITY COMMISSION
CITY OF ST. ALBANS
KANAWHA COUNTY, WEST VIRGINIA

**WATER WORKS
RIVER LAWN PROJECT**

DATE	SCALE	DRWG. NO.
NOV. 10 - 1953	HORIZ. 1" = 50' VERT. 1" = 10'	2001-0

W.D. KELLEY, CONSULTING ENGINEER
CHARLESTON, WEST VIRGINIA