
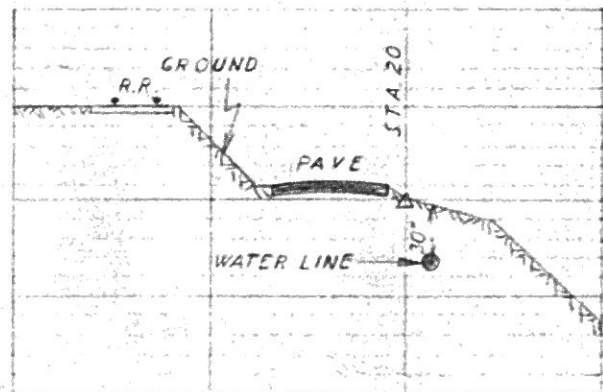
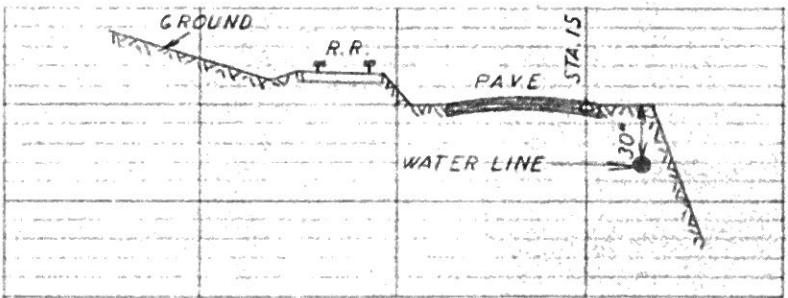


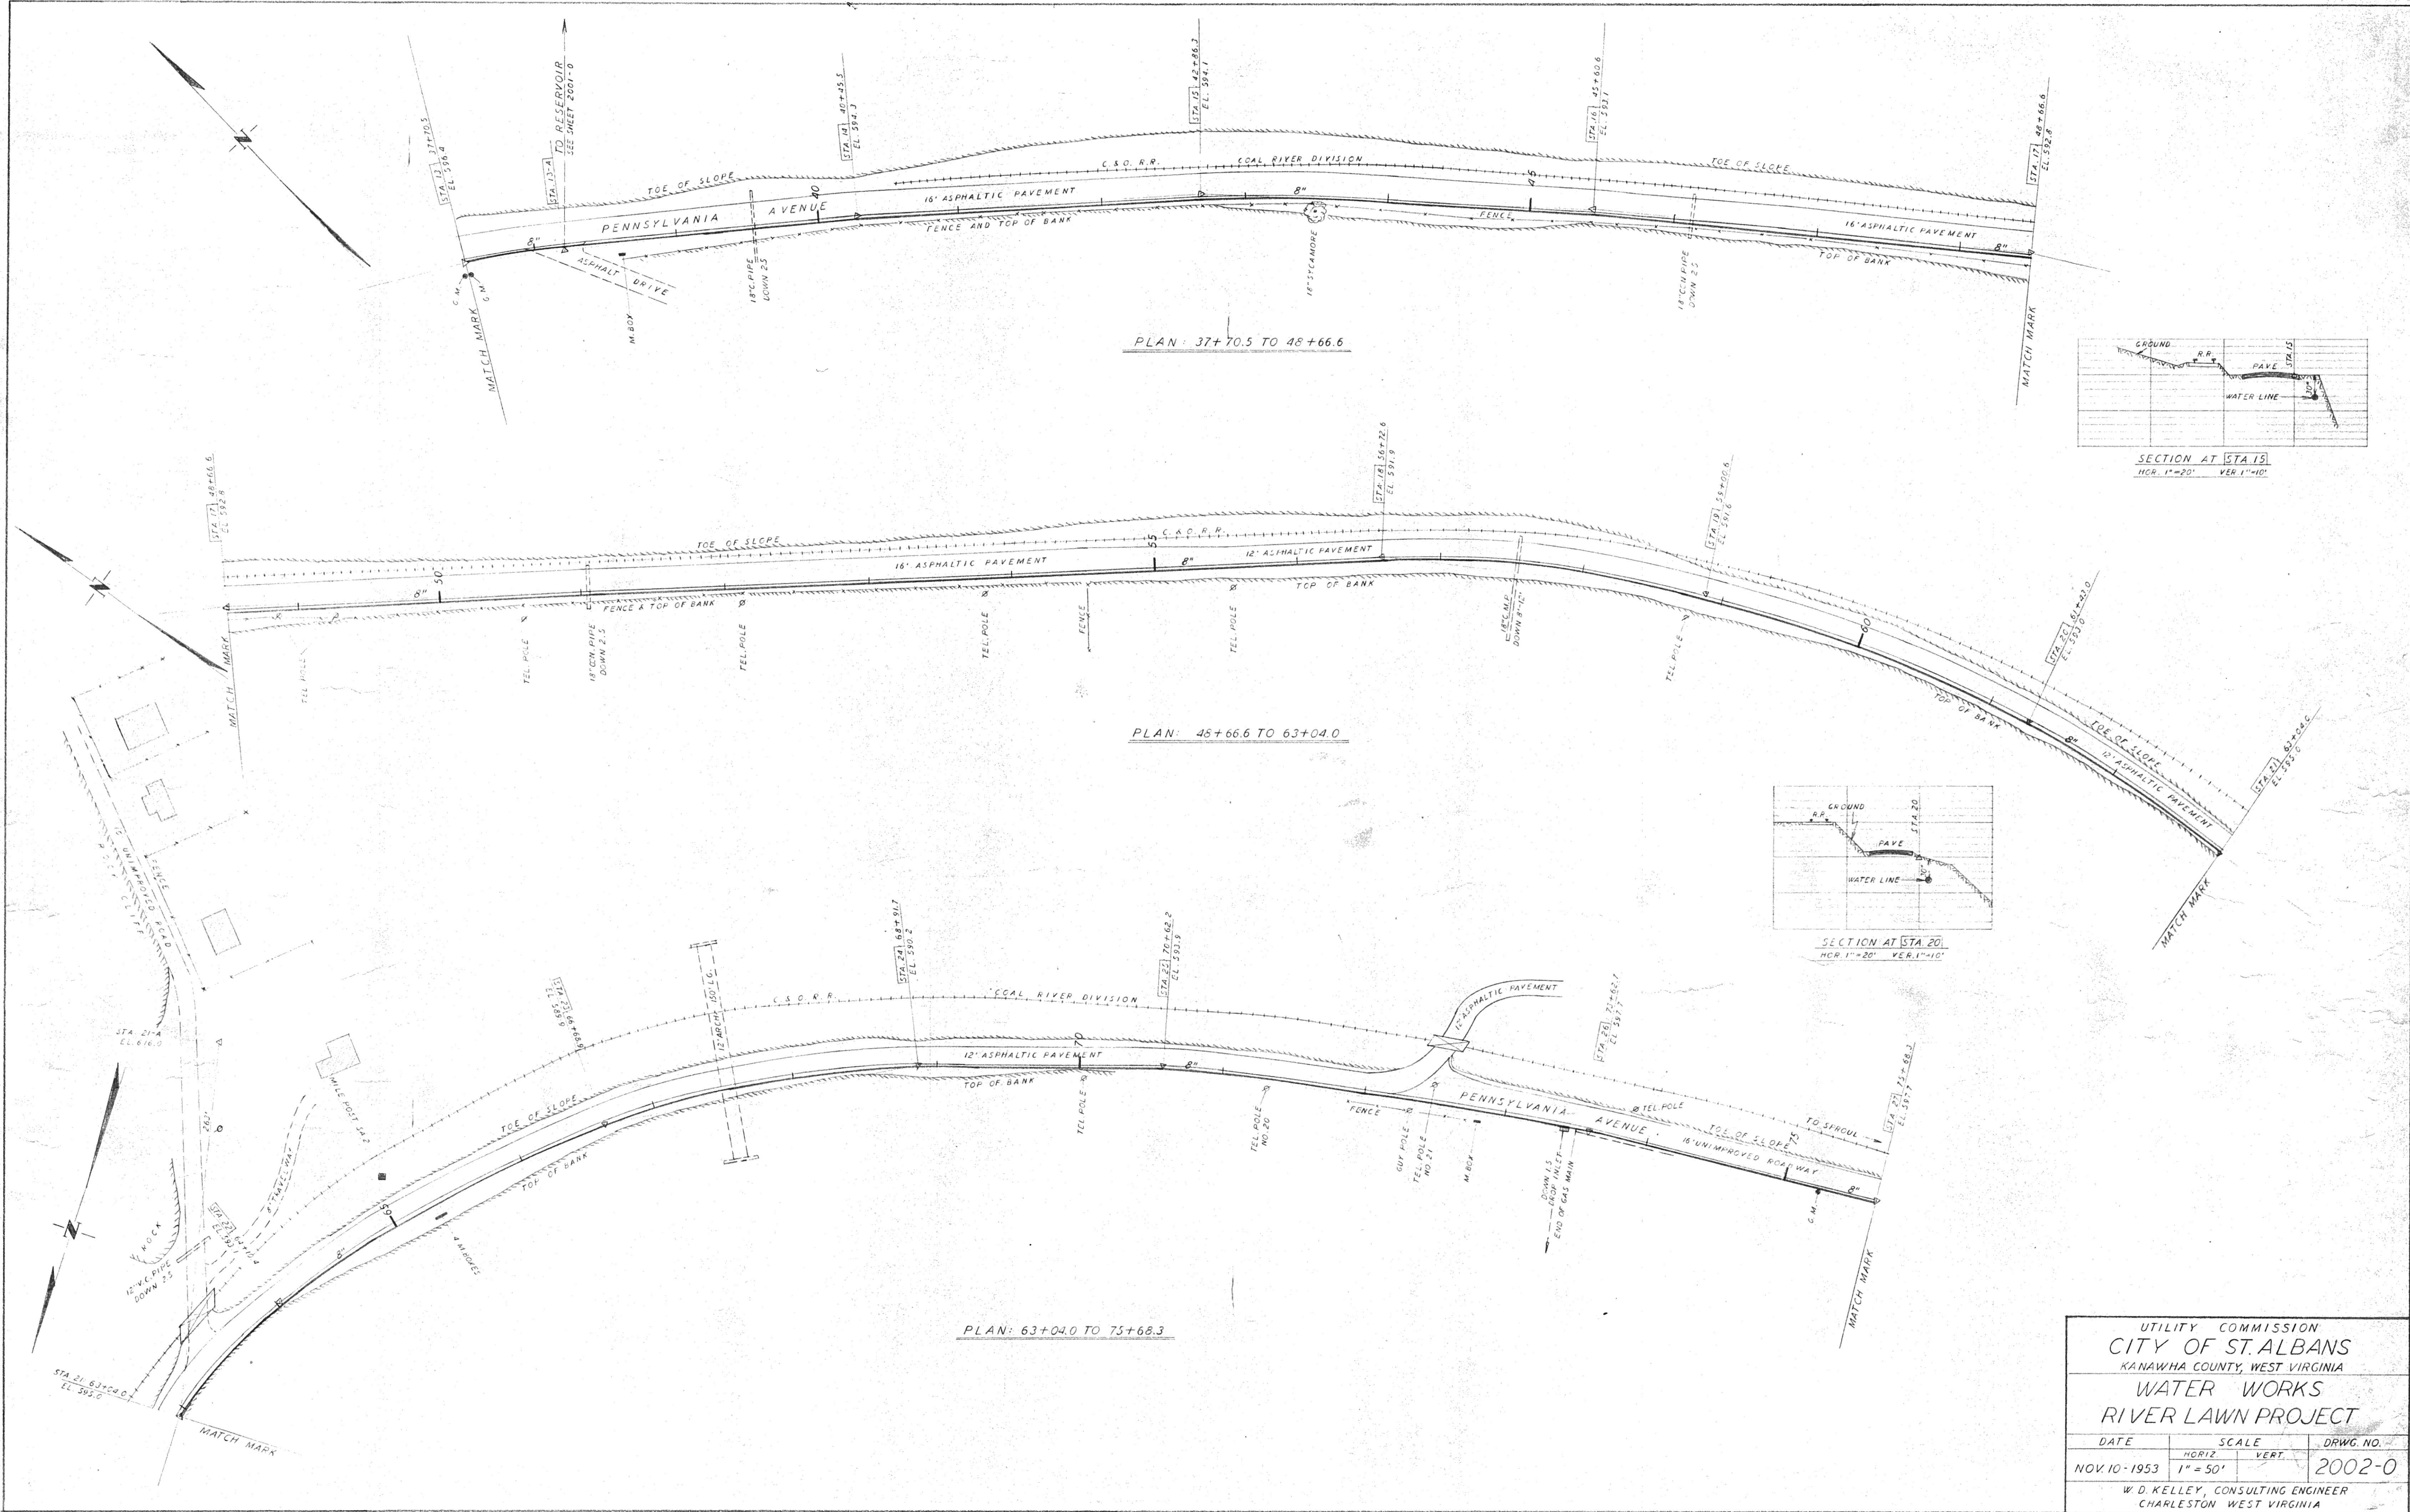

UTILITY COMMISSION		
CITY OF ST. ALBANS		
KANAWHA COUNTY, WEST VIRGINIA		
WATER WORKS		
RIVER LAWN PROJECT		
DATE	SCALE	DRWG. NO.
NOV. 10 - 1953	HORIZ. 1" = 50' VERT. 1" = 10'	2002-0
W. D. KELLEY, CONSULTING ENGINEER CHARLESTON, WEST VIRGINIA		