


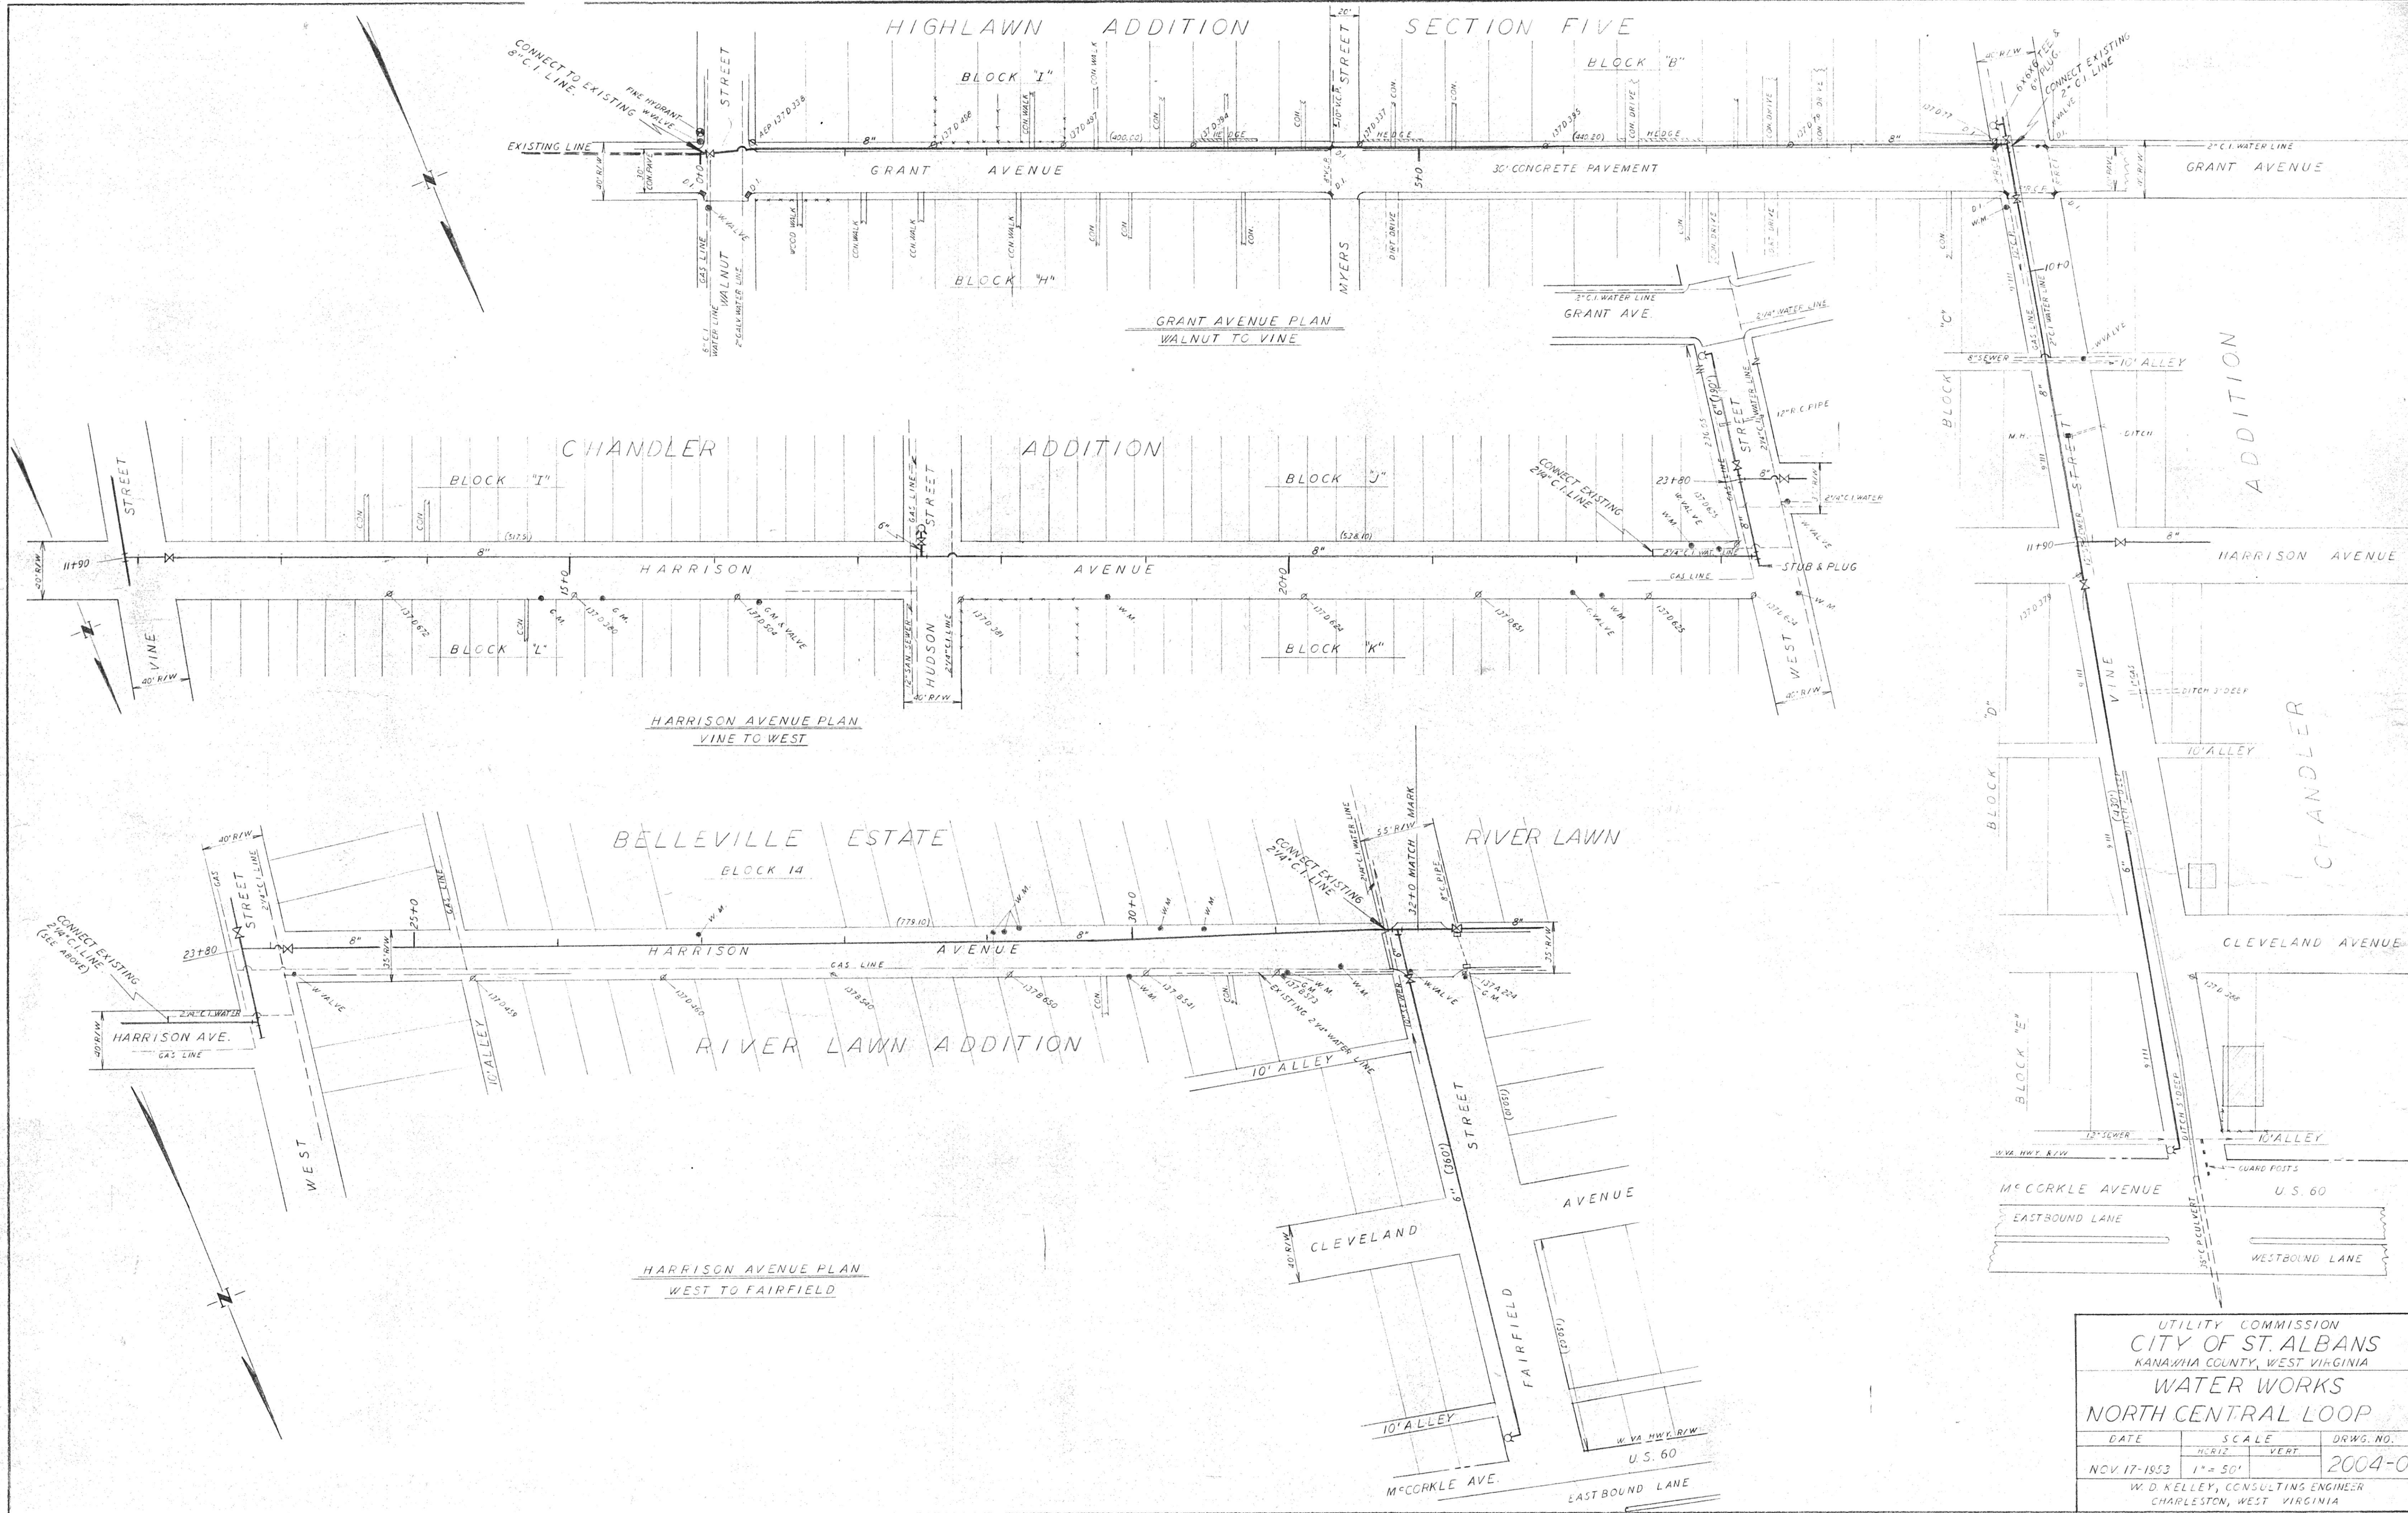

UTILITY COMMISSION CITY OF ST. ALBANS KANAWHA COUNTY, WEST VIRGINIA		
WATER WORKS NORTH CENTRAL LOOP		
DATE	SCALE	DRWG. NO.
NOV 17-1953	1" = 50'	2004-0
W. D. KELLEY, CONSULTING ENGINEER CHARLESTON, WEST VIRGINIA		