
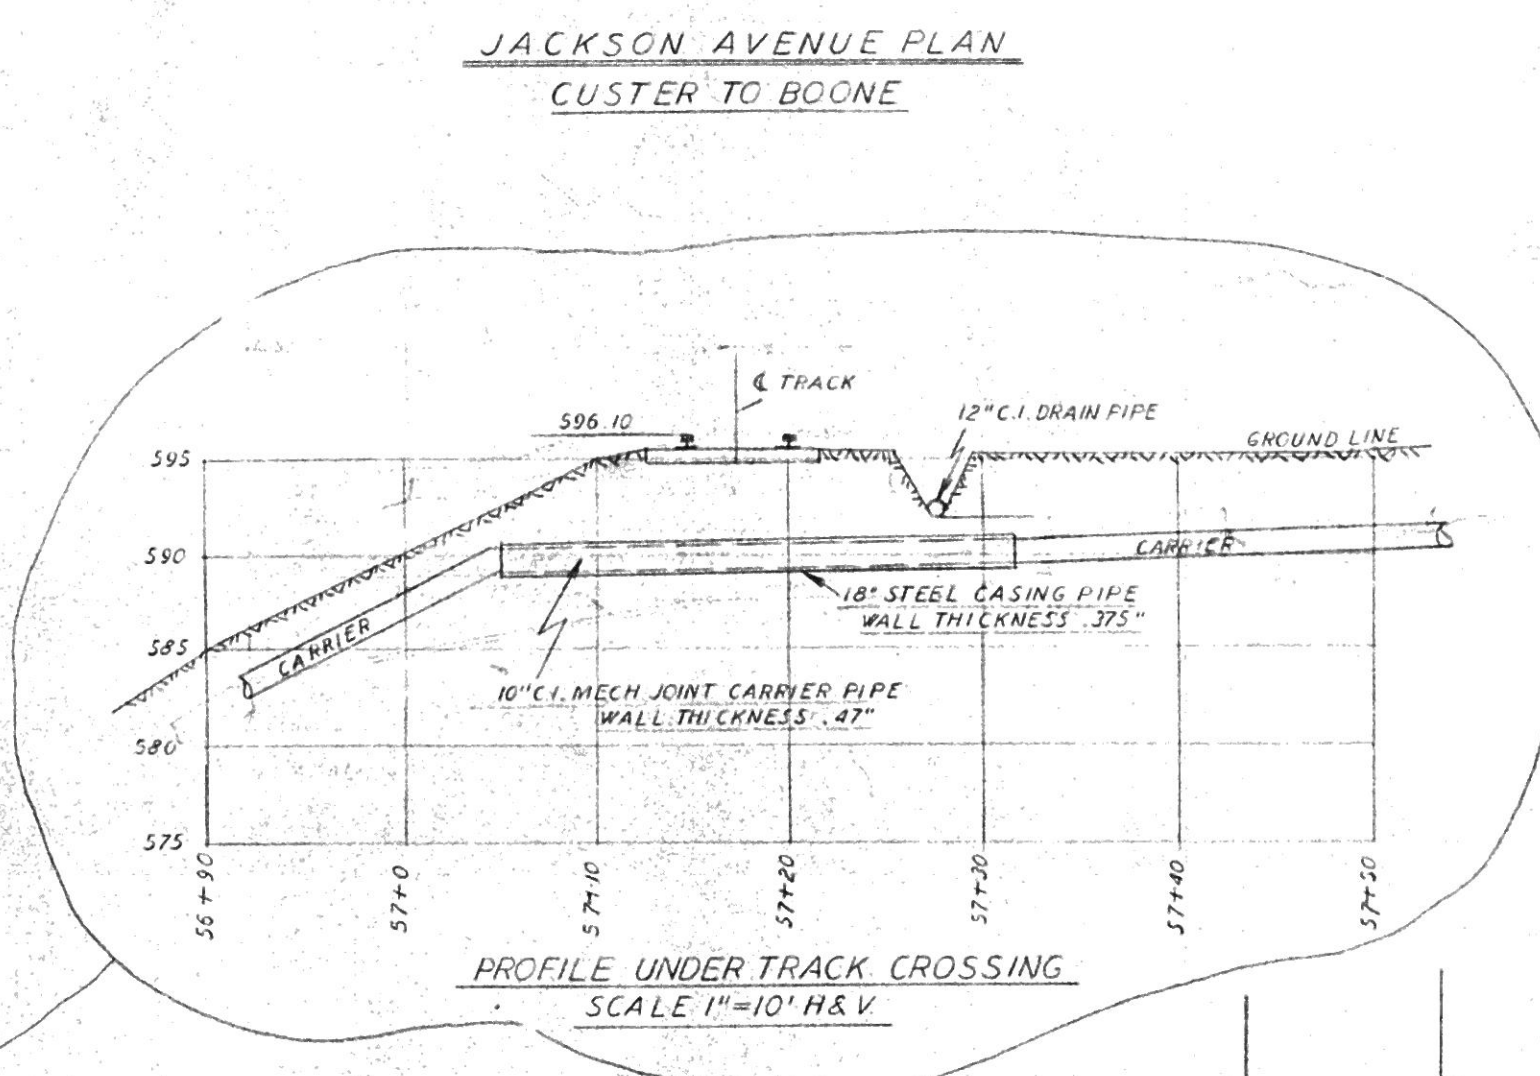
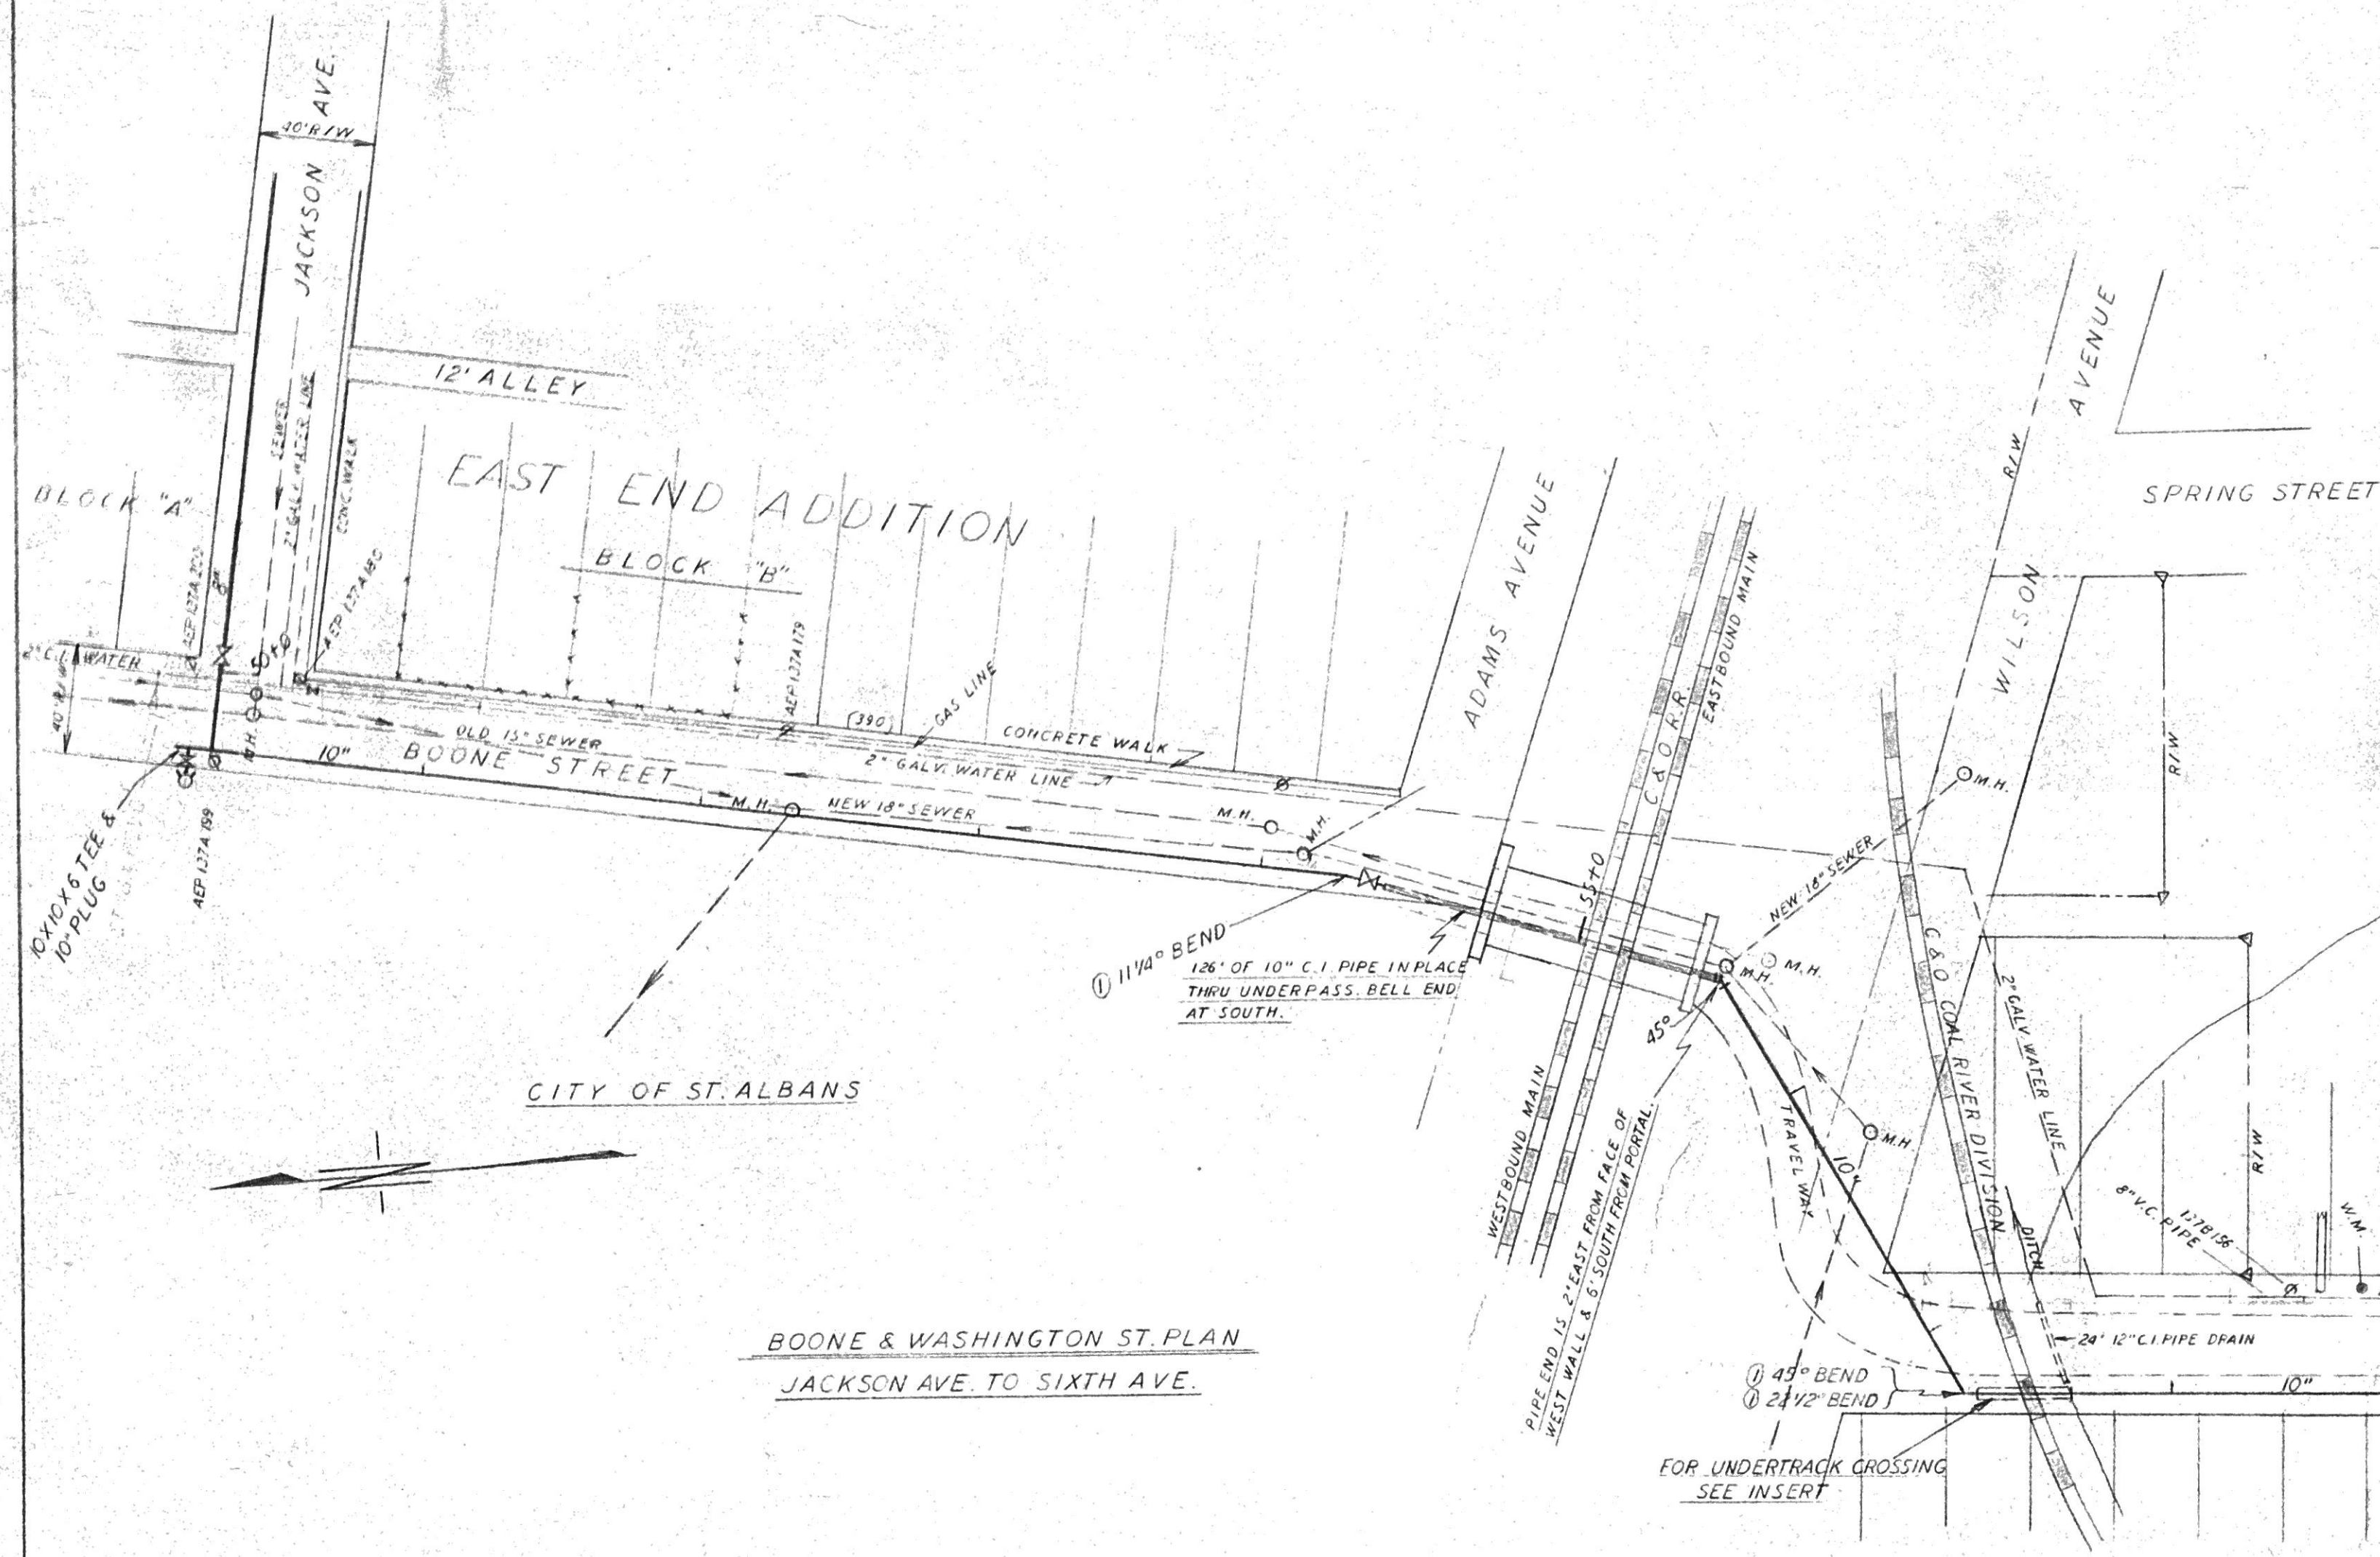


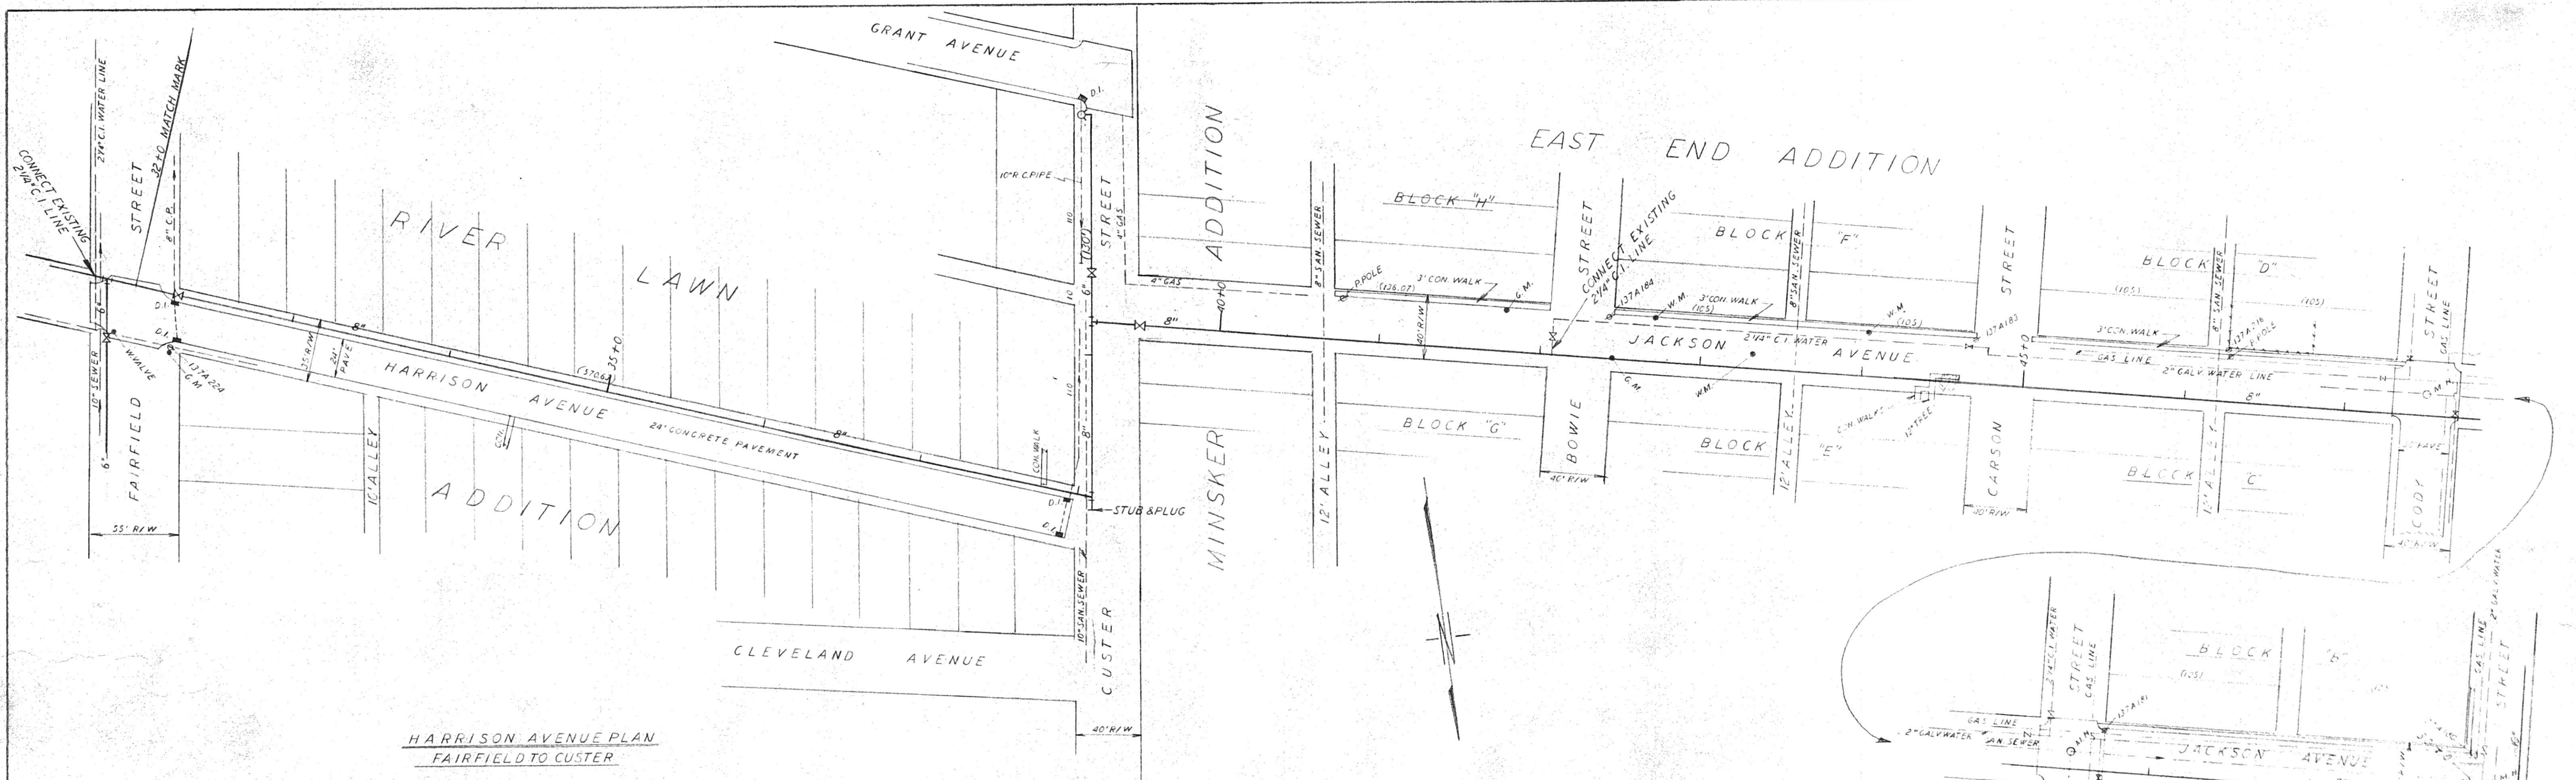

|                     |
|---------------------|
| UTIL<br>CITY<br>KAR |
| NORTH               |
| DATE                |
| NOV. 18-1953        |
| W. D. KE<br>CHAR    |