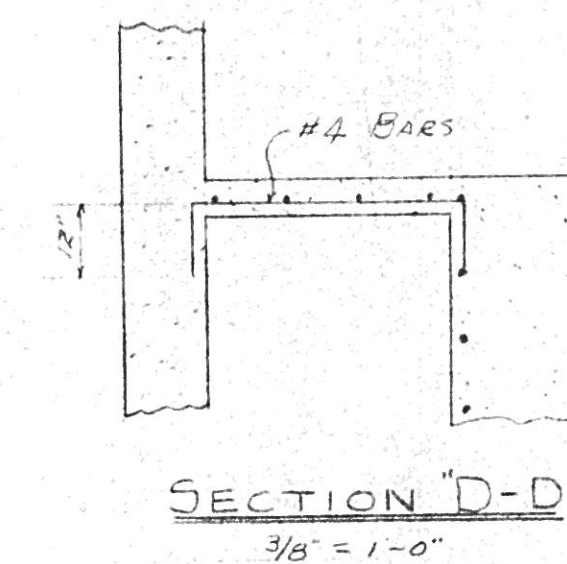
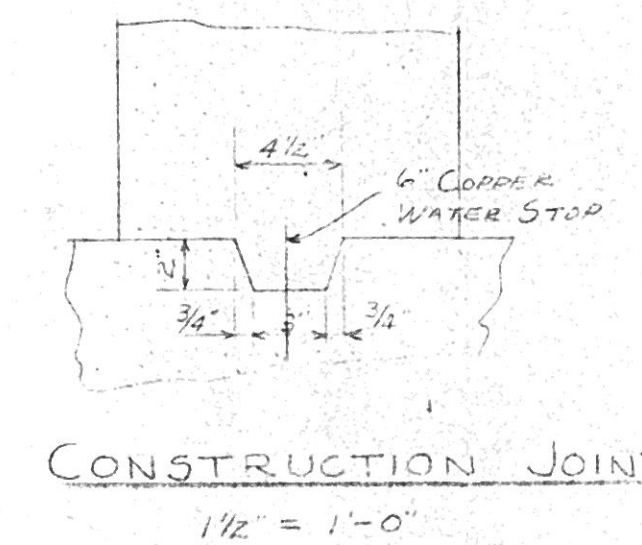
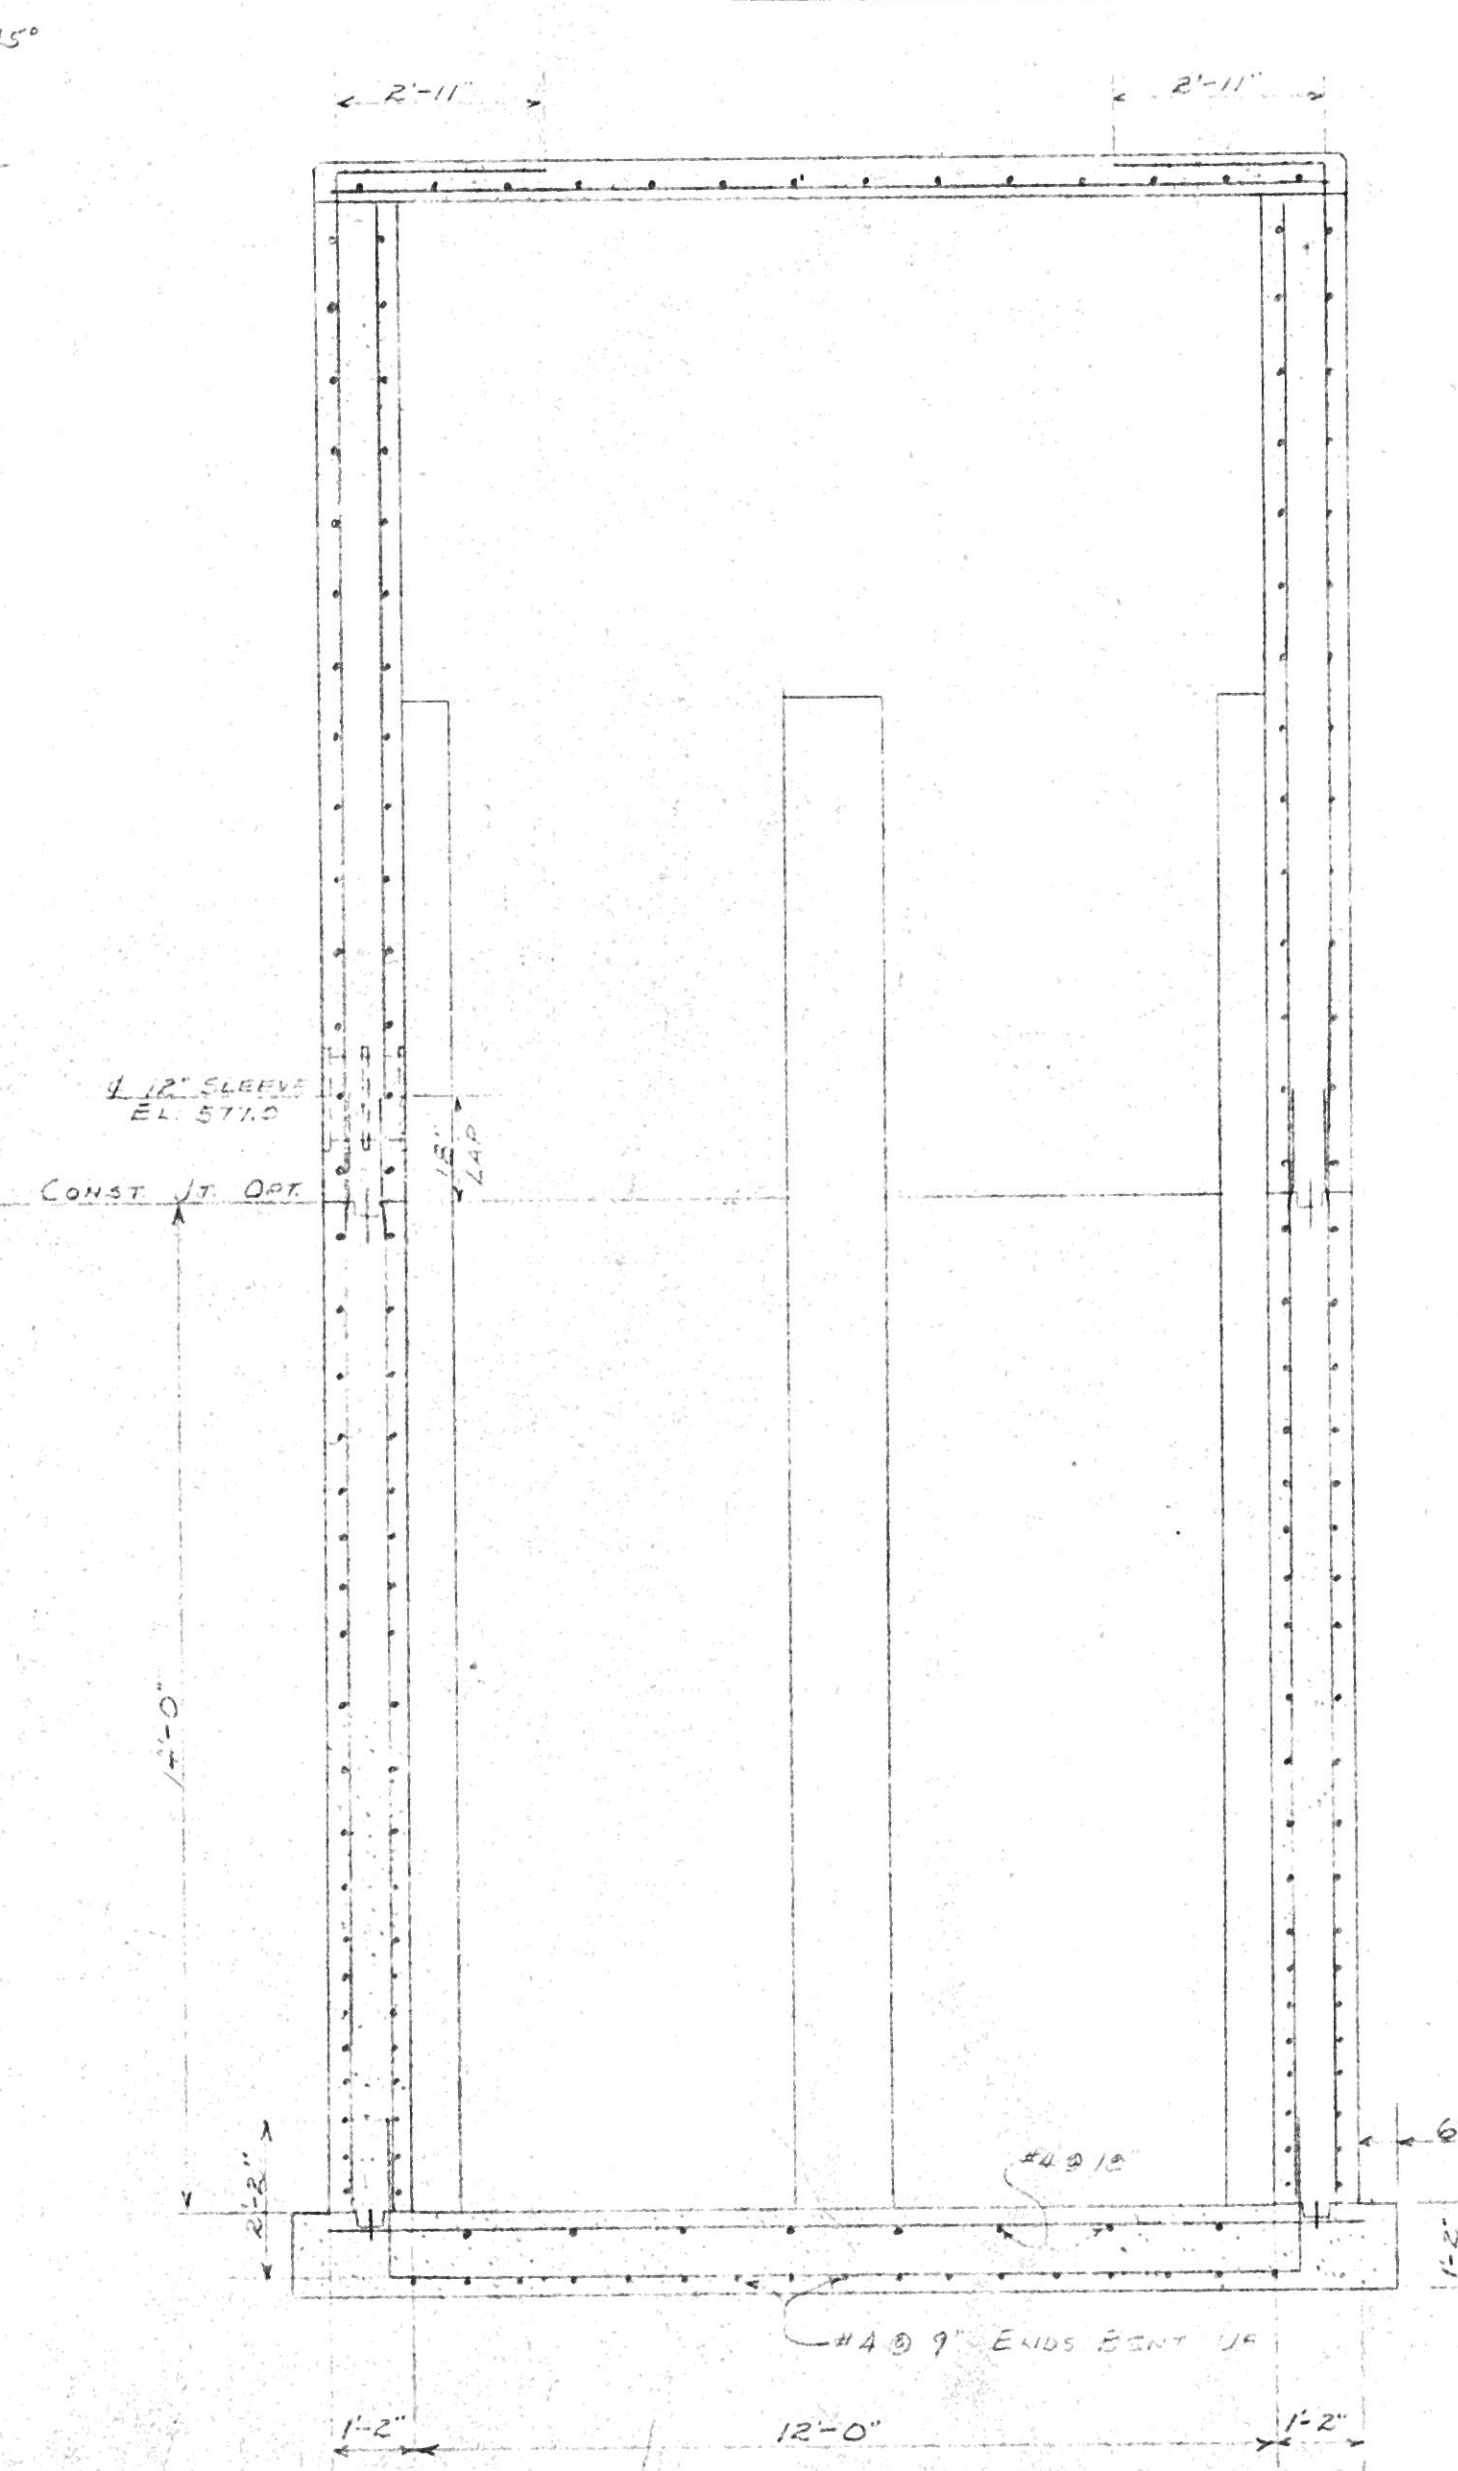
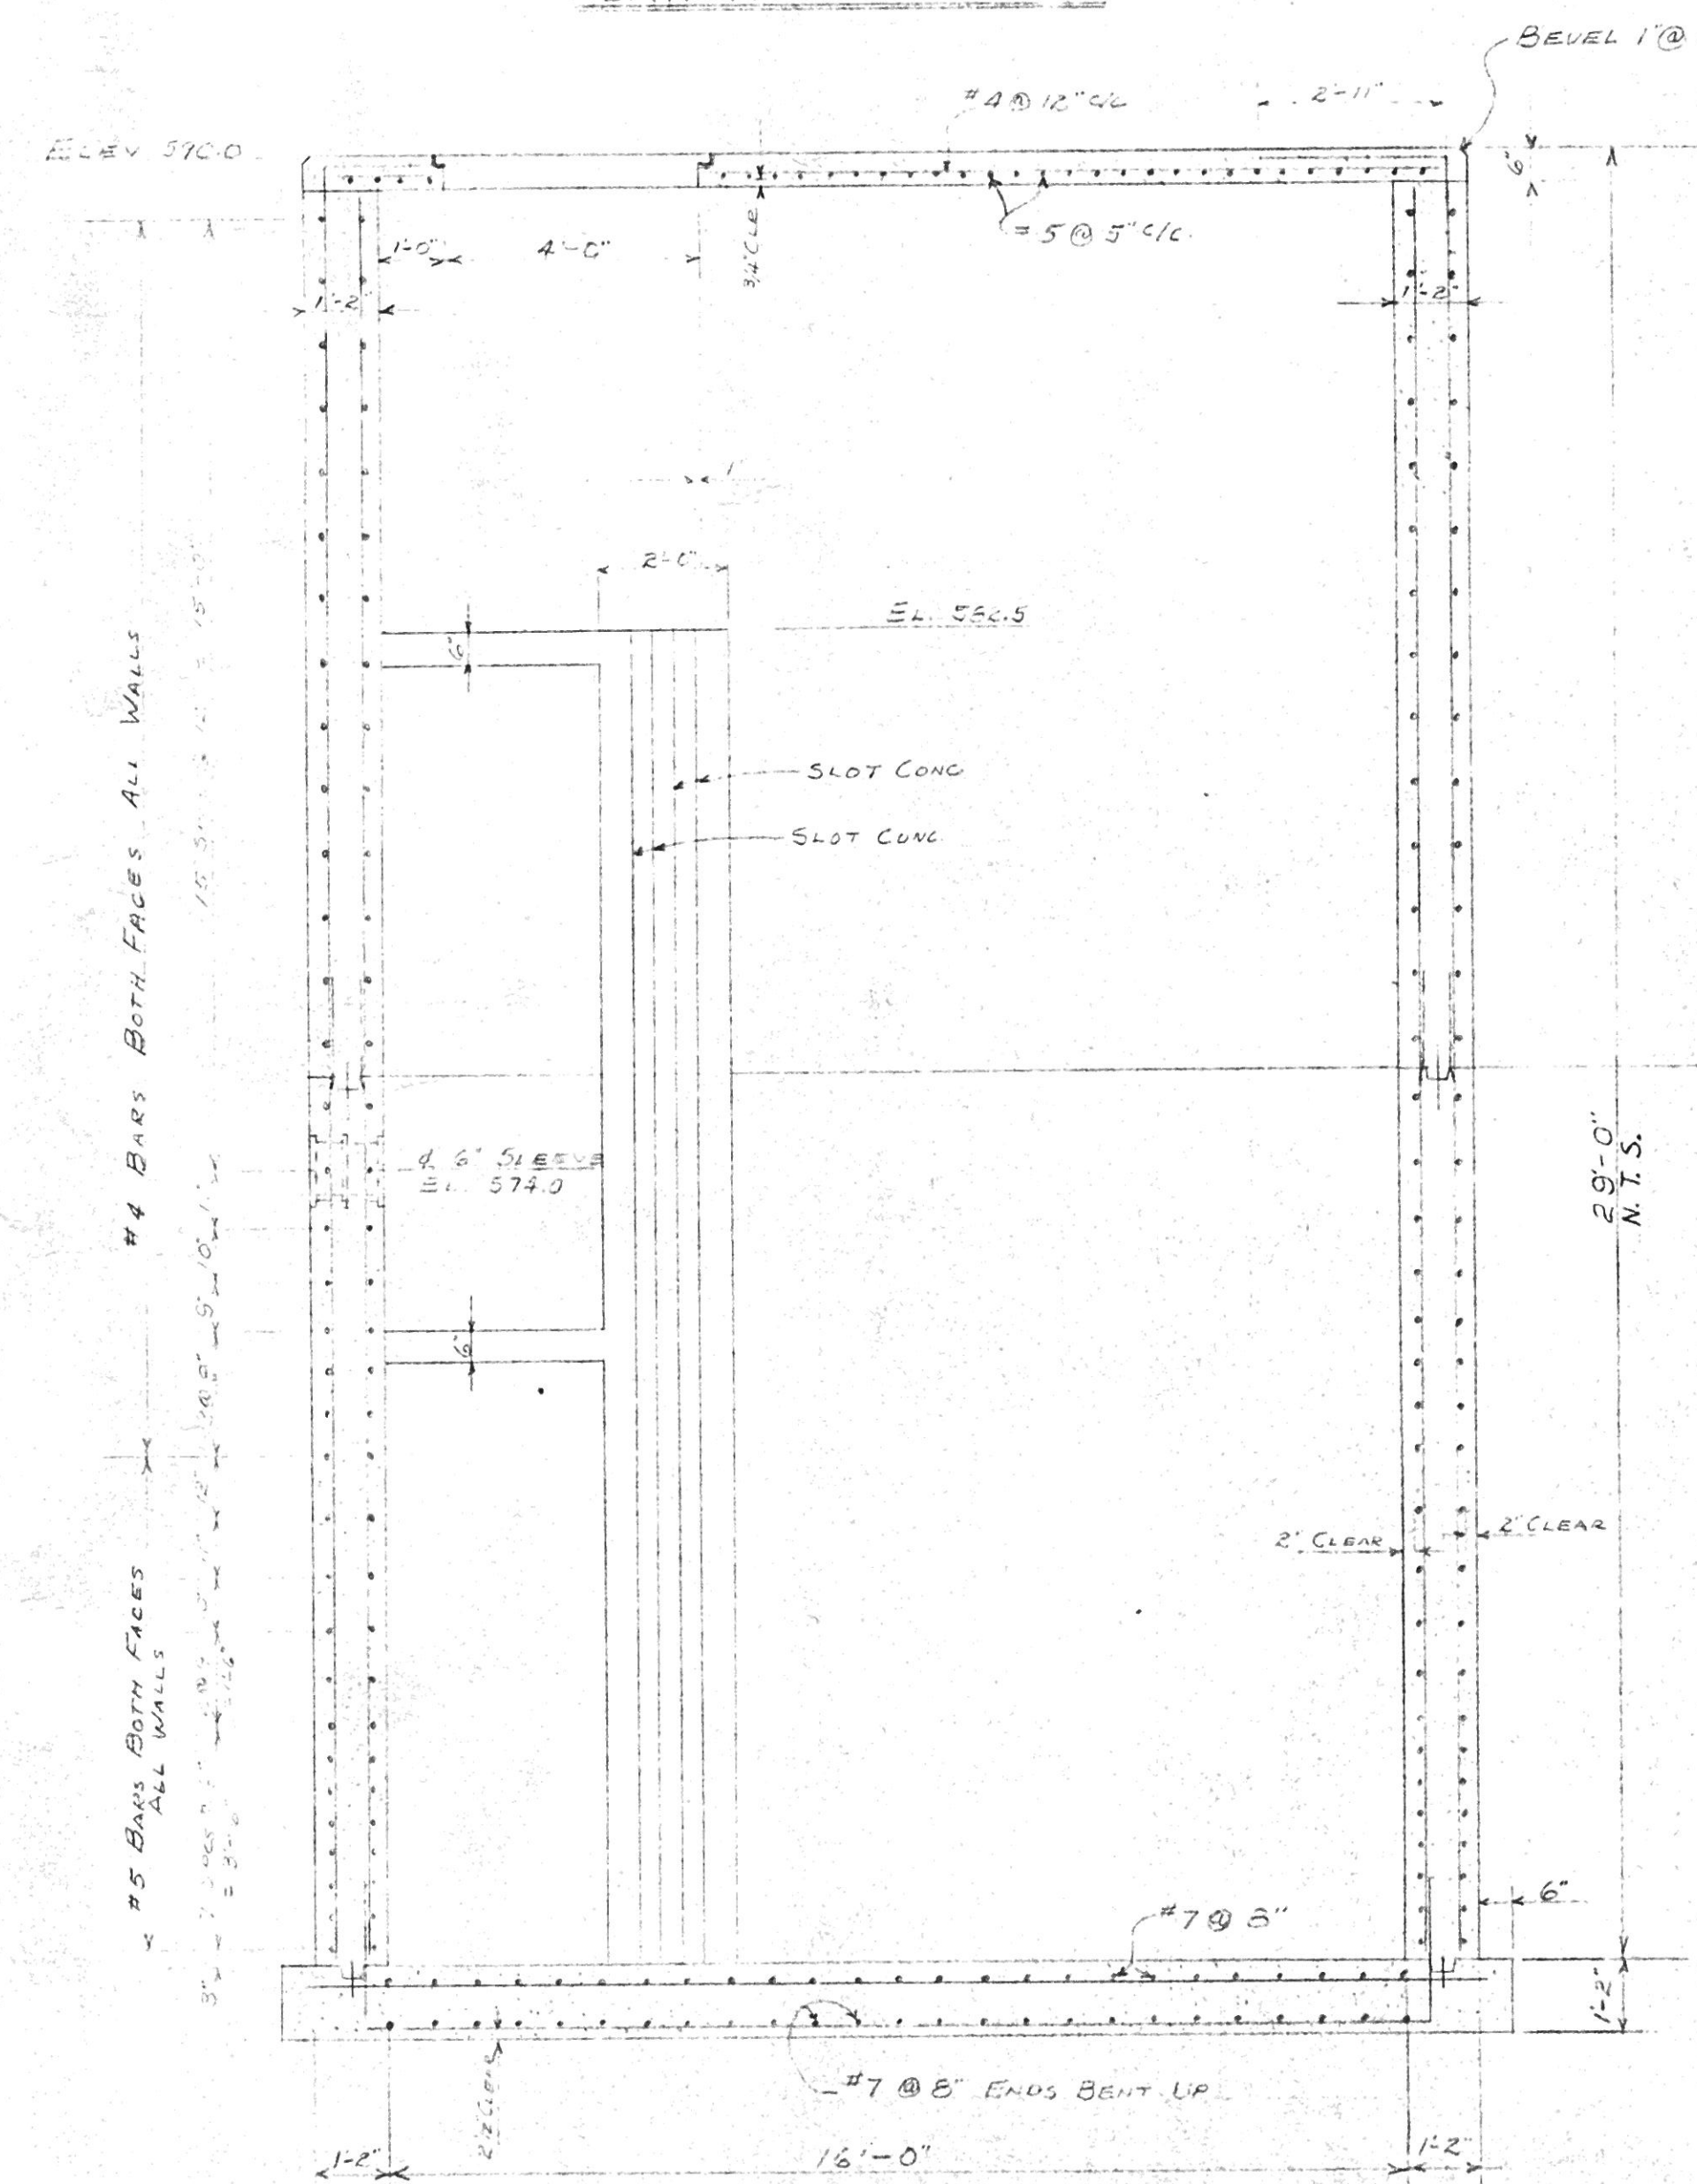
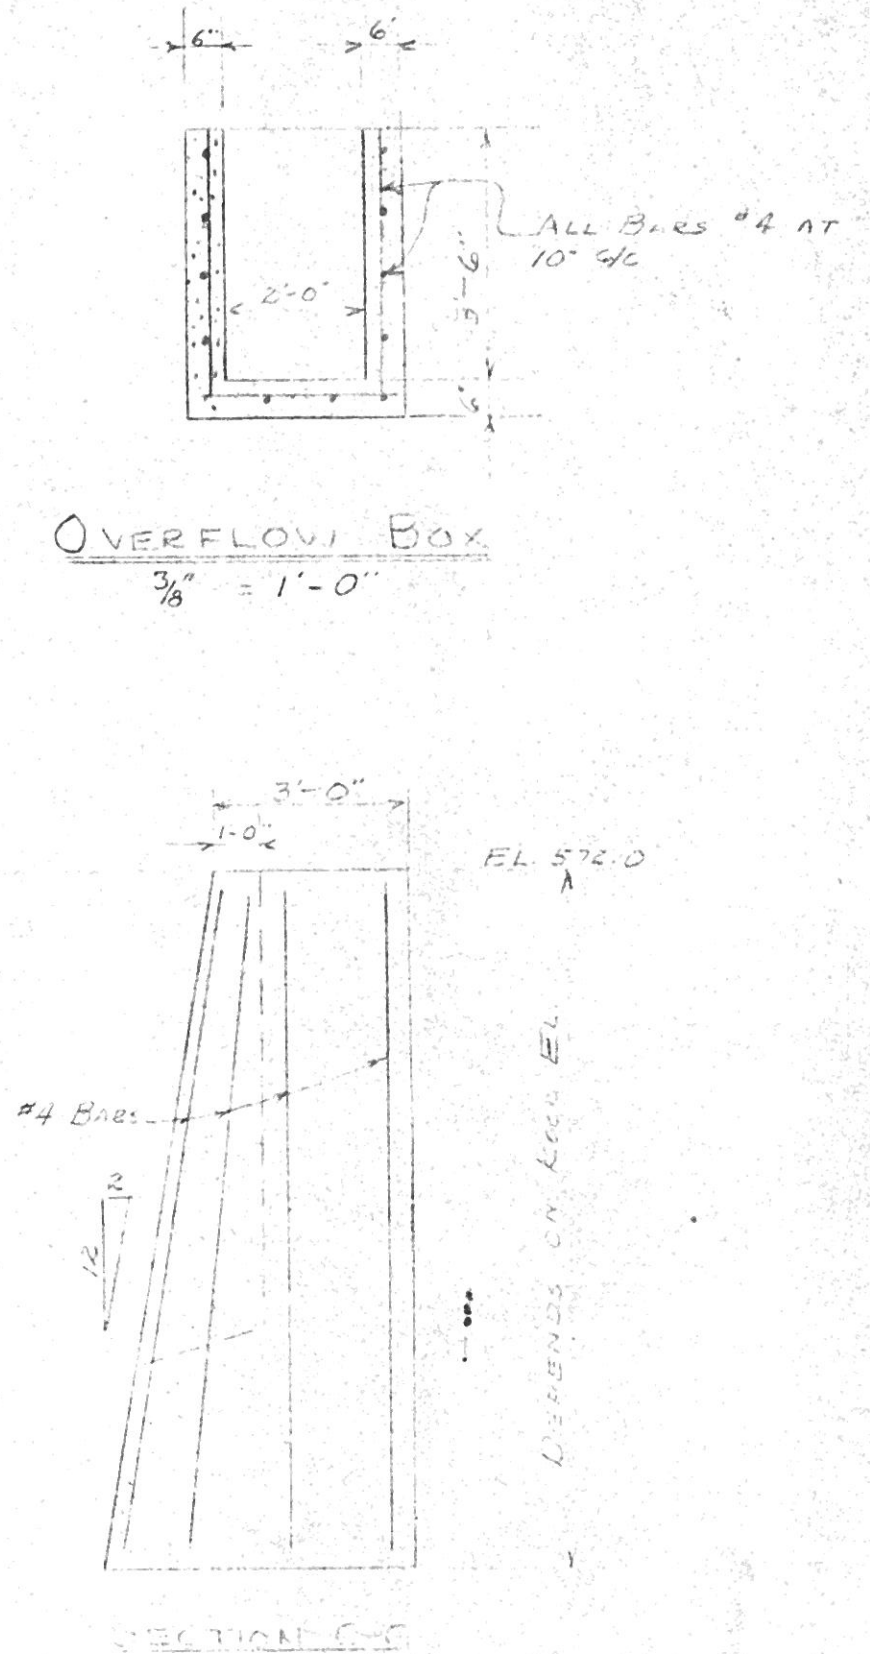
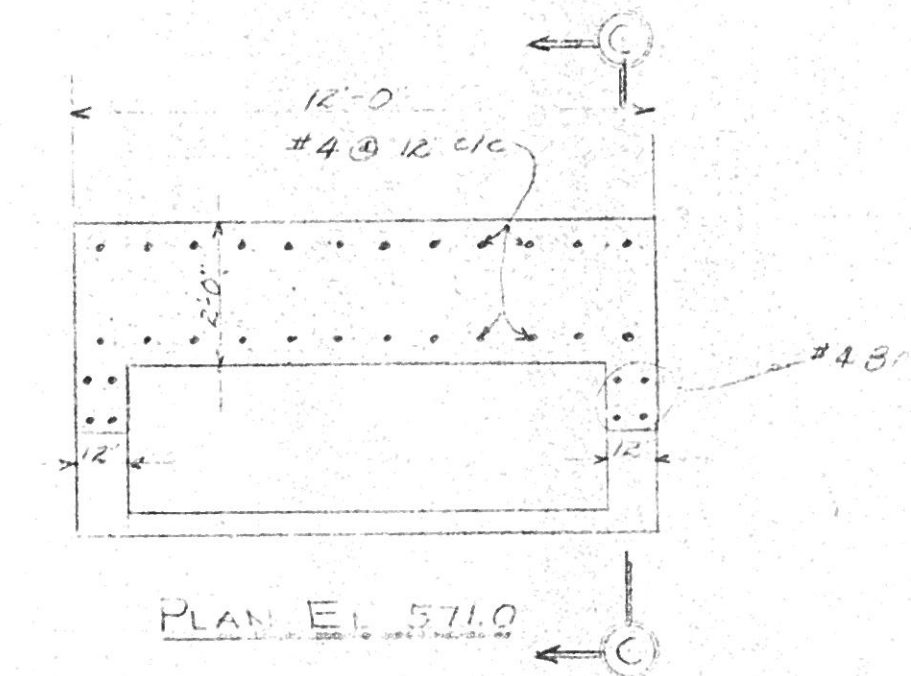
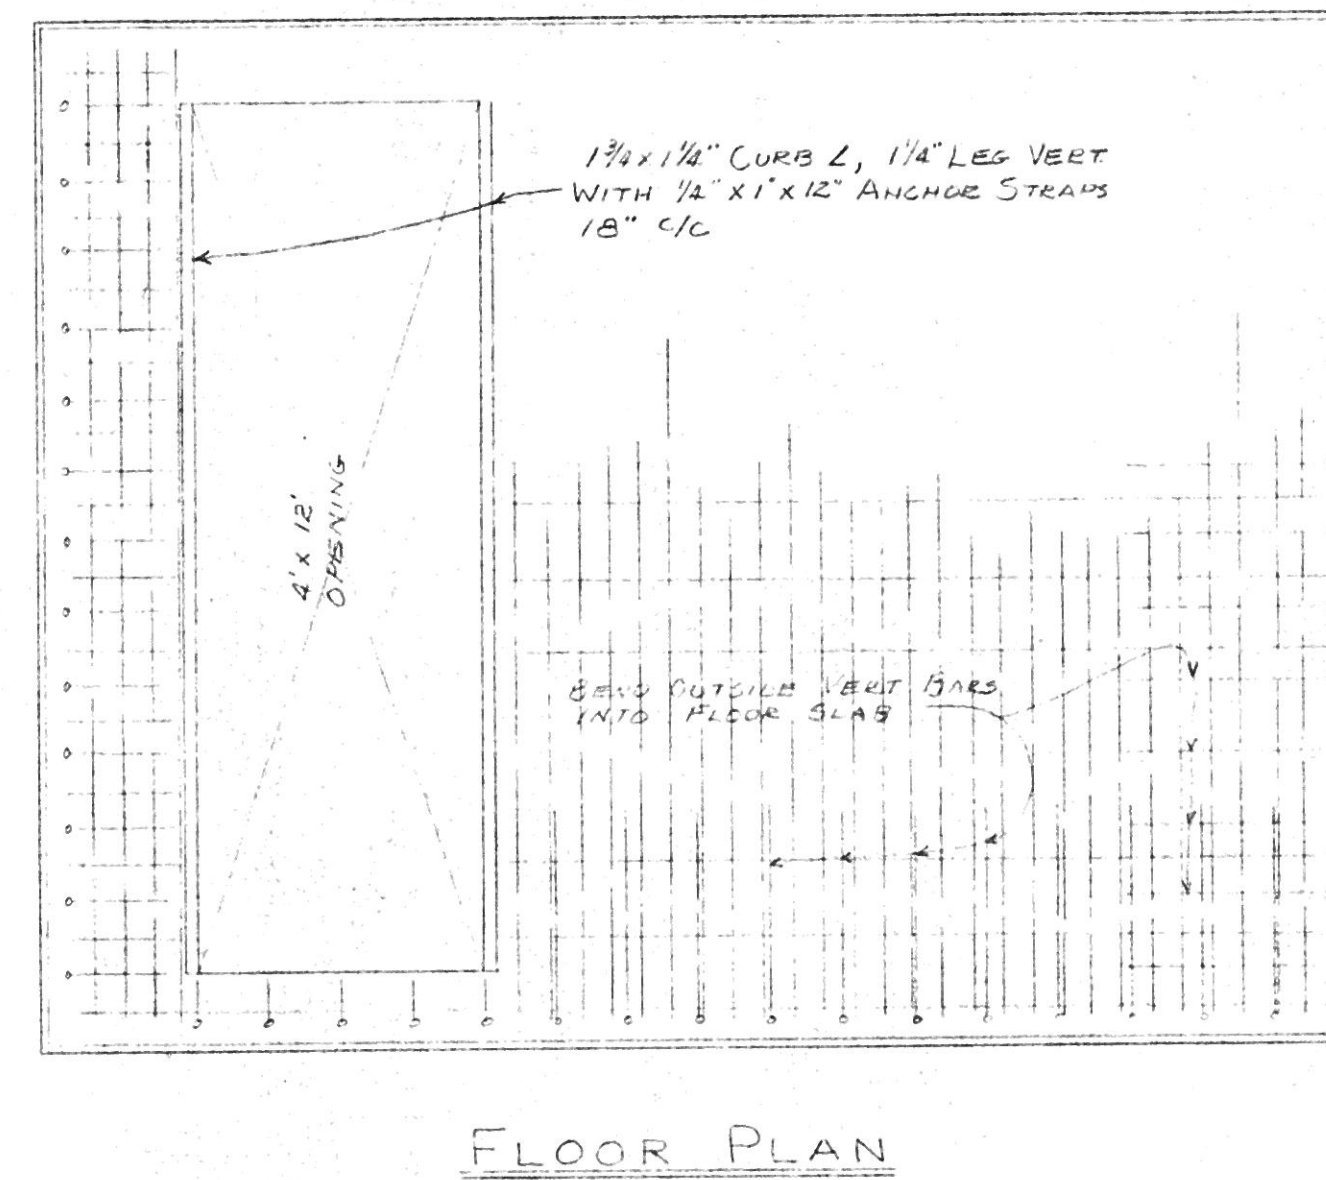
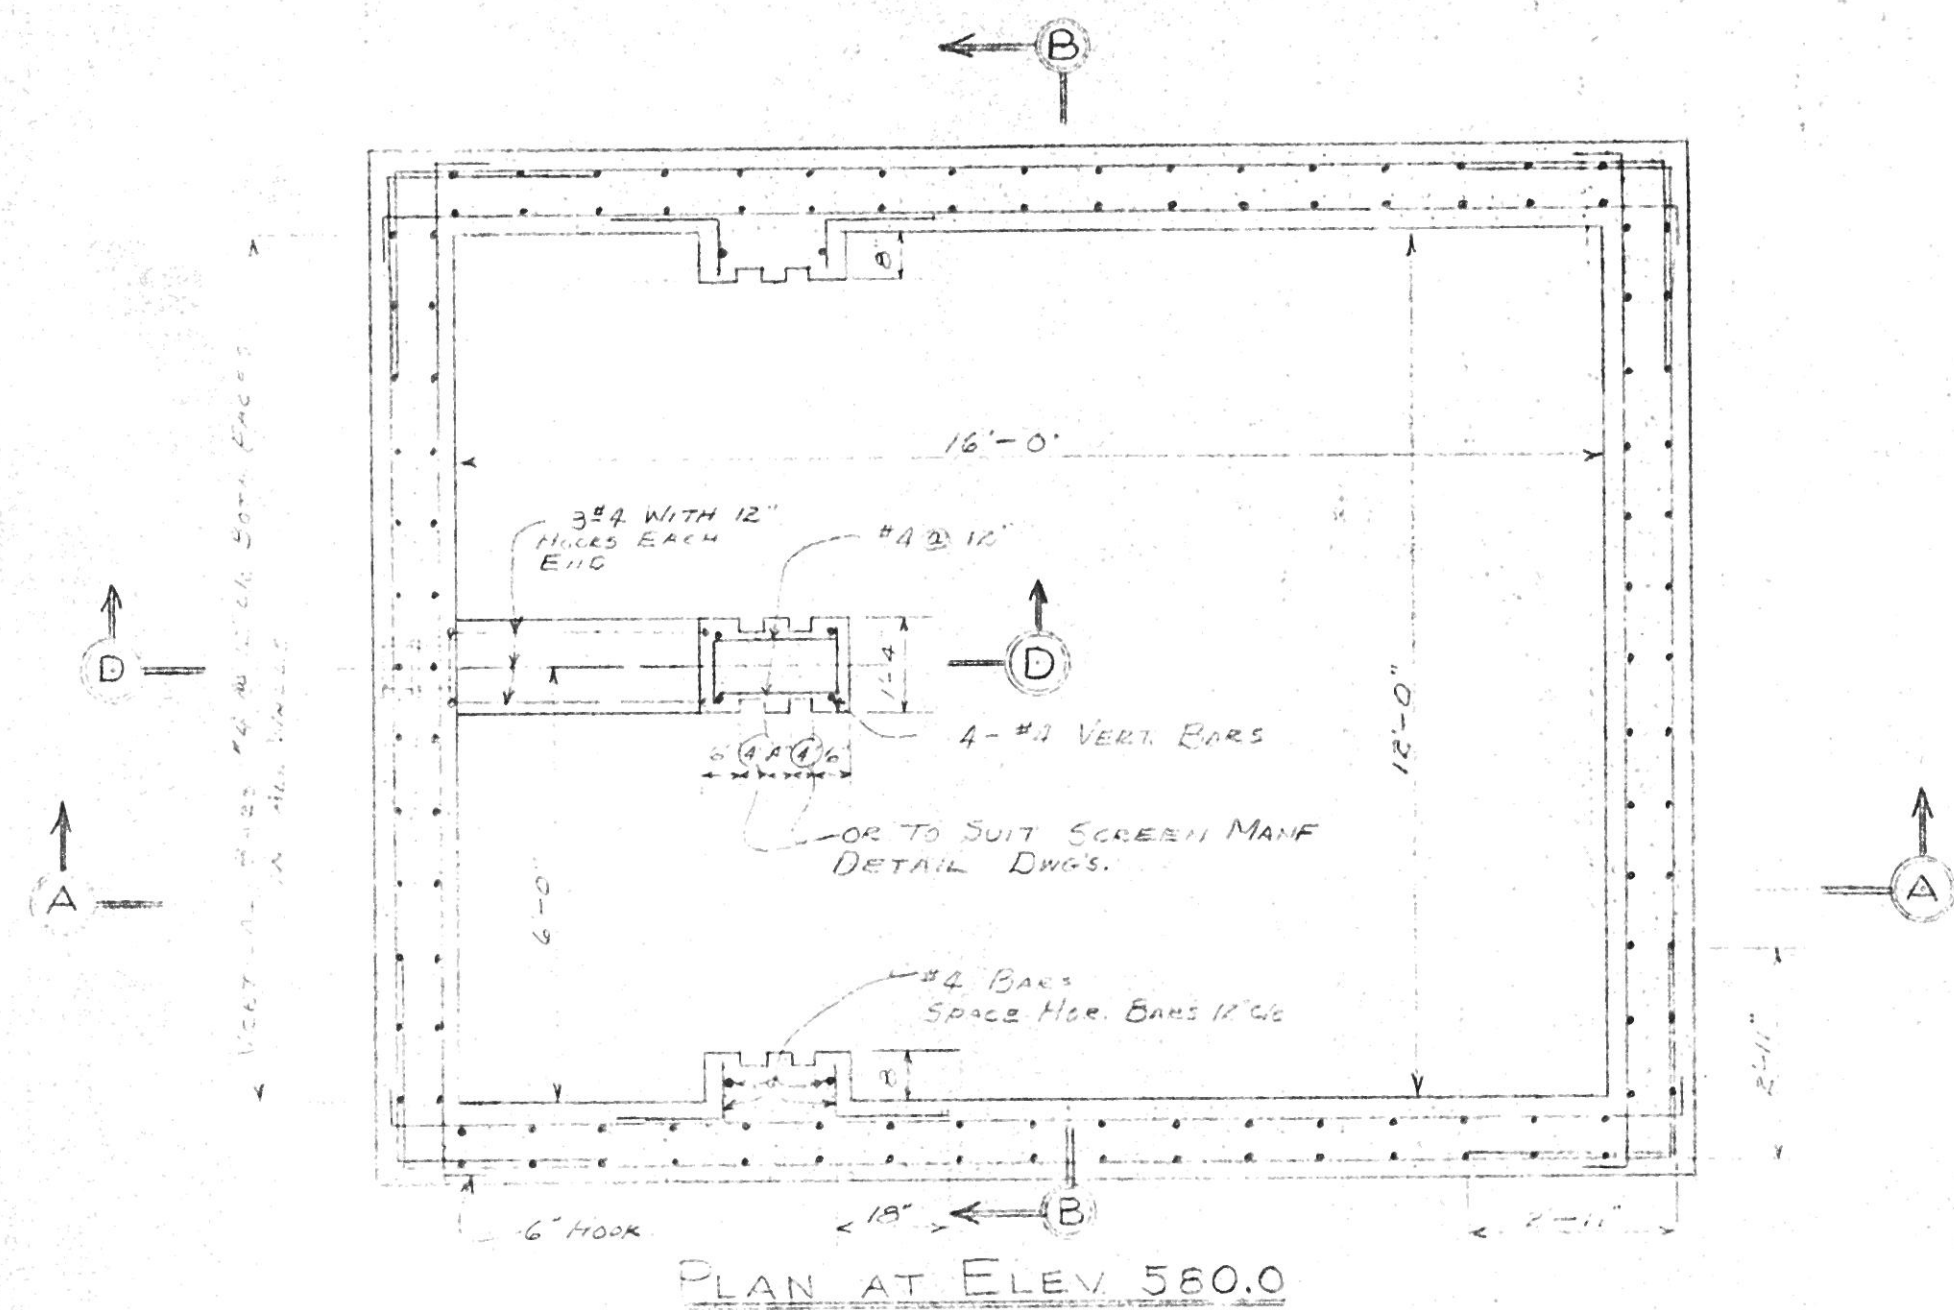


|                                                                                         |                                                 |                    |
|-----------------------------------------------------------------------------------------|-------------------------------------------------|--------------------|
| MUNICIPAL UTILITIES COMMISSION<br>CITY OF SAINT ALBANS<br>KANAWHA COUNTY, WEST VIRGINIA |                                                 |                    |
| WATER PROJECT<br>LOWER FALLS INTAKE                                                     |                                                 |                    |
| DATE<br>JAN. 10, 1955                                                                   | SCALE<br>HORIZ. 1" = 10'-0"<br>VERT. 1" = 1'-0" | DWG. NO.<br>2107-0 |
| W.D. KELLEY, CONSULTING ENGINEER<br>CHARLESTON, WEST VIRGINIA                           |                                                 |                    |