
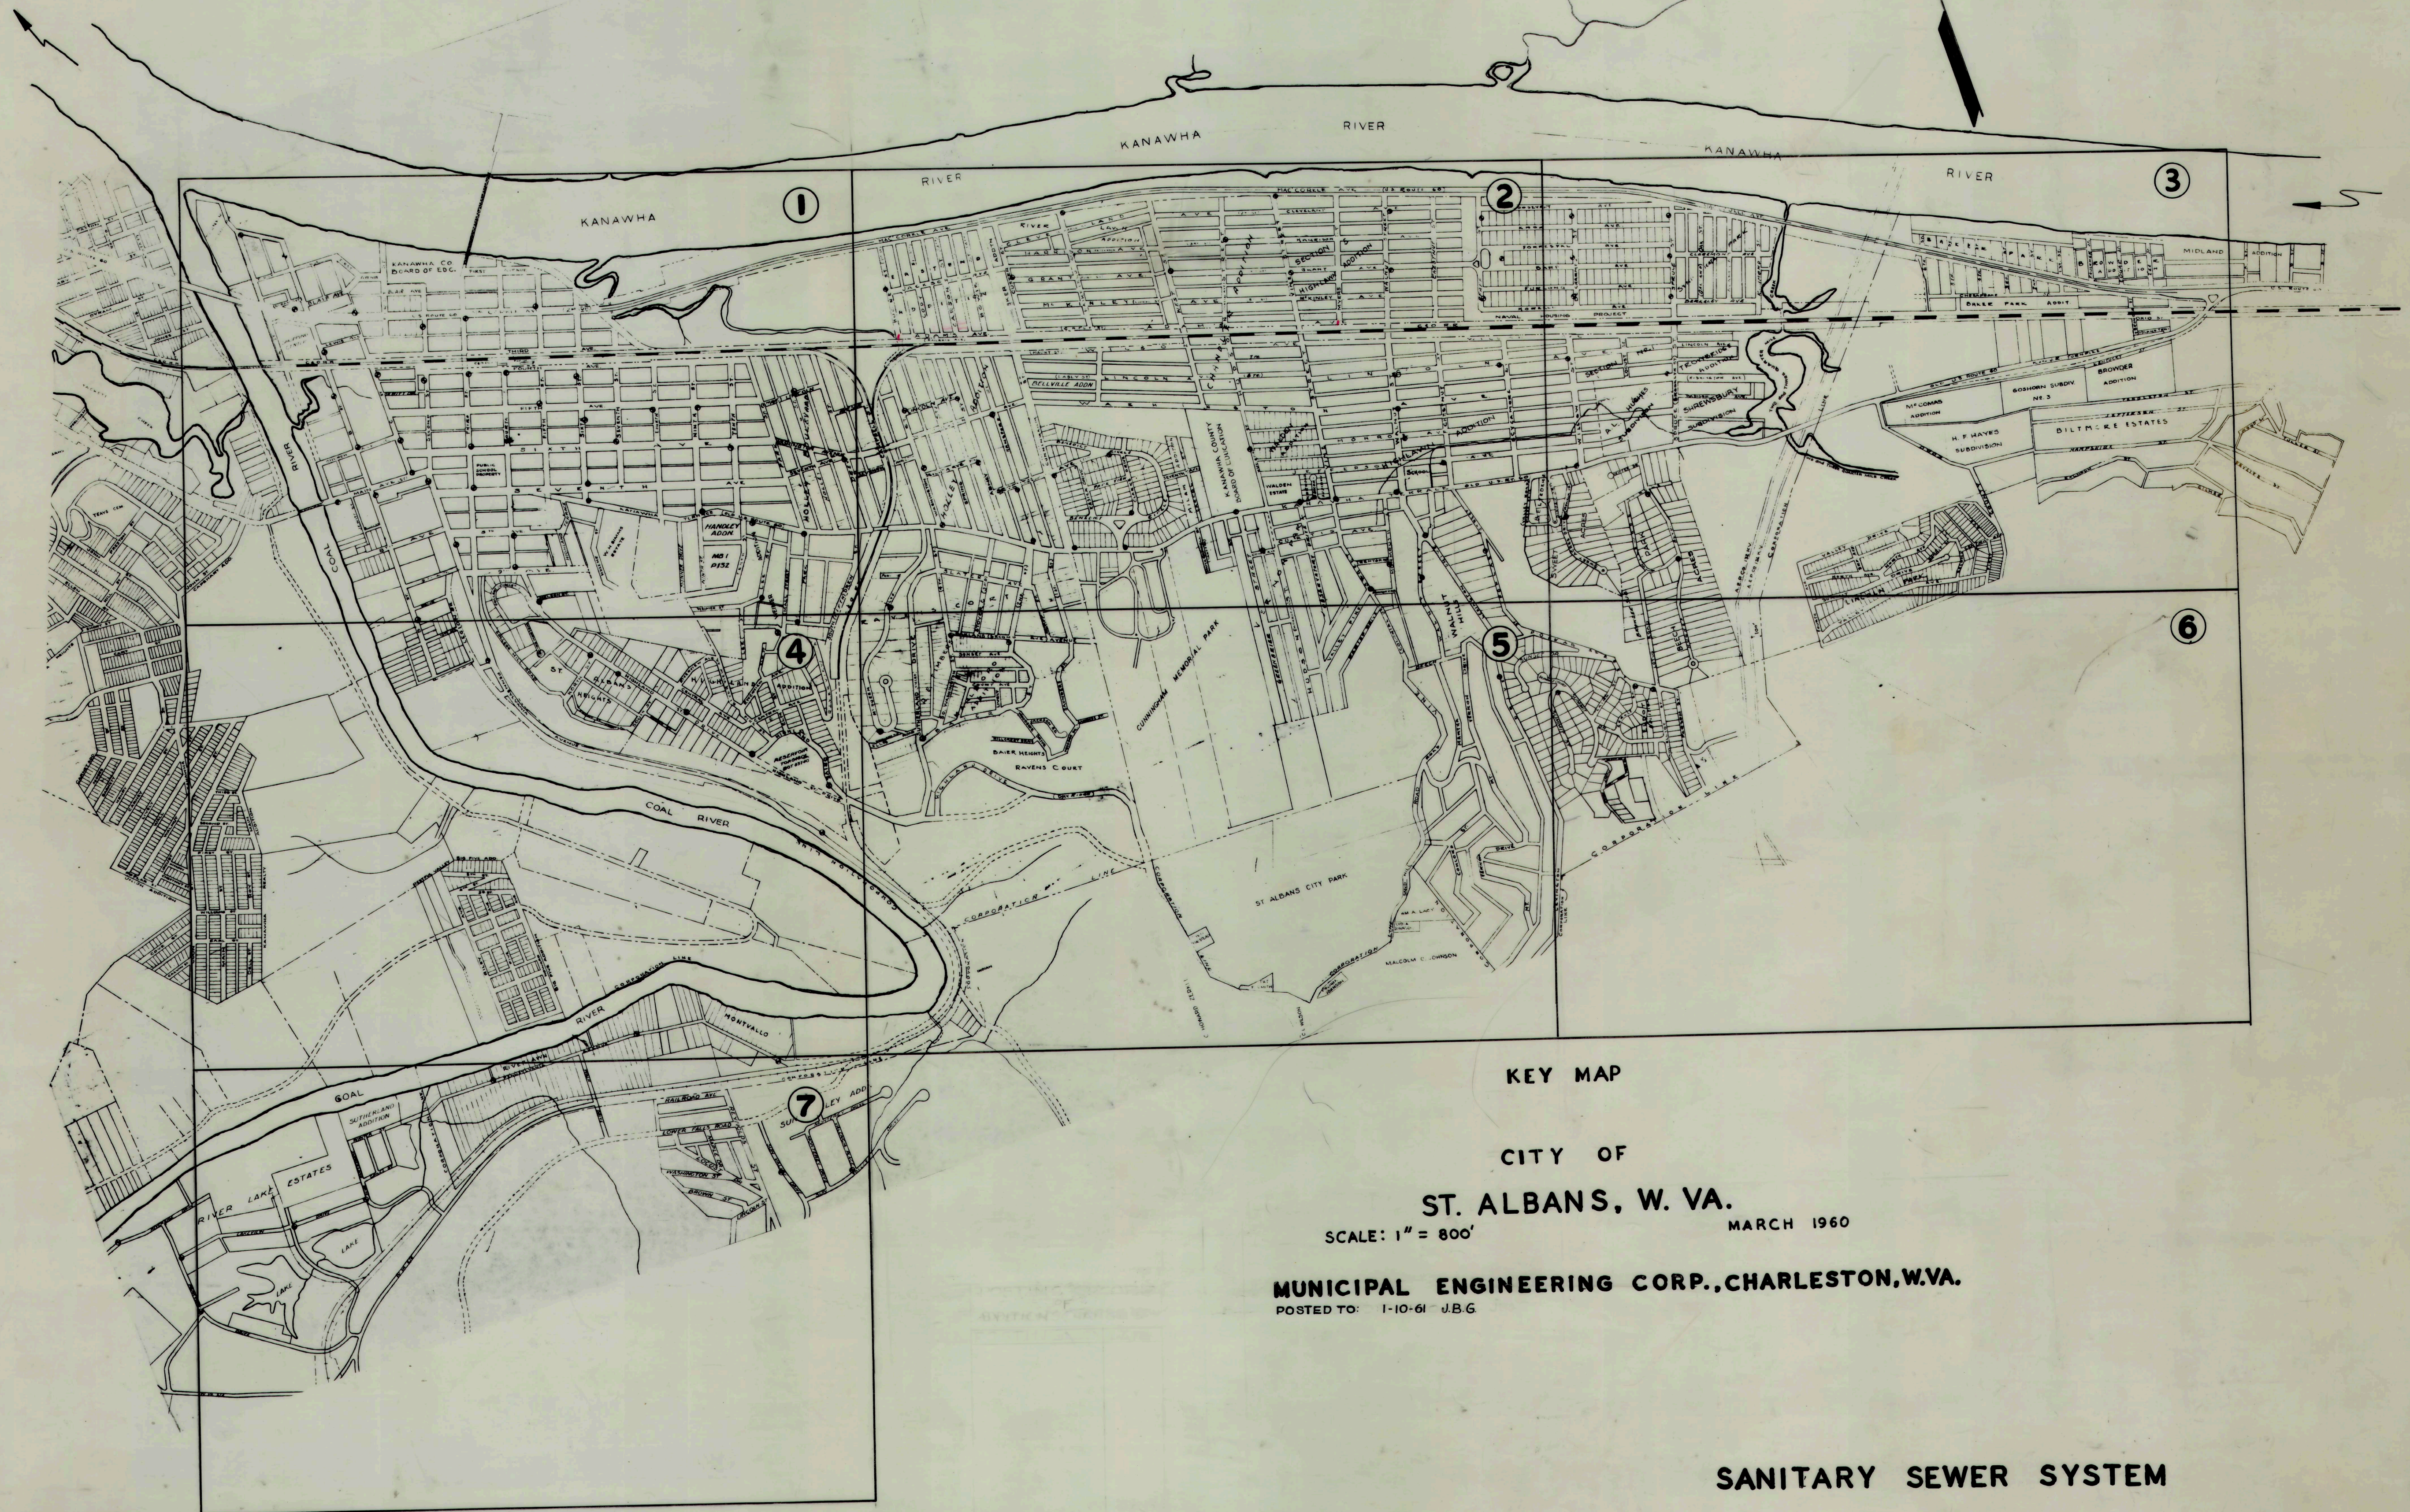


THE MUNICIPAL UTILITY COMMISSION OF THE CITY OF ST. ALBANS
FRANK E. OLIVER
B. J. COTTRELL
W. R. THOMAS
G. H. ELLIS
H. F. STUHR, JR.

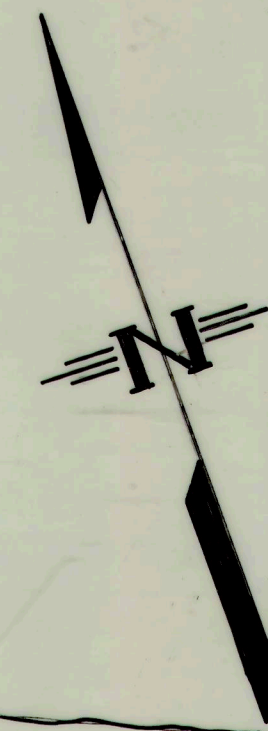

KEY MAP

CITY OF
ST. ALBANS, W. VA.

SCALE: 1" = 800'

MARCH 1960

MUNICIPAL ENGINEERING CORP., CHARLESTON, W. VA.
POSTED TO: 1-10-61 J.B.G.

SANITARY SEWER SYSTEM