


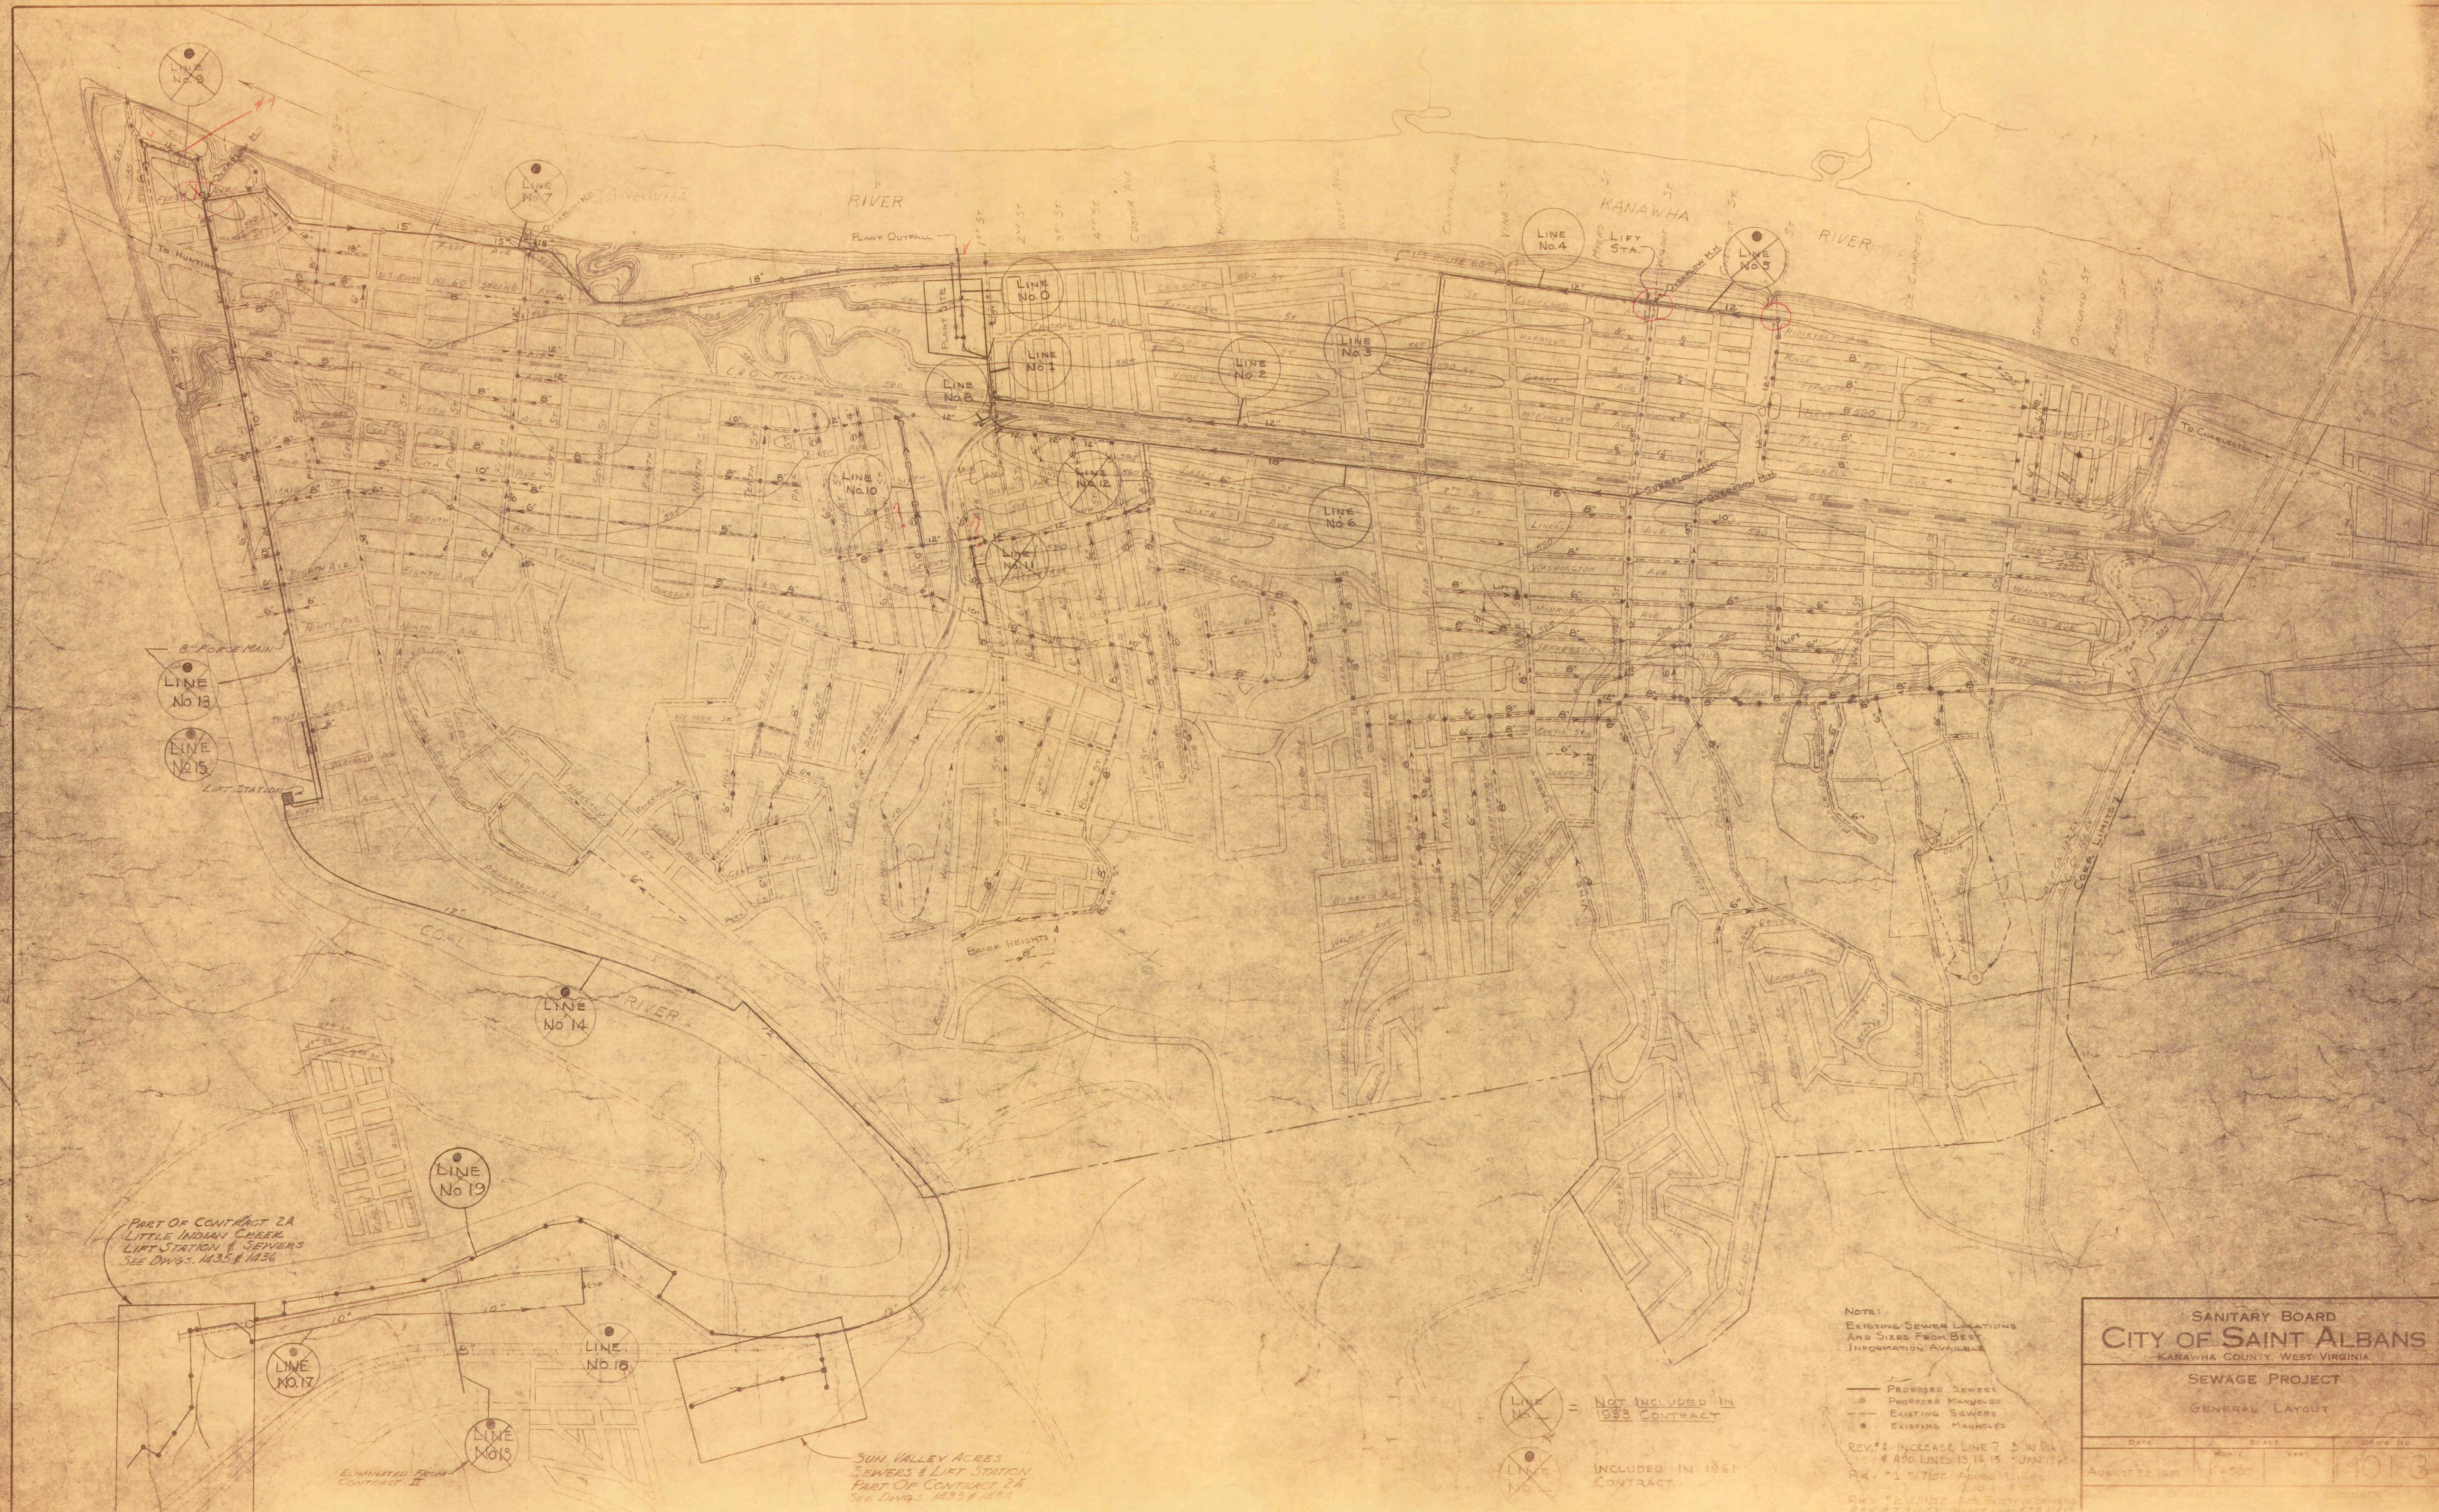

PART OF CONTRACT 2A
LITTLE INDIAN CREEK
LIFT STATION & SEWERS
SEE DWGS. 1435 & 1436

ELIMINATED FROM
CONTRACT II

SUN VALLEY ACRES
SEWERS & LIFT STATION
PART OF CONTRACT 2A
SEE DWGS. 1433 & 1434

LINE NO. 13 = NOT INCLUDED IN 1933 CONTRACT
LINE NO. 14 = INCLUDED IN 1961 CONTRACT

NOTE:
EXISTING SEWER LOCATIONS
AND SIZES FROM BEST
INFORMATION AVAILABLE

— PROPOSED SEWERS
• PROPOSED MANHOLES
— EXISTING SEWERS
• EXISTING MANHOLES

REV. #1 INCREASE LINE 7 3" IN DIA.
ADD LINES 13, 14, 15 - JAN 1961
REV. #1 5/11/62 APPROX. LINES
1, 10, 11, & 12
REV. #2 2/11/62 ADD EXISTING SEWERS
REV. #3 1/1/63 DELETE LINES 13, 14, 15

SANITARY BOARD CITY OF SAINT ALBANS KANAWHA COUNTY, WEST VIRGINIA			
SEWAGE PROJECT			
GENERAL LAYOUT			
DATE	SCALE	VERT.	DRAW. NO.
AUGUST 22, 1933	1" = 500'		14013