
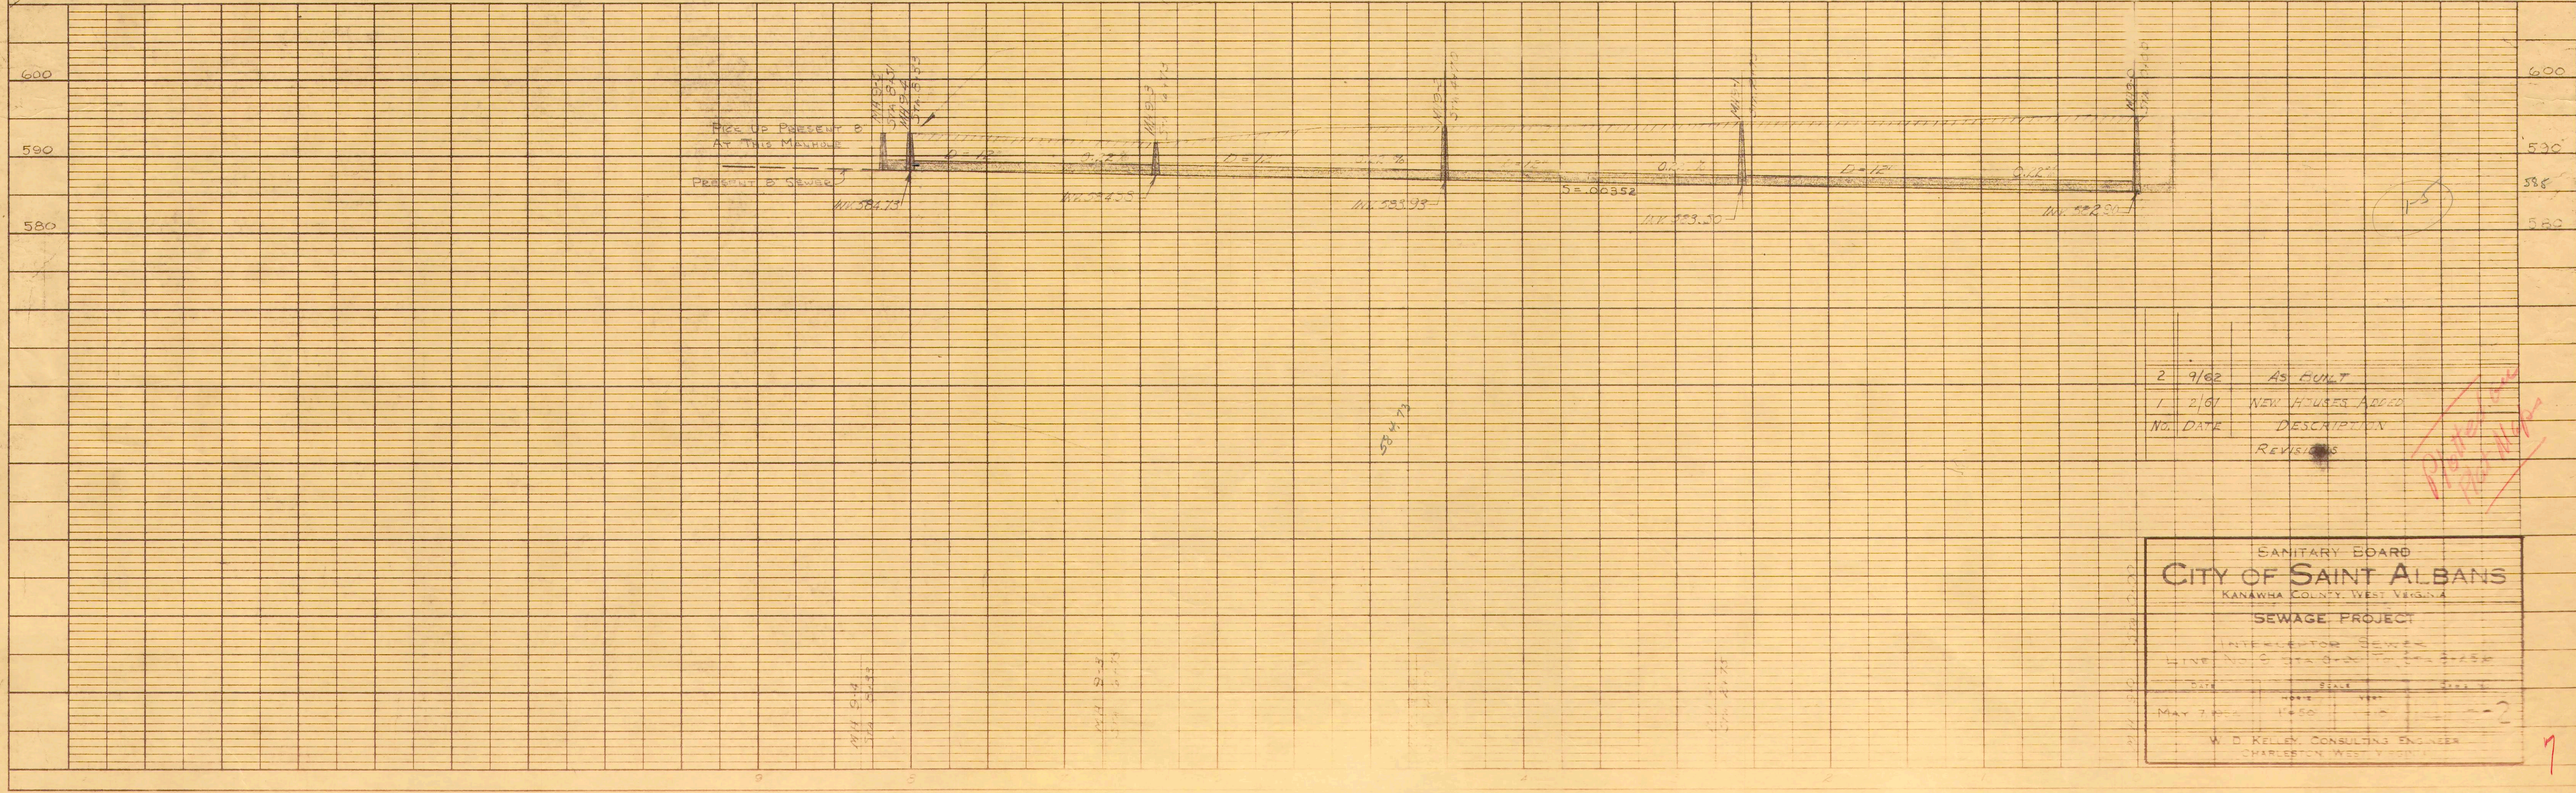


PLAN	DATE	
	BY	
	SURVEYED	
	NOTED	
NOTE BOOK	NO.	
	DATE	
	BY	
	NOTED	

PROFILE	DATE	
	BY	
	SURVEYED	
	NOTED	
NOTE BOOK	NO.	
	DATE	
	BY	
	NOTED	

NOTE: WYES AND CONNECTIONS TO HOUSE SEWERS SHOWN AS INSTALLED AS DIRECTED BY ENGINEER.

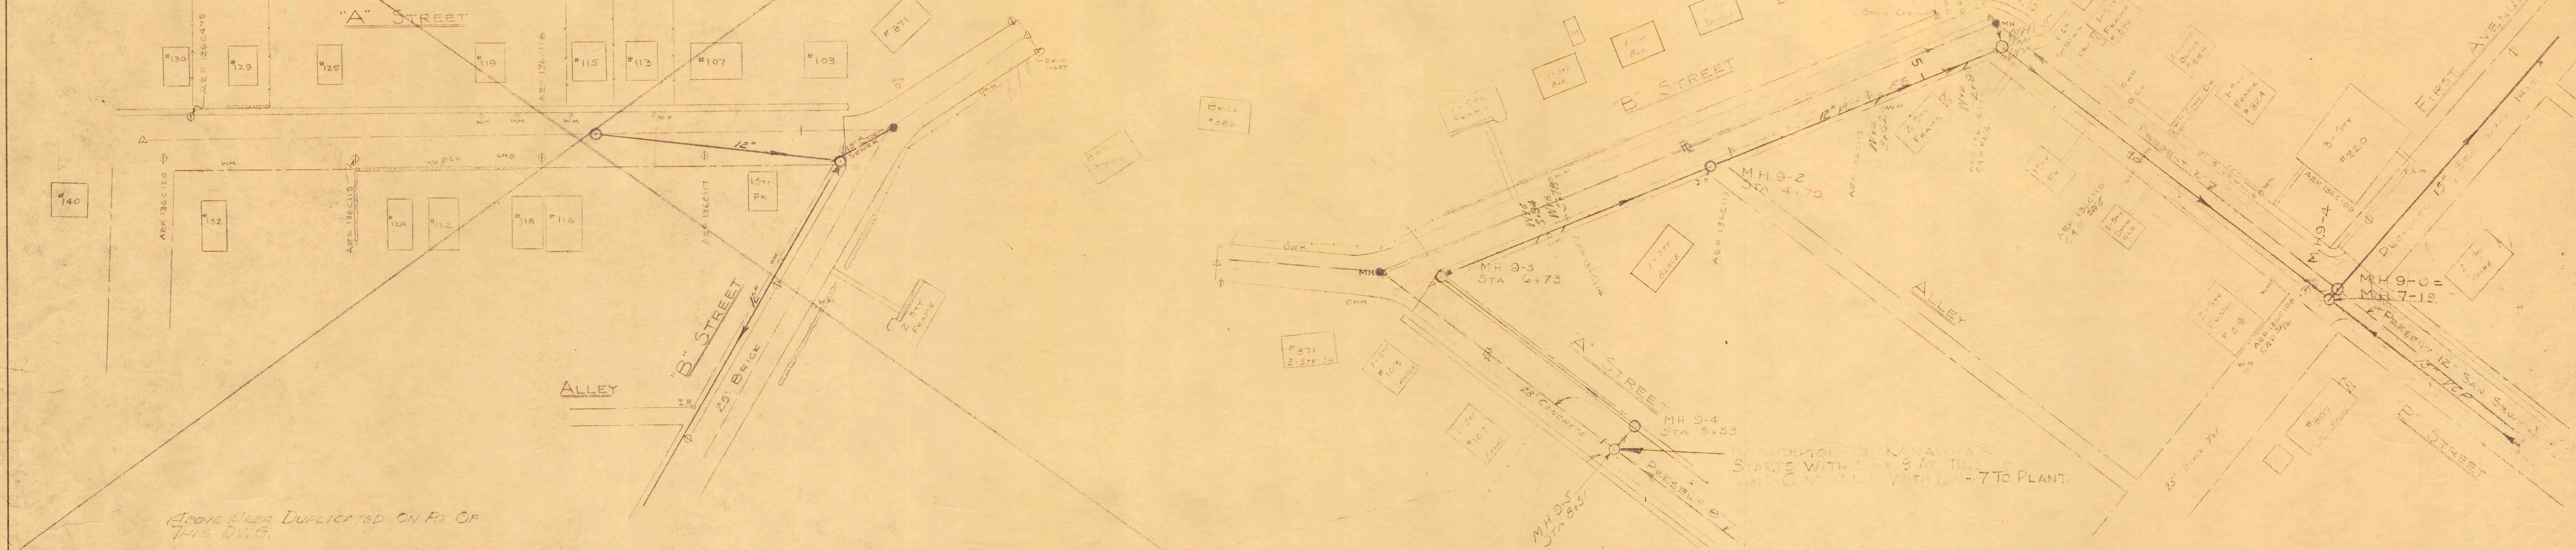

NO.	DATE	DESCRIPTION
2	9/62	AS PLANT
1	2/61	NEW HOUSES ADDED
		REVISIONS

SANITARY BOARD	
CITY OF SAINT ALBANS	
KANAWHA COUNTY, WEST VIRGINIA	
SEWAGE PROJECT	
INTERCEPTOR SEWER	
LINE NO. 9 STA. 0+00 TO STA. 2+00	
DATE	SCALE
MAY 7, 1960	1" = 40'
W. D. KELLEY, CONSULTING ENGINEER	
CHARLESTON, WEST VIRGINIA	