



CONCRETE PIPE MANHOLES

BRICK MANHOLES


NOTE: BRICK MANHOLES TO BE CONSTRUCTED ONLY UNDER SPECIAL CONDITIONS AS DIRECTED BY ENGINEER.

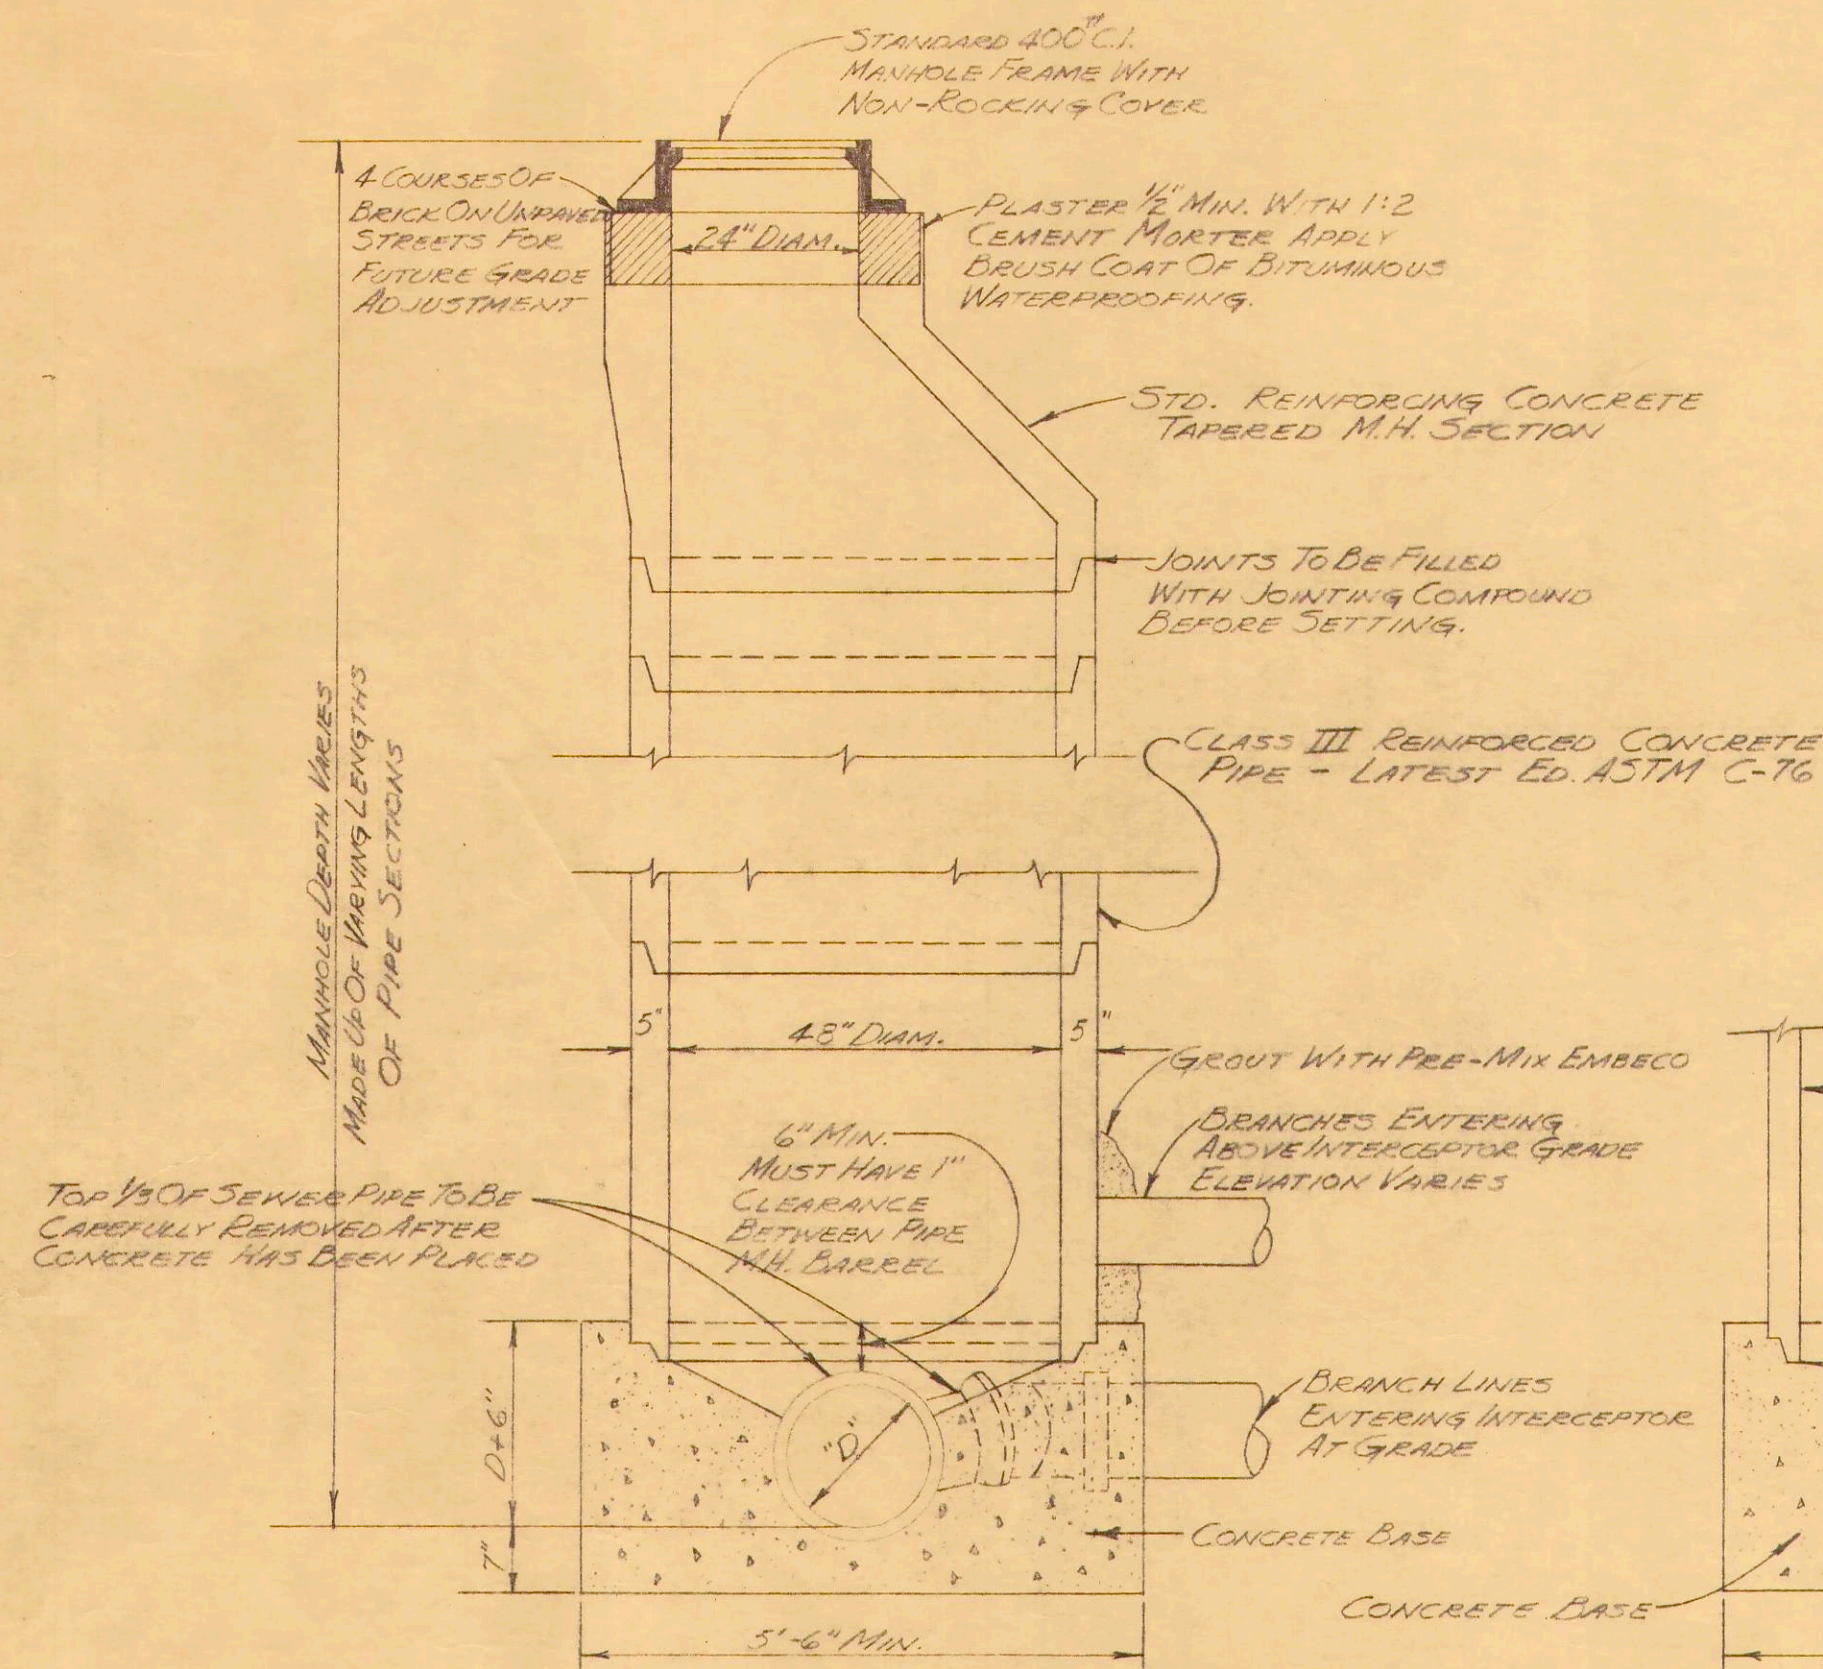


TRANSVERSE SECTION
TYPE "A"
SCALE: 1/2"=1'-0"

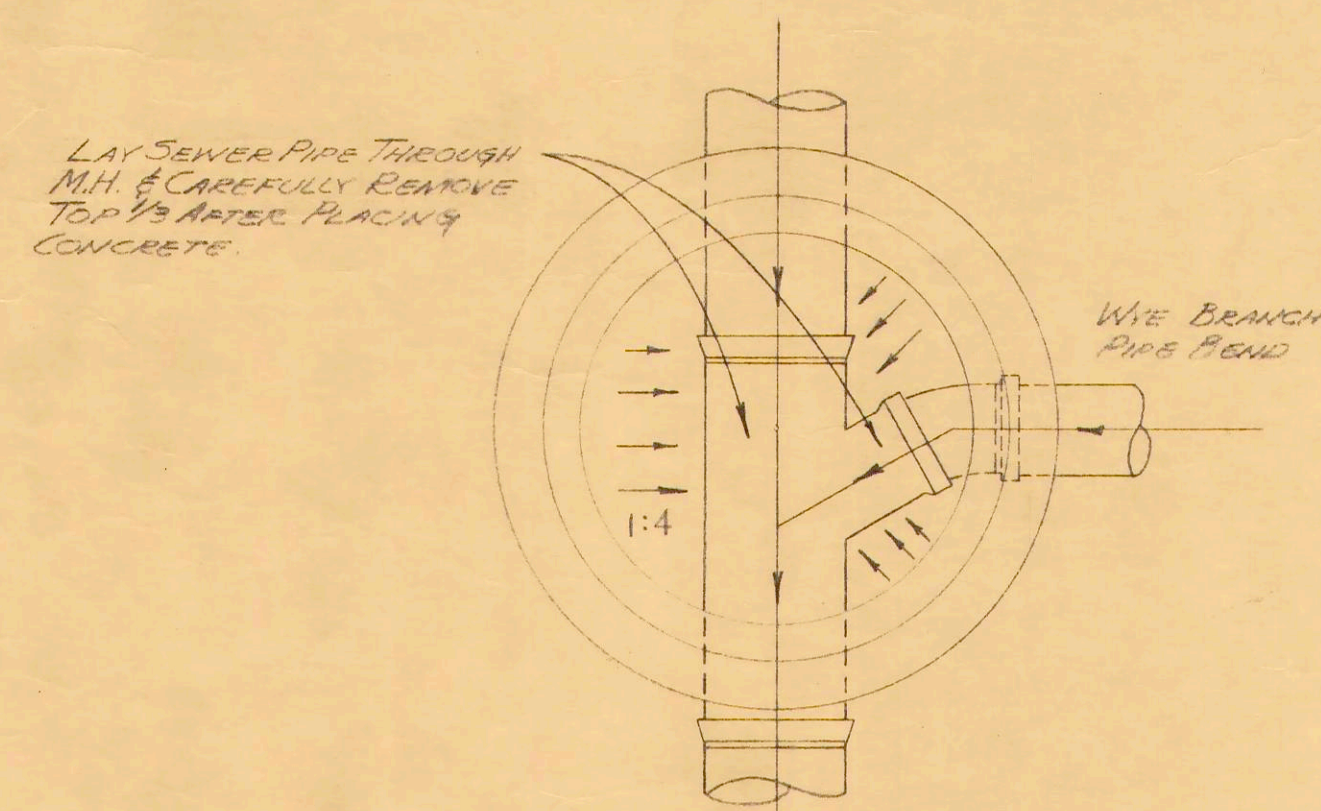


BASE PLAN
JUNCTION MH, TYPE "A"

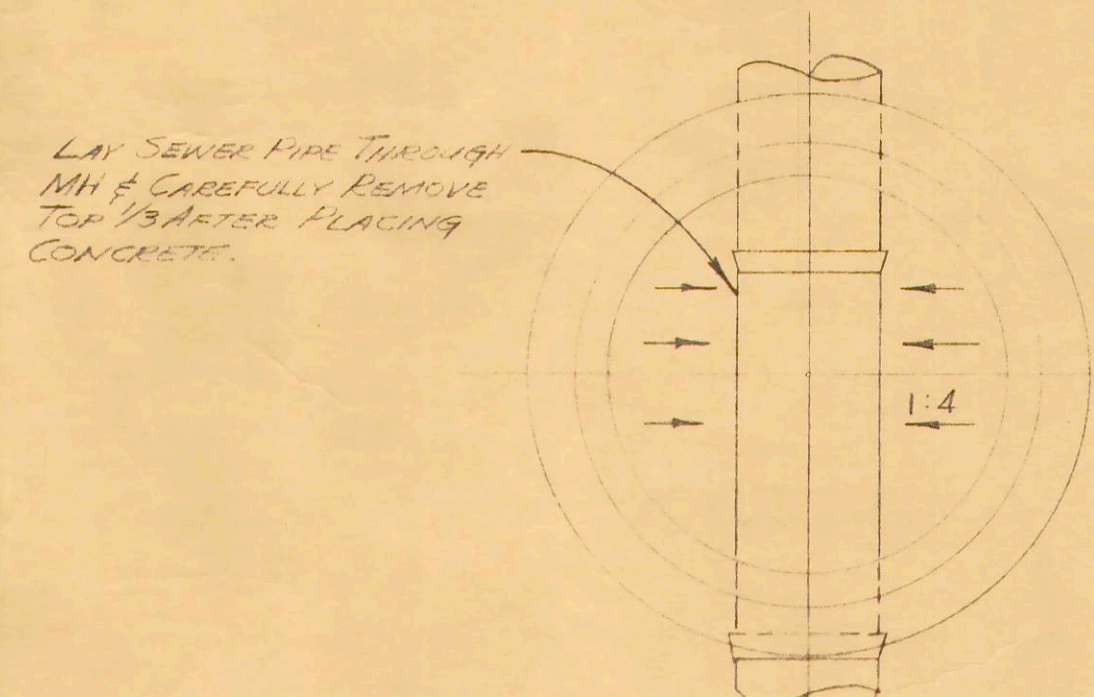


BASE PLAN
LINE MANHOLE - TYPE "A"

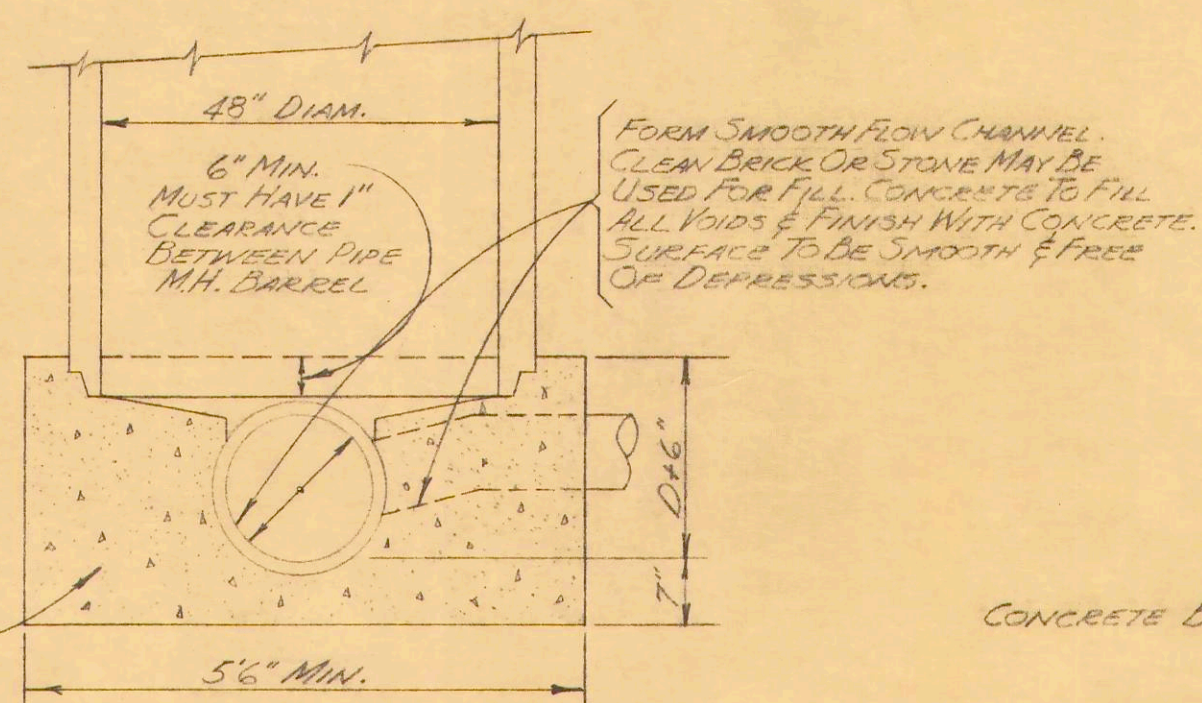


TRANSVERSE SECTION
TYPE "D"
SCALE: 1/2"=1'-0"

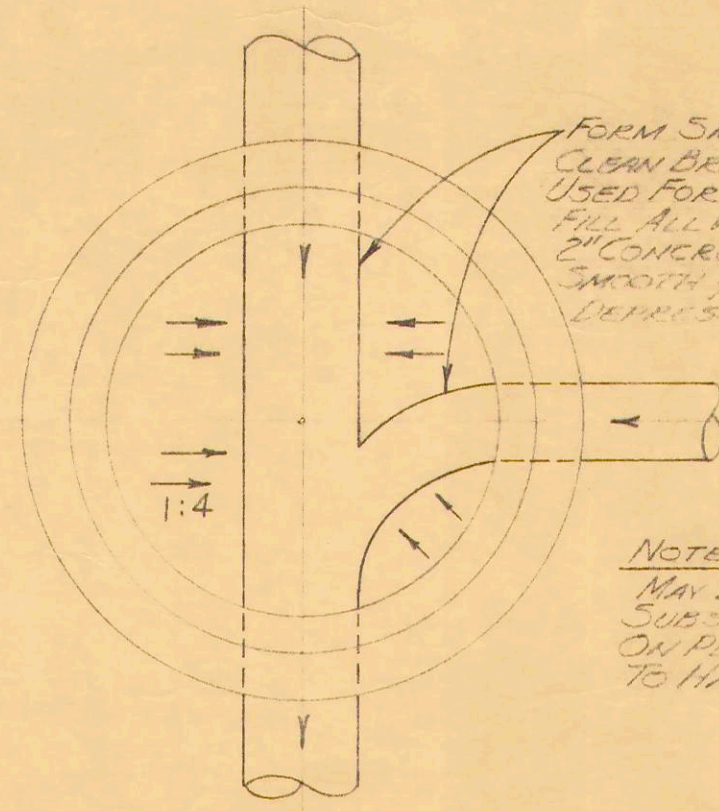


BASE PLAN
ALTERNATE JUNCTION MH, TYPE "D"

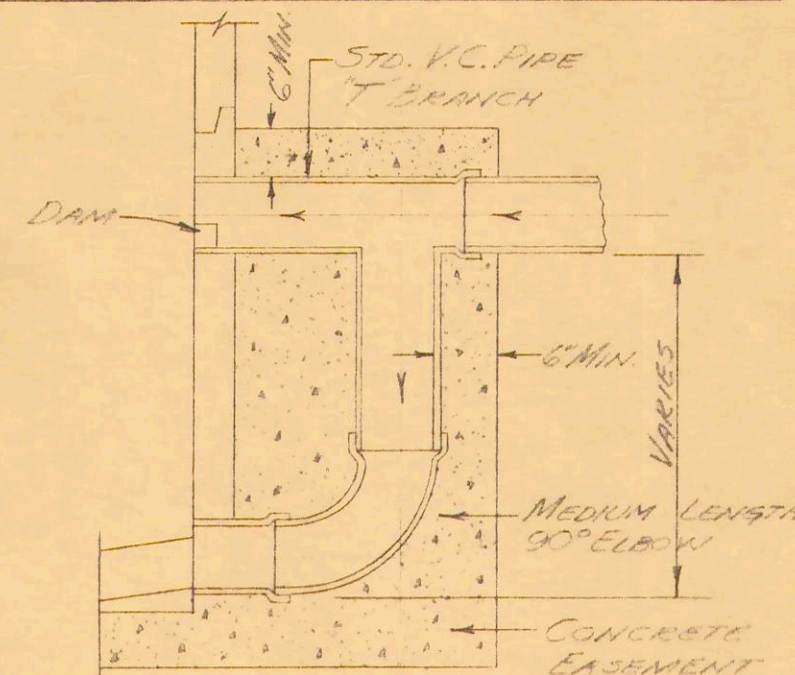


SECTION
TYPICAL DROP CONNECTION
TO MANHOLE

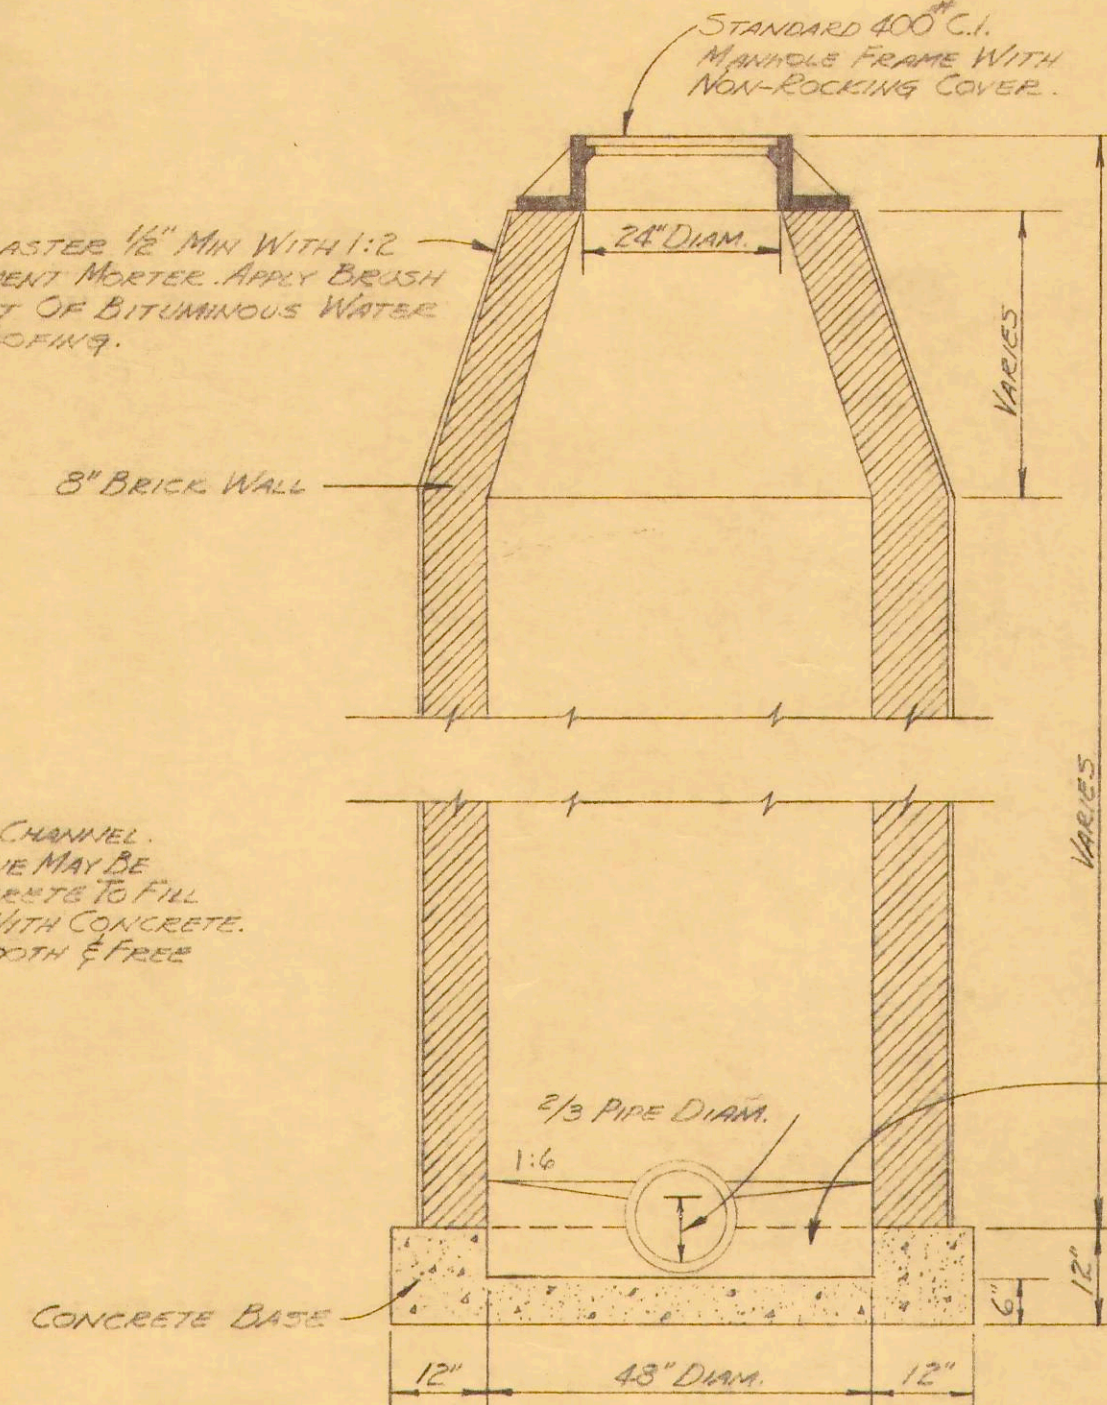


TRANSVERSE SECTION
TYPE "B"
SCALE: 1/2"=1'-0"

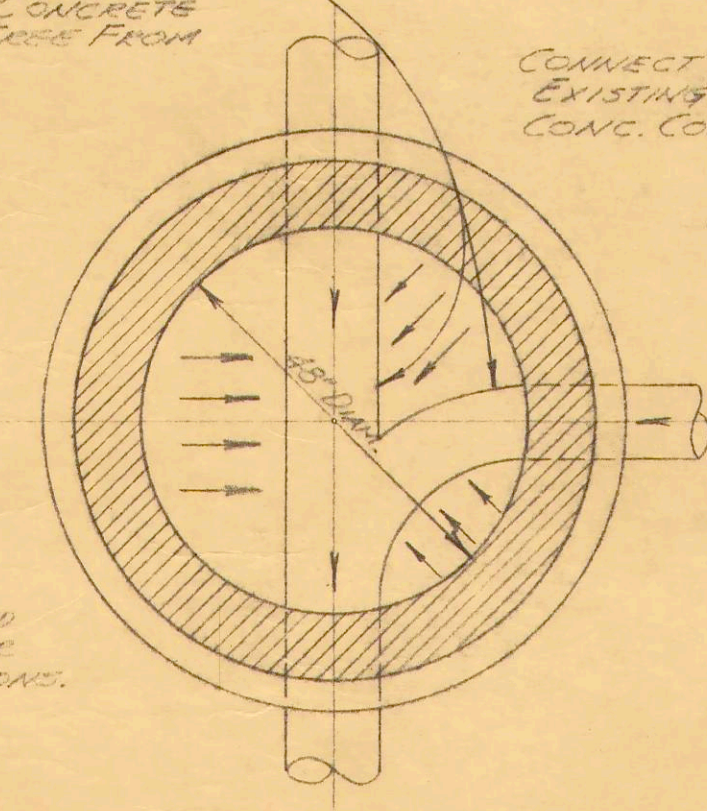


BASE PLAN - JUNCTION MANHOLE

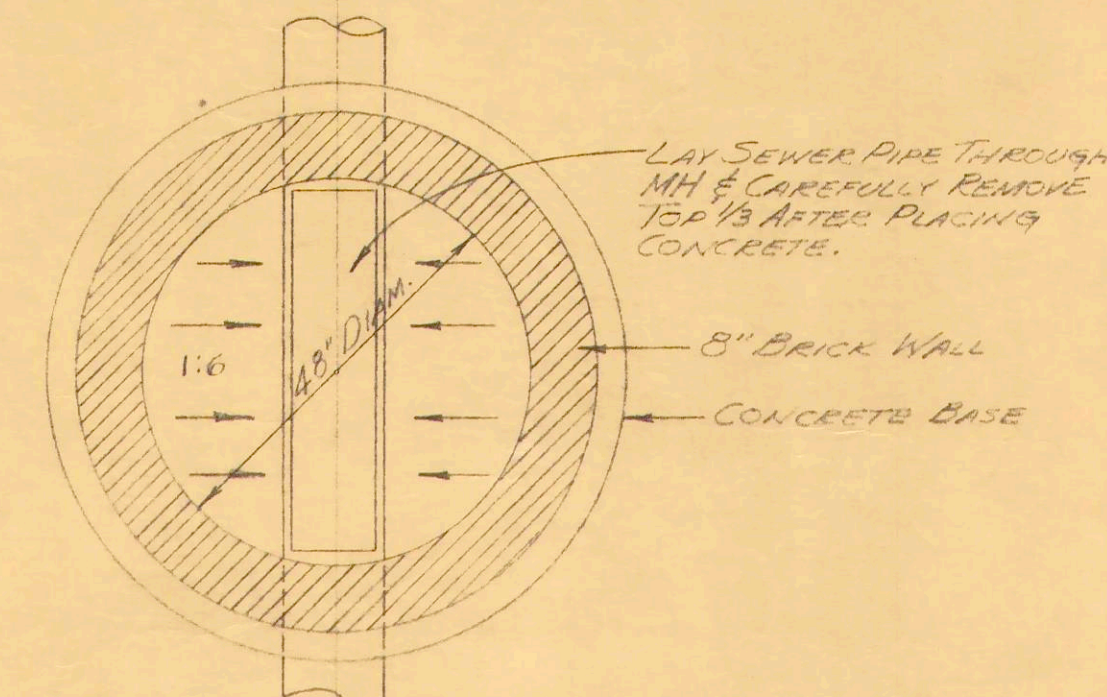


BASE PLAN - TYPICAL LINE MH

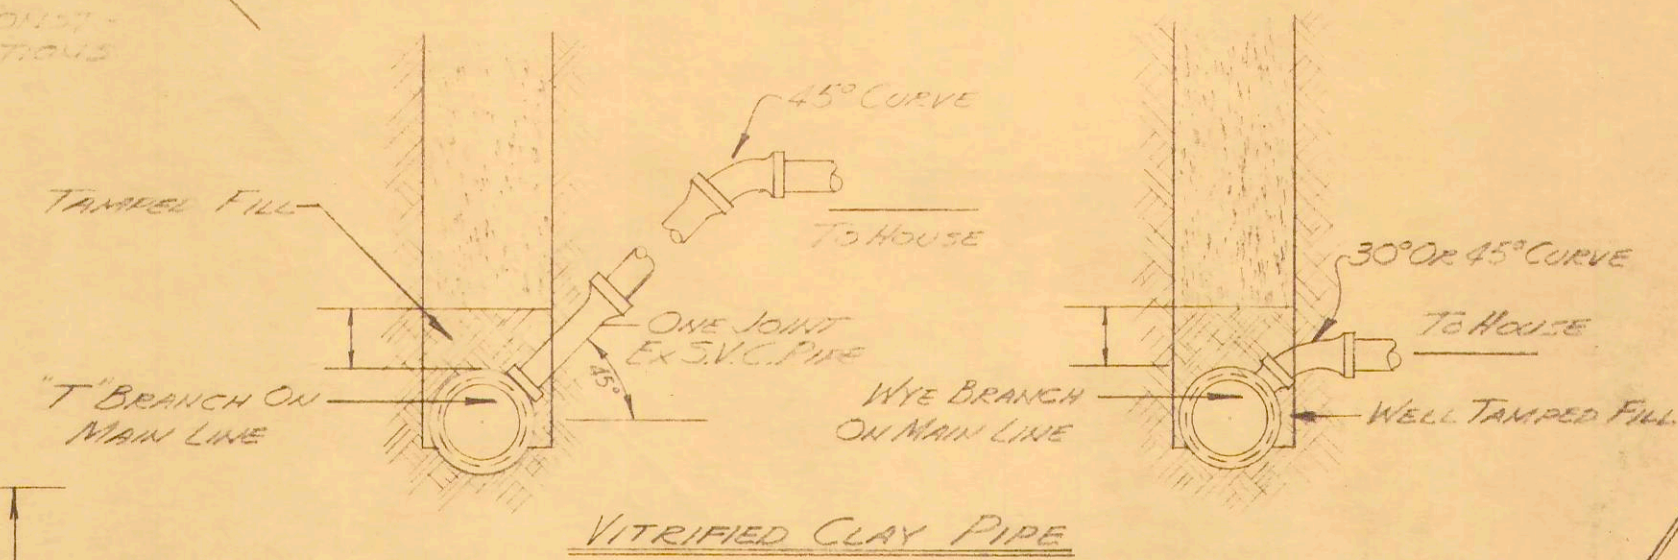


TYPE "A"
DEEP SEWER CONNECTION
TYPE "B"
STANDARD CONNECTION
TYPICAL HOUSE SEWER CONNECTIONS
NOT TO SCALE

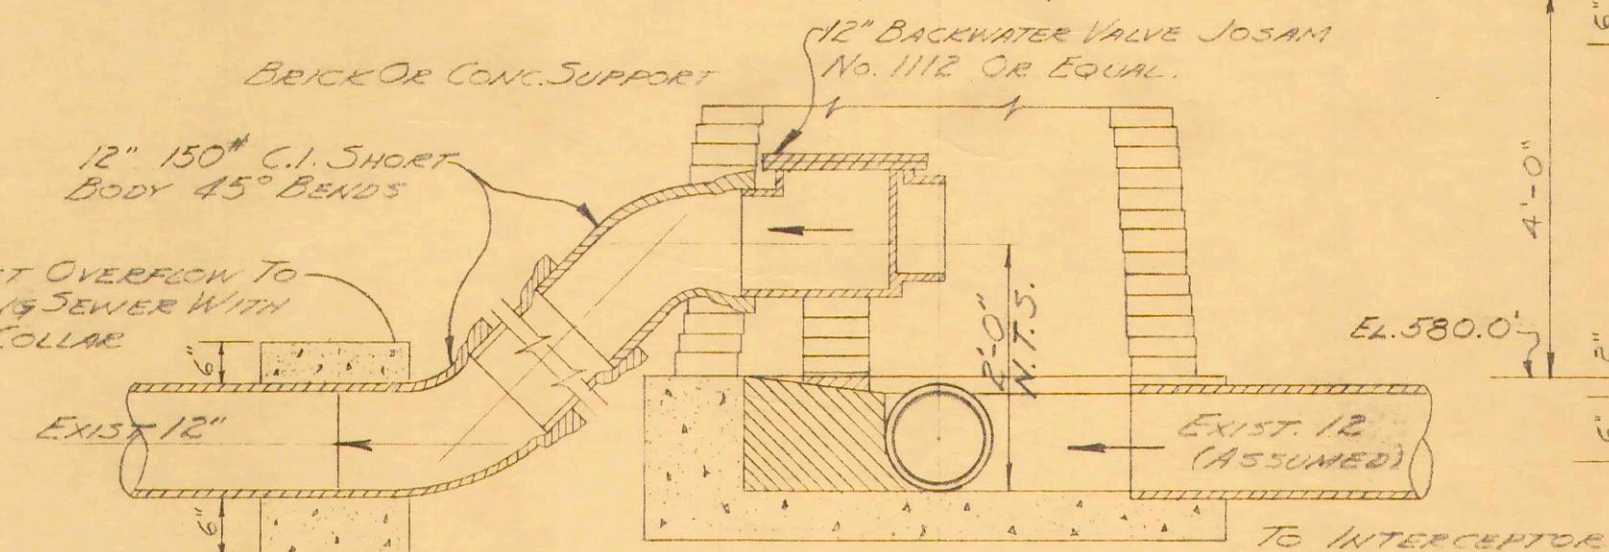


STANDARD CONNECTION
TYPICAL OVERFLOW MANHOLE
SCALE: 1/2"=1'-0"

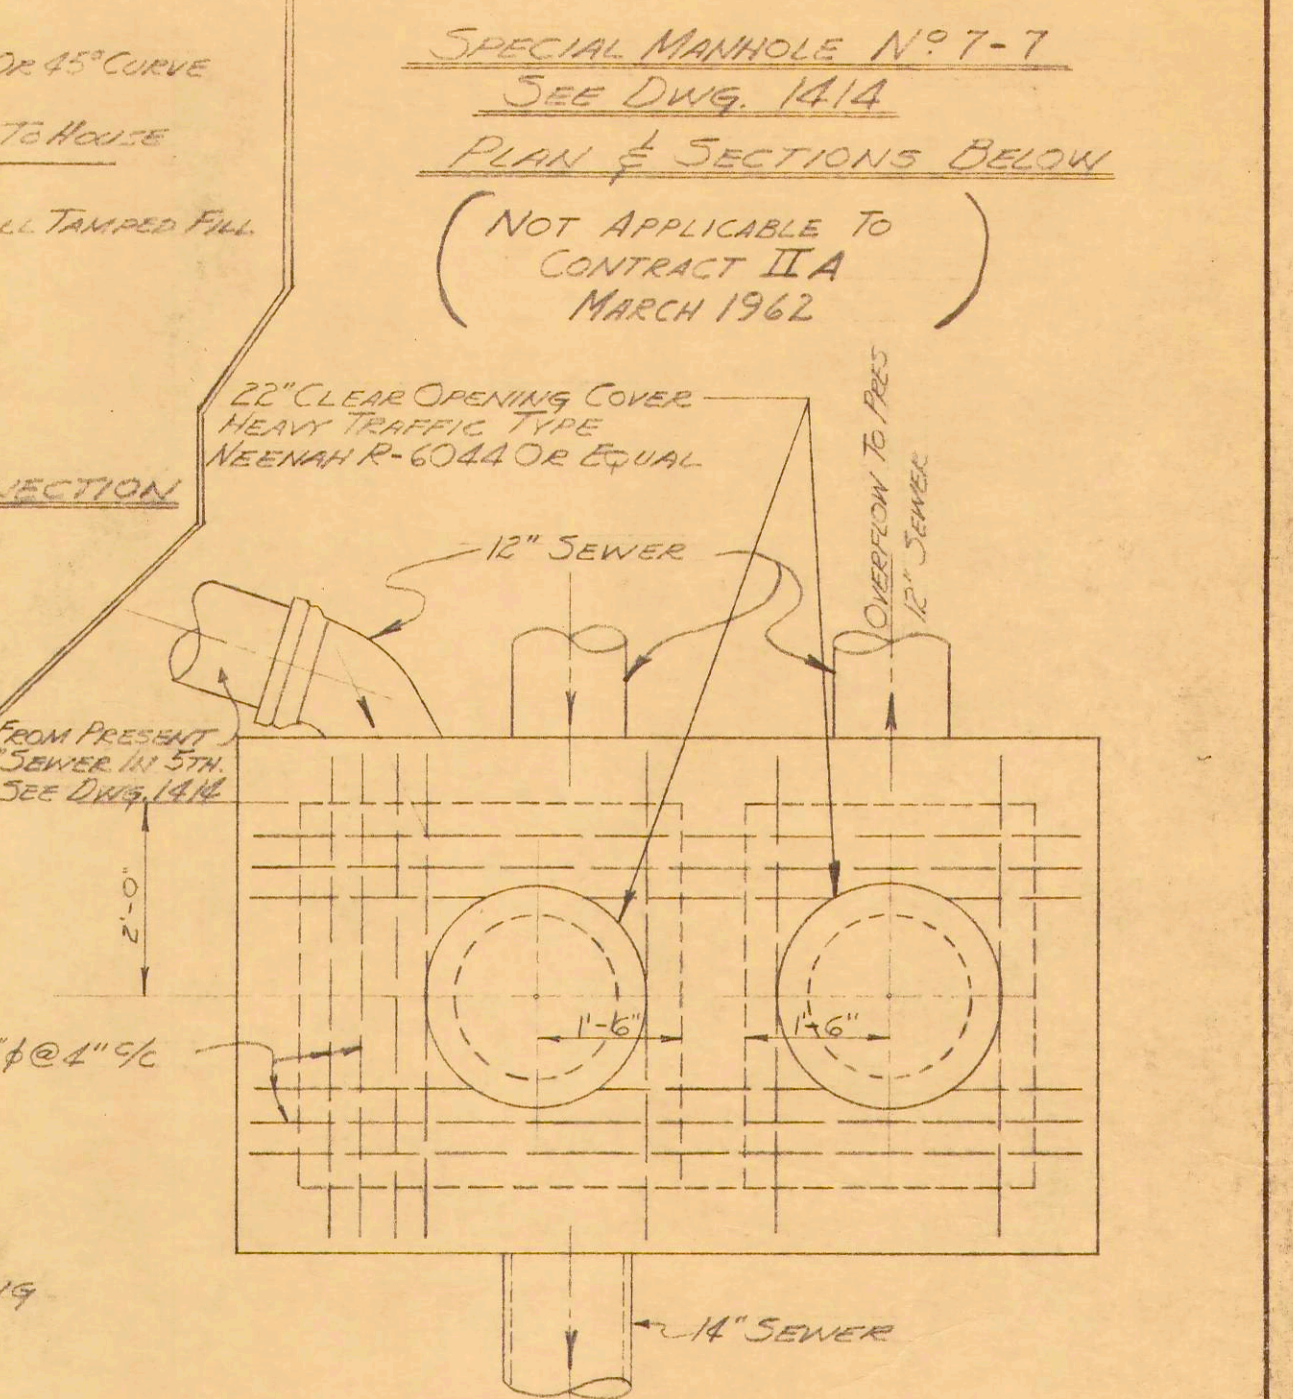


PLAN OF TOP SLAB

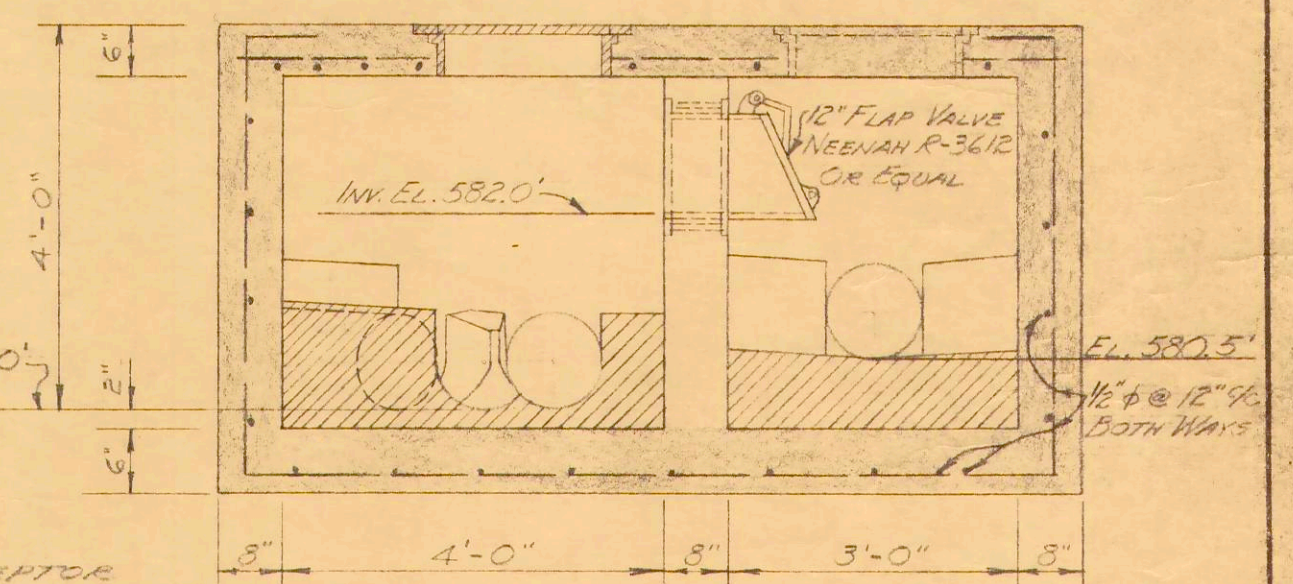

SECTION A-A

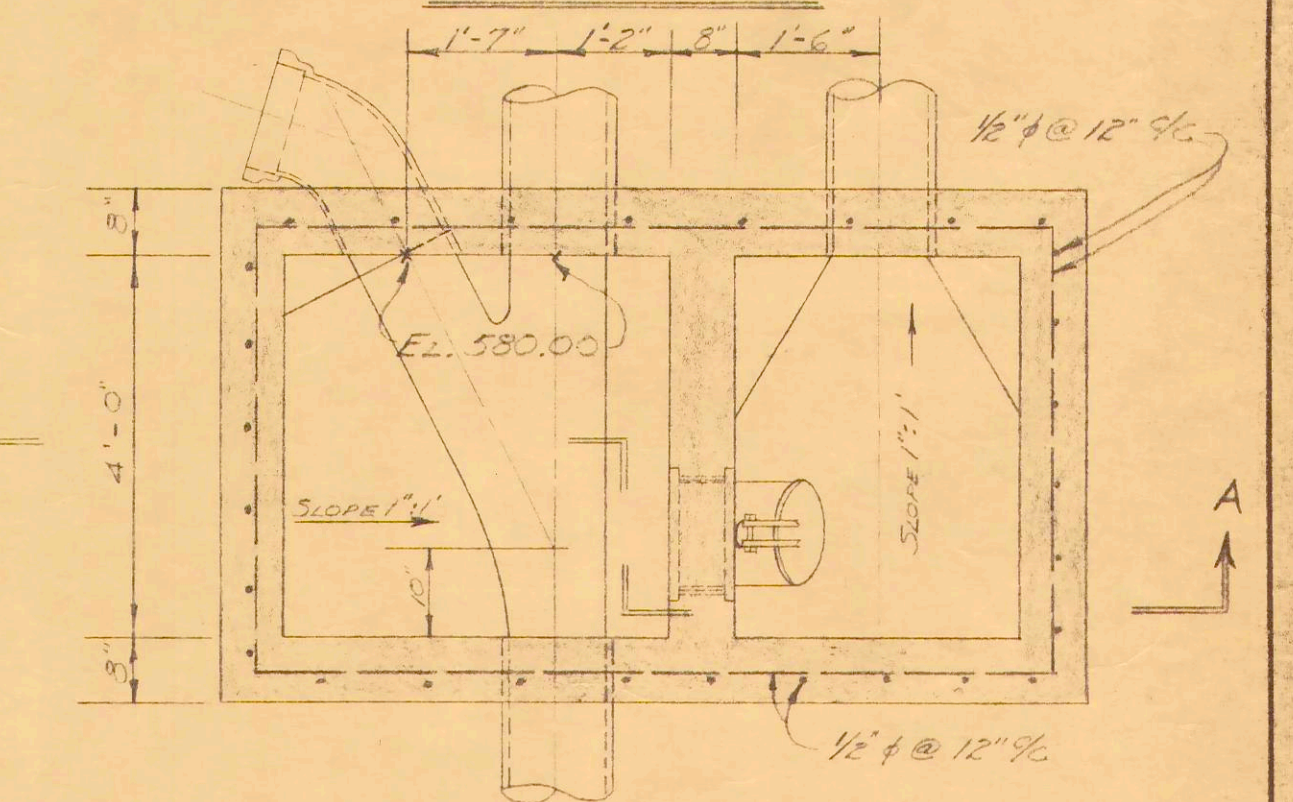

PLAN BELOW TOP SLAB

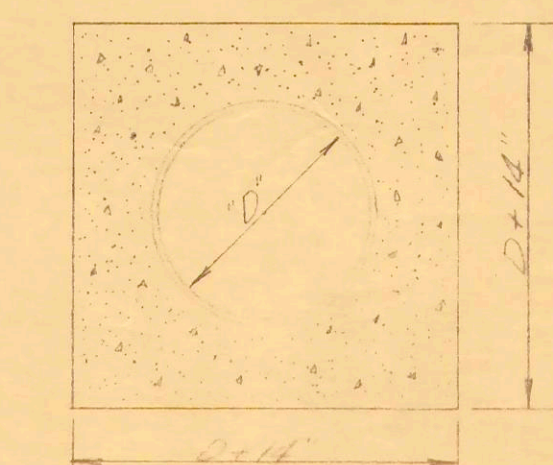

CONCRETE ENCASEMENT

CITY OF SAINT ALBANS

KANAWHA COUNTY WEST VIRGINIA

MANHOLES, SEWER CONNECTIONS
AND MISC. DETAILS - TYPICAL

DATE	HORIZ.	SCALE	VERT.	DRWG. NO.
FEB. 1961	AS SHOWN	AS SHOWN	AS SHOWN	1402

KELLEY GIDLEY & STALL, INC. CONSULTING ENGINEERS
1000 10TH AVENUE, N.W. WASHINGTON, D.C. 20004