
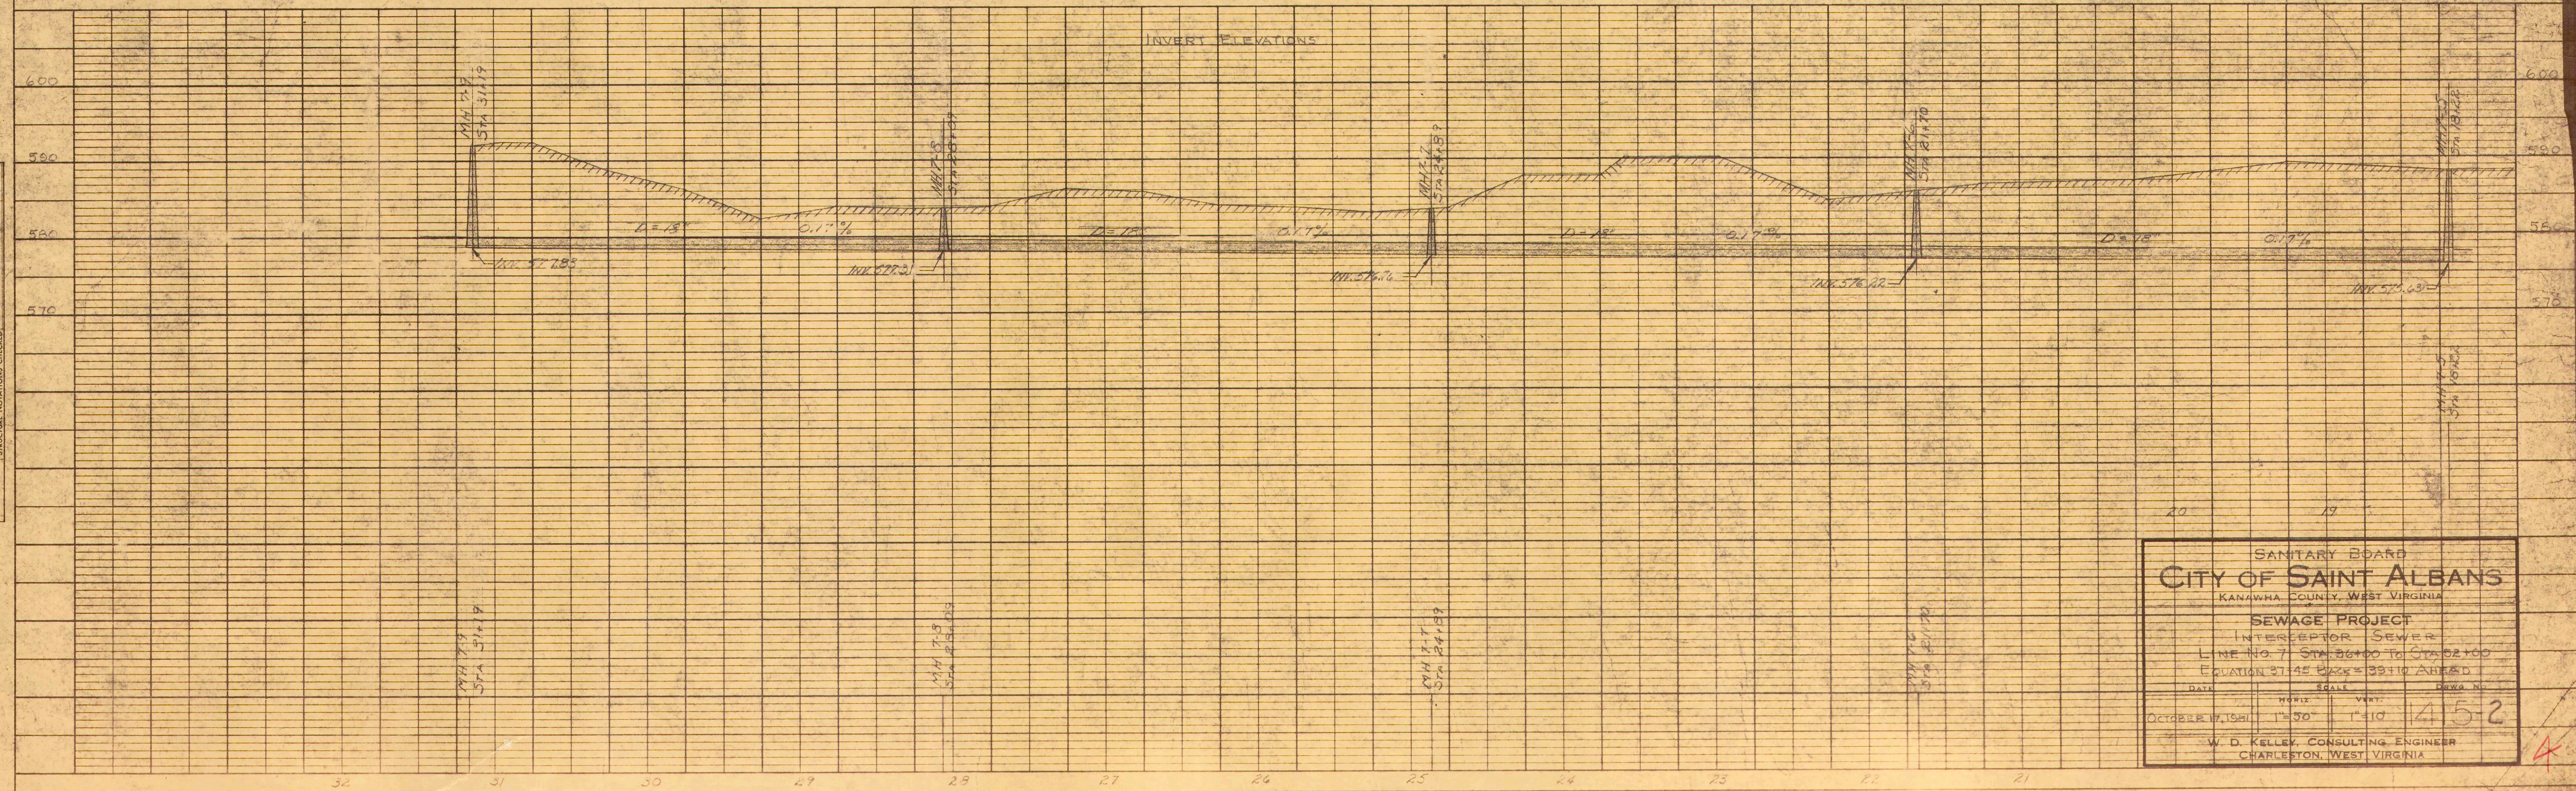


|                    |         |  |
|--------------------|---------|--|
| PLAN               | DATE    |  |
|                    | BY      |  |
|                    | CHECKED |  |
|                    | NOTED   |  |
| NOTE BOOK          |         |  |
| ALIGNMENT CHECKED  |         |  |
| RT. OF WAY CHECKED |         |  |
| No.                |         |  |

|                             |         |  |
|-----------------------------|---------|--|
| PROFILE                     | DATE    |  |
|                             | BY      |  |
|                             | CHECKED |  |
|                             | NOTED   |  |
| NOTE BOOK                   |         |  |
| GRADES CHECKED              |         |  |
| B. M.'S. NOTED              |         |  |
| STRUCTURE NOTATIONS CHECKED |         |  |
| No.                         |         |  |

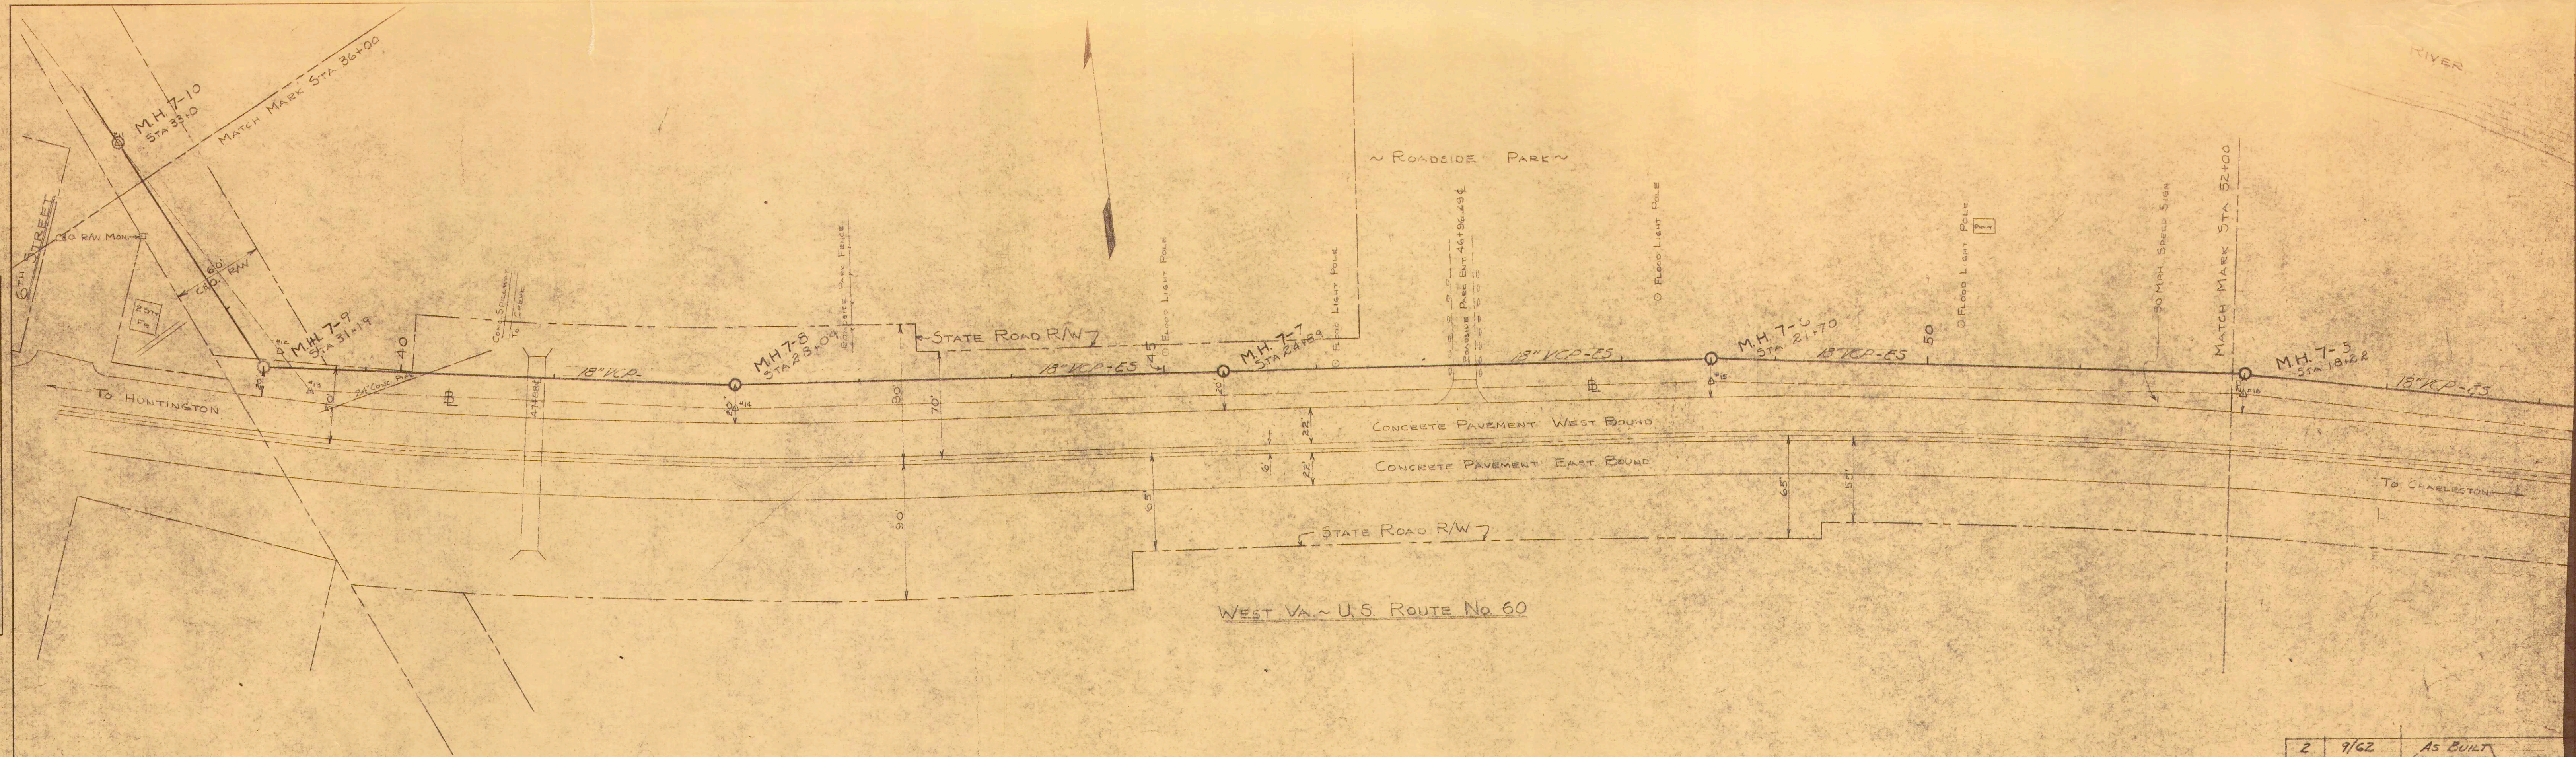

| No. | DATE    | DESCRIPTION                                          |
|-----|---------|------------------------------------------------------|
| 2   | 9/62    | As Built                                             |
| 1   | 7/26/61 | SEWER LOCATION CHANGED FROM 25' TO 20' FROM PAVEMENT |

SANITARY BOARD  
CITY OF SAINT ALBANS  
KANAWHA COUNTY, WEST VIRGINIA

SEWAGE PROJECT  
INTERCEPTOR SEWER  
LINE NO. 7: STA 30+00 TO STA 52+00  
ELEVATION 31'45" TO 33'10" AHEAD

DATE: OCTOBER 17, 1961  
SCALE: 1"=50'  
VERT: 1"=10'

W. D. KELLEY, CONSULTING ENGINEER  
CHARLESTON, WEST VIRGINIA

145-2