


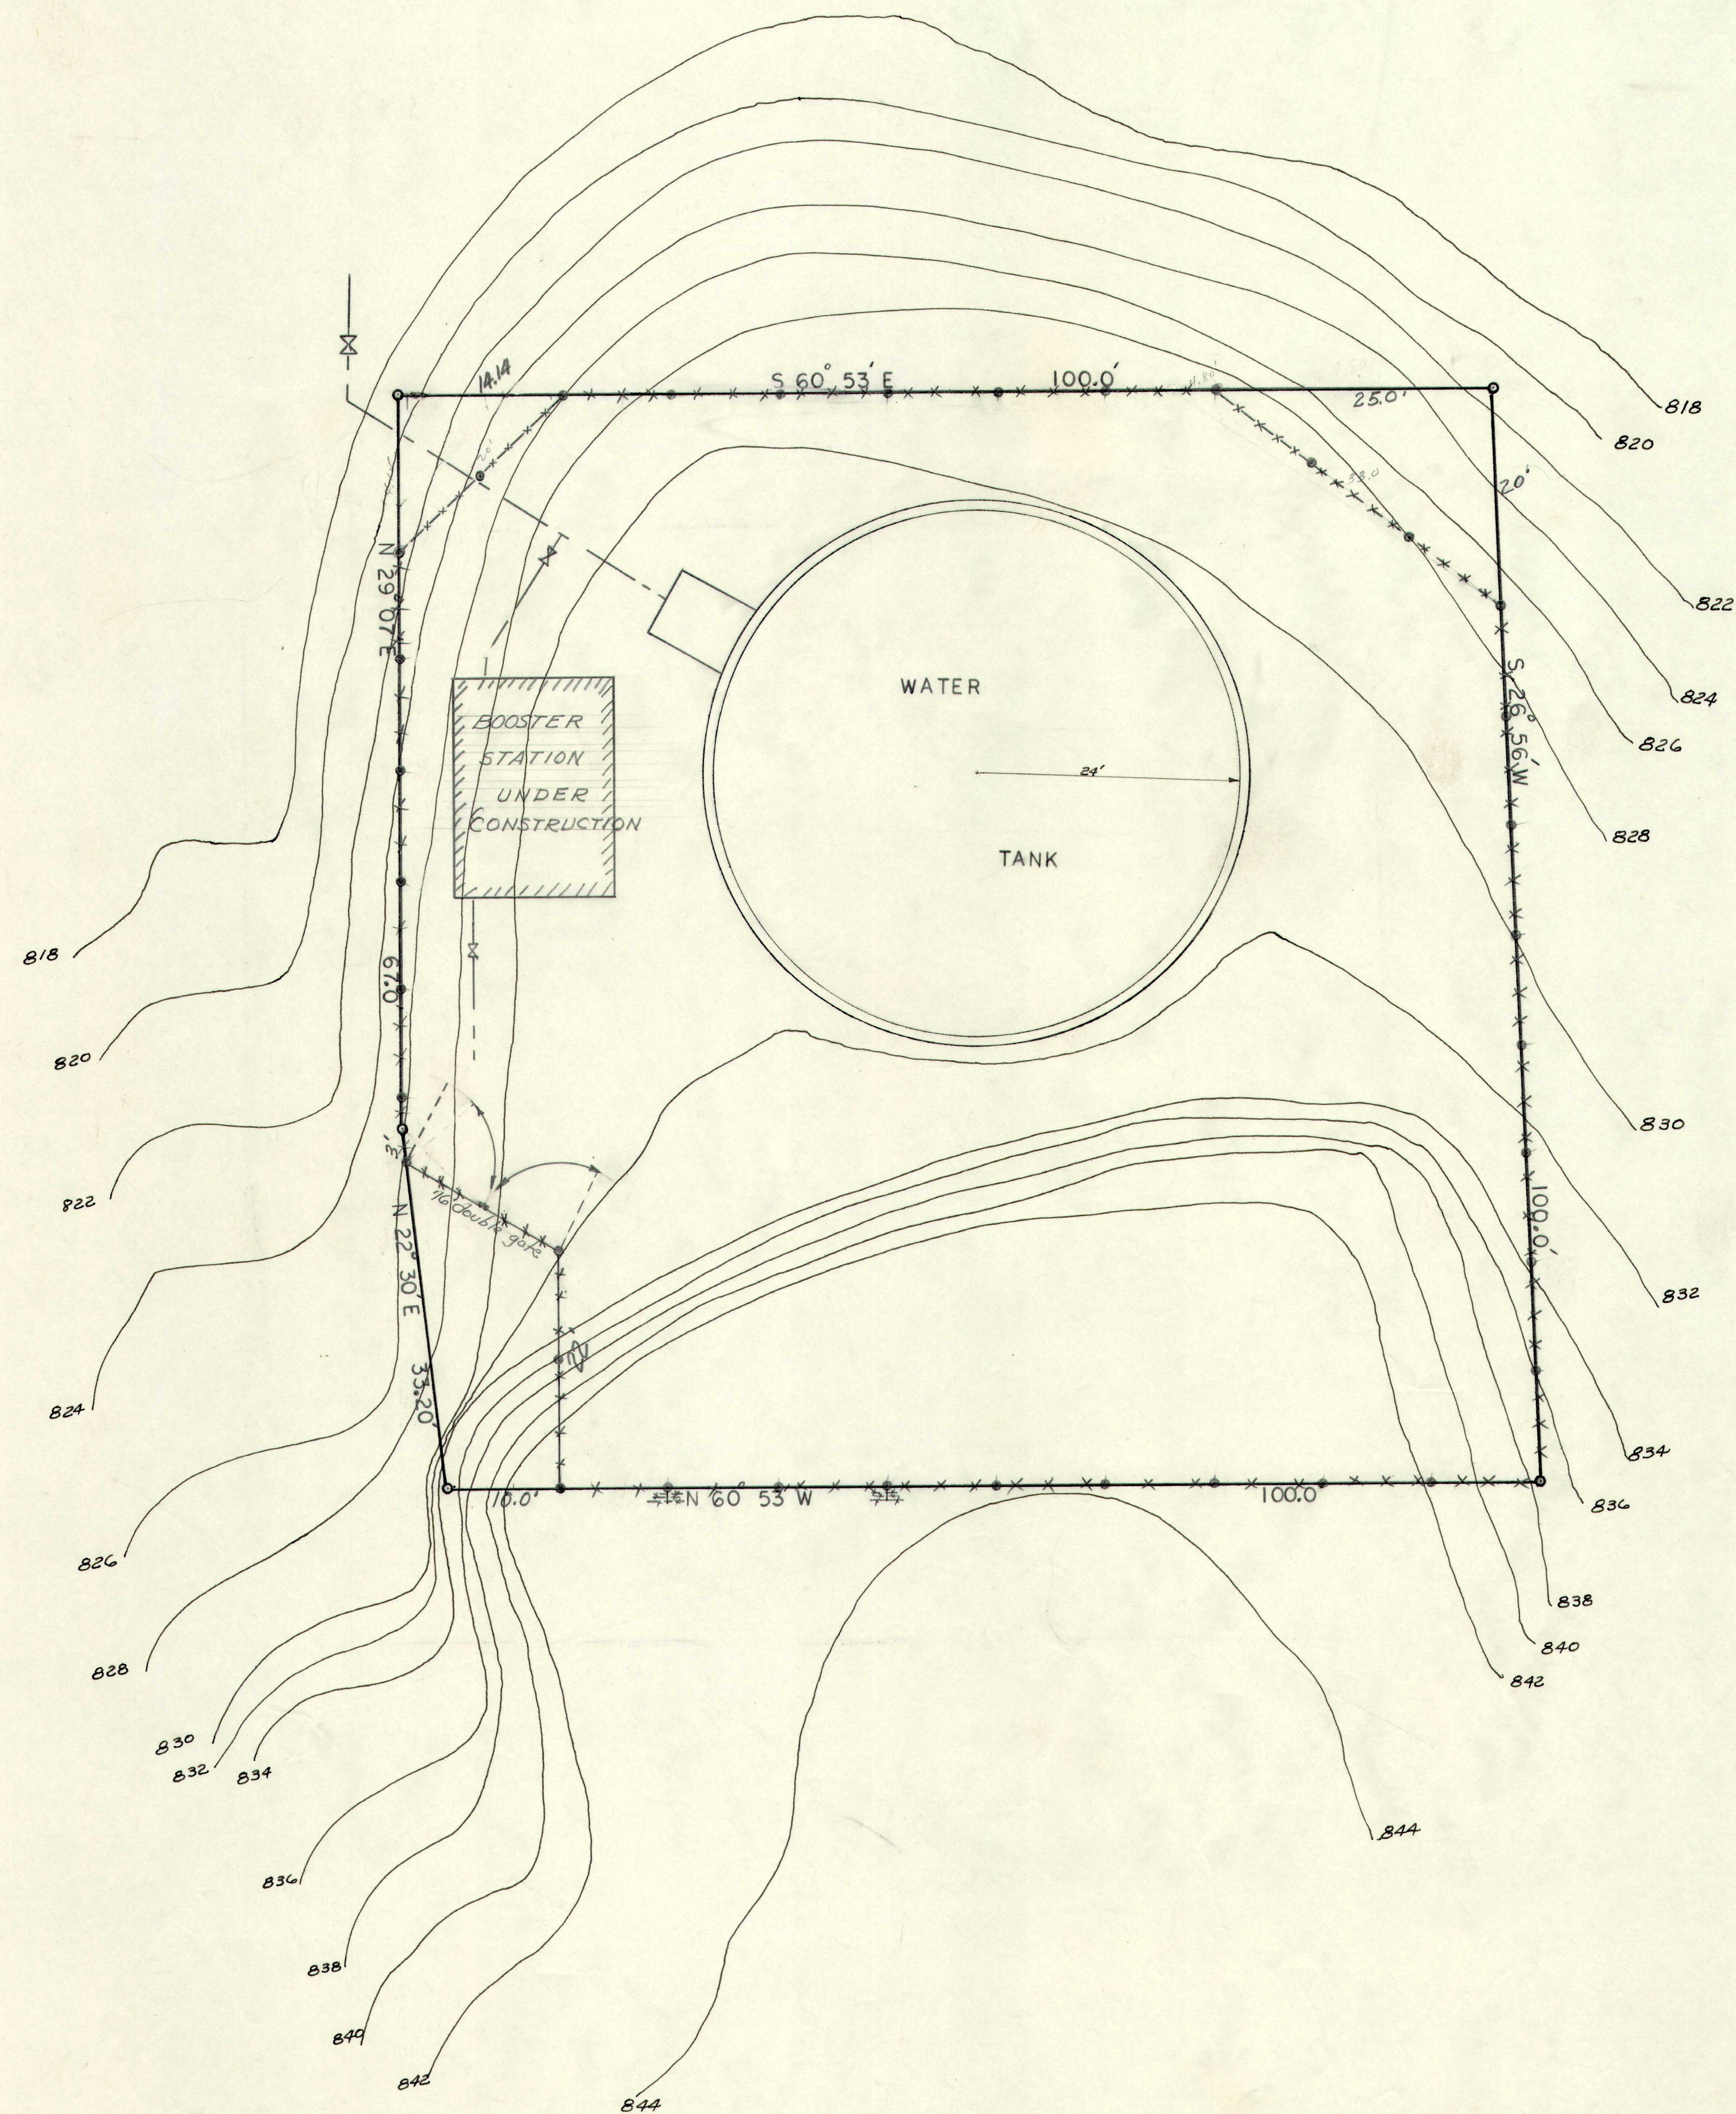

- Specifications:
1. Construct T-chain link fence (6' fabric, 1' barb wire) of No. 9 gauge wire woven into a 2" mesh. Barb wire post arms at a 45° Angle, with 3 strands of wire.
 2. Line posts shall be spaced 10' apart and shall consist of 2 1/2" O.D. tubular steel pipe with a 1 5/8" O.D. top rail. Posts shall be set 36" in concrete footing.
 3. Construct a 16' double gate with 4" O.D. gate posts, using double latch with gate keepers.
 4. All material to be galvanized.
 5. All corner posts to be braced as needed.
 6. Special attention must be given to the fence at the S.W. Corner to traverse near vertical wall of rock.

Map revised to show
fencing plan. 9/7/66

REVISED		MUNICIPAL UTILITY COMMISSION	
DATE		CITY OF SAINT ALBANS	
9/7/66		KA: AWAH COUNTY - WEST VIRGINIA	
CONTOURS			
VINE STREET TANK SITE			
DATE	SCALE	DRAWING NO.	
3/23/66	1" = 10'	47	
JOB NO.	MAP PLAT NO.		
E-41	S3E1		
DRAWN BY	CHECK'D	APPROVED	
O.T.			