

APPROVED SUBJECT TO CONFORMITY TO OUR
PLANS AND SPECIFICATIONS INCLUDING
CORRECTIONS NOTED.





KELLEY, GIDLEY & STAUB, INC.

DATE 11-6-63 BY TJH

BILL OF MATERIAL

1	8" X 4'-0" GEN. W.I. PIPE PLAIN ENDS
1	8" WELDING FLG.
1	8" C.I. Base Ell. 9" C. TO F.
	FLG. VERT. END - M.J. HORIZ. END
1	DEFLECTOR CAP R 16" DIA X 3/8"
3	1 3/4" X 9/8" BAR X 9 5/8"
1	3/8" X 1" Bar Ring For 8"
	Pipe Ship Loose
8	M. BOLTS 3/4" X 3 1/2"
1	GASKET 8"
1	CLA-YAL-HYDRO MERCURY
	ALTITUDE GAGE #X-48 WITH
	MERCURY-TO READ 0-100

INSTALLED BY
OTHERS

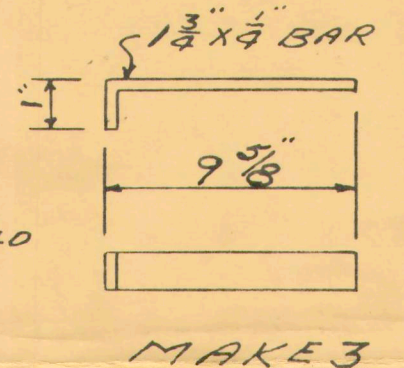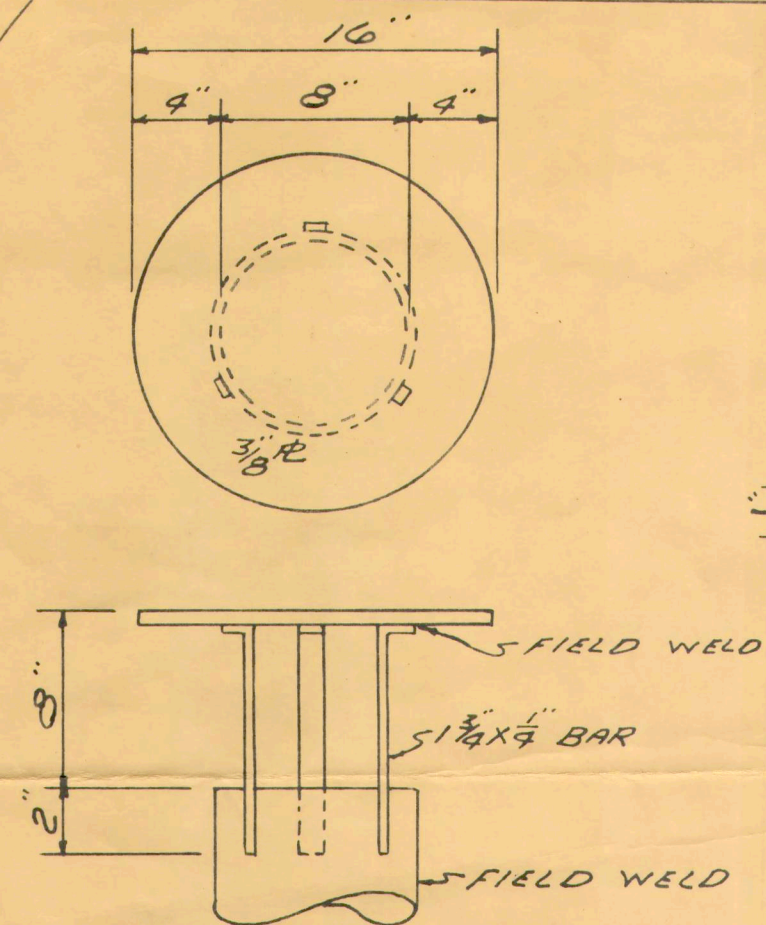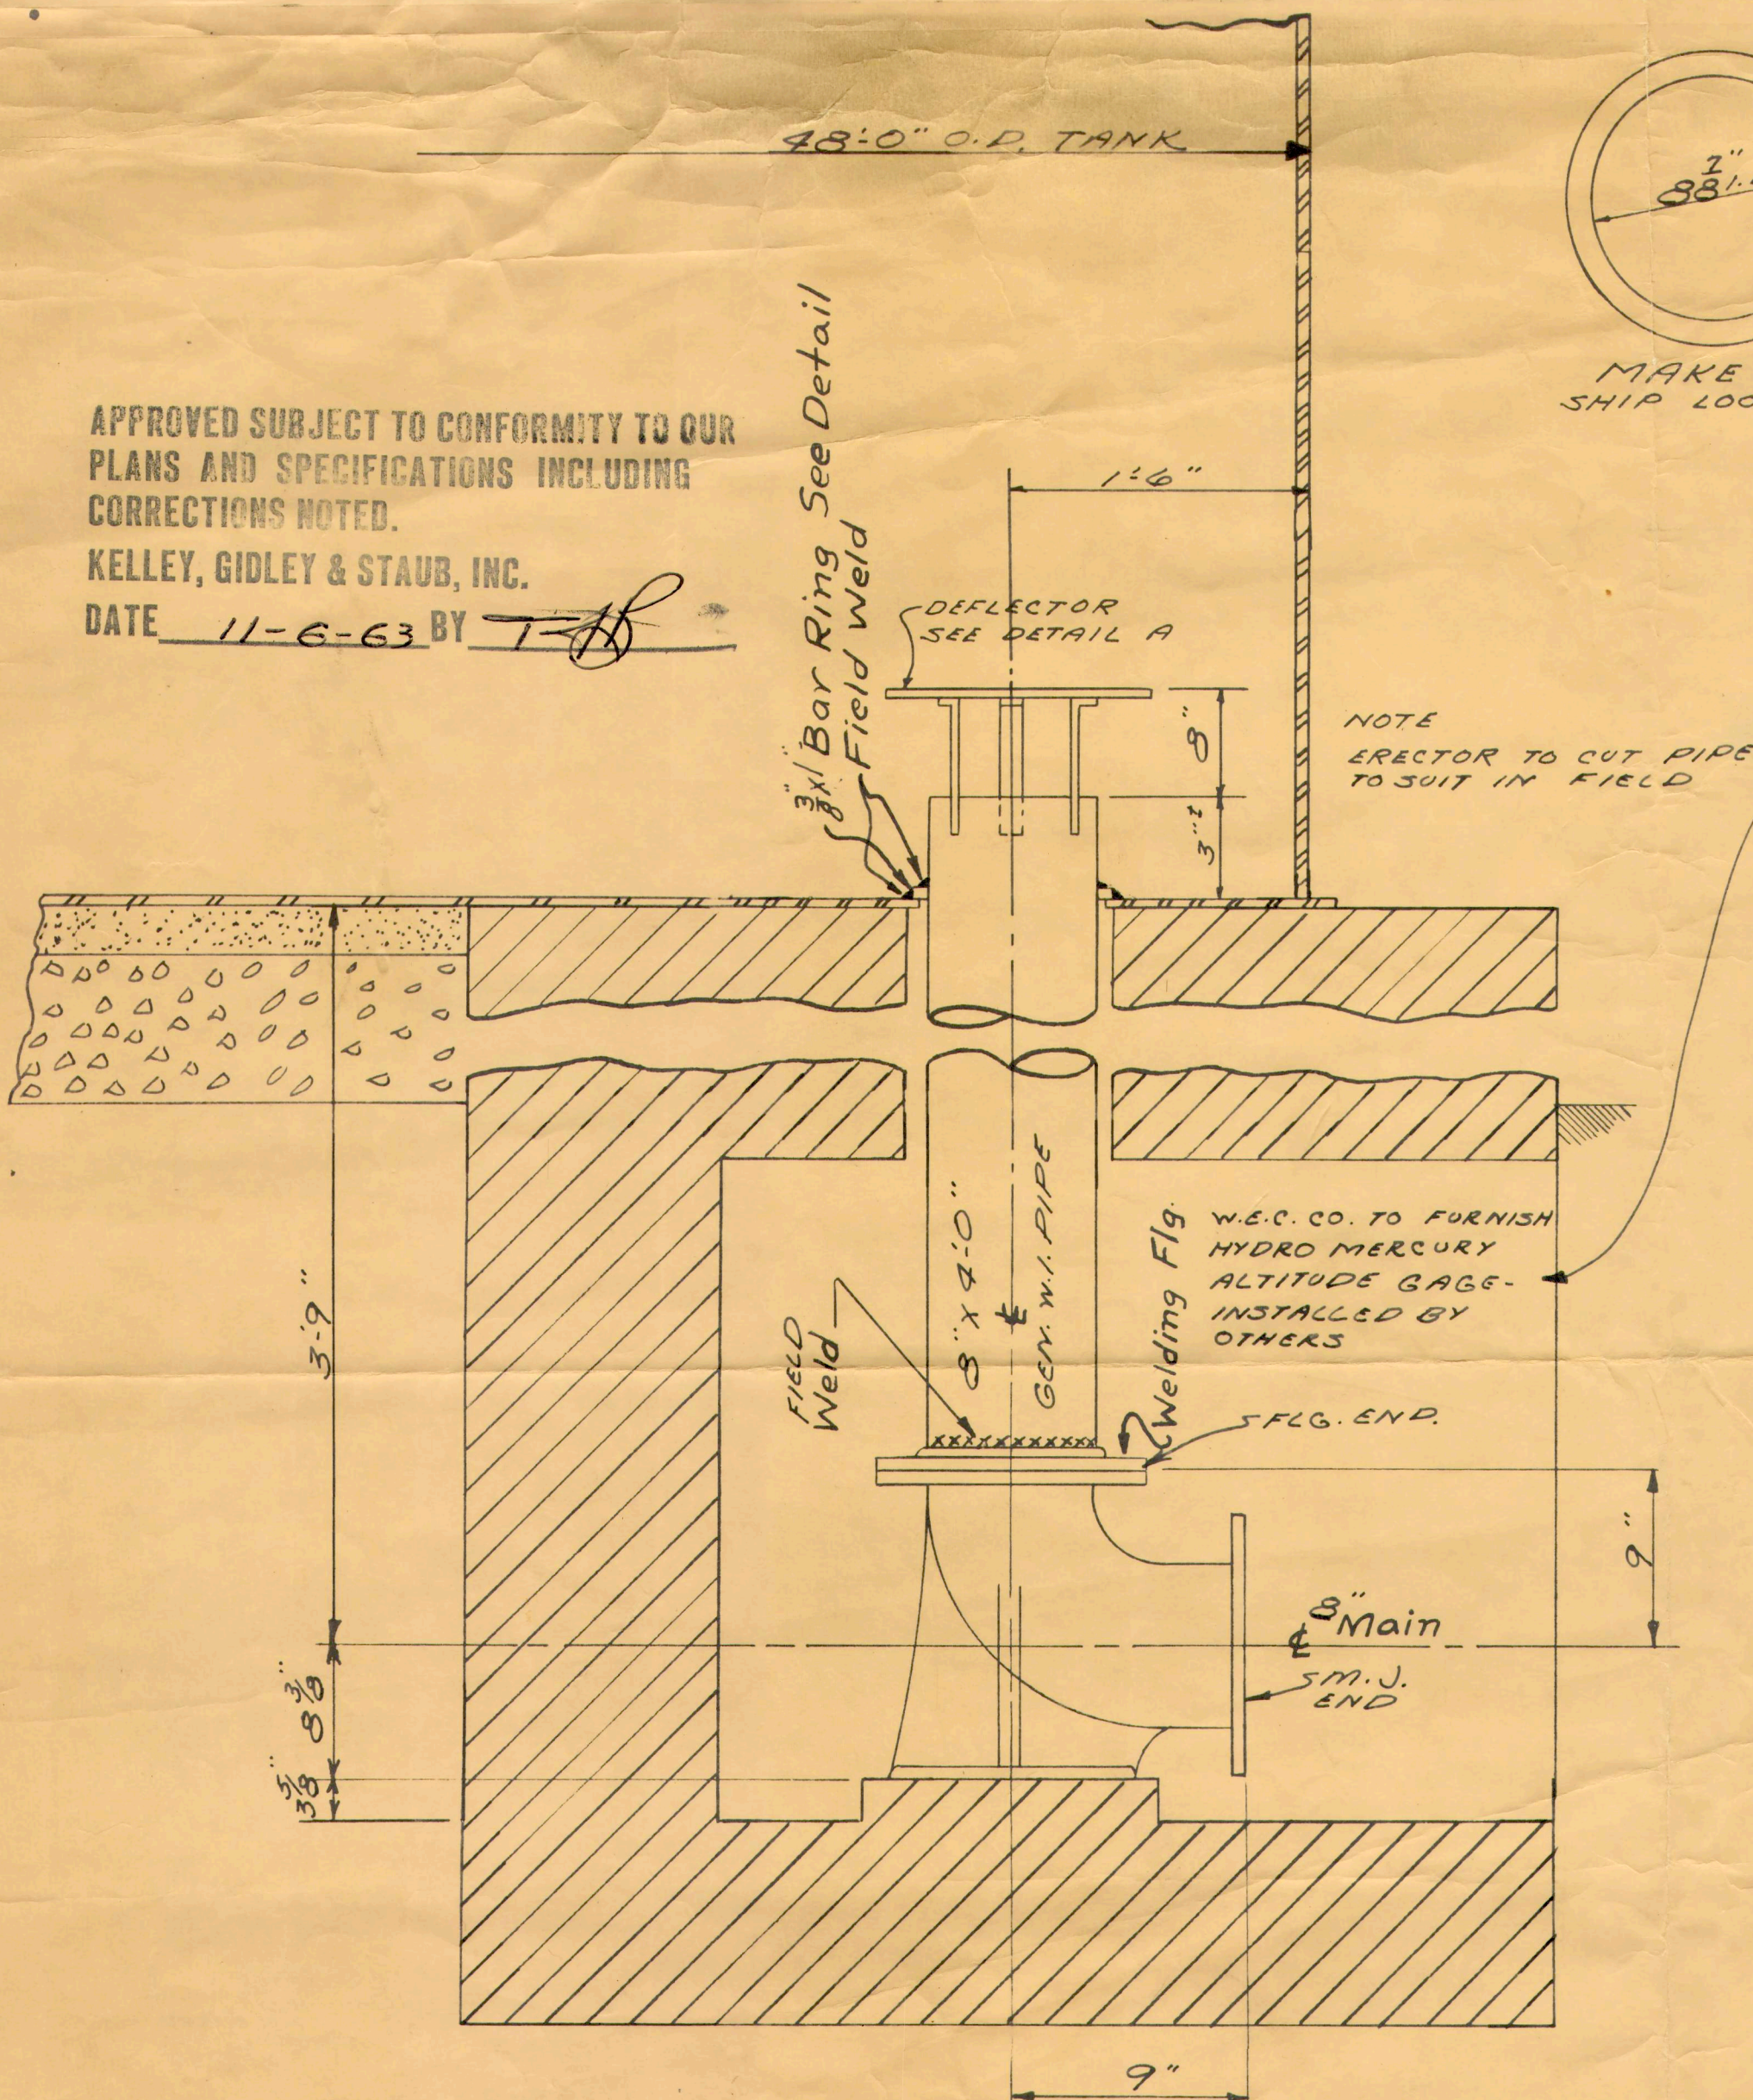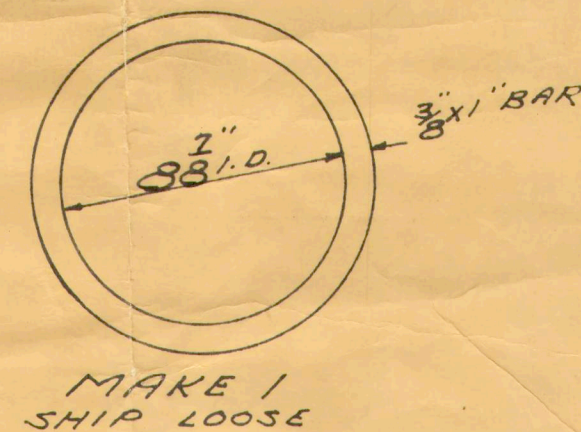

8" INLET PIPE
for
WELDED TANK

W. E. CALDWELL CO.
INCORPORATED
LOUISVILLE, KY.

ORDER No C-5135

DATE 10-4-63

DRAWN BY J.F.

CHECKED BY

FILLED BY RLC CK

B-TF-7366