


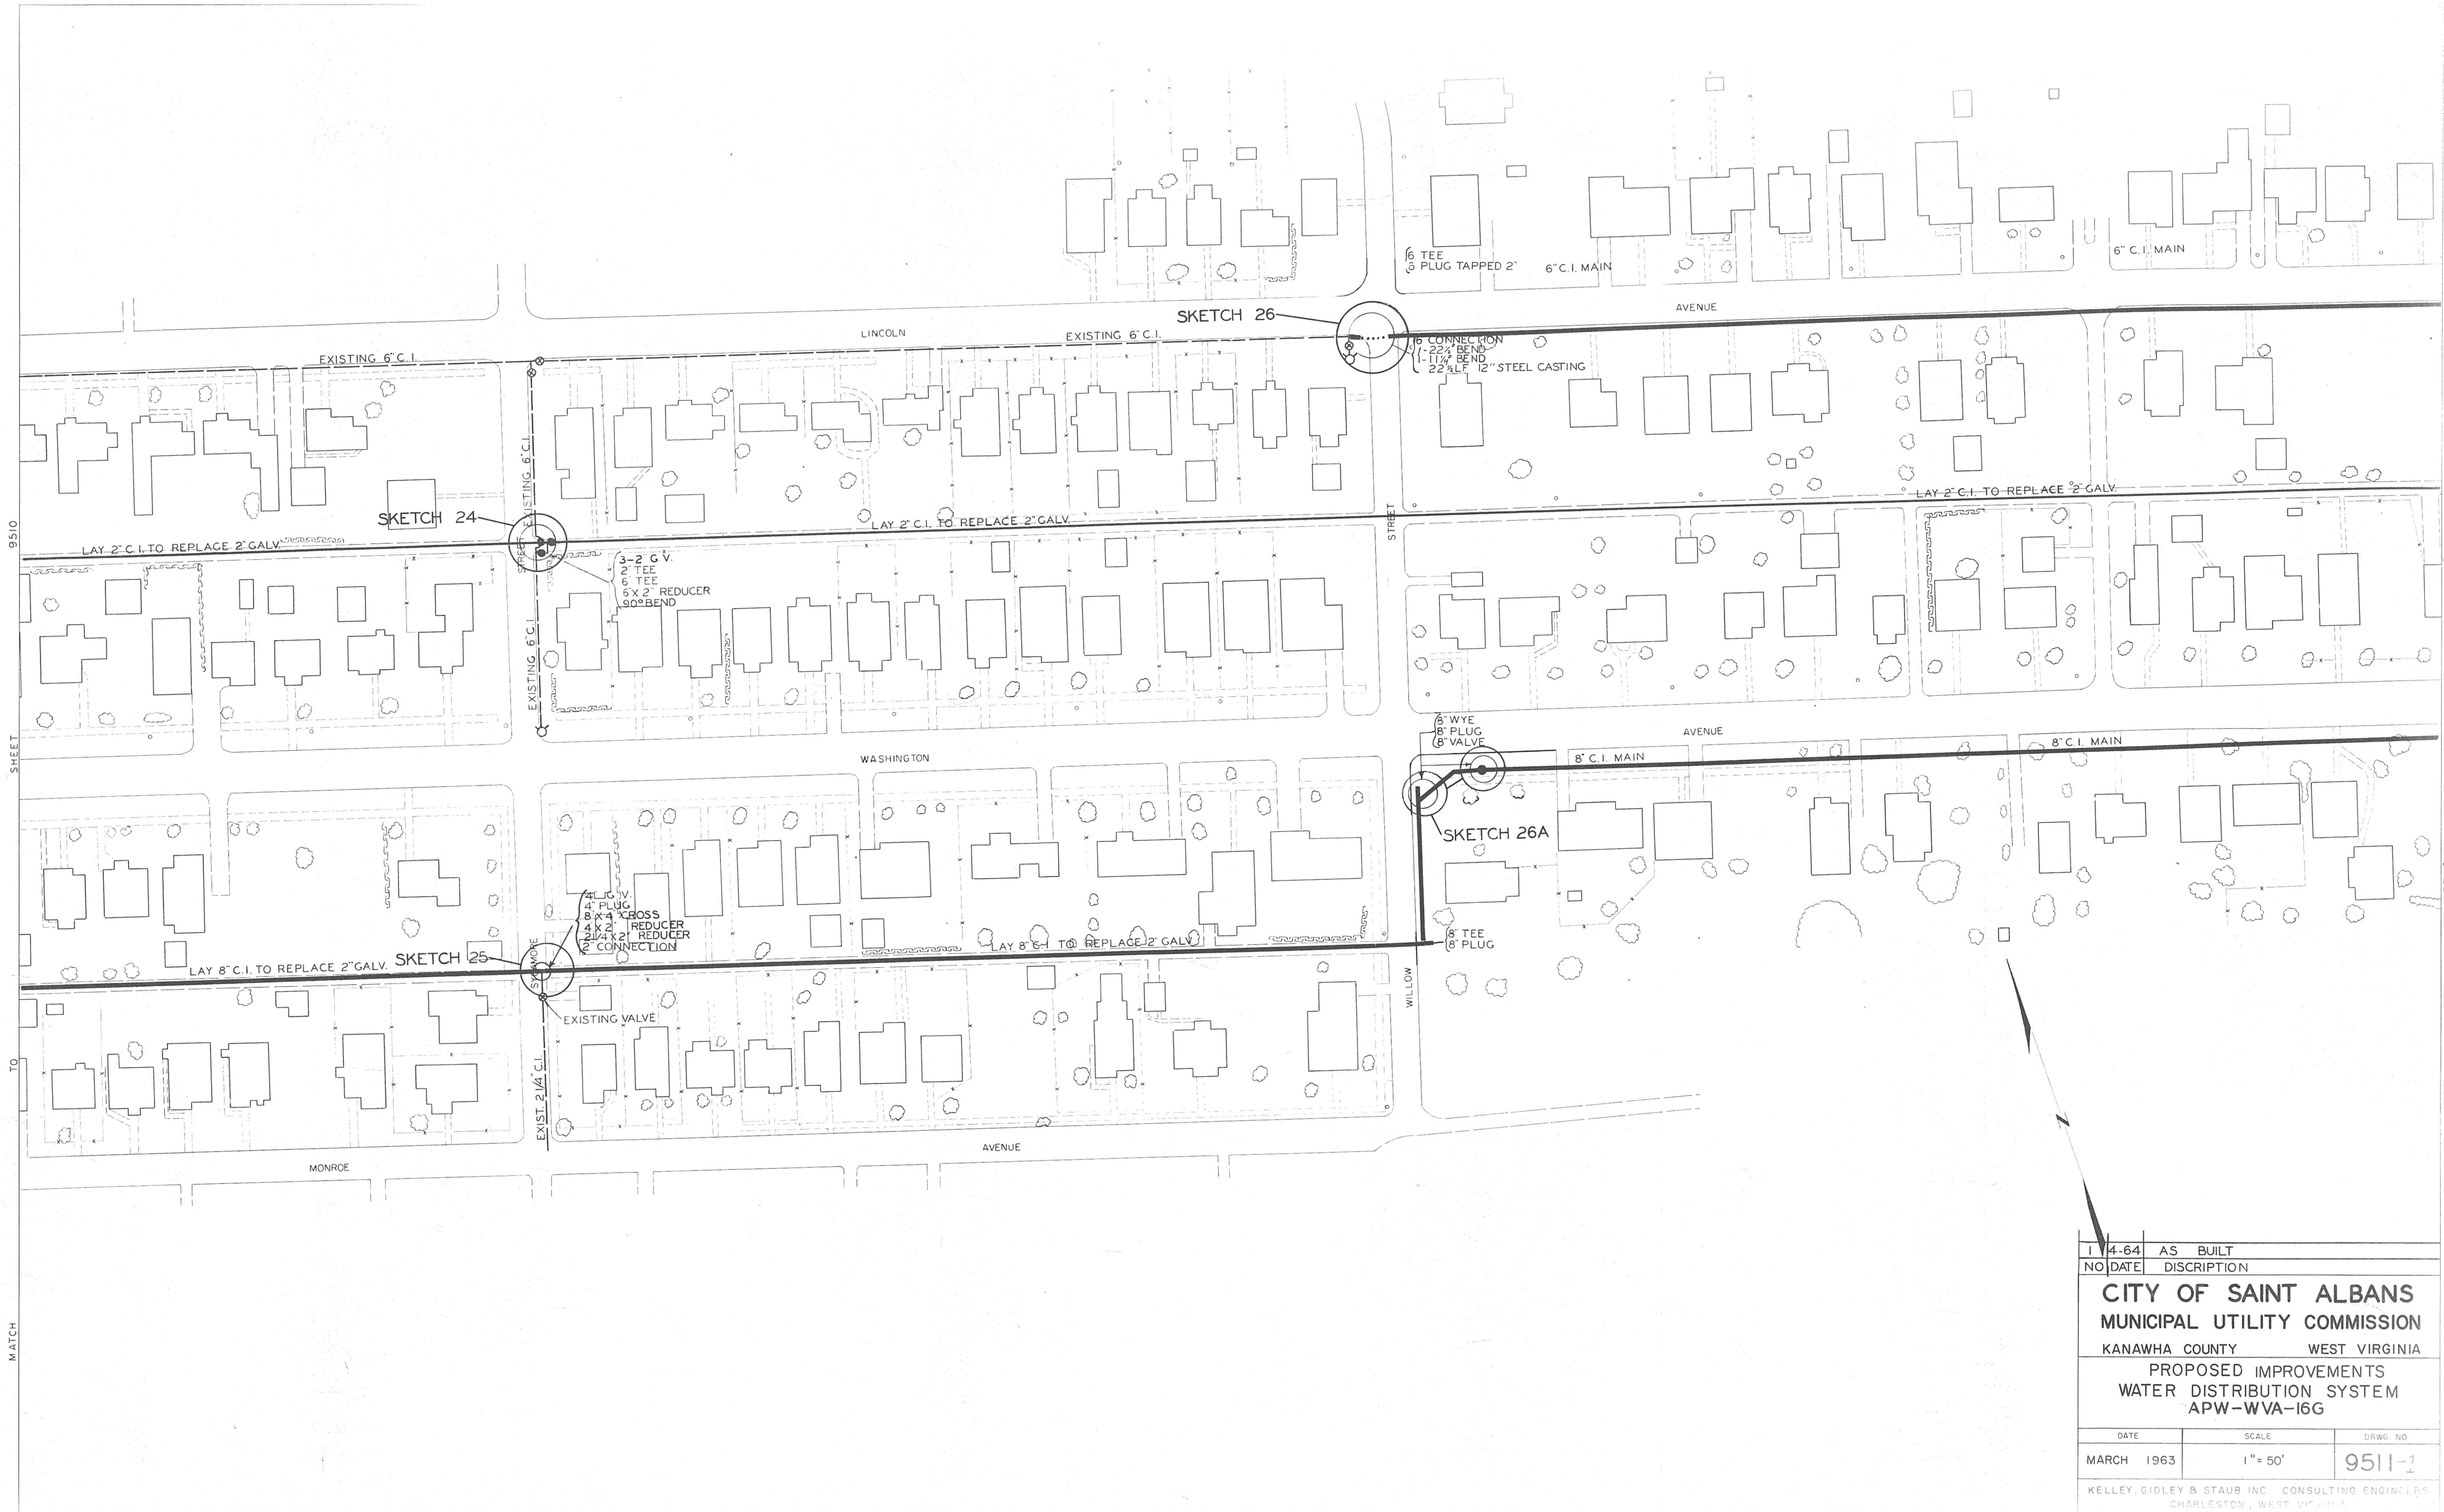

|                                                  |               |           |
|--------------------------------------------------|---------------|-----------|
| 14-64                                            | AS BUILT      |           |
| NO. DATE                                         | DISCRIPTION   |           |
| CITY OF SAINT ALBANS                             |               |           |
| MUNICIPAL UTILITY COMMISSION                     |               |           |
| KANAWHA COUNTY                                   | WEST VIRGINIA |           |
| PROPOSED IMPROVEMENTS                            |               |           |
| WATER DISTRIBUTION SYSTEM                        |               |           |
| APW-WVA-I6G                                      |               |           |
| DATE                                             | SCALE         | DRWG. NO. |
| MARCH 1963                                       | 1" = 50'      | 9511-1    |
| KELLEY, GIDLEY & STAUB INC. CONSULTING ENGINEERS |               |           |
| CHARLESTON, WEST VIRGINIA                        |               |           |