


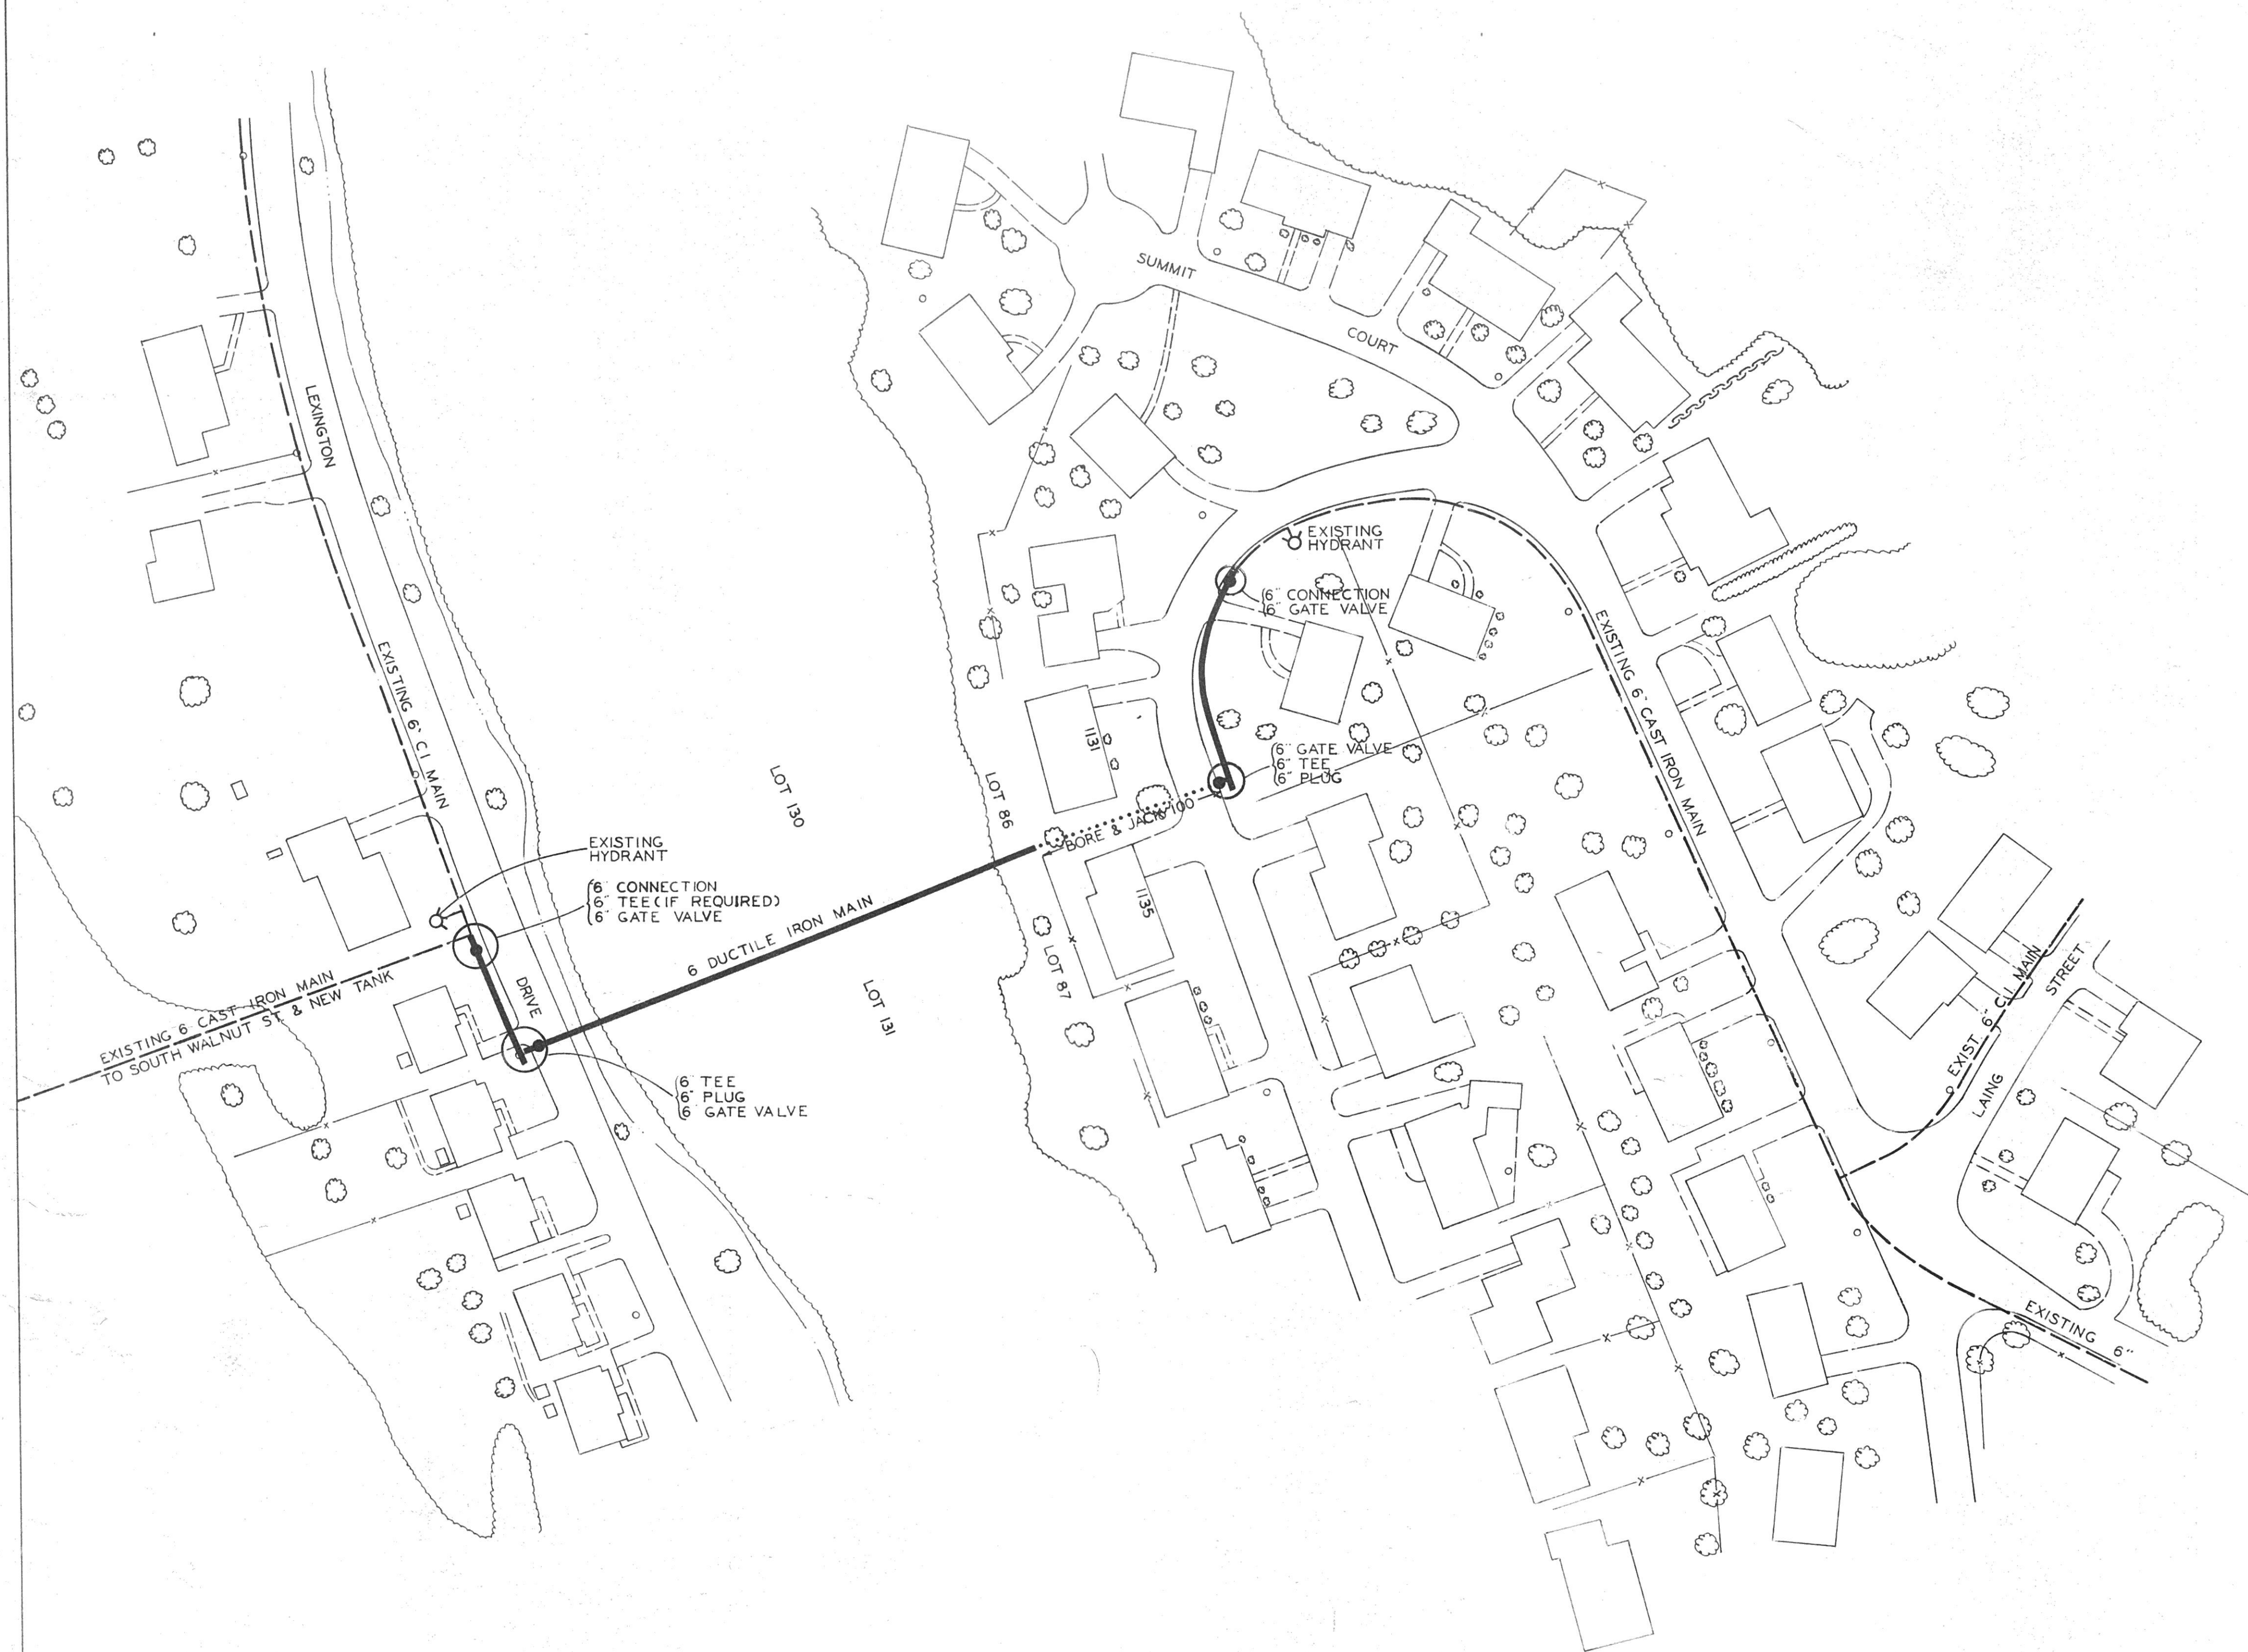

ELIMINATED FROM CONTRACT

CITY OF SAINT ALBANS MUNICIPAL UTILITY COMMISSION KANAWHA COUNTY WEST VIRGINIA		
PROPOSED IMPROVEMENTS WATER DISTRIBUTION SYSTEM APW-WVA-16G		
DATE	SCALE	DWG NO
MARCH 1963	1" = 50'	9516
KELLEY & ASSOCIATES, INC. CONSULTING ENGINEERS SAINT ALBANS, WEST VIRGINIA		