


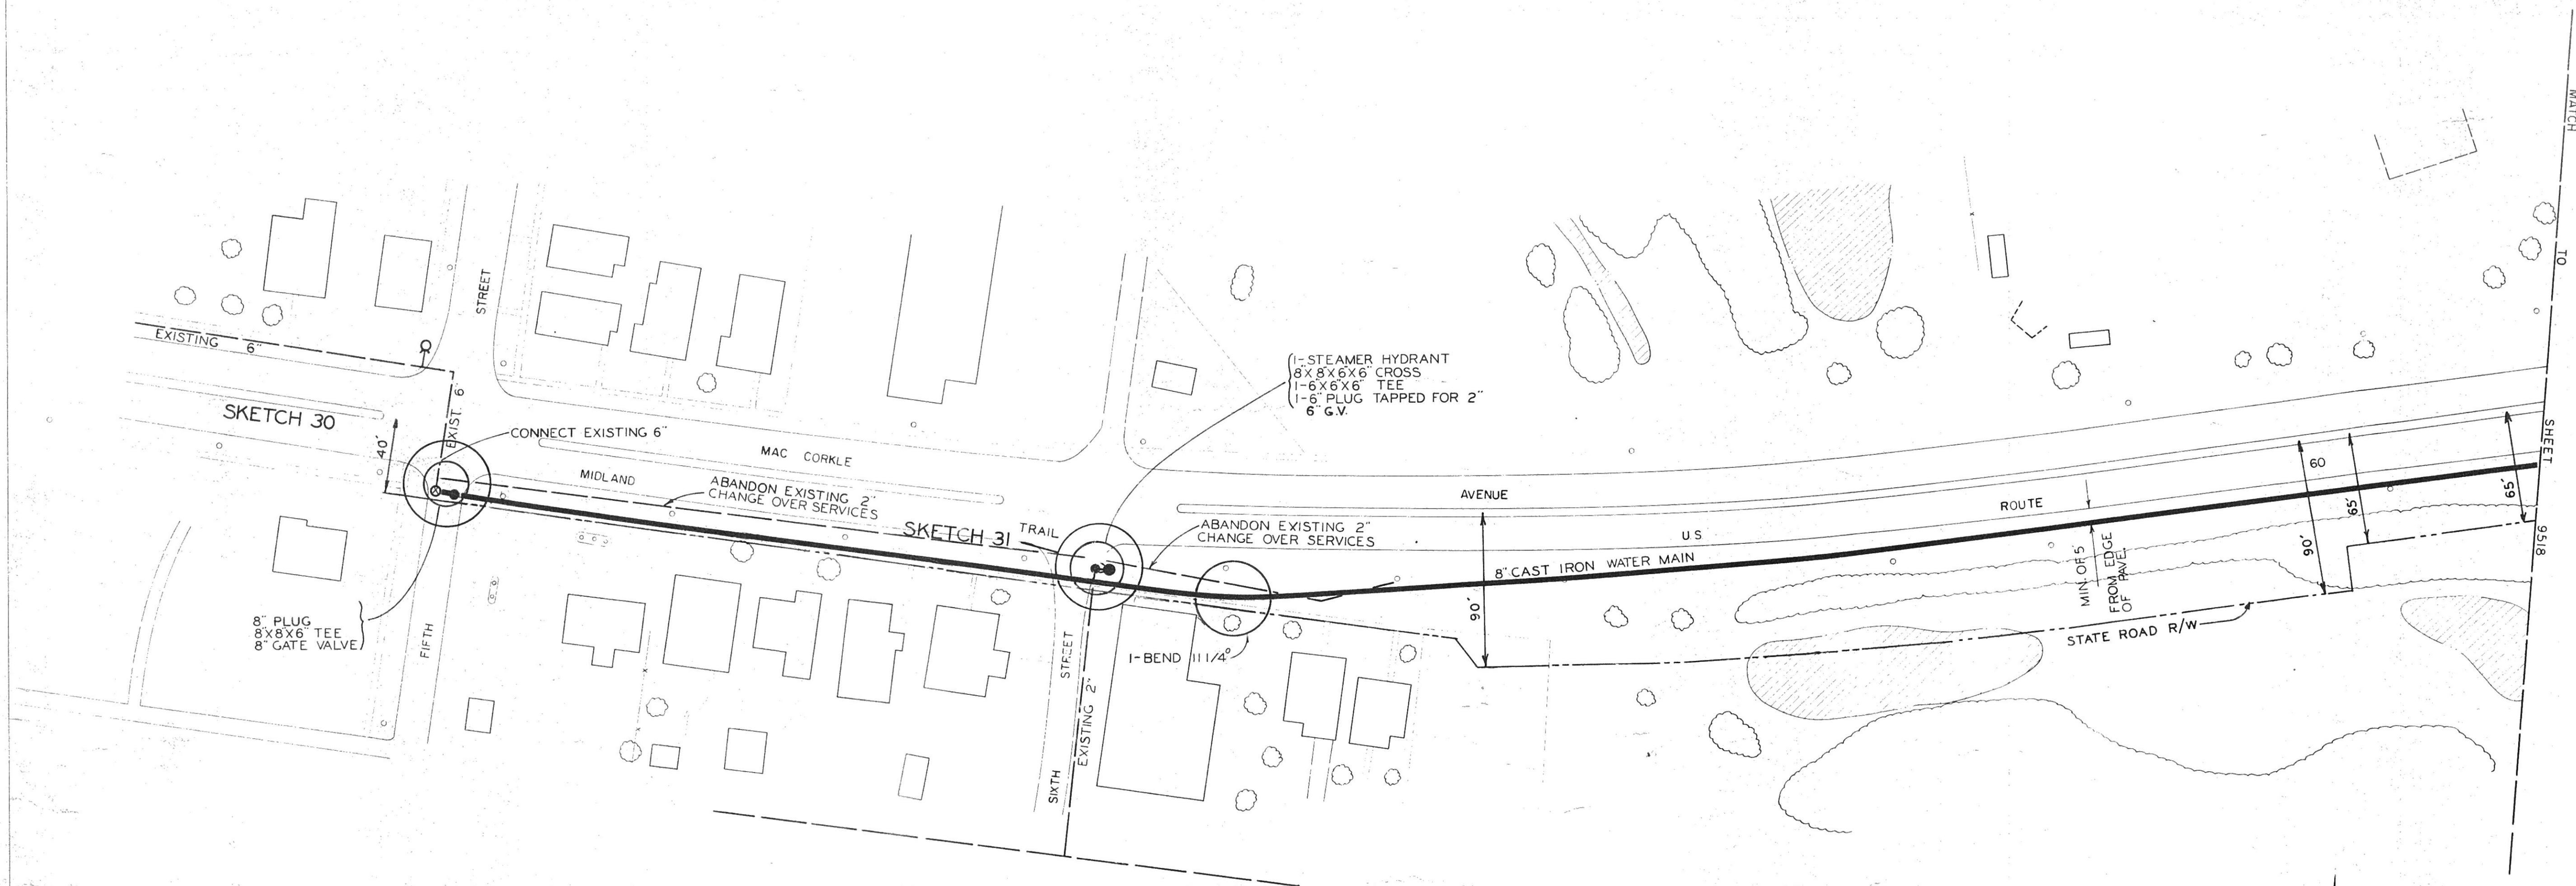

NO	4-64	AS BUILT
DATE		DISCRIPTION
CITY OF SAINT ALBANS		
MUNICIPAL UTILITY COMMISSION		
KANAWHA COUNTY		WEST VIRGINIA
PROPOSED IMPROVEMENTS		
WATER DISTRIBUTION SYSTEM		
APW-WVA-16G		
DATE	SCALE	LRWG. NO.
MARCH 1963	1" = 50'	9517-1
KELLEY, GIDLEY & STAUB INC. CONSULTING ENGINEERS		
CHARLESTON, WEST VIRGINIA		