


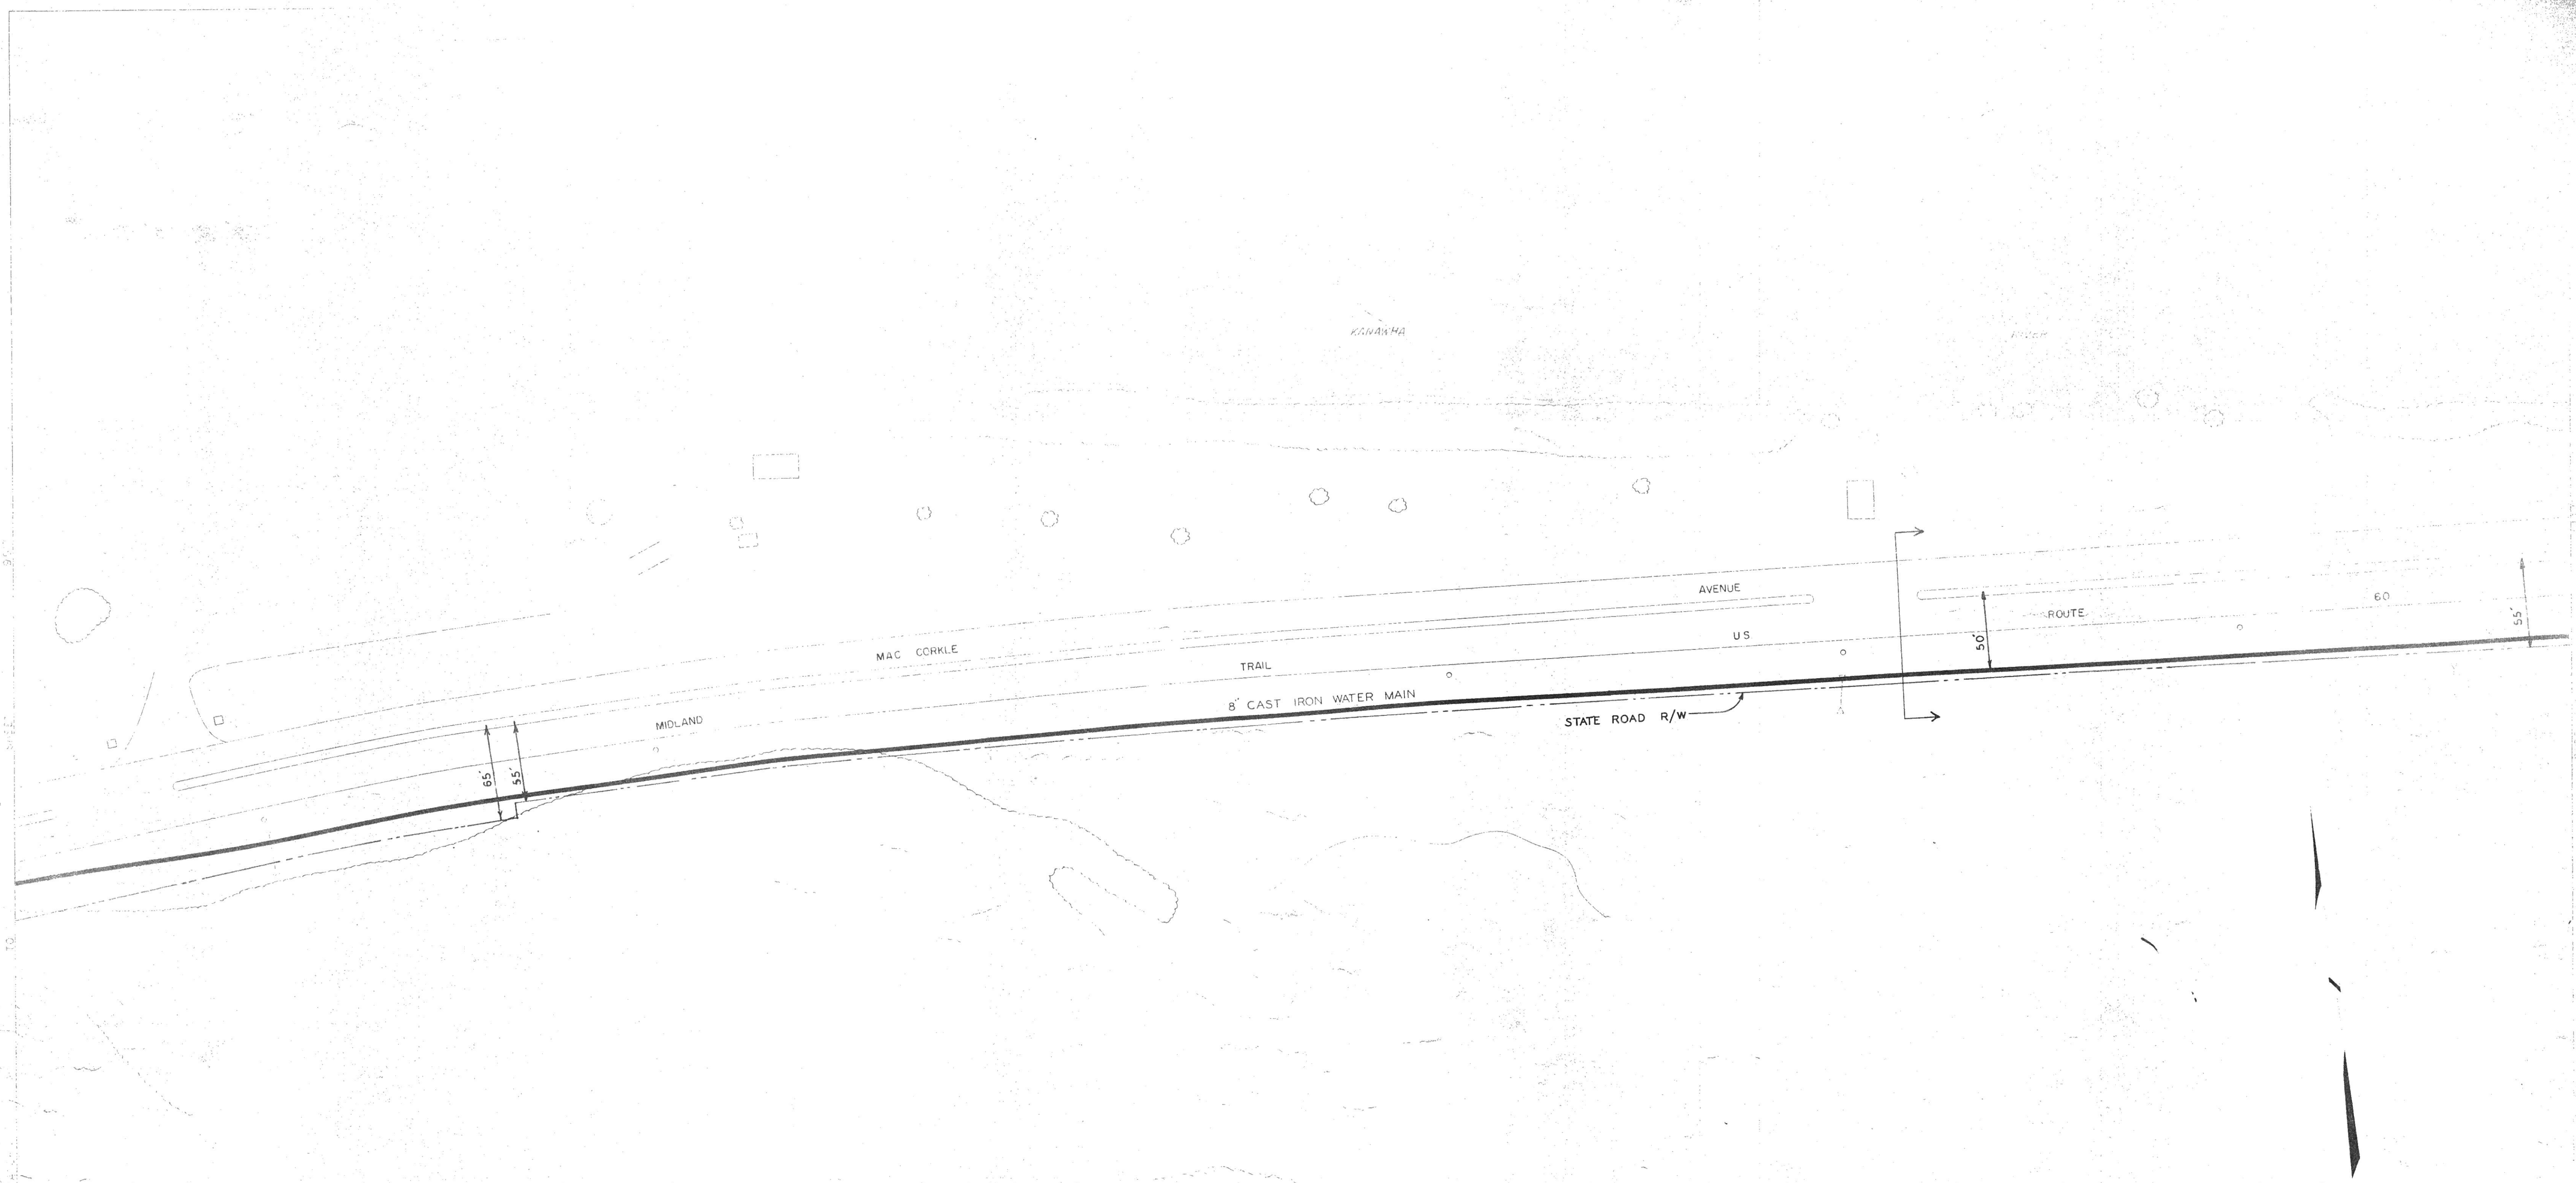

1	4-64	AS BUILT
NO	DATE	DISCUSSION
CITY OF SAINT ALBANS		
MUNICIPAL UTILITY COMMISSION		
KANAWHA COUNTY		WEST VIRGINIA
PROPOSED IMPROVEMENTS		
WATER DISTRIBUTION SYSTEM		
APW-WVA-16G		
MARCH 1963	1" = 50'	9518-1
J. L. HARRIS & SONS, INC., CONSULTING ENGINEERS		
1000 WEST VIRGINIA		