
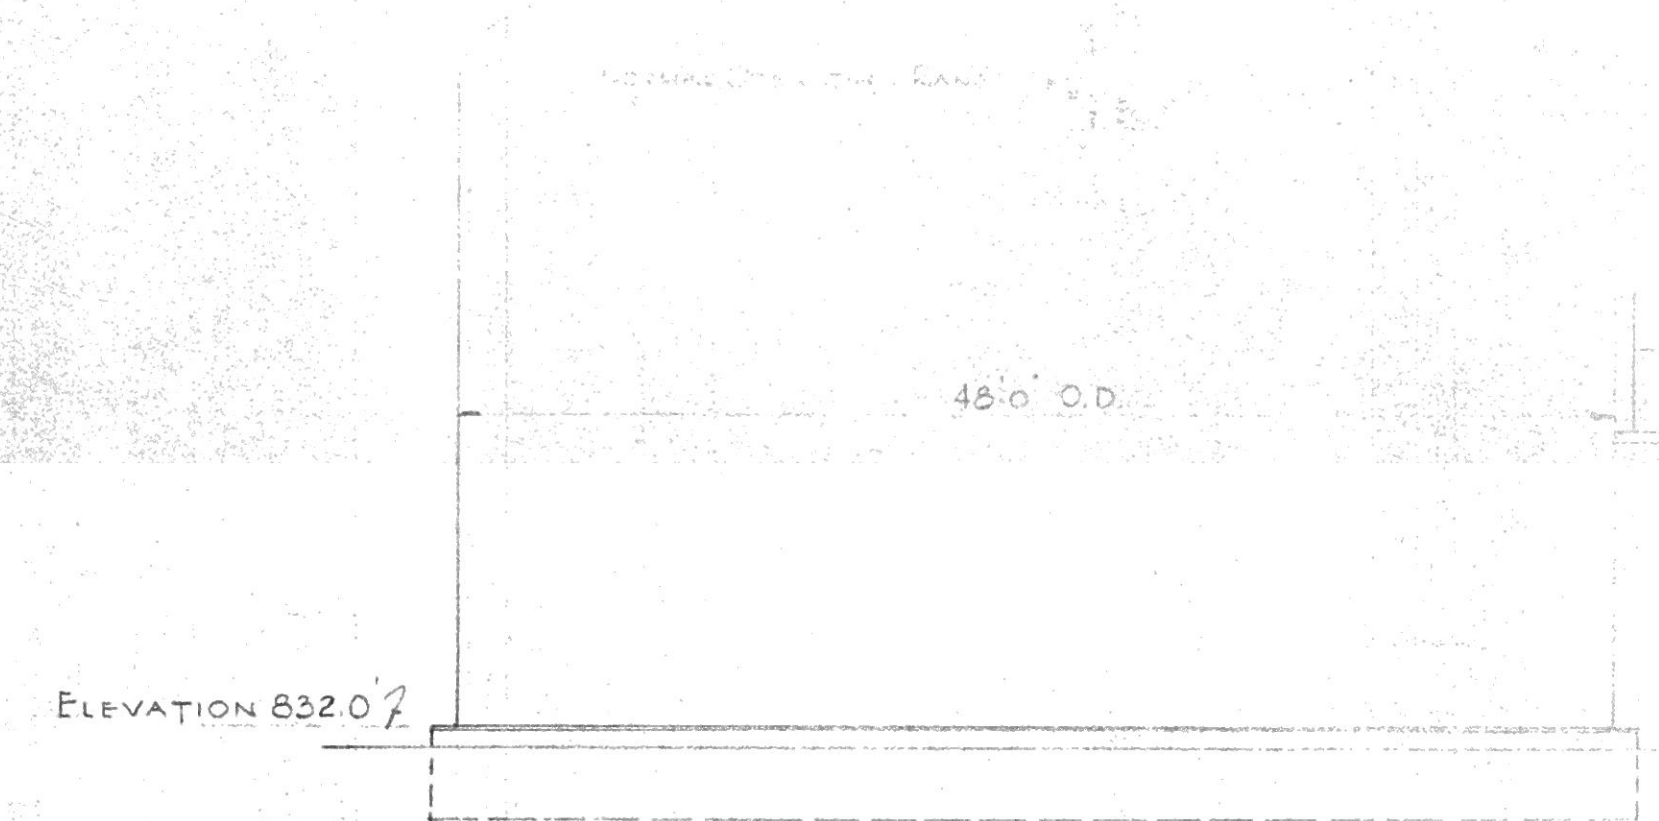


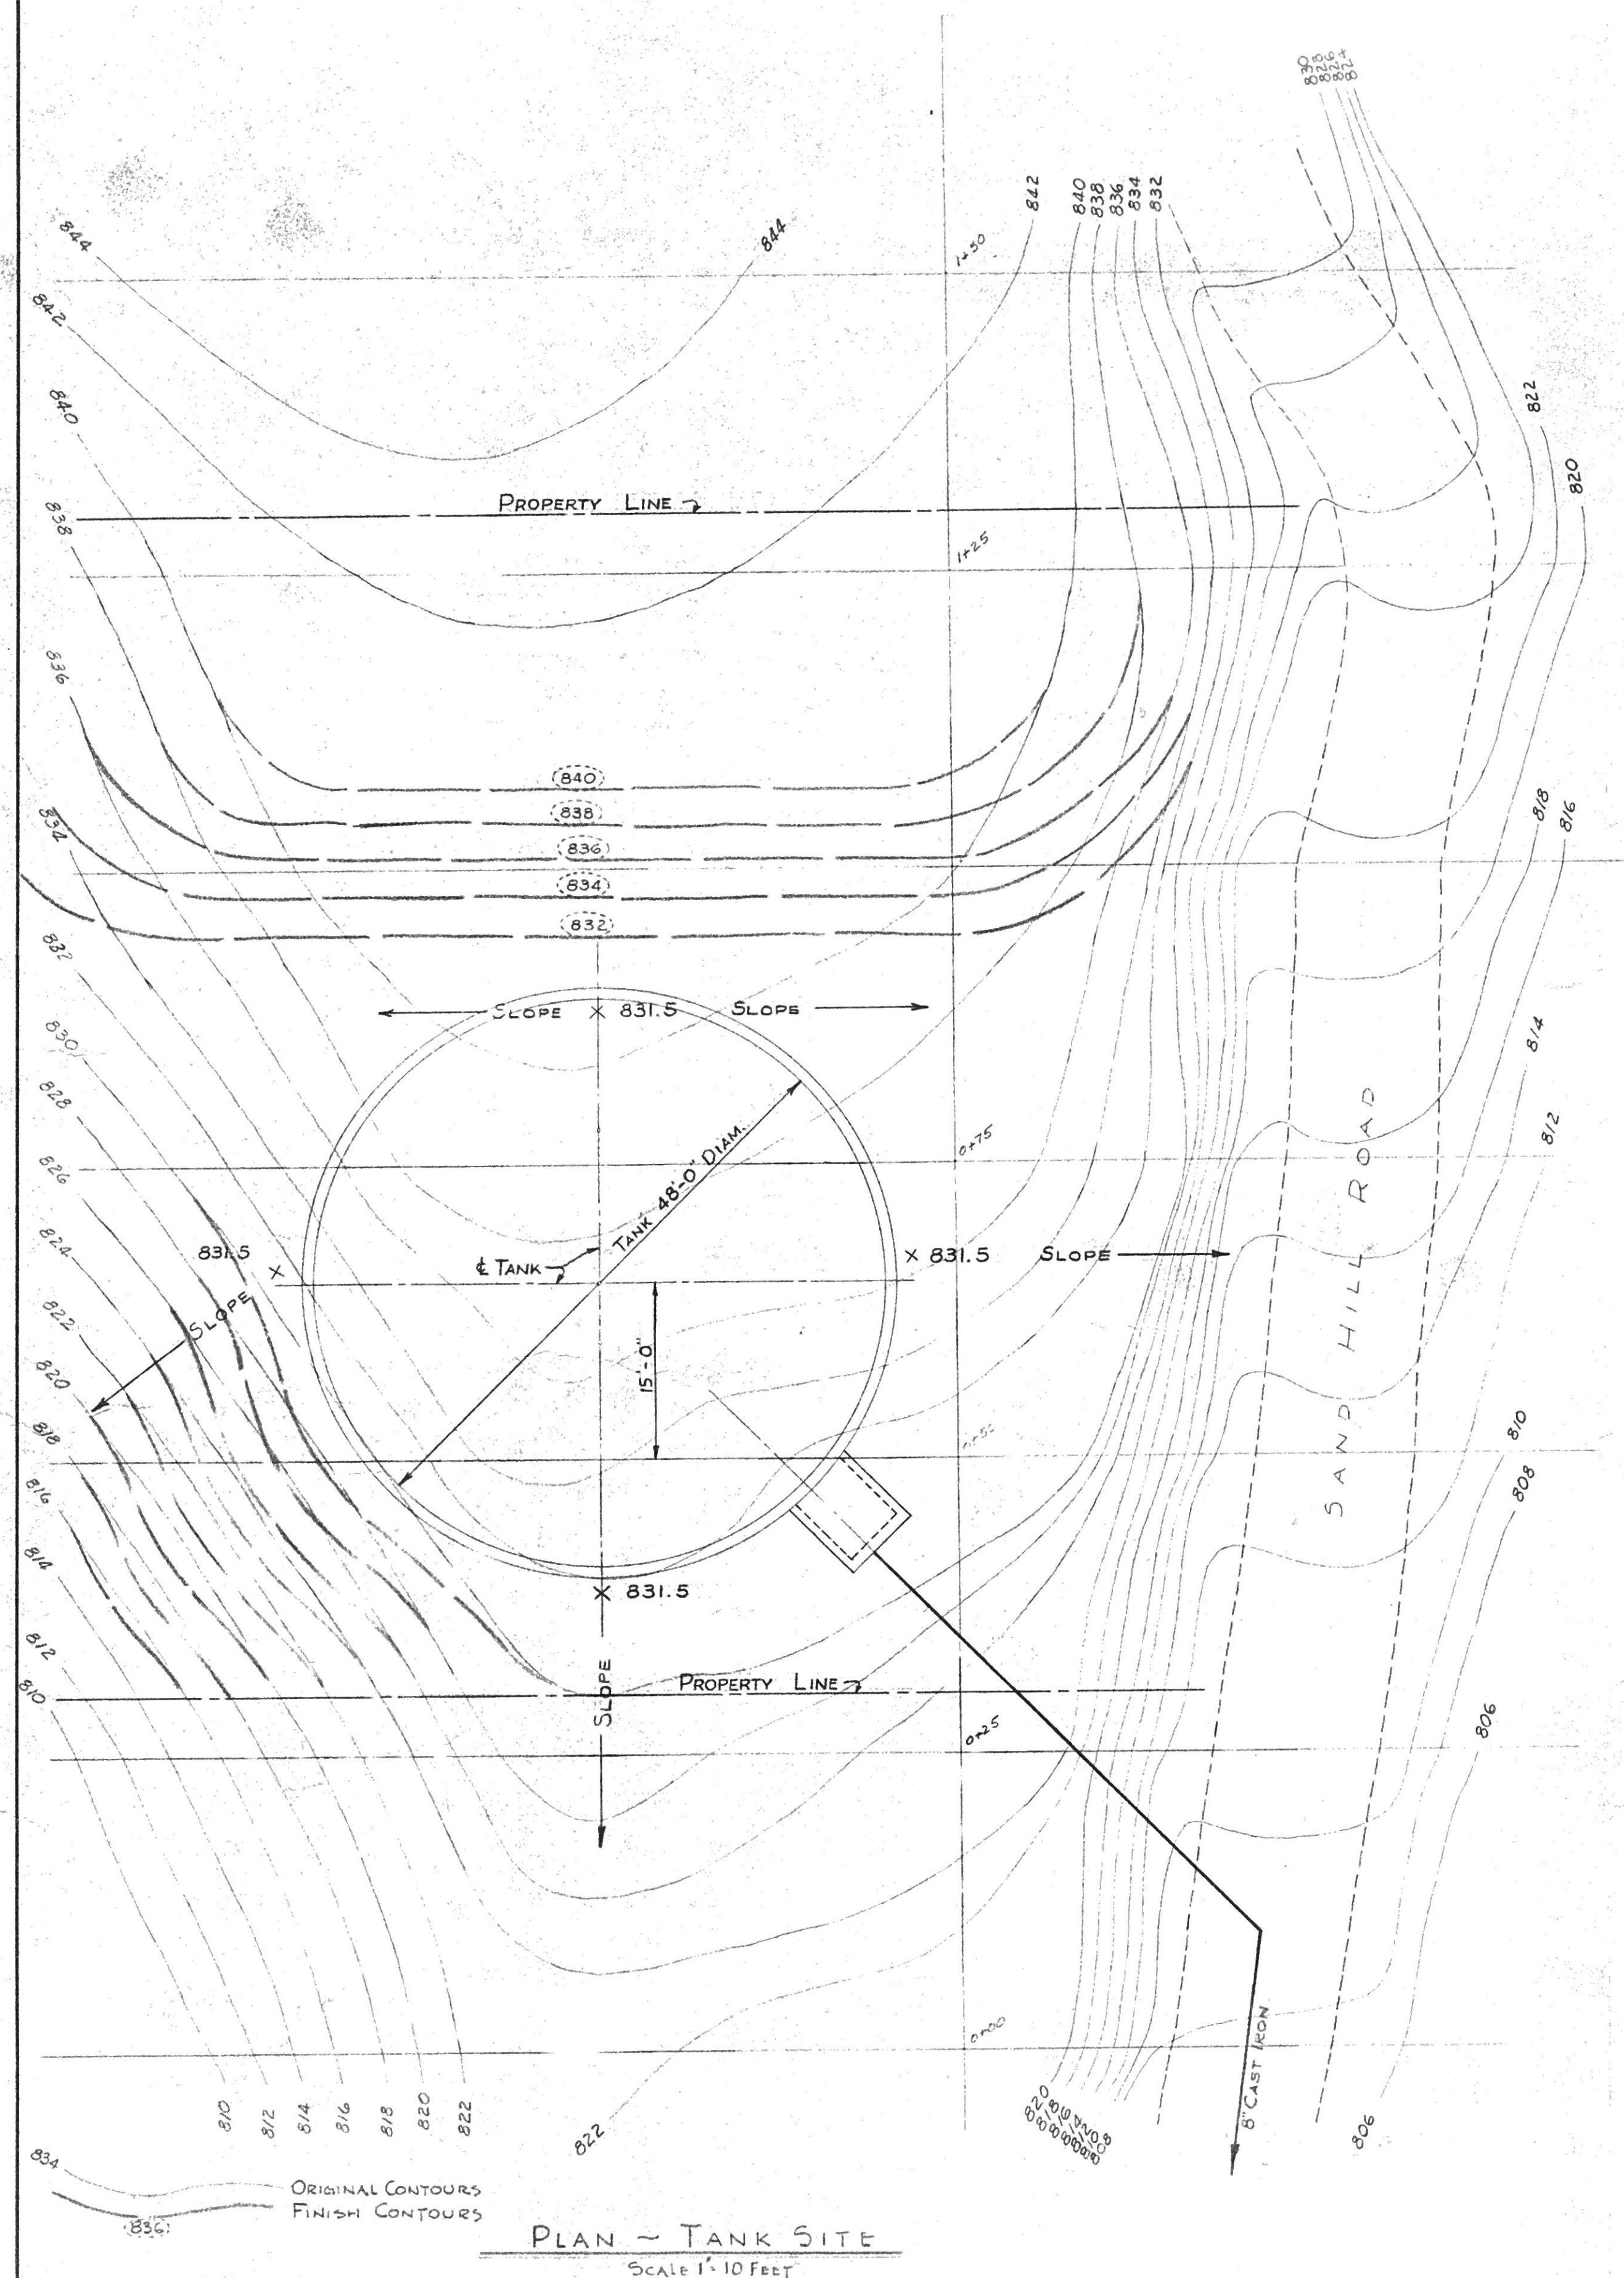

400,000 GAL. TANK ELEVATION
Scale 1/8" = 1'-0"

- TANK SPECIFICATIONS**
- TANK: 48'-0" DIA x 35'-0" OVERALL HEIGHT
MIN. PLATE THICKNESS 1/4"
- TANK ACCESSORIES**
- SHELL MANHOLE 24" MIN. DIA.
 - ROOF HATCH, MIN. OPENING 24", HINGED WITH HASP
 - OUTSIDE LADDER: 12 FT. ABOVE GRADE TO TOP WITH SAFETY CAGE
 - INSIDE LADDER: TOP SHELL TO TANK BOTTOM WITH ACCESS PLATFORM
 - PAINTER'S TROLLEY: INSIDE & OUTSIDE
 - ROOF FINIAL
 - 8" C.I.M.J. 90° BASE ELBOW & C.I.C.L. PIPE
 - INFLUENT WITH STANDARD CAULKING RING
 - PROVIDE ALTITUDE GAGE IN PIT WITH HYDRO-MERCURY CONTROLS
 - ELLIPTICAL ROOF
 - TANK SHALL CONFORM WITH AWWA SPECS D-100-59
- SEE DETAIL SPECIFICATIONS FOR PAINTING INSTRUCTIONS

2	4-64	AS BUILT
1	7-63	RELOCATED TANK 15' DOWNHILL - LOWERED 3'
No.	DATE	DESCRIPTION
REVISIONS		
MUNICIPAL UTILITY COMMISSION		
CITY OF SAINT ALBANS		
KANAWHA COUNTY WEST VIRGINIA		
PROPOSED IMPROVEMENTS		
EAST END STORAGE TANK		
PLOT PLAN & ELEVATION		
DATE	SCALE	DRAWING NO.
MARCH 1963	AS SHOWN	9502-2
KELLY JOHNS & STALL, INC., CONSULTING ENGINEERS		
SAND HILL ROAD, SAINT ALBANS, W. VA.		