


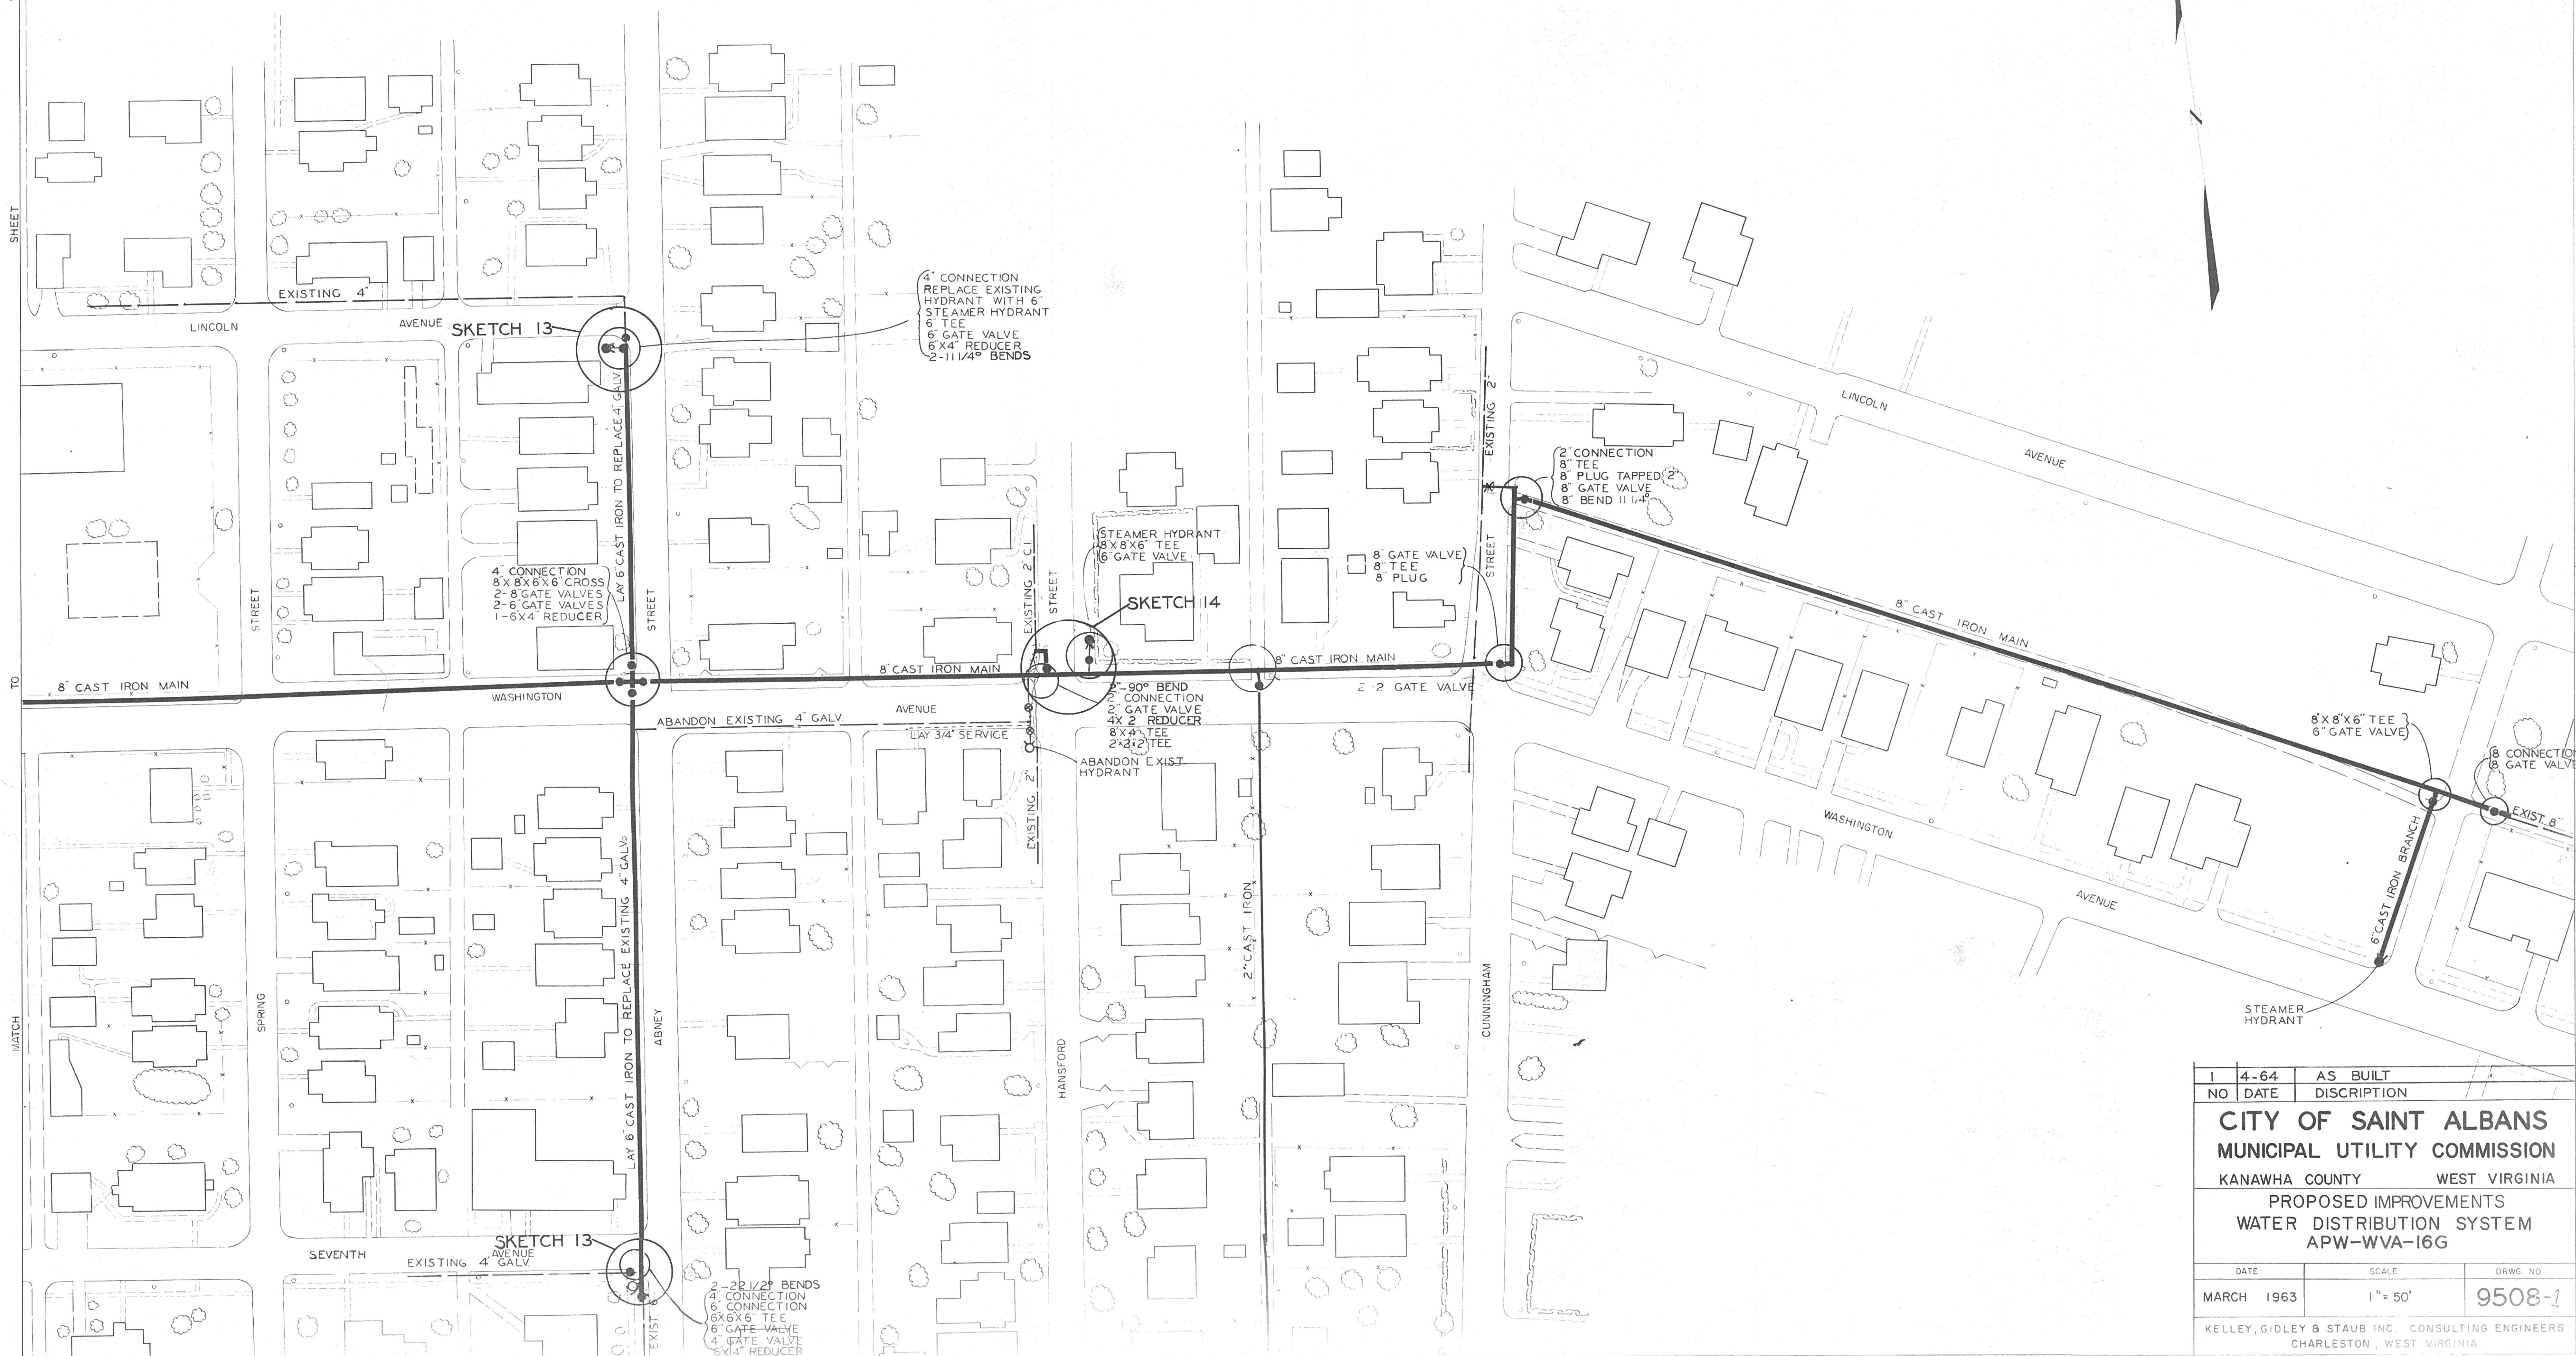

NO	DATE	AS BUILT DISCRIPTION
1	4-64	AS BUILT
CITY OF SAINT ALBANS MUNICIPAL UTILITY COMMISSION		
KANAWHA COUNTY WEST VIRGINIA		
PROPOSED IMPROVEMENTS WATER DISTRIBUTION SYSTEM APW-WVA-16G		
DATE	SCALE	DRWG NO
MARCH 1963	1" = 50'	9508-1
KELLEY, GIDLEY & STAUB INC. CONSULTING ENGINEERS CHARLESTON, WEST VIRGINIA		