




SECTION A-A
SCALE: 1/4\"/>

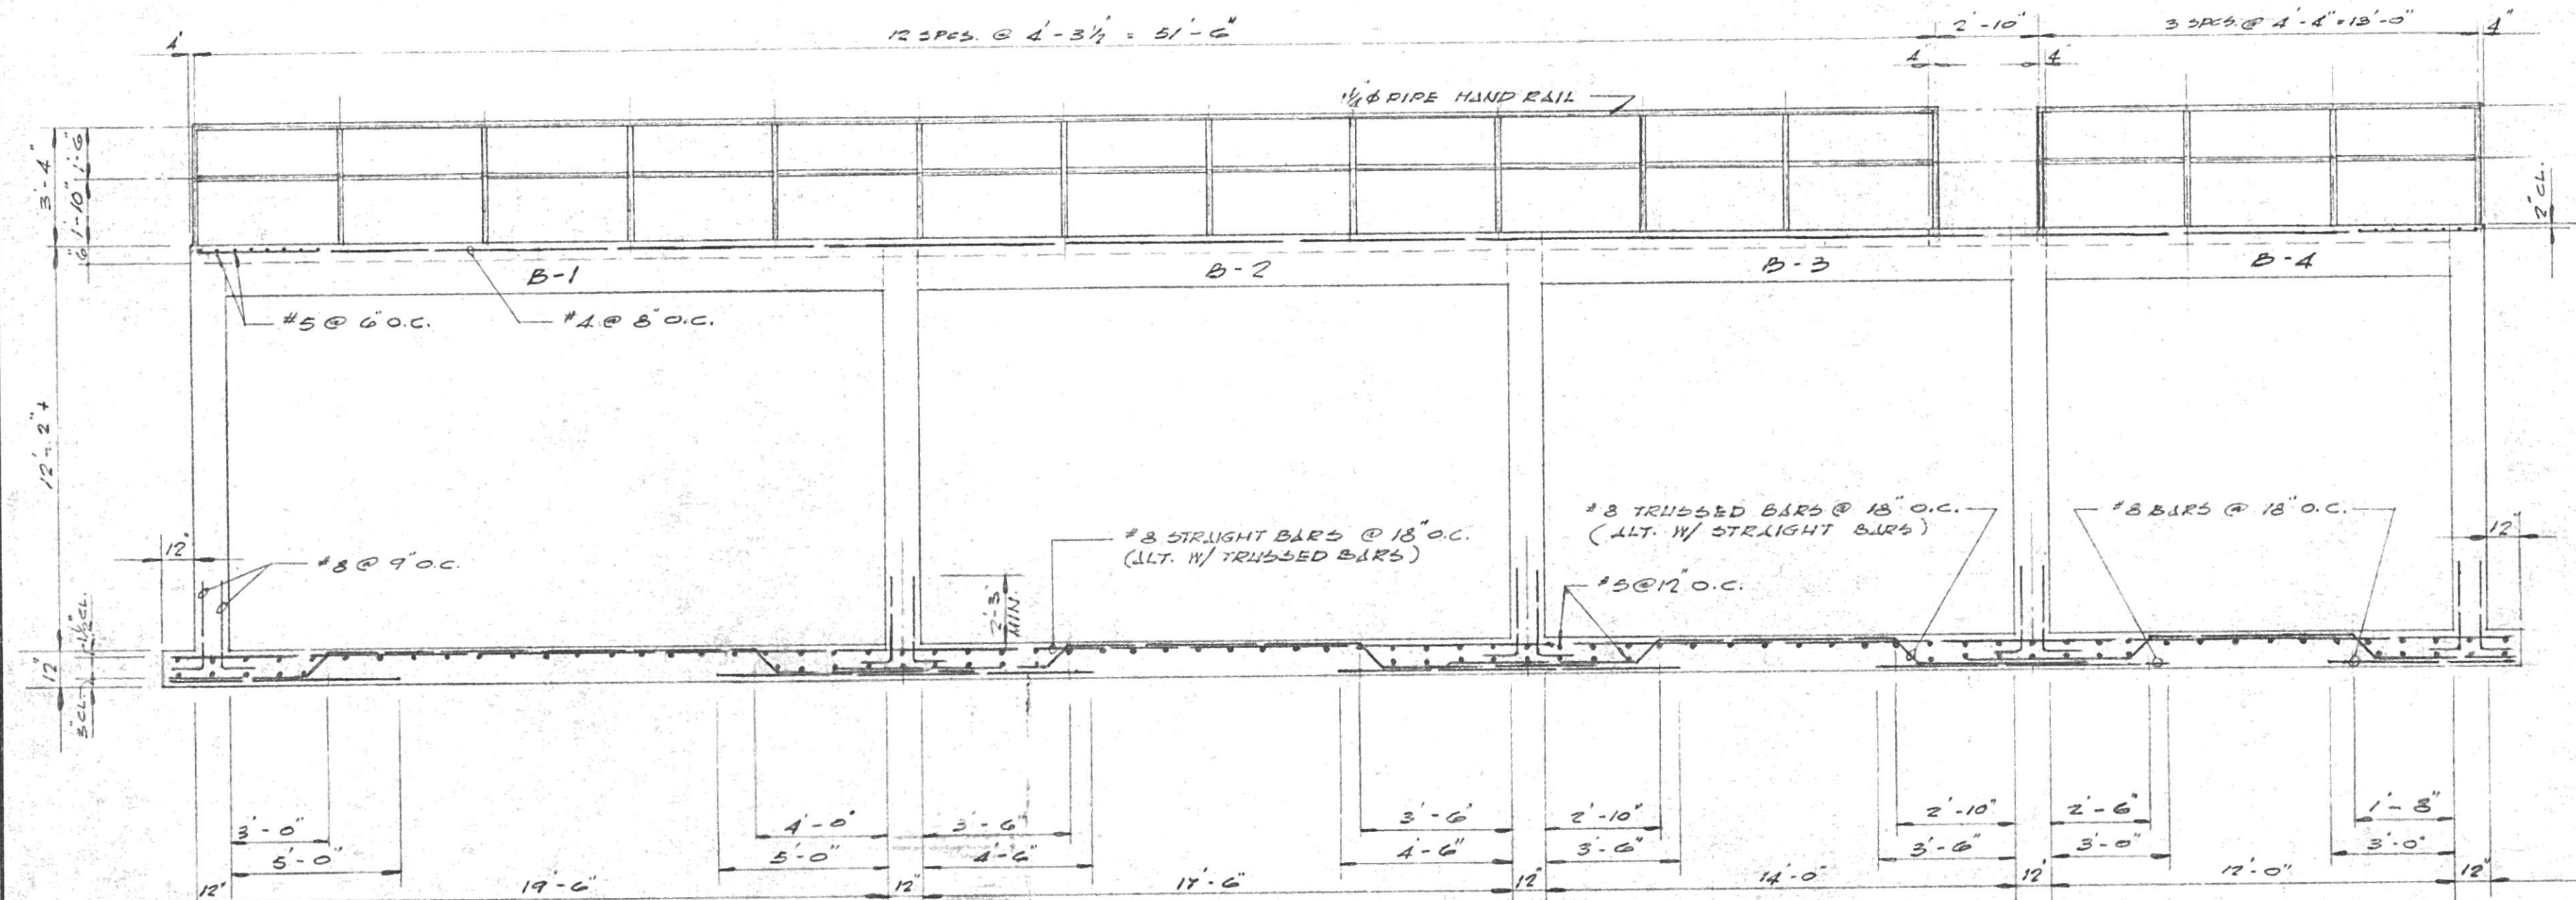


SECTION B-B
SCALE: 1/4\"/>

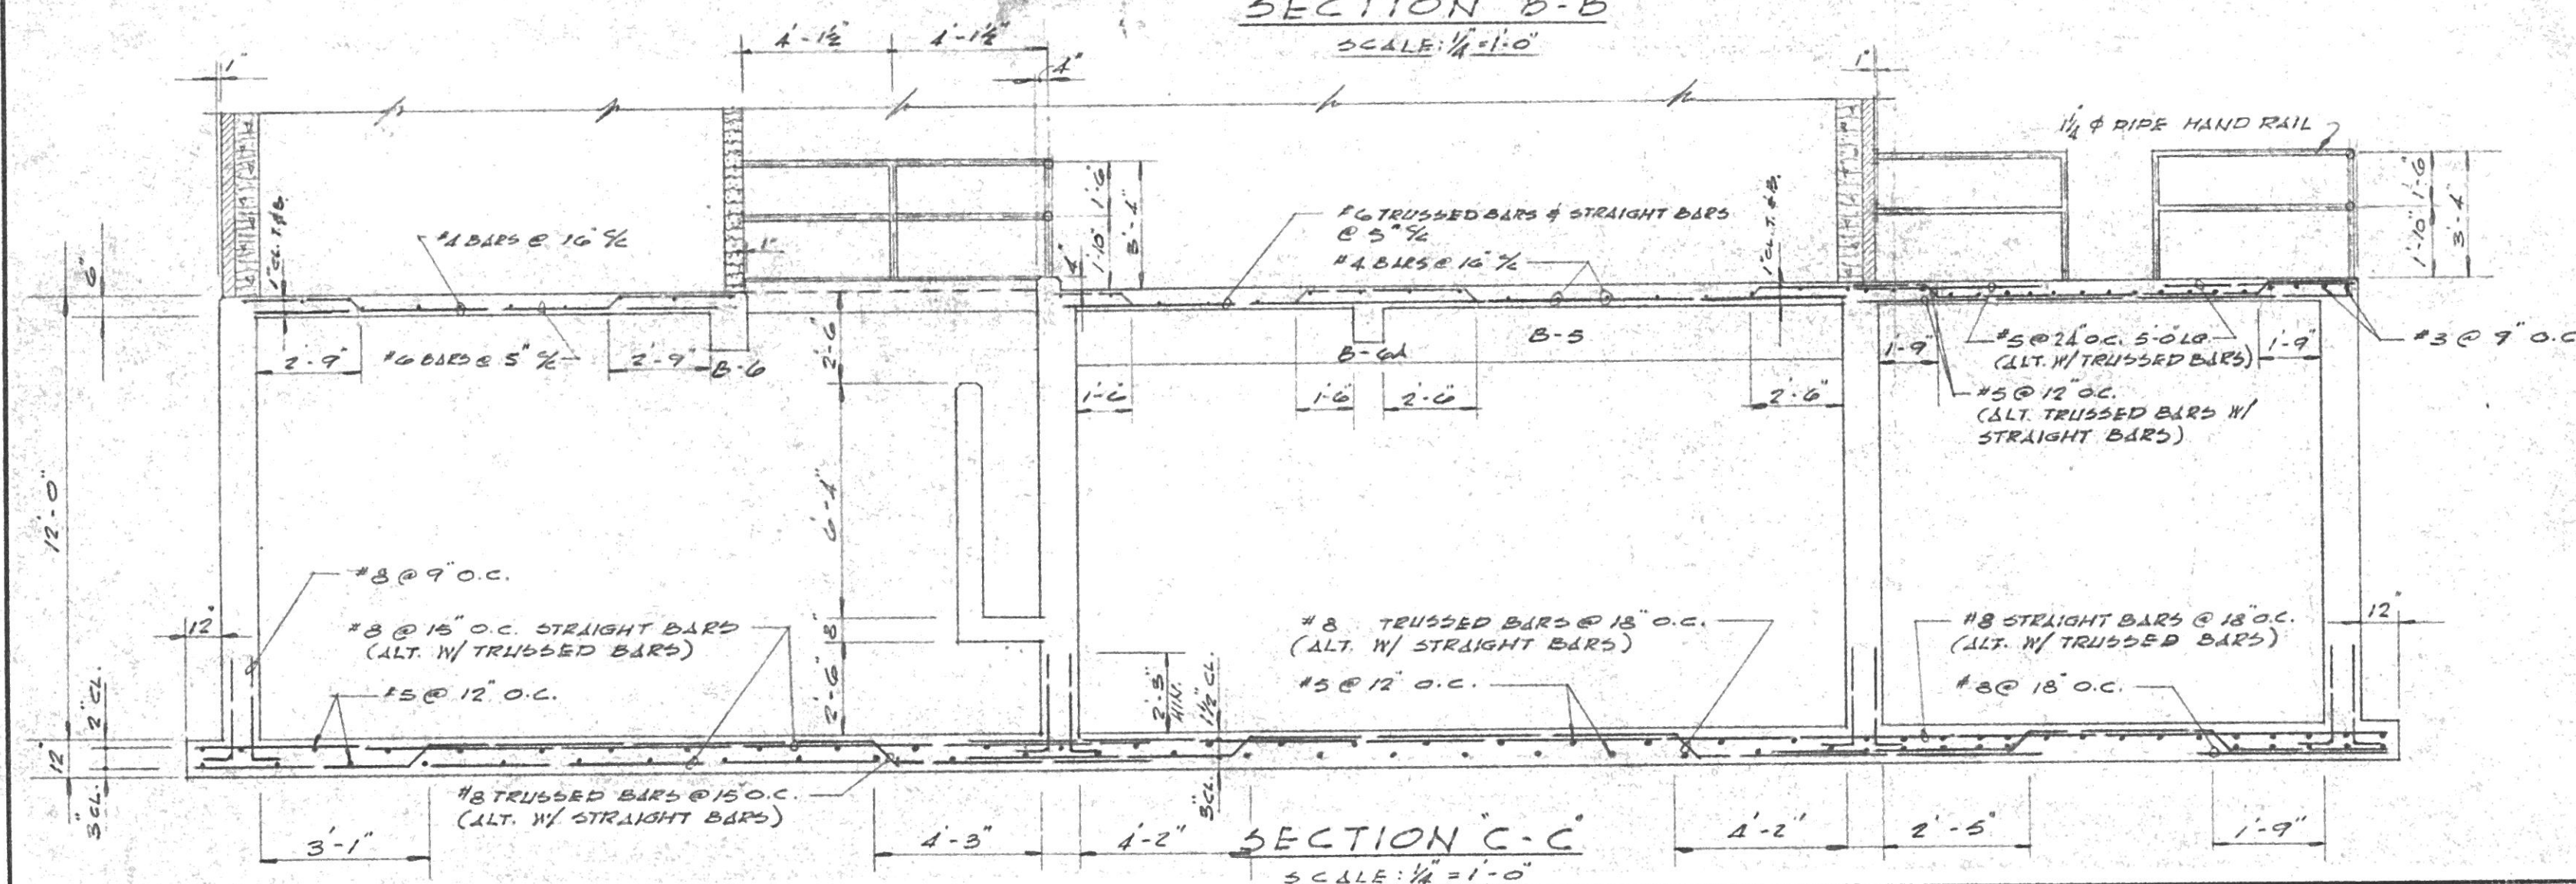


SECTION C-C
SCALE: 1/4\"/>

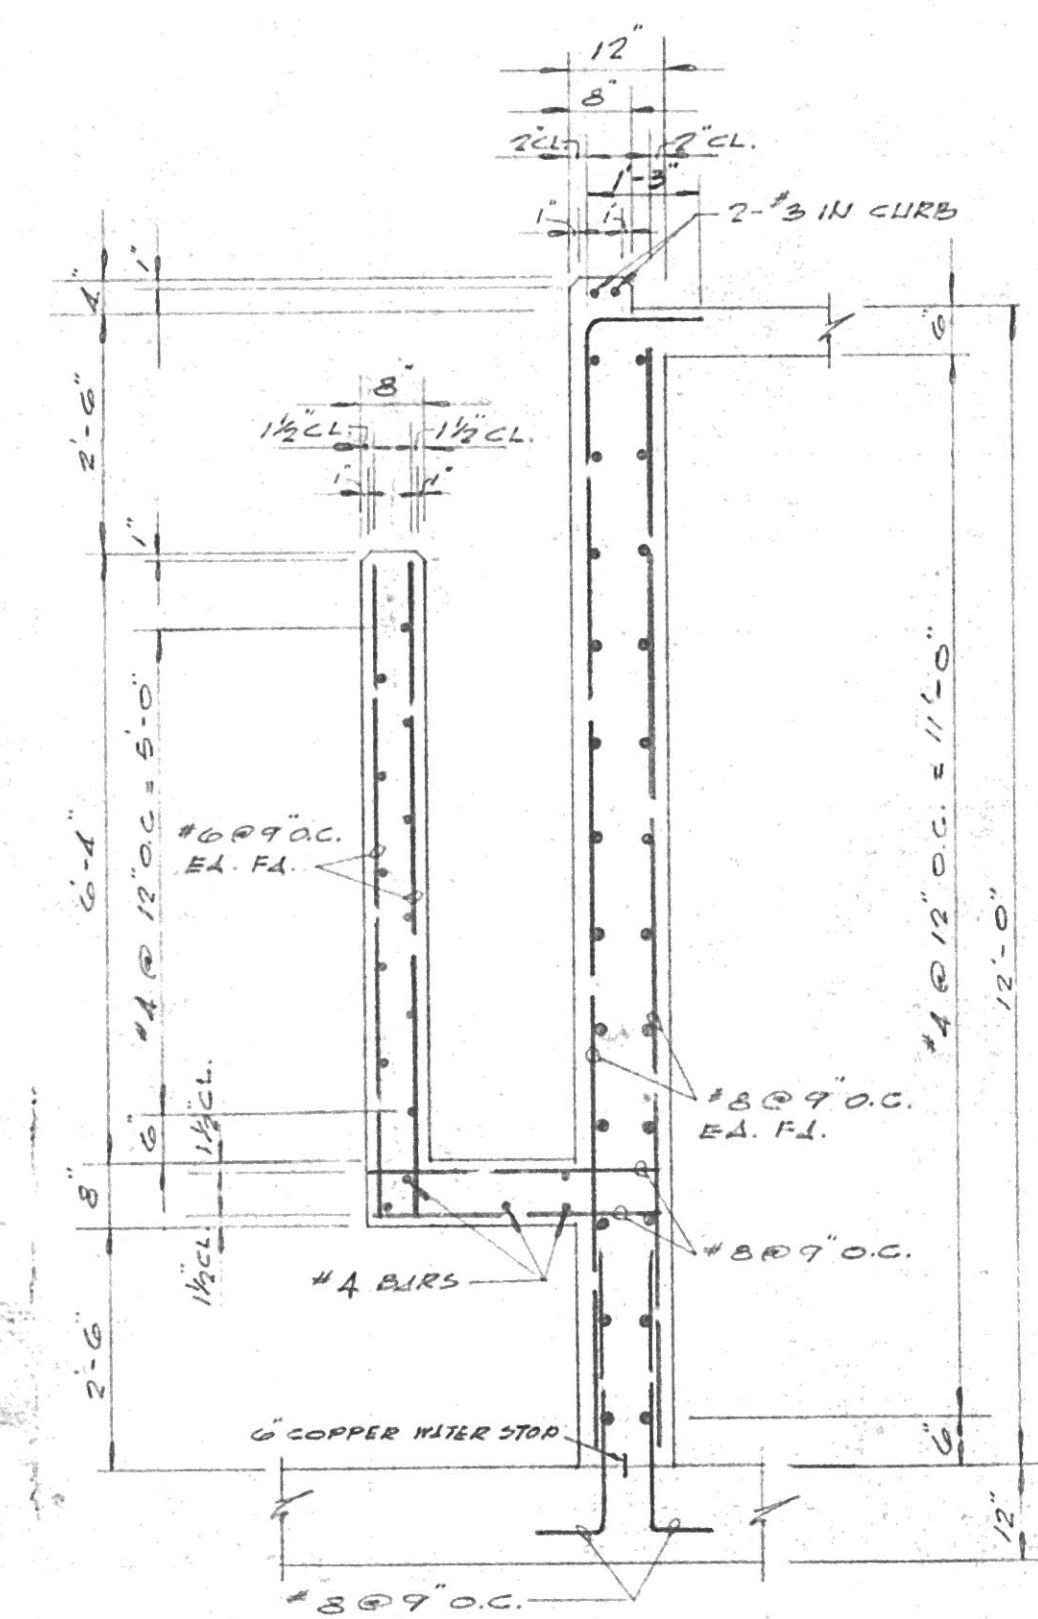

SECTION D-D
SCALE: 1/2\"/>

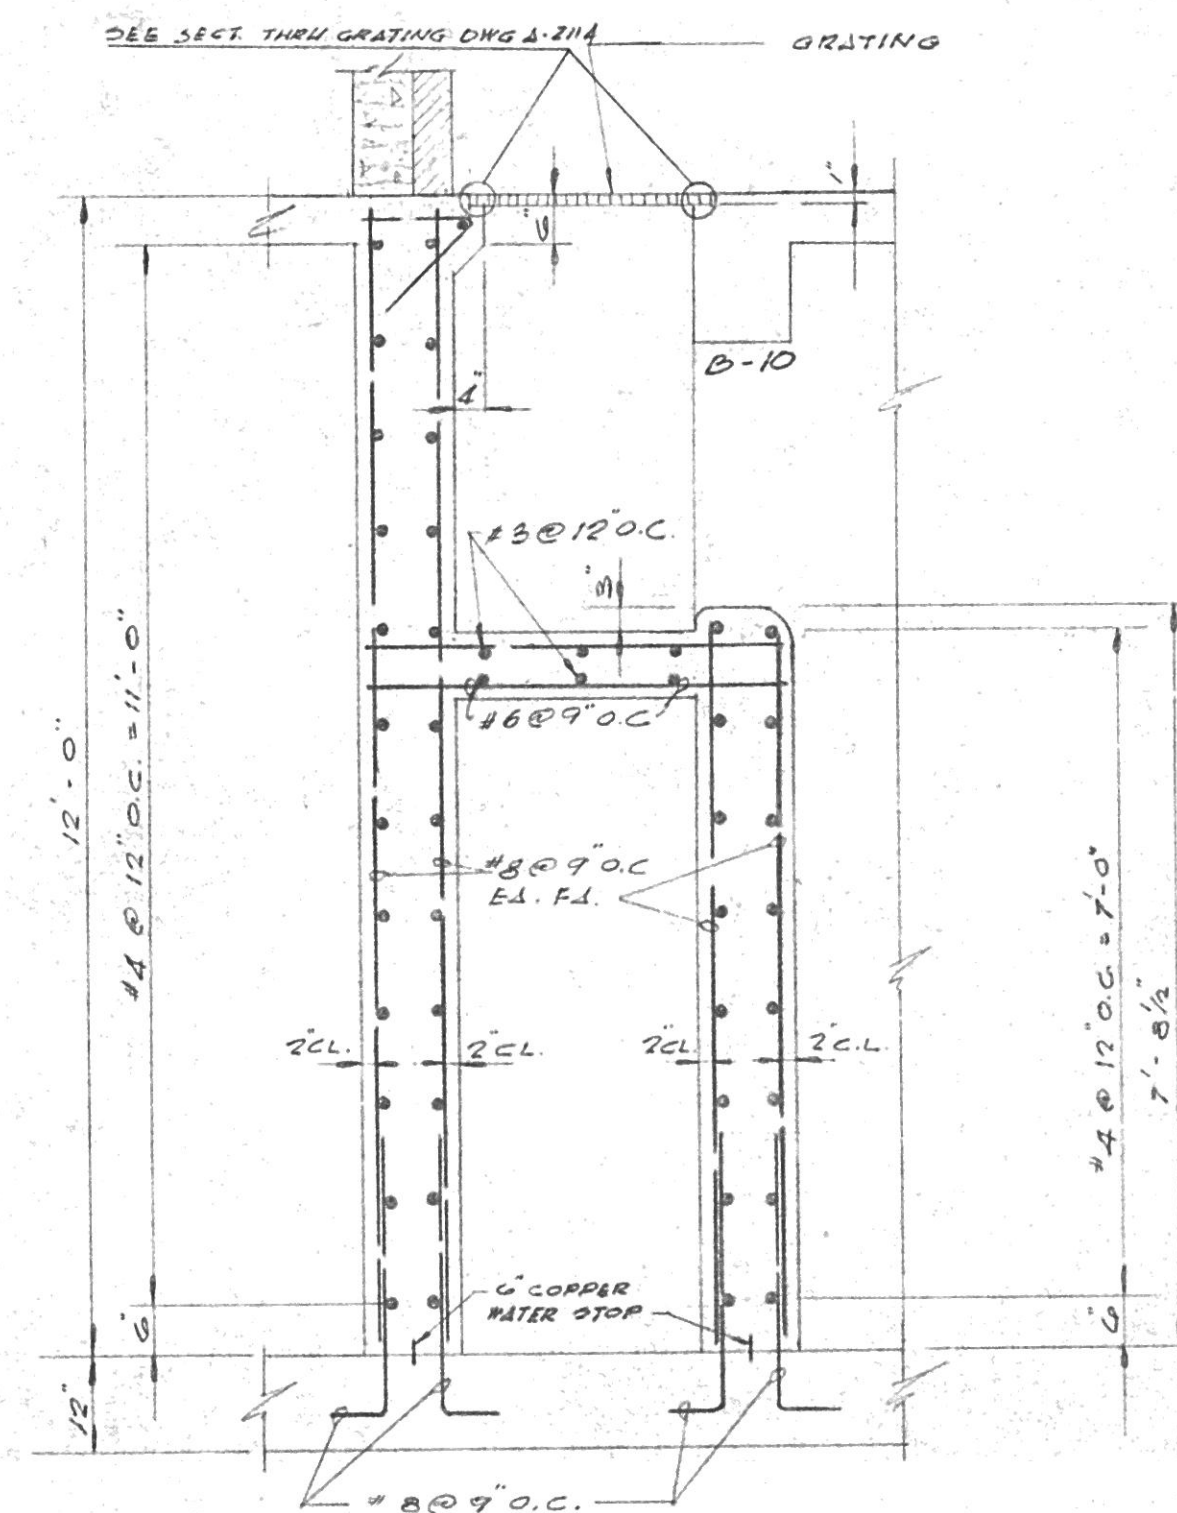

SECTION E-E
SCALE: 1/2\"/>

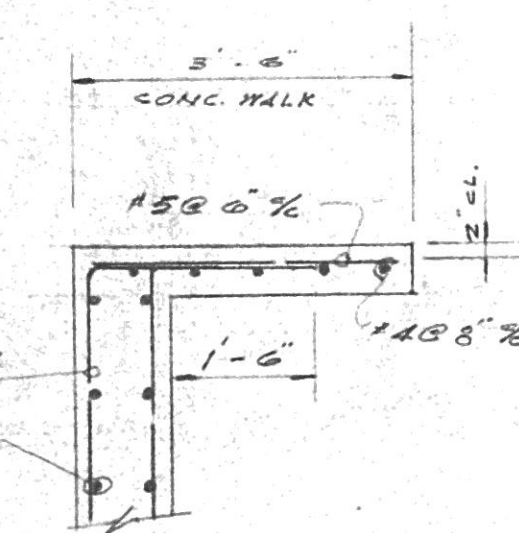

SECTION O-O
SCALE: 1/4\"/>

WEST VIRGINIA
STATE DEPARTMENT OF HEALTH
RECEIVED 12-13-67
REJECTED
RETURNED
FOR CHANGES
APPROVED 10-1-67 NO. 2897
DIVISION OF SANITARY ENGINEERING

No.	DATE	DESCRIPTION
REVISIONS		
MUNICIPAL UTILITY COMMISSION		
CITY OF SAINT ALBANS		
KANAWHA COUNTY WEST VIRGINIA		
WATER PROJECT		
FILTER PLANT EXPANSION		
REINFORCED CONCRETE		
SECTIONS AND DETAILS		
CHECKED BY: AFK	APPROVED BY: TJB	DRWG. No.
DATE: SEPT. 1967	SCALE: AS SHOWN	A-2111
KELLEY, GIDLEY, STAUB & BLAIR, INC.		
CONSULTING ENGINEERS • CHARLESTON, WEST VIRGINIA		