




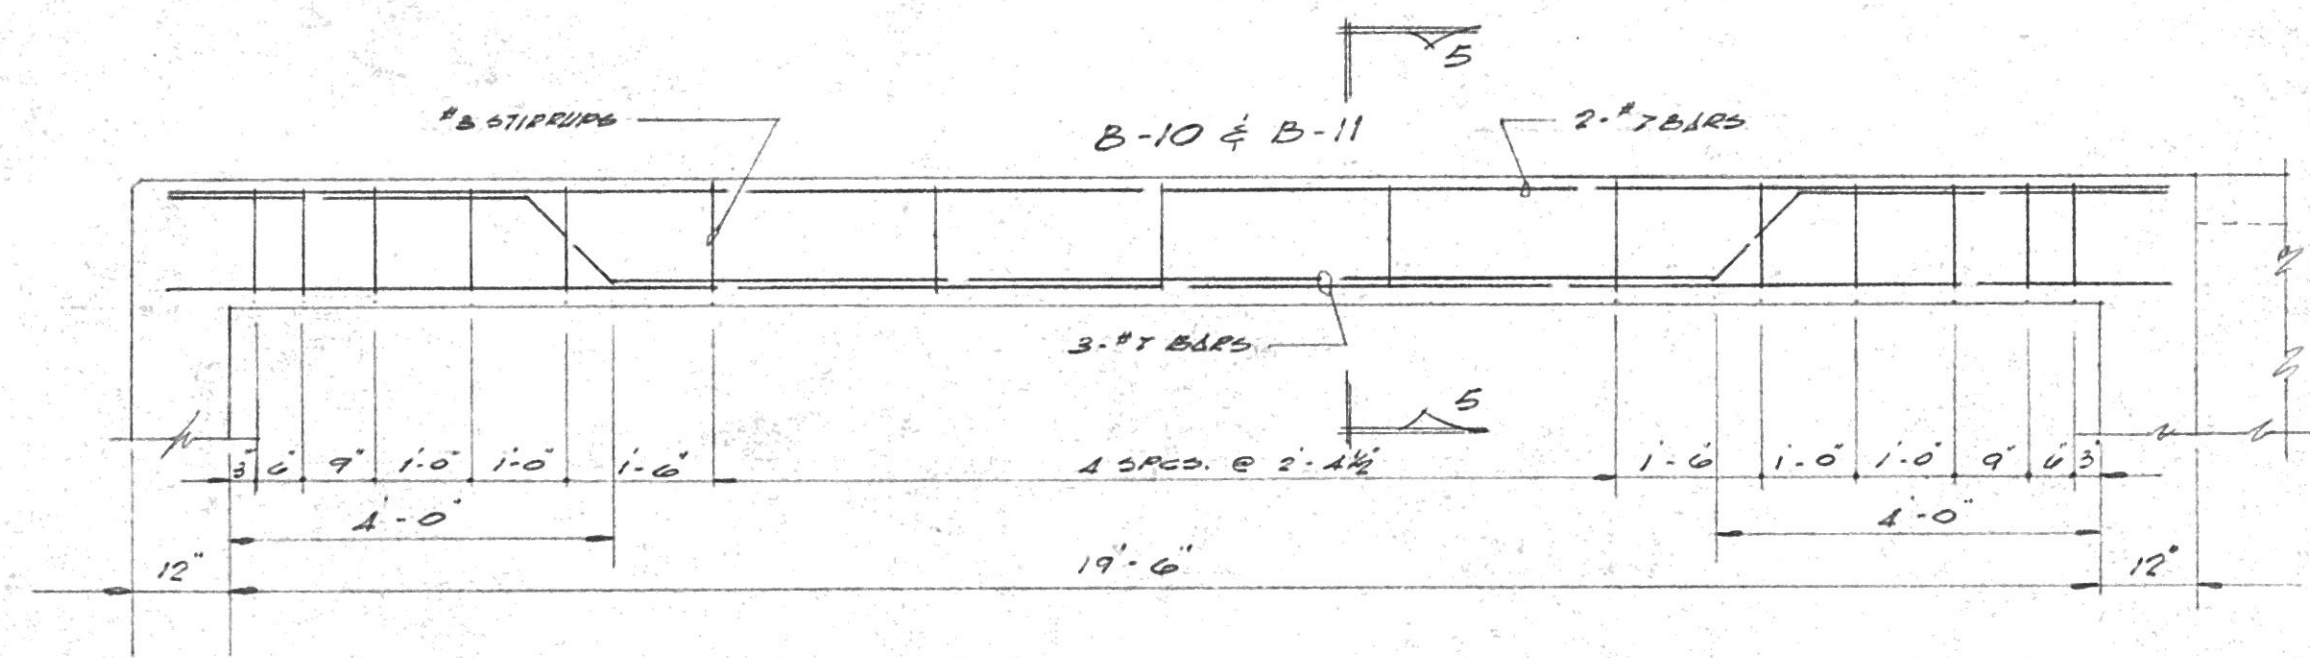


BEAM B-10 & B-11
SCALE: 1/4" = 1'-0"

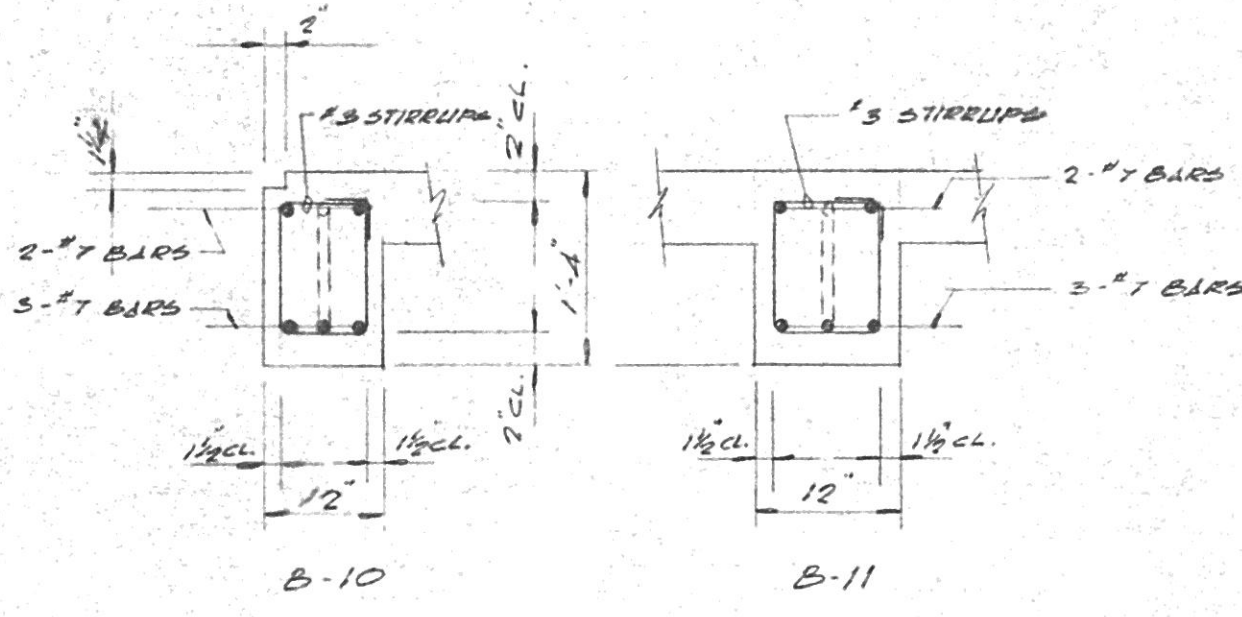



SECTION 5-5
SCALE: 3/4" = 1'-0"

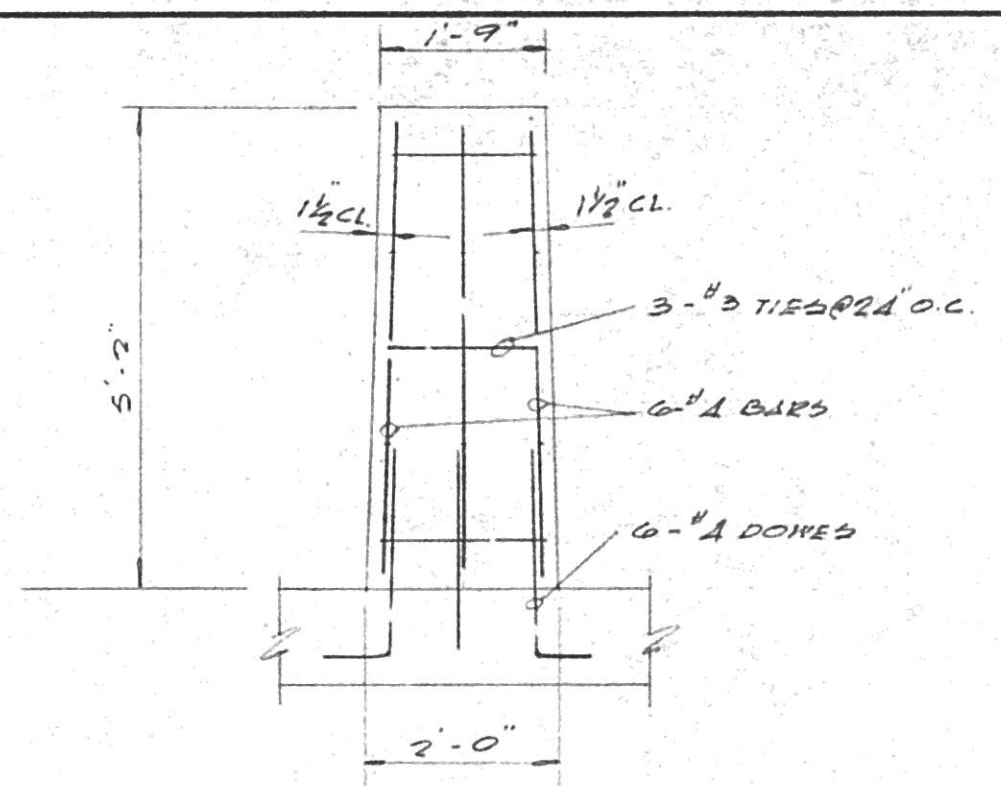


F.L.O.C. SHAFT SUPPORT DETAIL
SCALE: 1/2" = 1'-0"

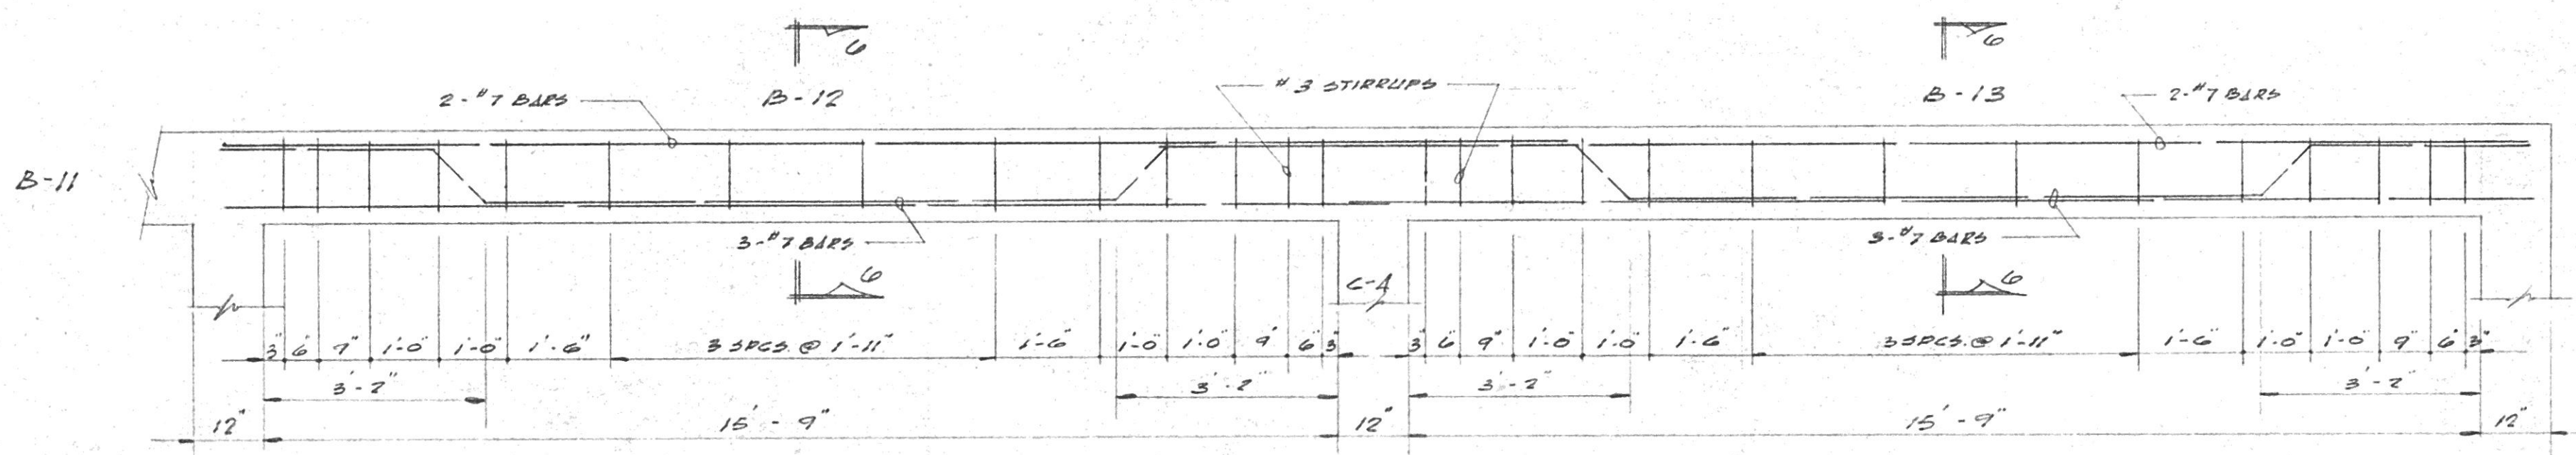


BEAMS B-12 & B-13
SCALE: 1/2" = 1'-0"

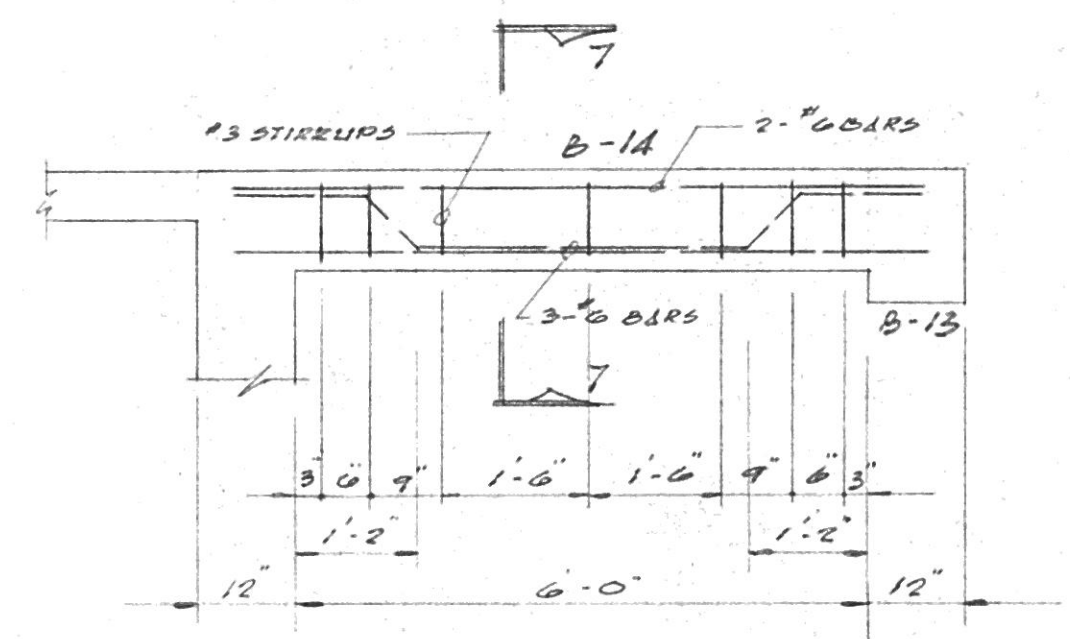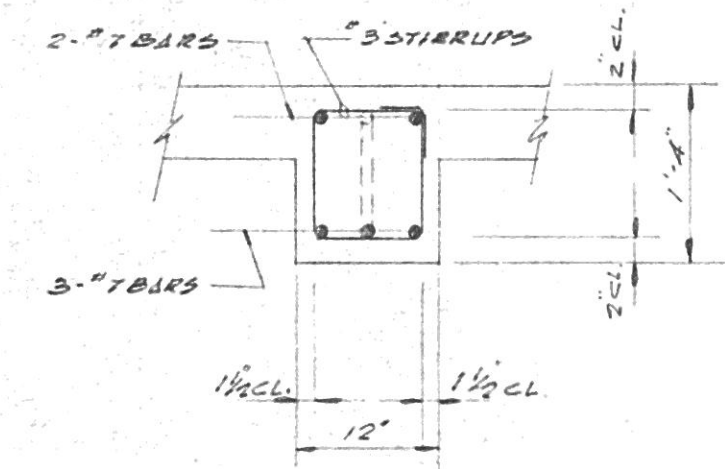


BEAM B-14
SCALE: 1/2" = 1'-0"

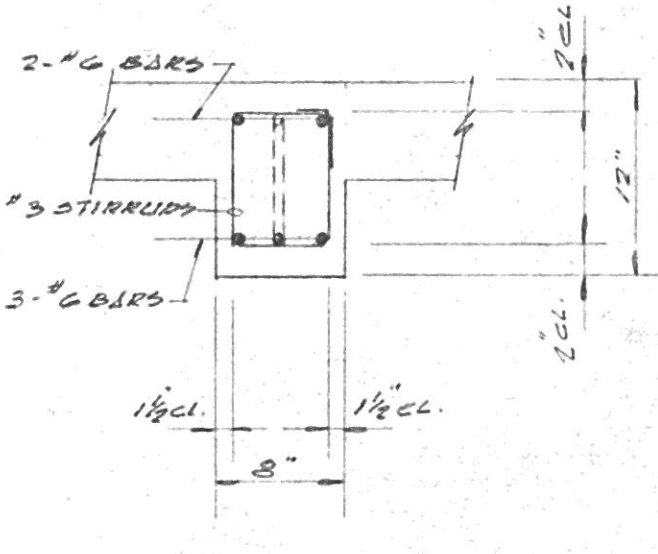


SECTION 7-7
SCALE: 1" = 1'-0"

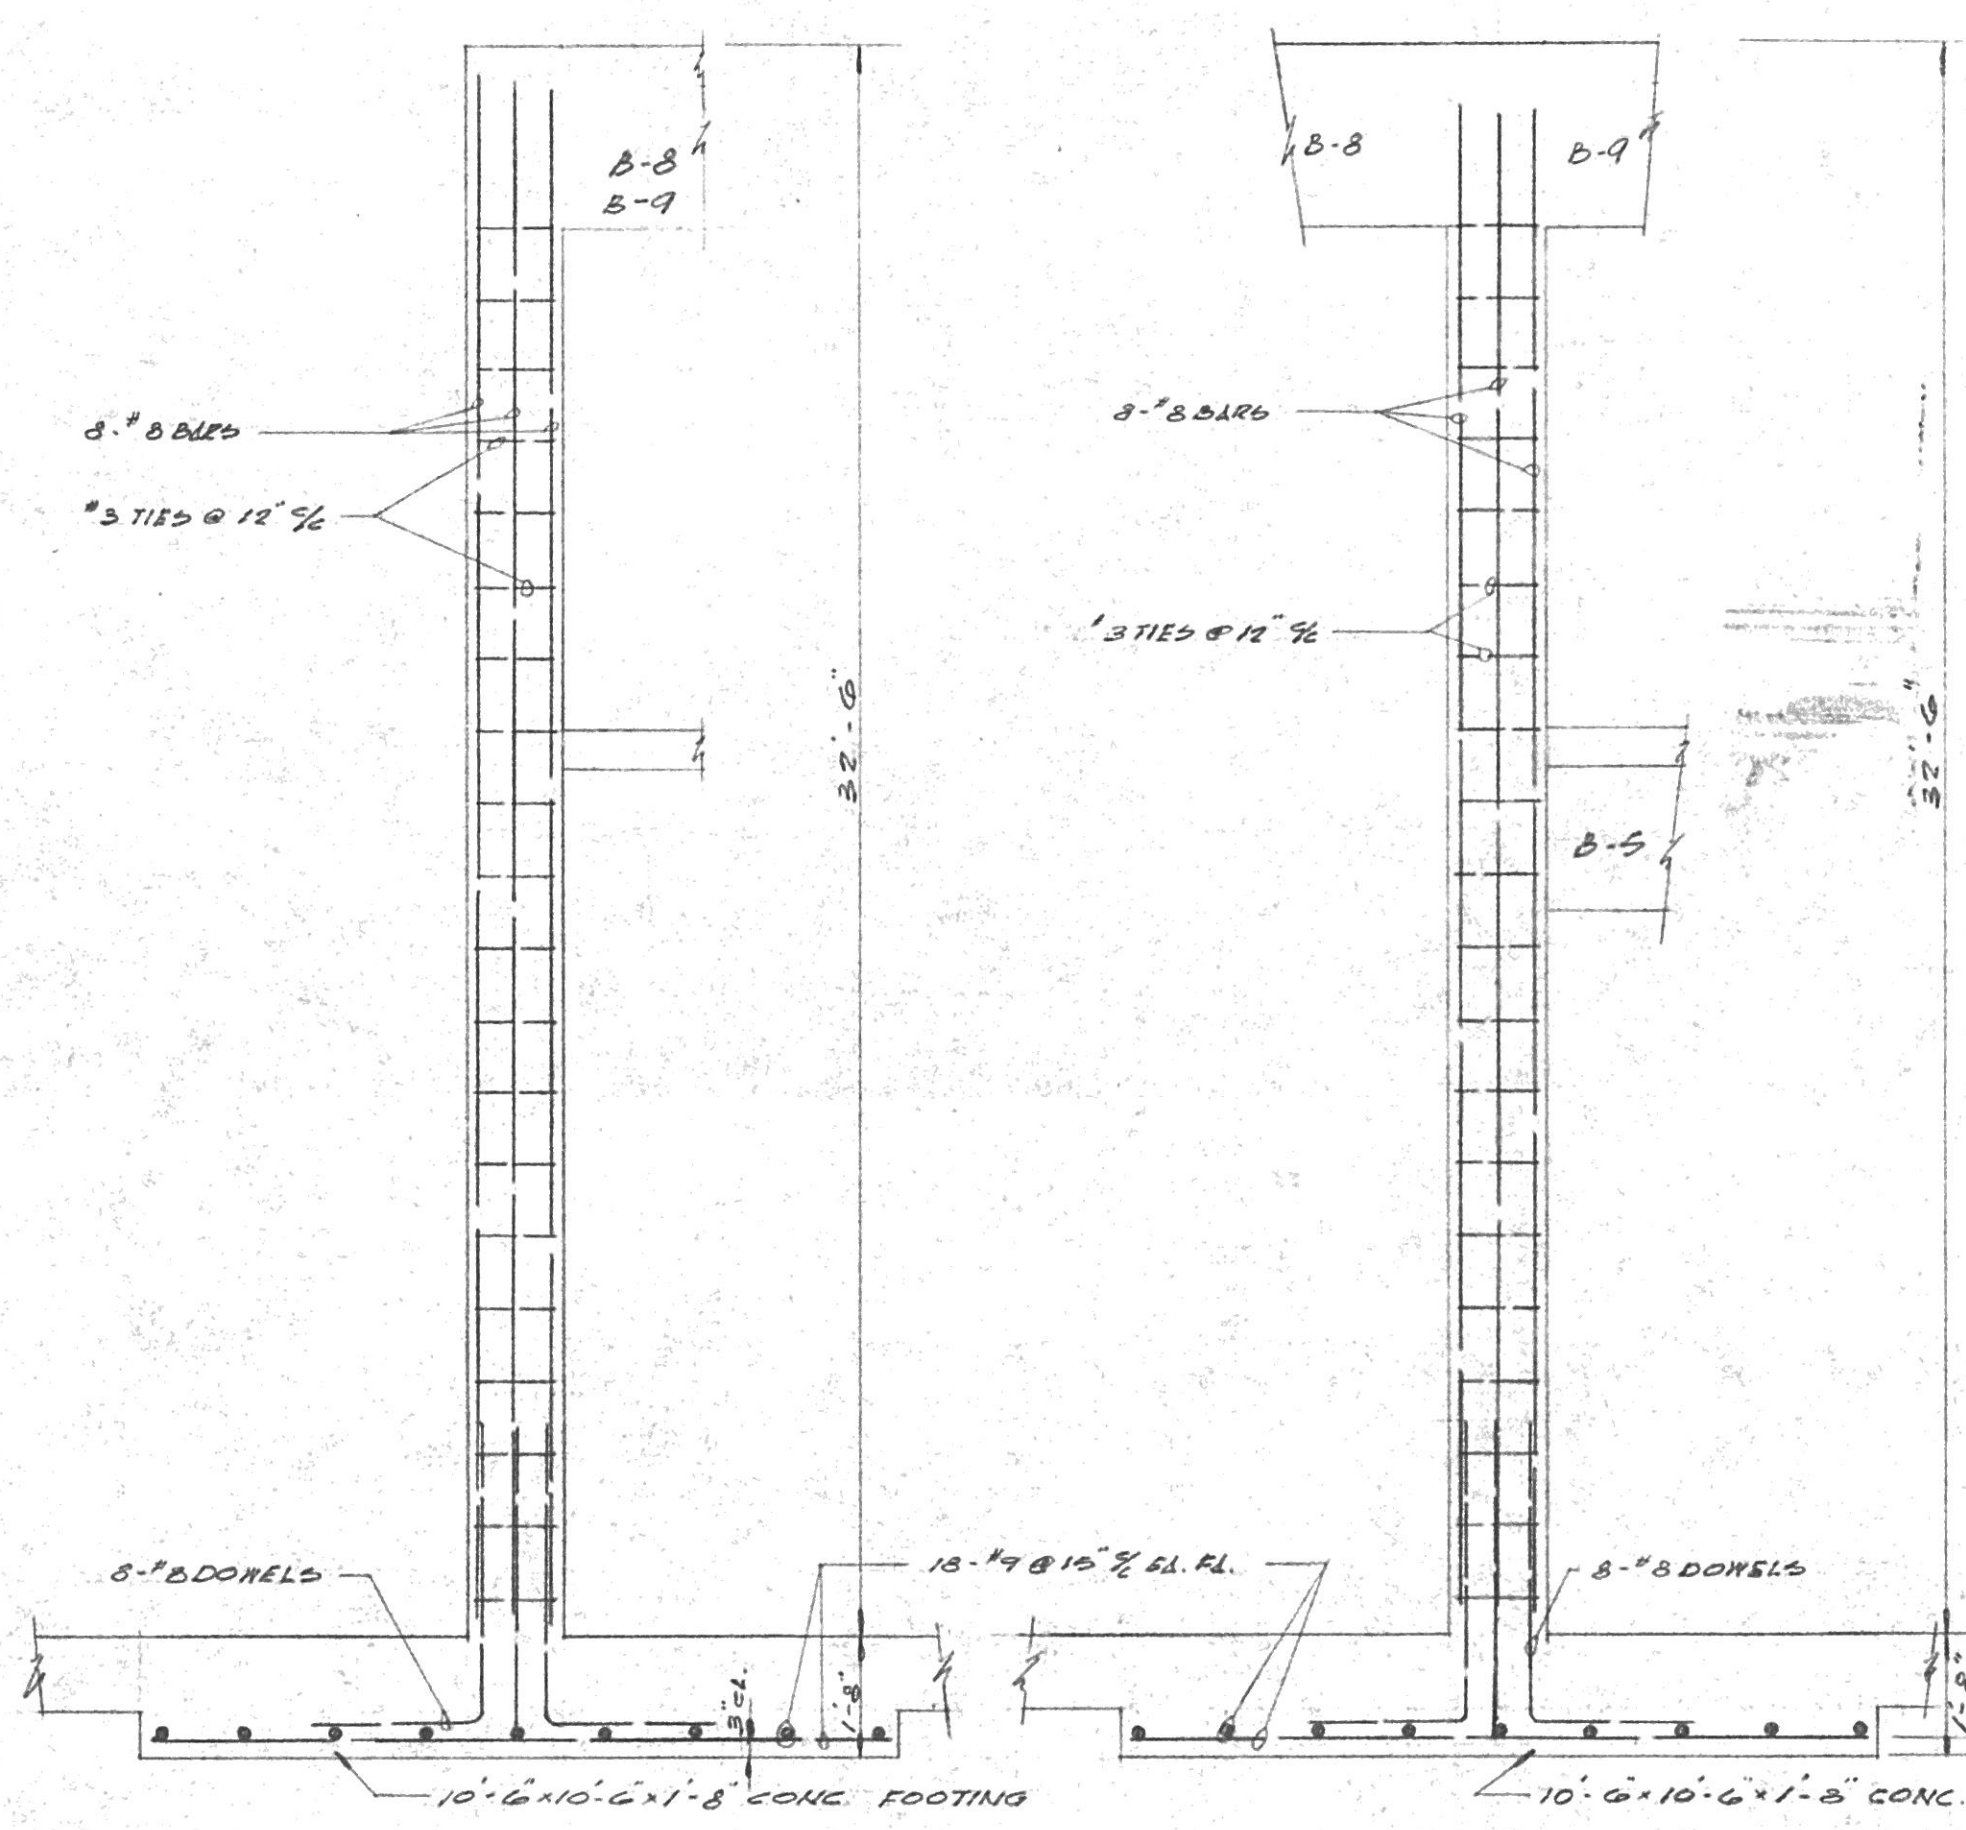


COLUMNS C-1 & C-3
SCALE: 3/4" = 1'-0"

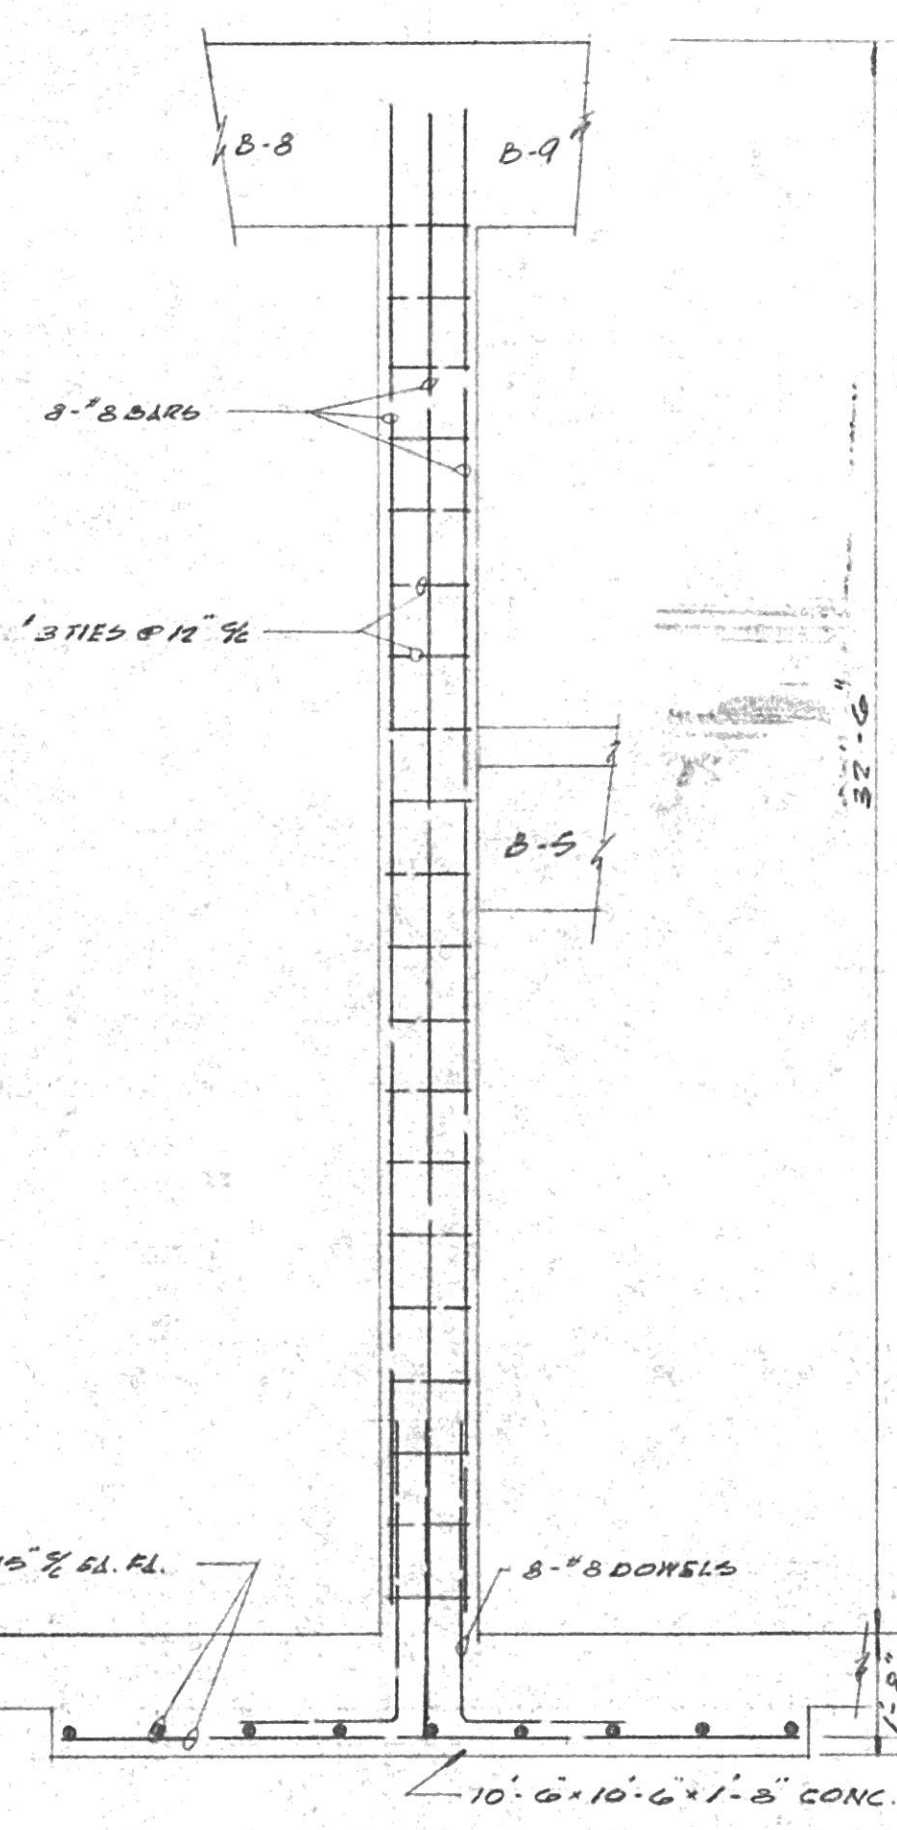


COLUMN C-2
SCALE: 3/4" = 1'-0"

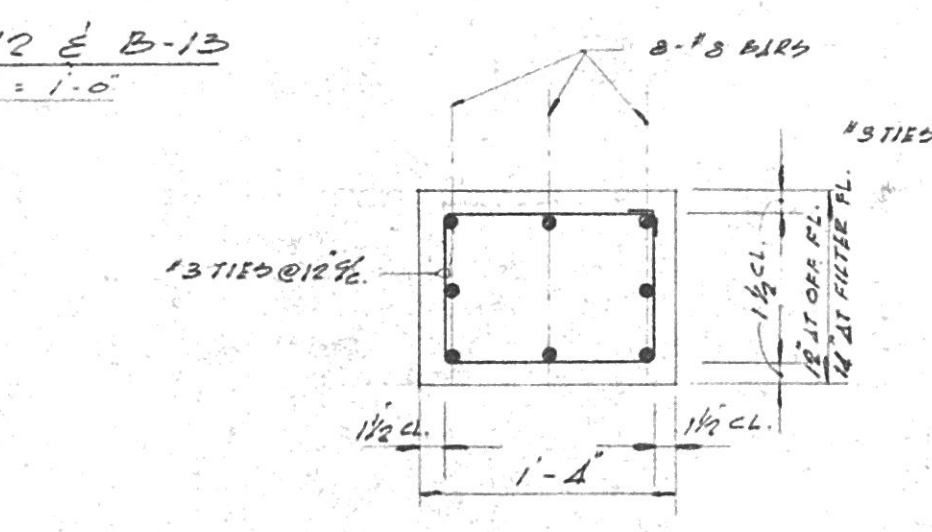


COLUMNS C-1 & C-3 PLAN
SCALE: 1" = 1'-0"

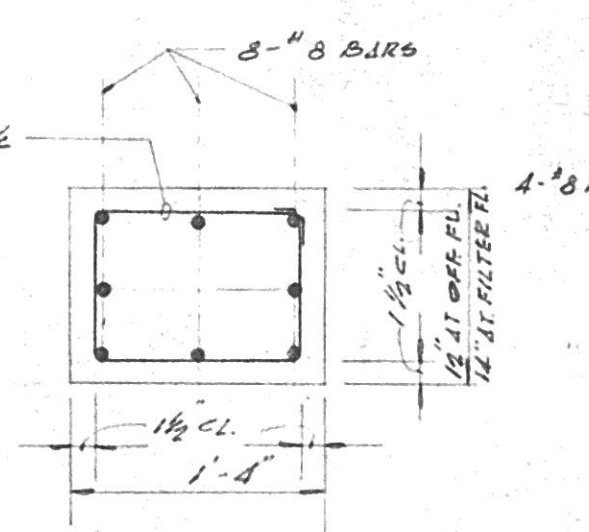


COLUMN C-2 PLAN
SCALE: 1" = 1'-0"

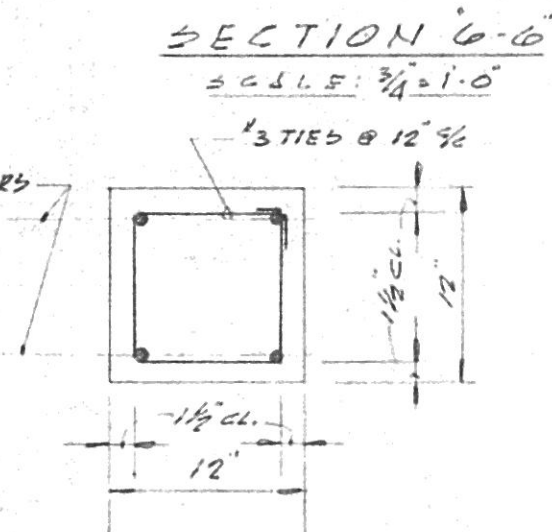


COLUMN C-4 PLAN
SCALE: 1" = 1'-0"

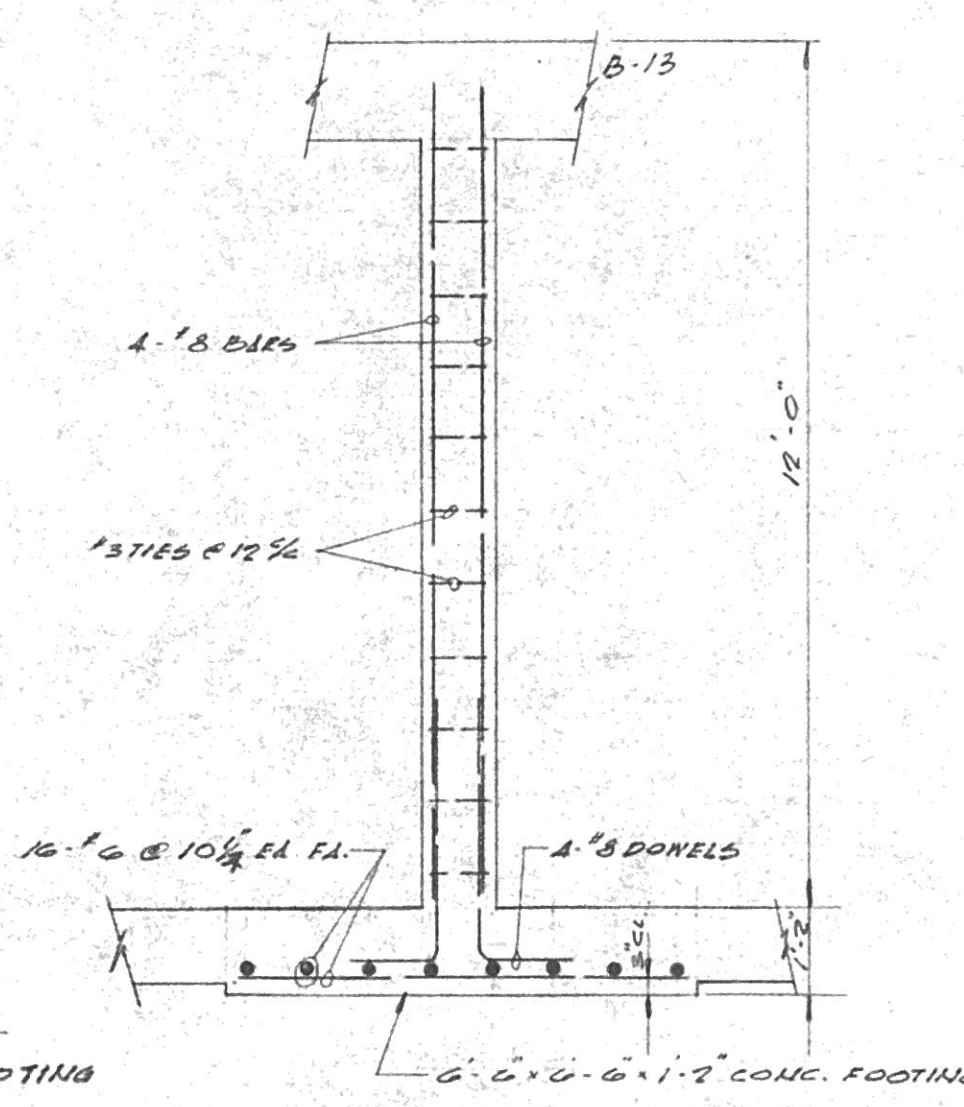


COLUMN C-4
SCALE: 3/4" = 1'-0"

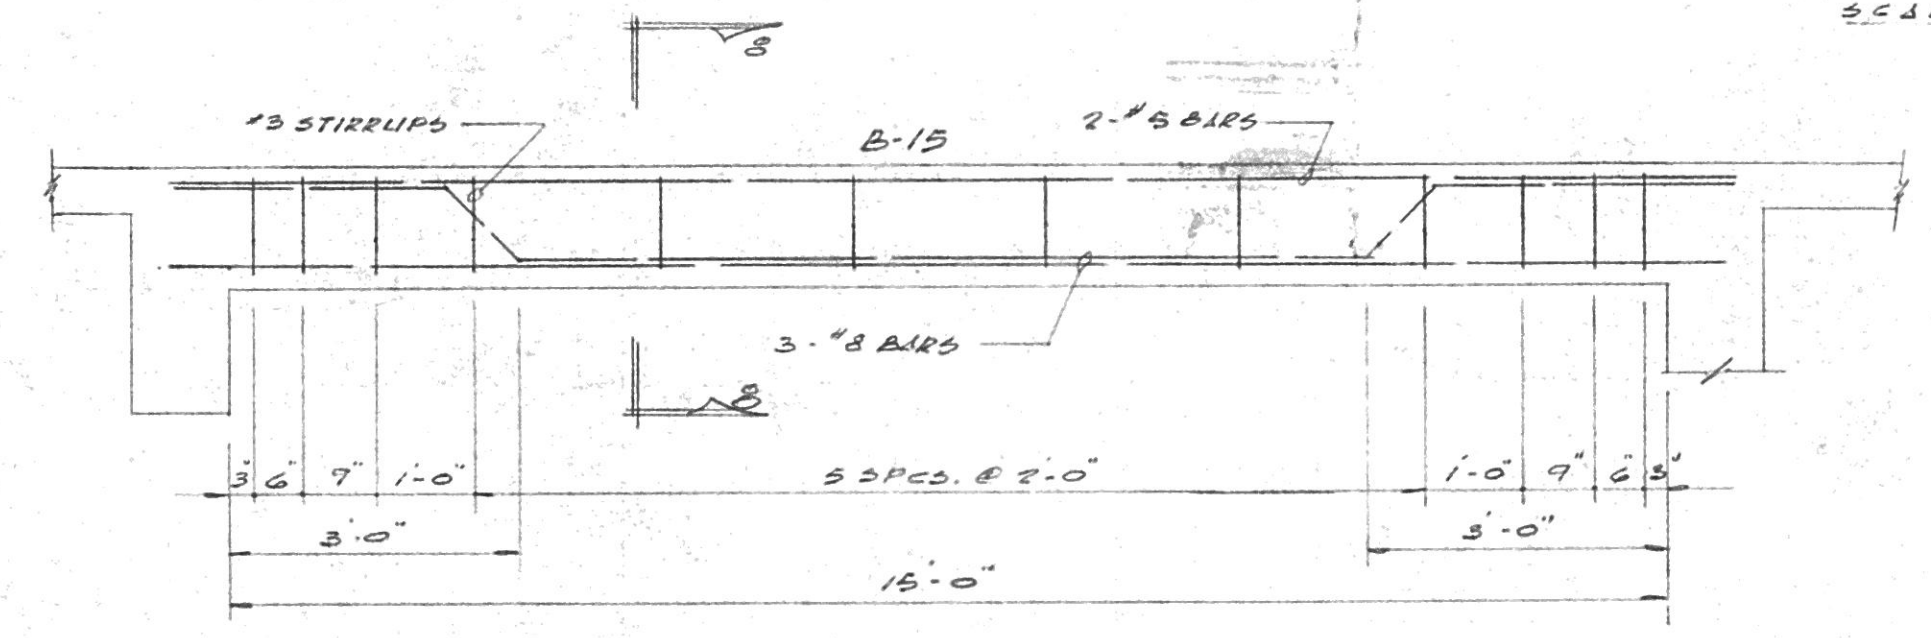

BEAM B-15
SCALE: 1/2" = 1'-0"

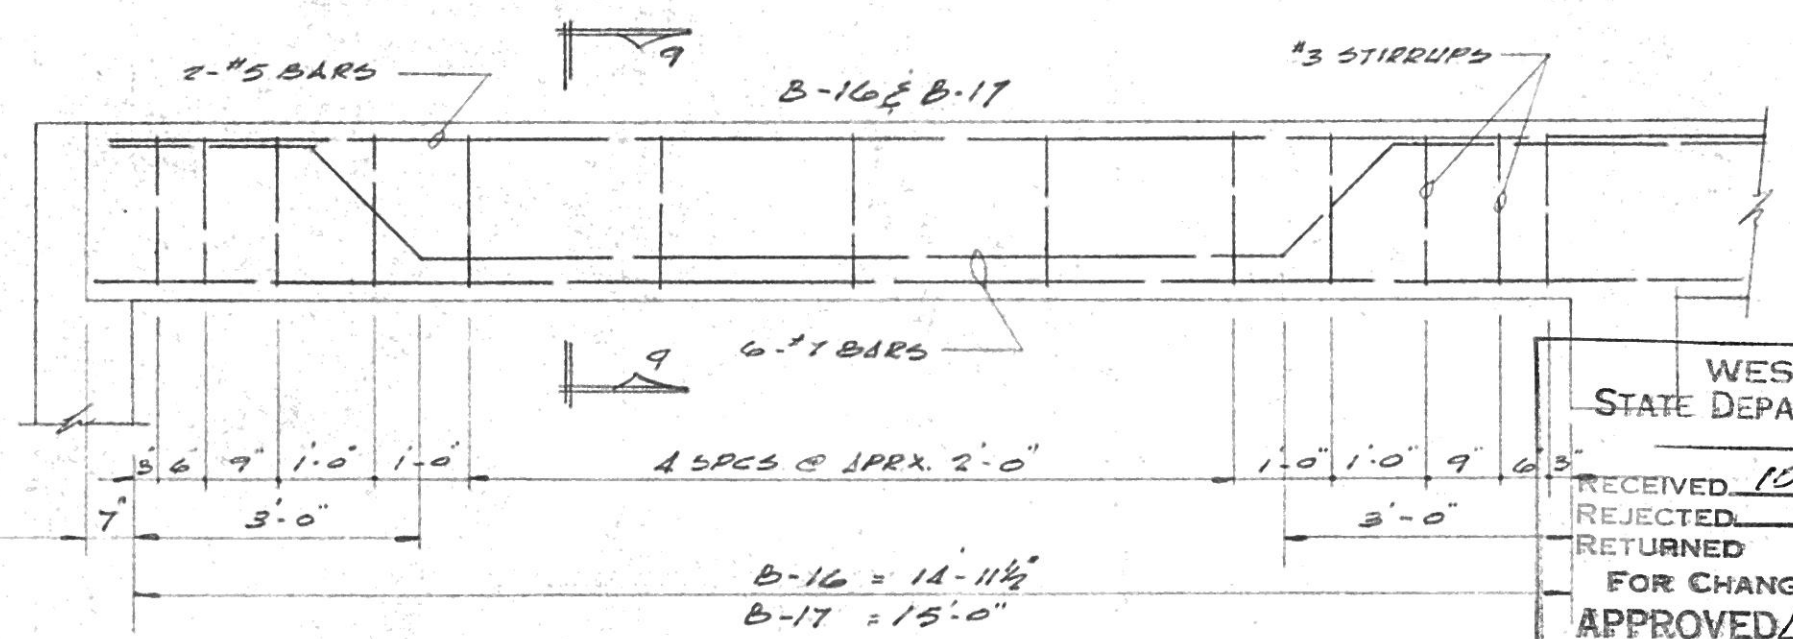

BEAMS B-16 & B-17
SCALE: 1/2" = 1'-0"

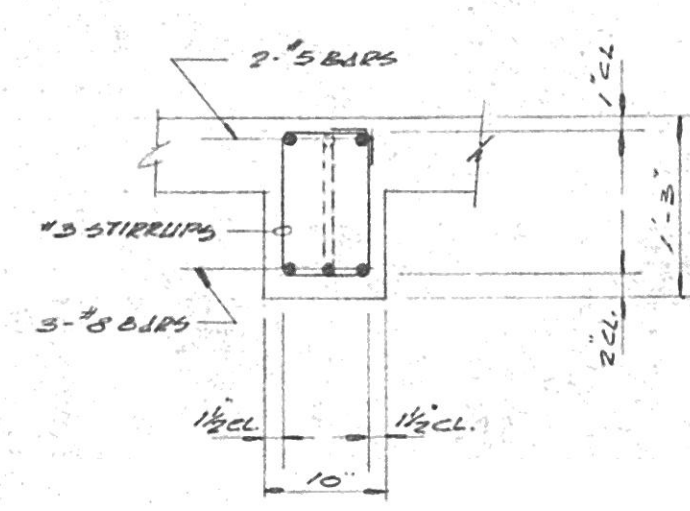

SECTION 8-8
SCALE: 3/4" = 1'-0"

WEST VIRGINIA
STATE DEPARTMENT OF HEALTH
RECEIVED 10-13-67
REJECTED
RETURNED
FOR CHANGES
APPROVED 12-13-67 NO 2897
DIVISION OF SANITARY ENGINEERING

No.	DATE	DESCRIPTION
REVISIONS		
MUNICIPAL UTILITY COMMISSION		
CITY OF SAINT ALBANS		
KANAWHA COUNTY WEST VIRGINIA		
WATER PROJECT		
FILTER PLANT EXPANSION		
REINFORCED CONCRETE DETAILS		
CHECKED BY: AFK	APPROVED BY: TJB	Drwg. No.
DATE: SEPT. 1967	SCALE: AS SHOWN	A-2113
KELLEY, GIDLEY, STAUB & BLAIR, INC.		
CONSULTING ENGINEERS • CHARLESTON, WEST VIRGINIA		