
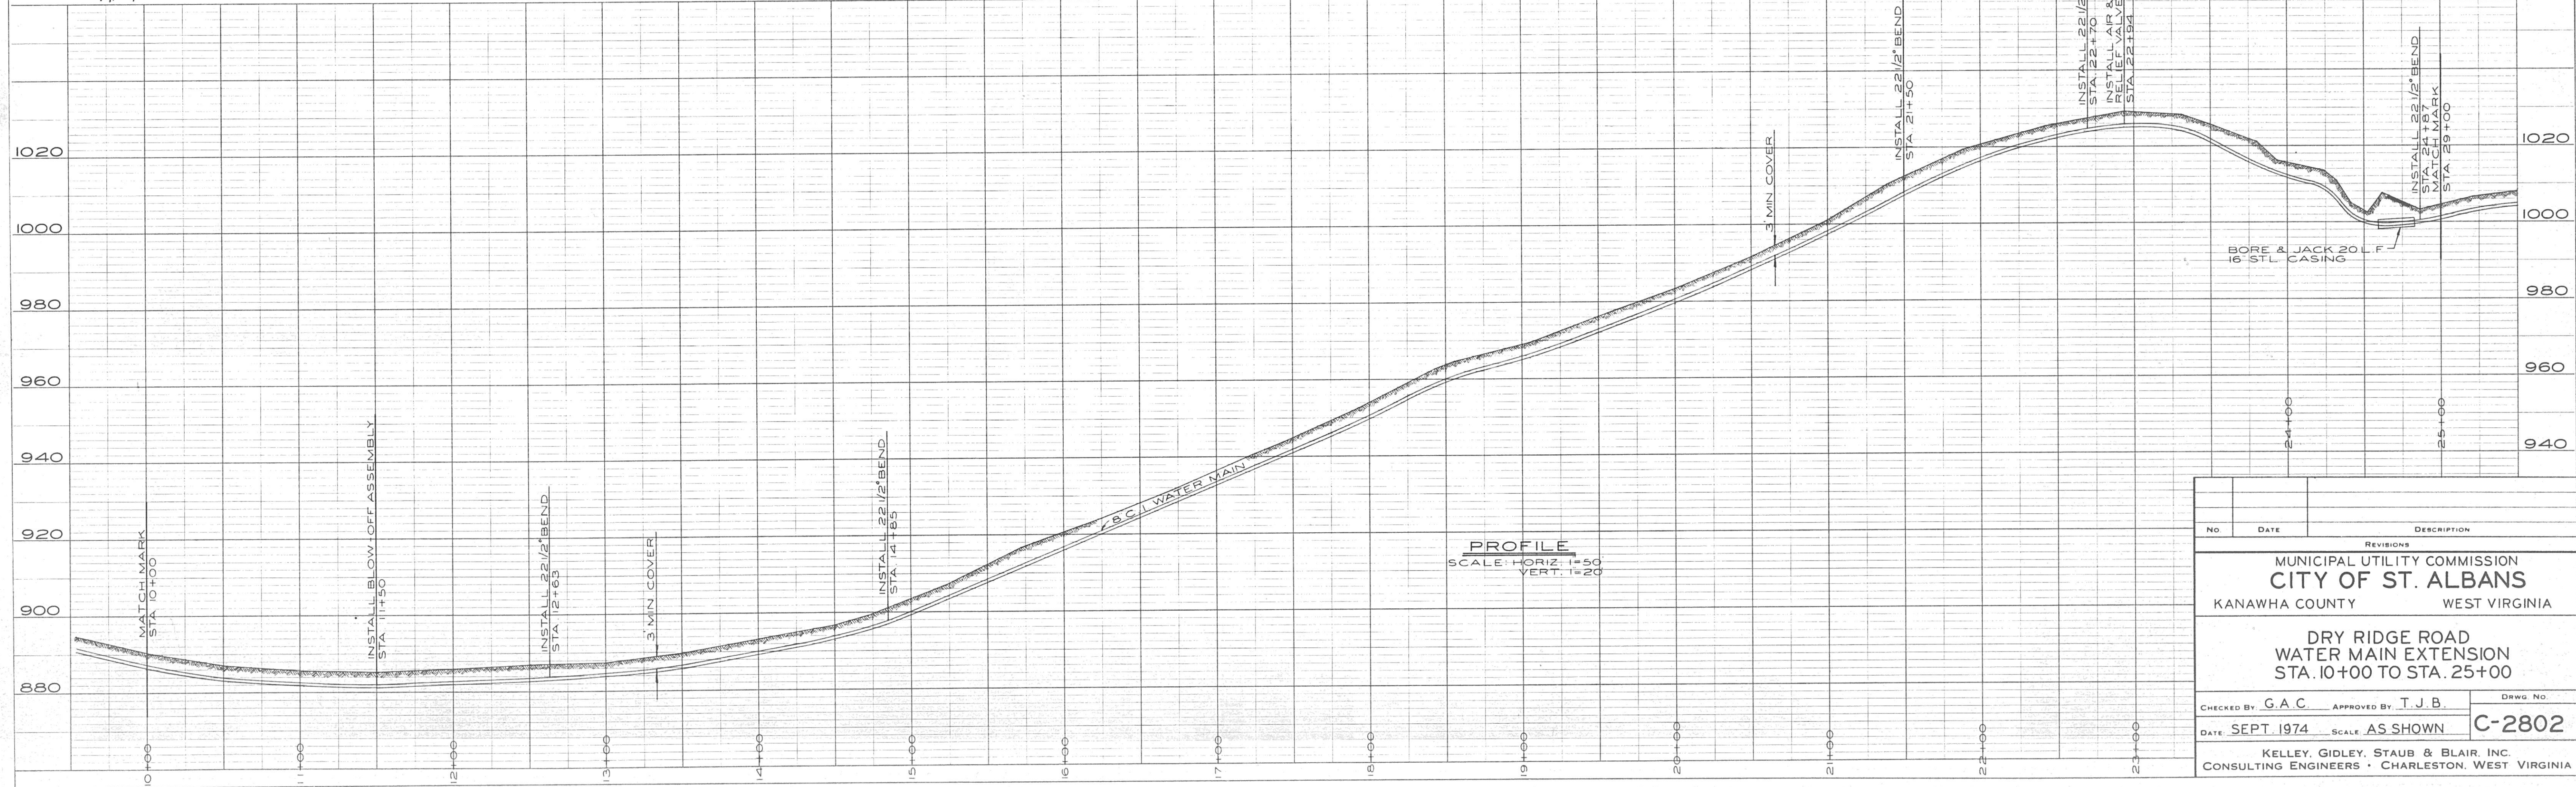


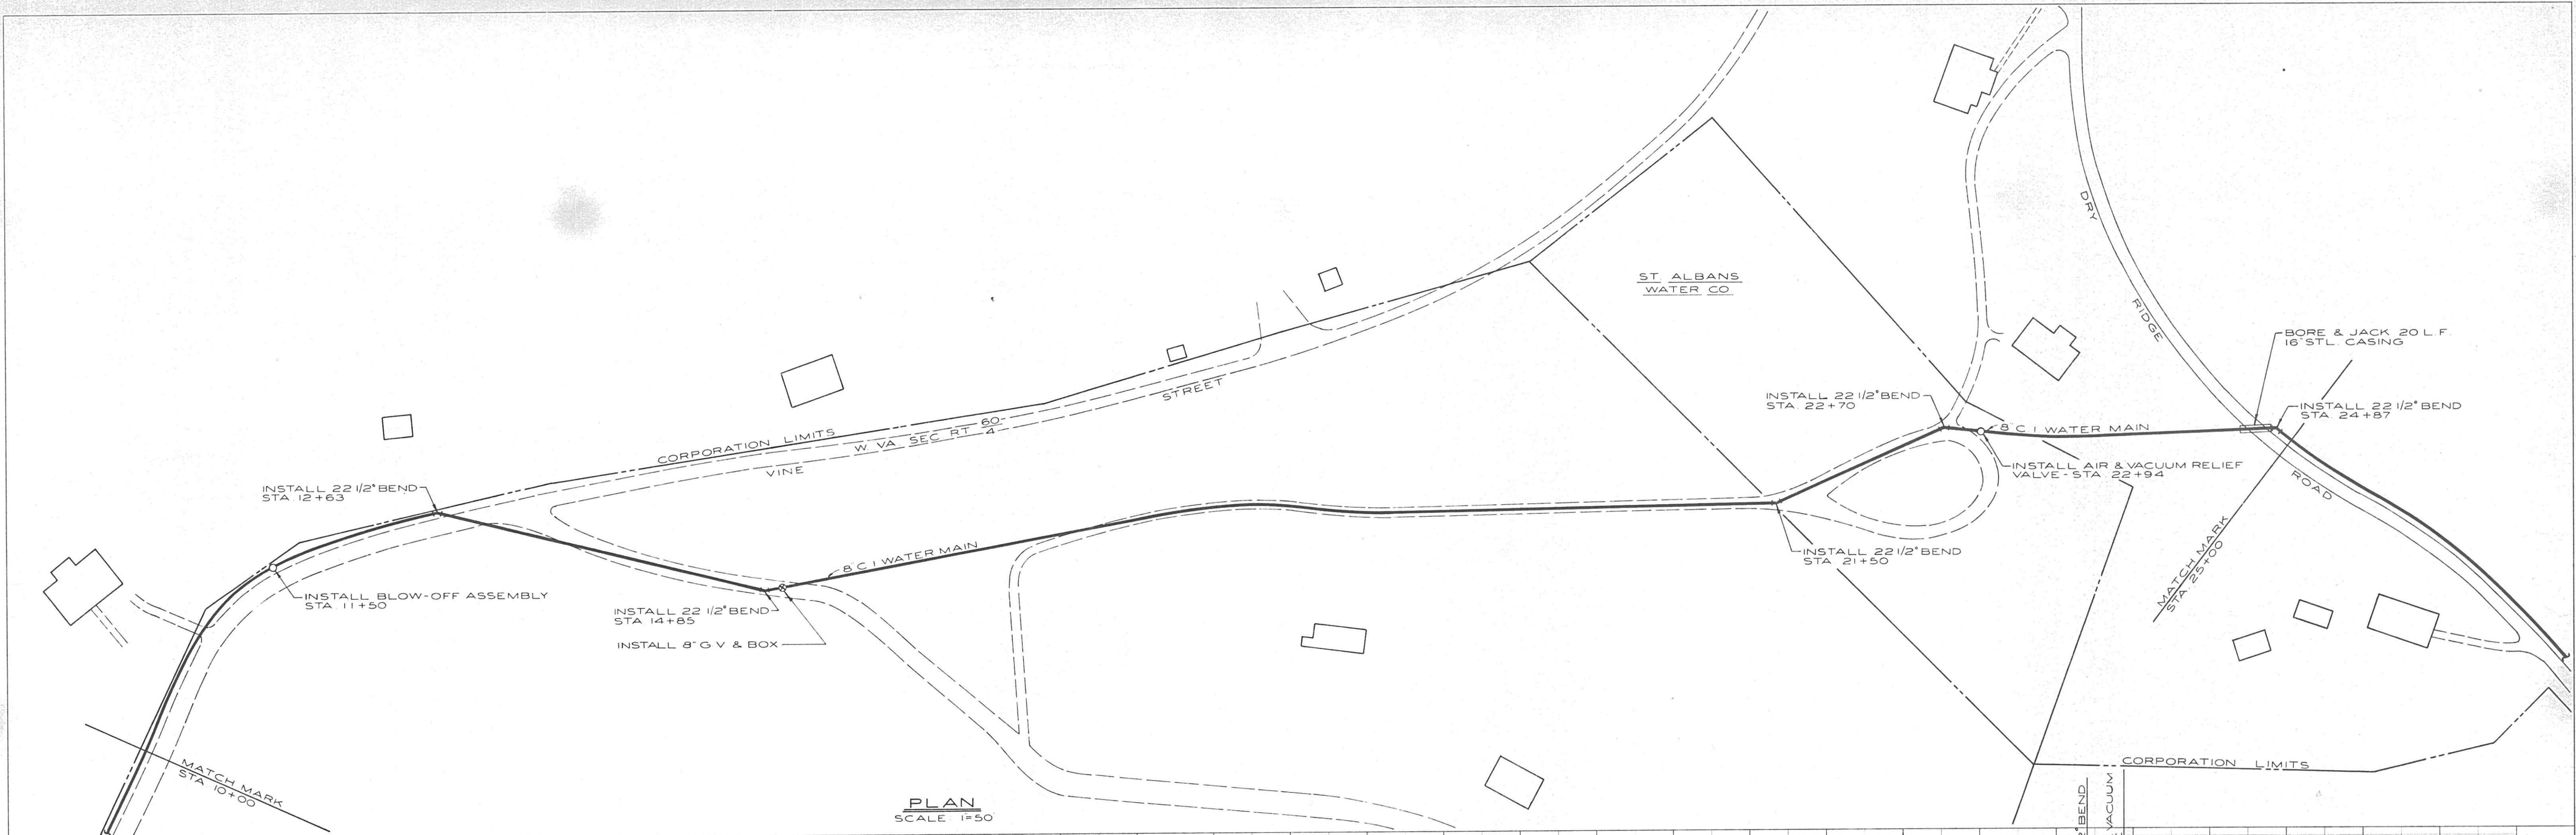

NO	DATE	DESCRIPTION
REVISIONS		
MUNICIPAL UTILITY COMMISSION		
CITY OF ST. ALBANS		
KANAWHA COUNTY		WEST VIRGINIA
DRY RIDGE ROAD		
WATER MAIN EXTENSION		
STA. 10+00 TO STA. 25+00		
CHECKED BY G A C		APPROVED BY T J B
DATE SEPT. 1974		SCALE AS SHOWN
KELLEY, GIDLEY, STAUB & BLAIR, INC.		DRWG. NO.
CONSULTING ENGINEERS • CHARLESTON, WEST VIRGINIA		C-2802