
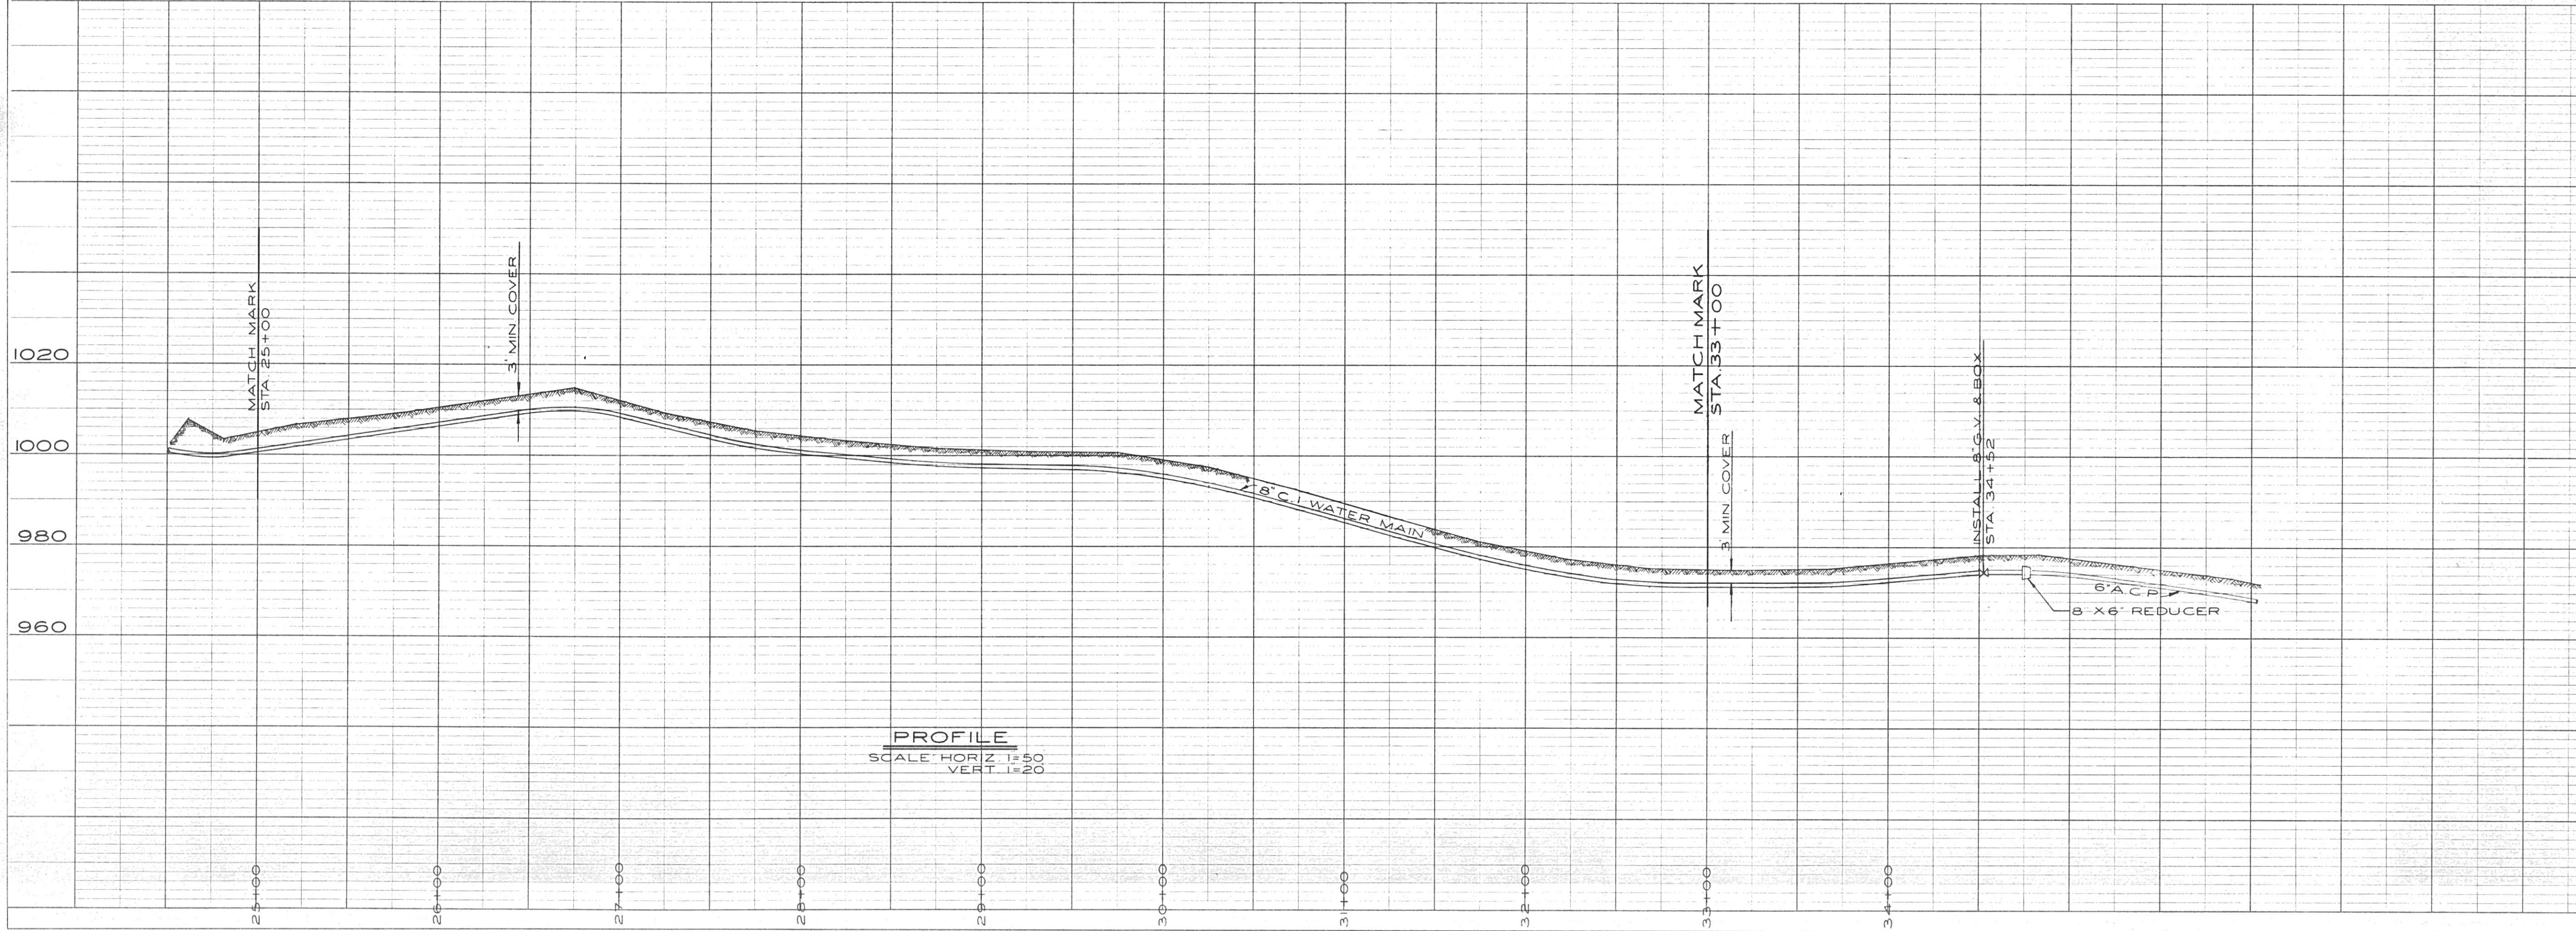


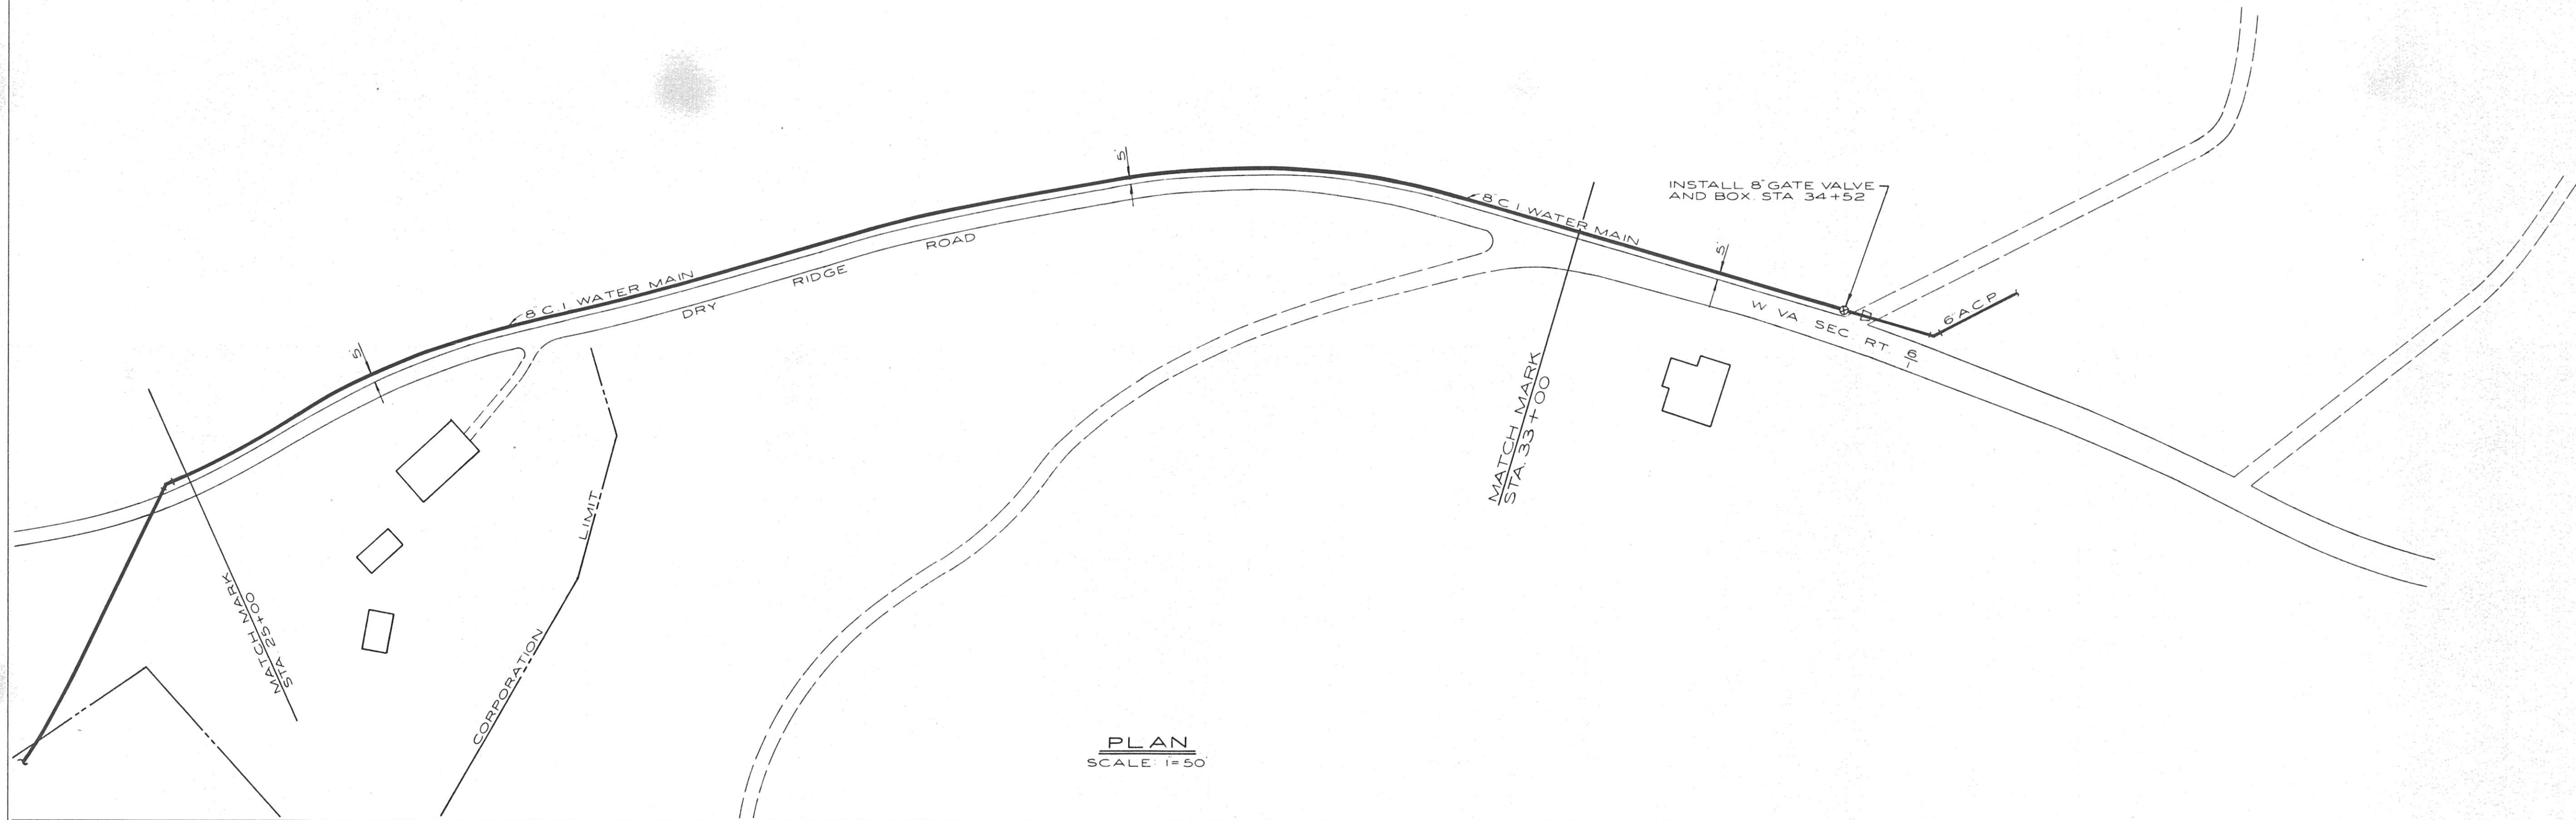

No.	DATE	DESCRIPTION	
REVISIONS			
MUNICIPAL UTILITY COMMISSION			
CITY OF ST. ALBANS			
KANAWHA COUNTY		WEST VIRGINIA	
DRY RIDGE ROAD			
WATER MAIN EXTENSION			
STA. 25+00 TO STA. 33+00			
CHECKED BY: G.A.C.		APPROVED BY: T.J.B.	
DATE: SEPT. 1974		SCALE: AS SHOWN	
		DRWG. NO.	
		C-2803	
KELLEY, GIDLEY, STAUB & BLAIR, INC.			
CONSULTING ENGINEERS • CHARLESTON, WEST VIRGINIA			