


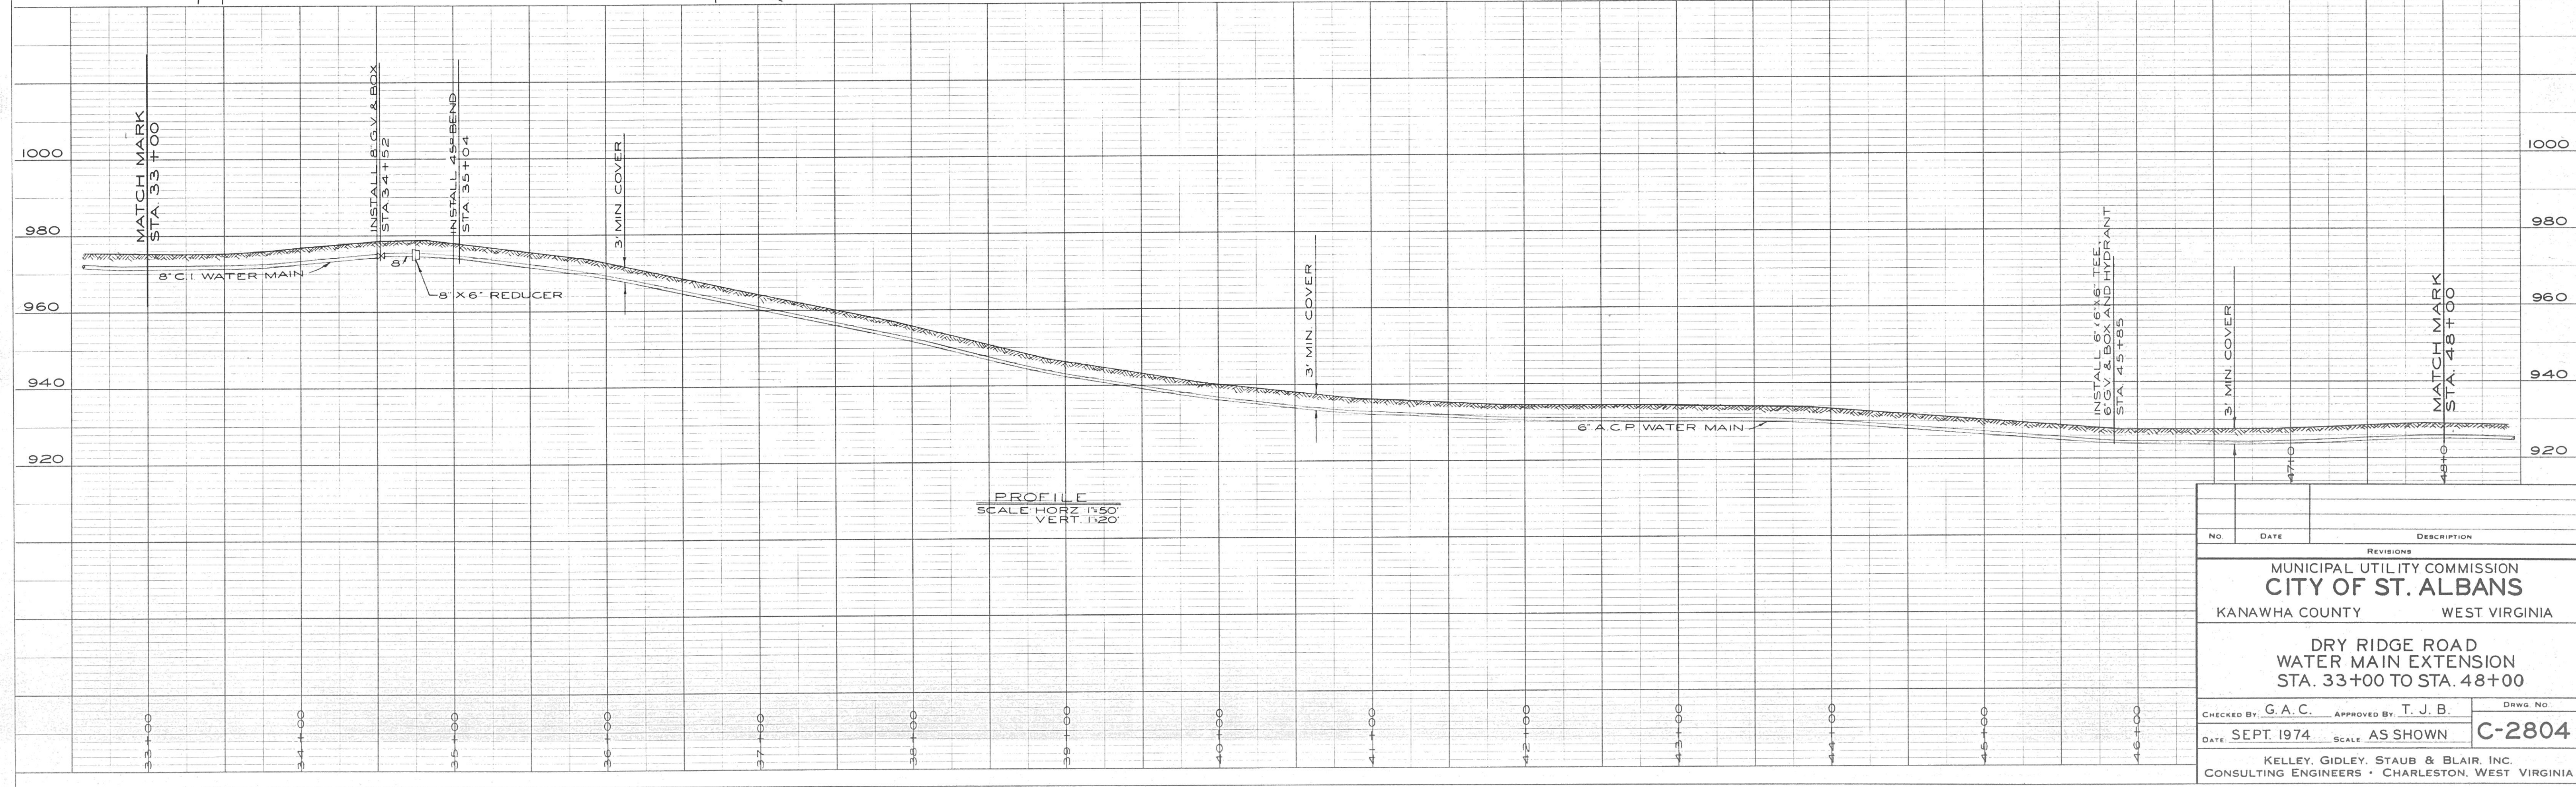

NO.	DATE	DESCRIPTION			
REVISIONS					
MUNICIPAL UTILITY COMMISSION					
CITY OF ST. ALBANS					
KANAWHA COUNTY			WEST VIRGINIA		
DRY RIDGE ROAD					
WATER MAIN EXTENSION					
STA. 33+00 TO STA. 48+00					
CHECKED BY: G. A. C.		APPROVED BY: T. J. B.		DRWG. NO.	
DATE: SEPT. 1974		SCALE: AS SHOWN		C-2804	
KELLEY, GIDLEY, STAUB & BLAIR, INC.					
CONSULTING ENGINEERS • CHARLESTON, WEST VIRGINIA					