
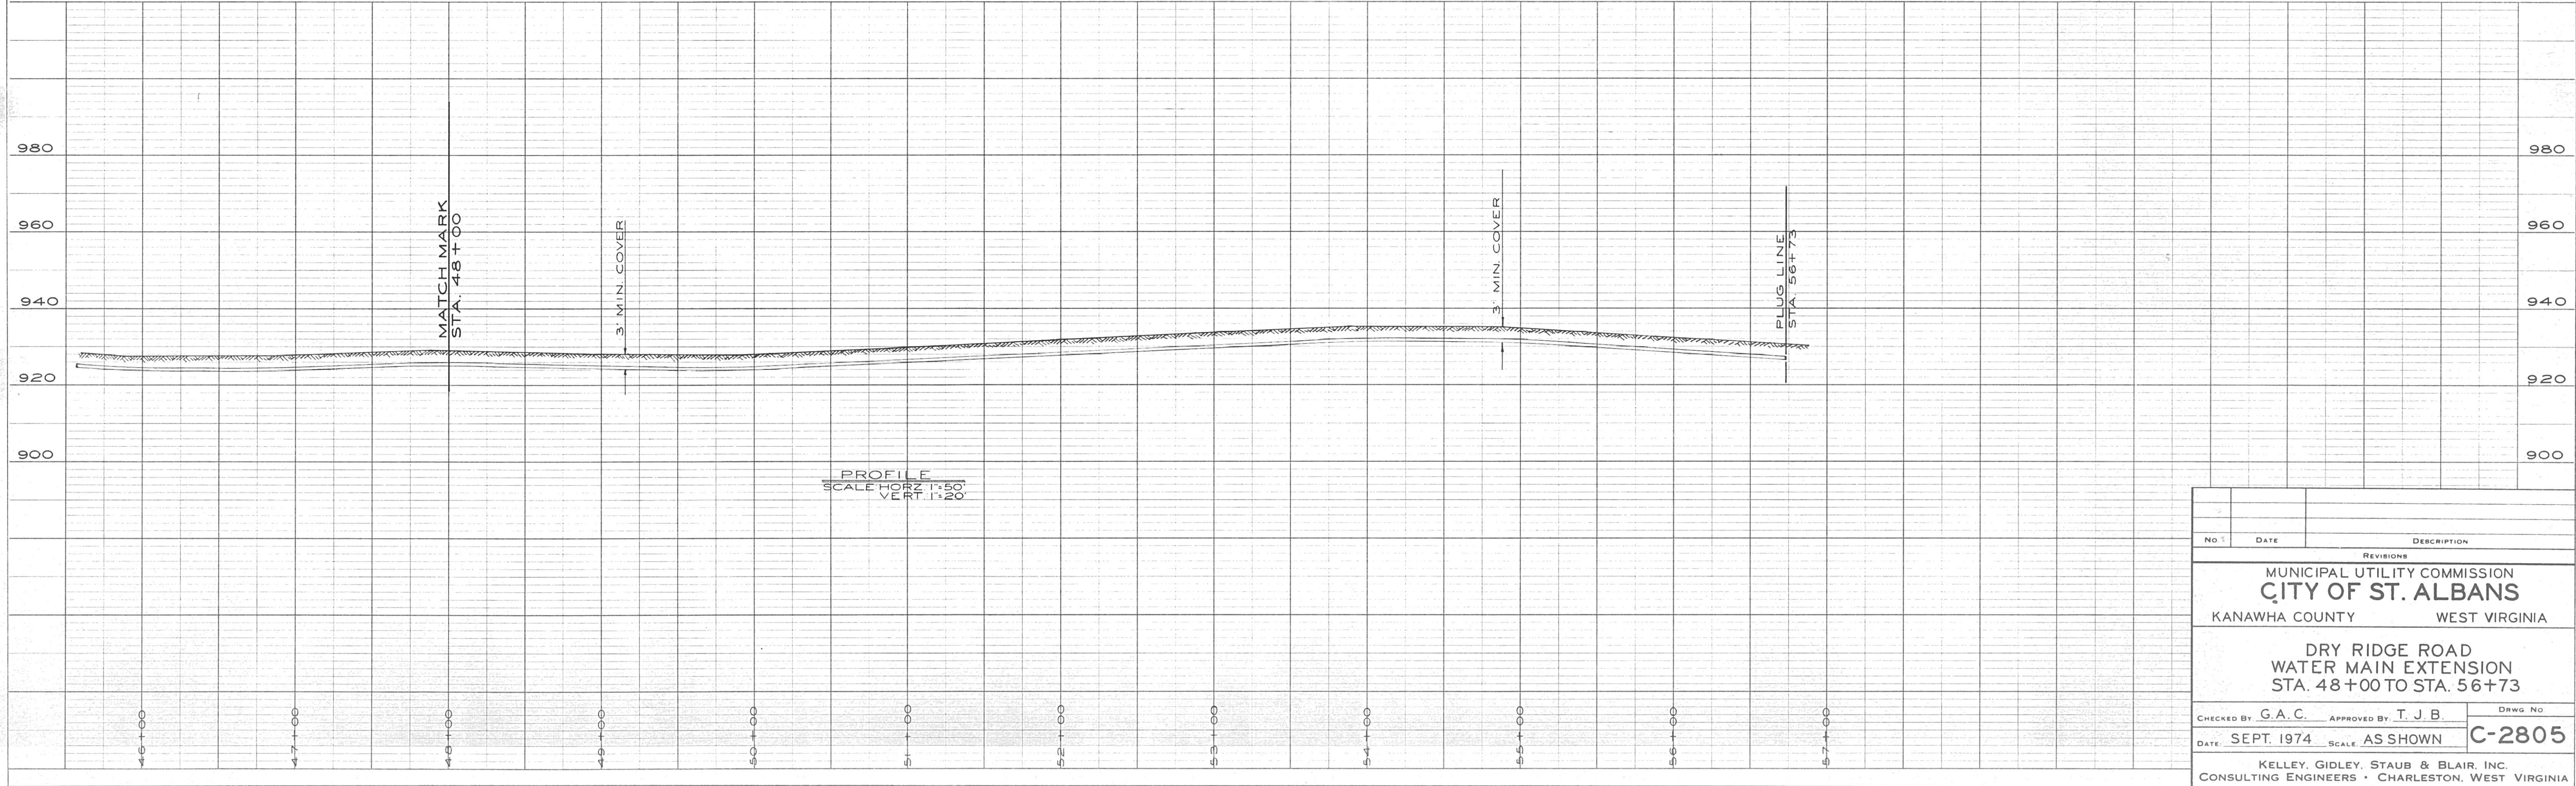


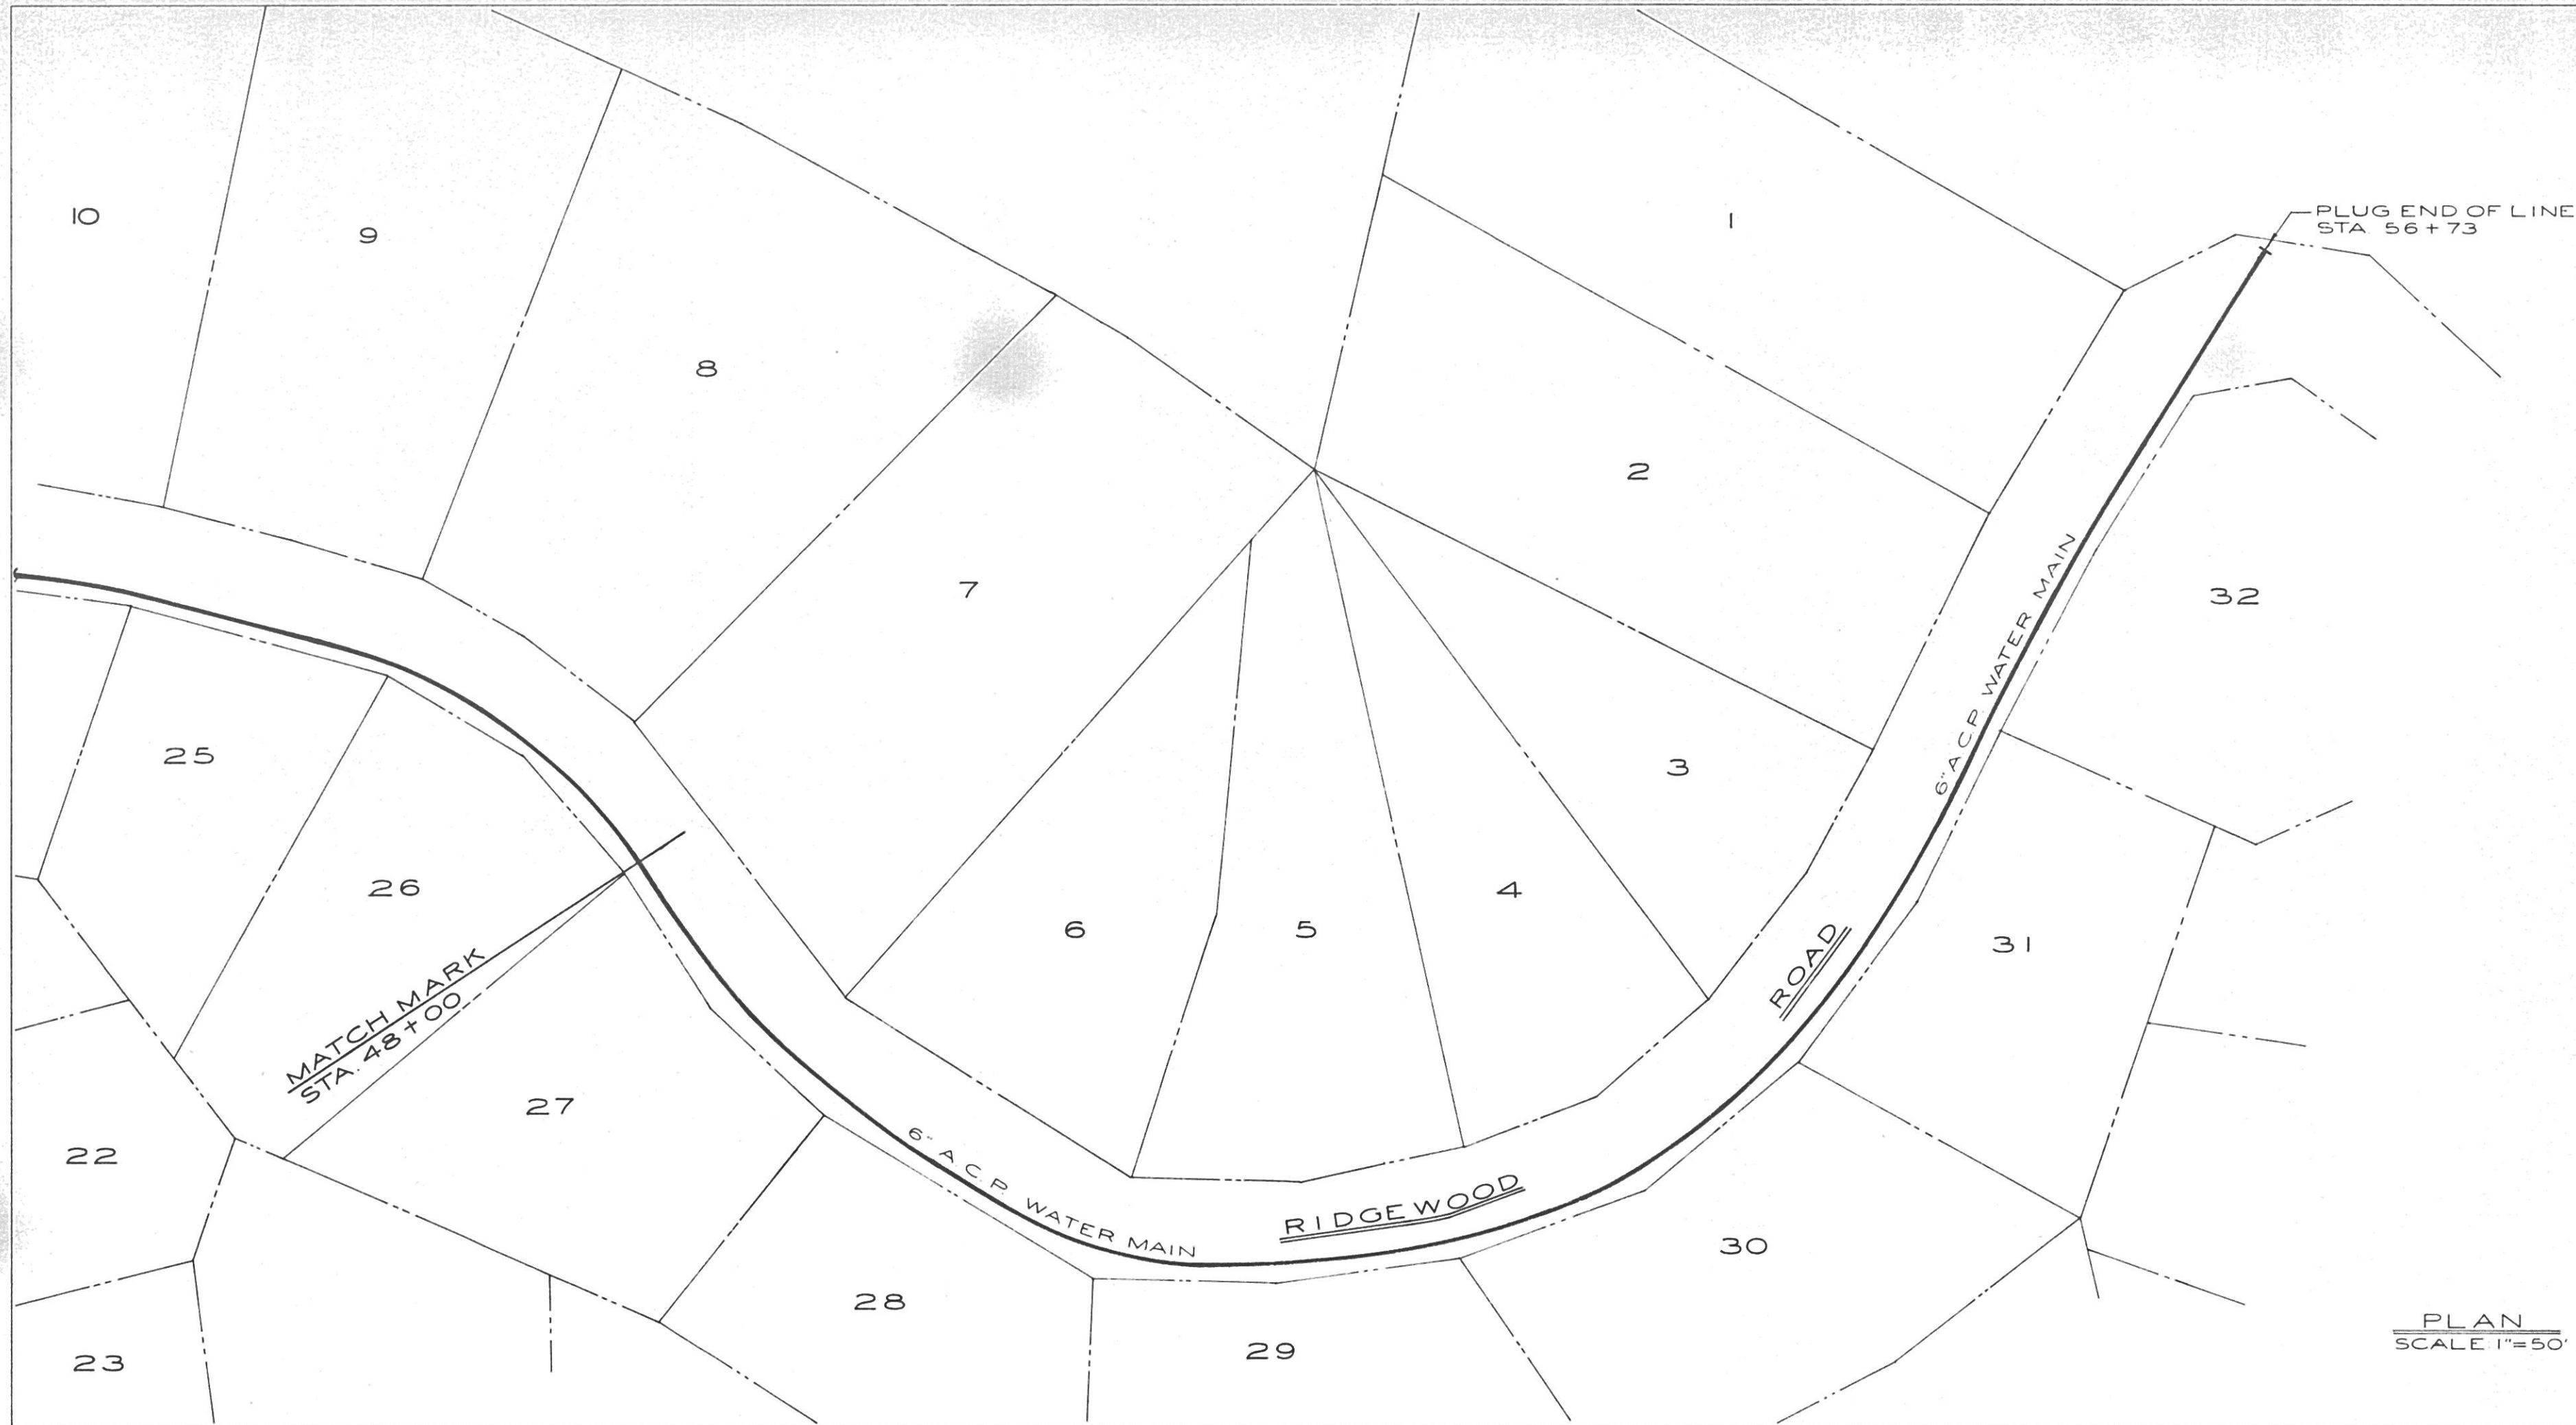

No. 5		DATE	
		DESCRIPTION	
REVISIONS			
MUNICIPAL UTILITY COMMISSION			
CITY OF ST. ALBANS			
KANAWHA COUNTY		WEST VIRGINIA	
DRY RIDGE ROAD			
WATER MAIN EXTENSION			
STA. 48 + 00 TO STA. 56 + 73			
CHECKED BY G. A. C.		APPROVED BY T. J. B.	
DATE SEPT. 1974		SCALE AS SHOWN	
		DRWG. No.	
		C-2805	
KELLEY, GIDLEY, STAUB & BLAIR, INC.			
CONSULTING ENGINEERS • CHARLESTON, WEST VIRGINIA			