

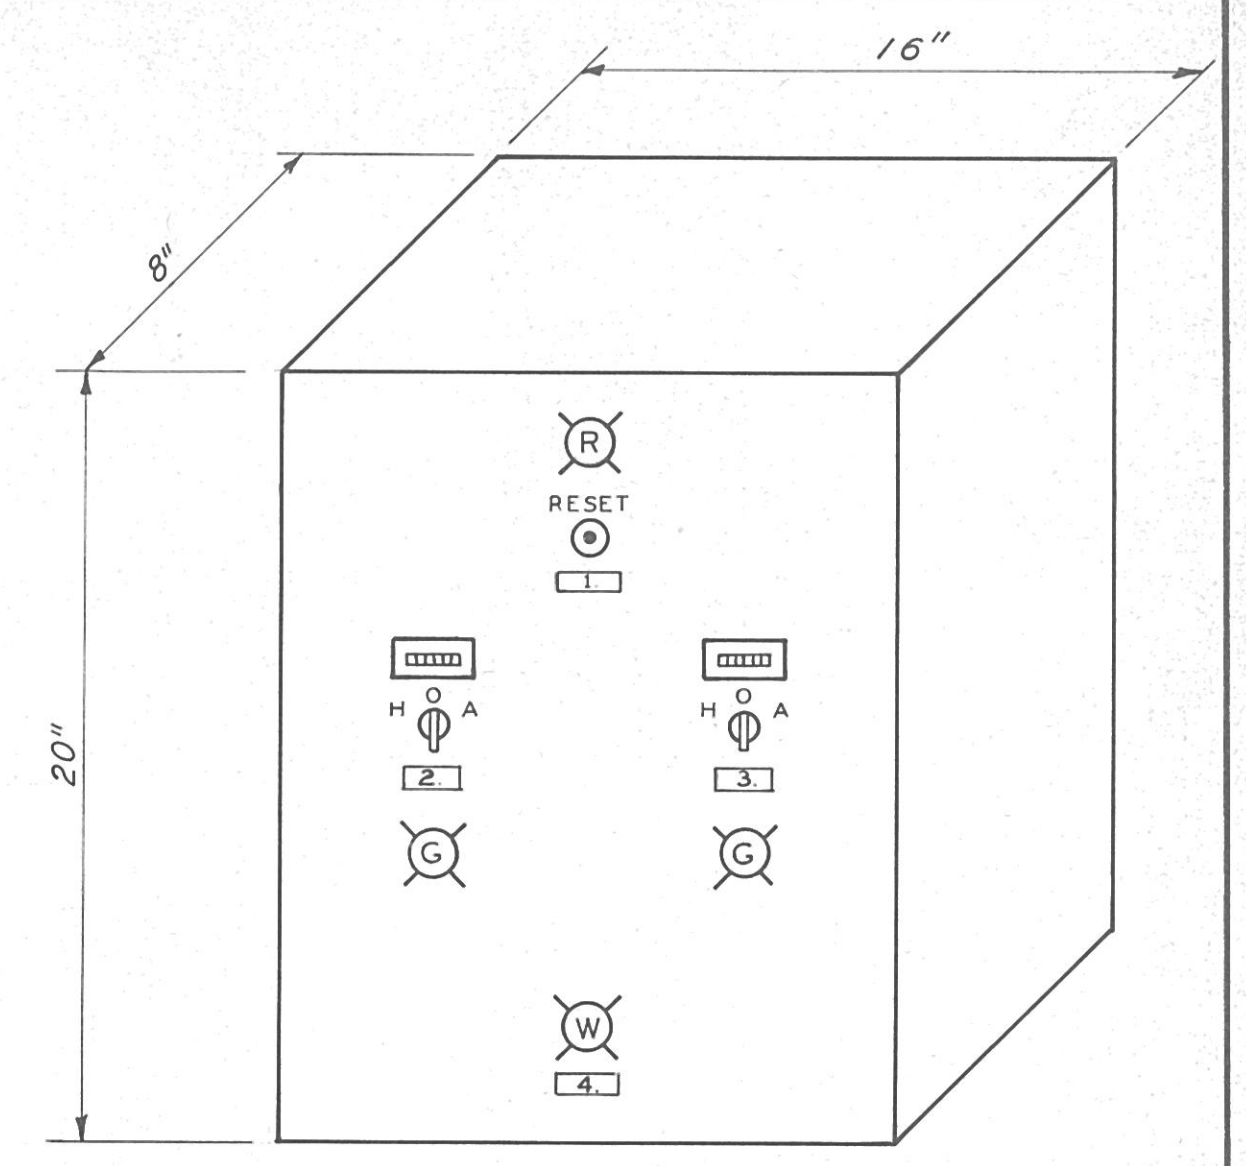
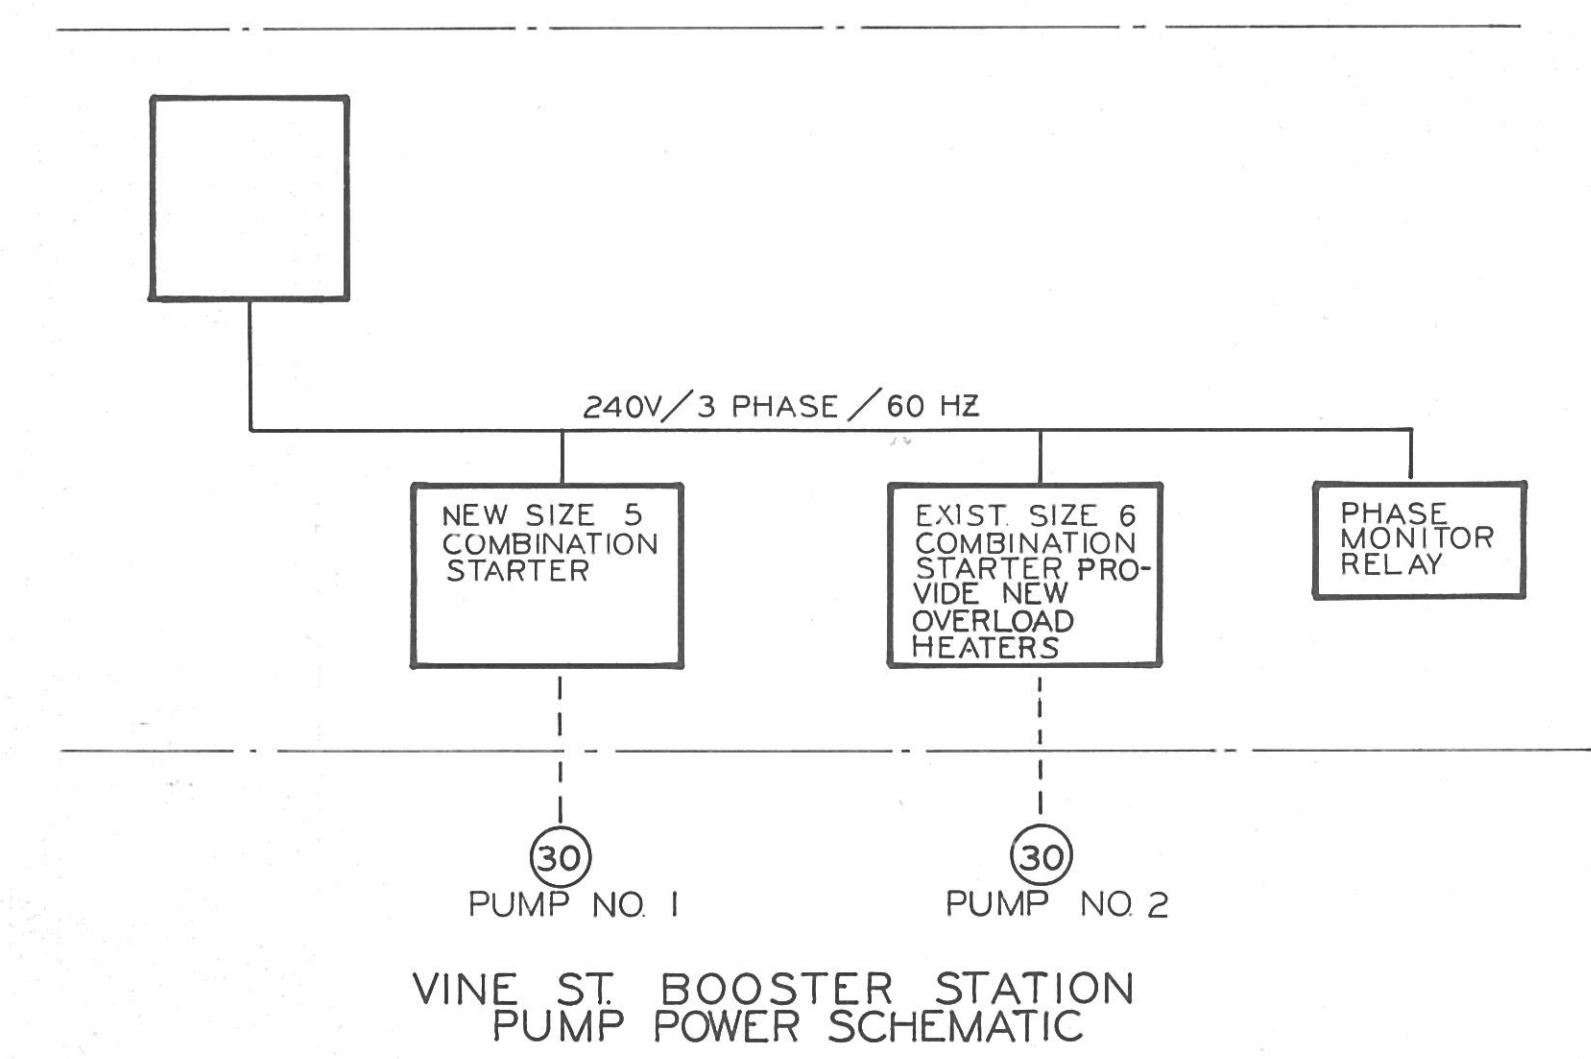
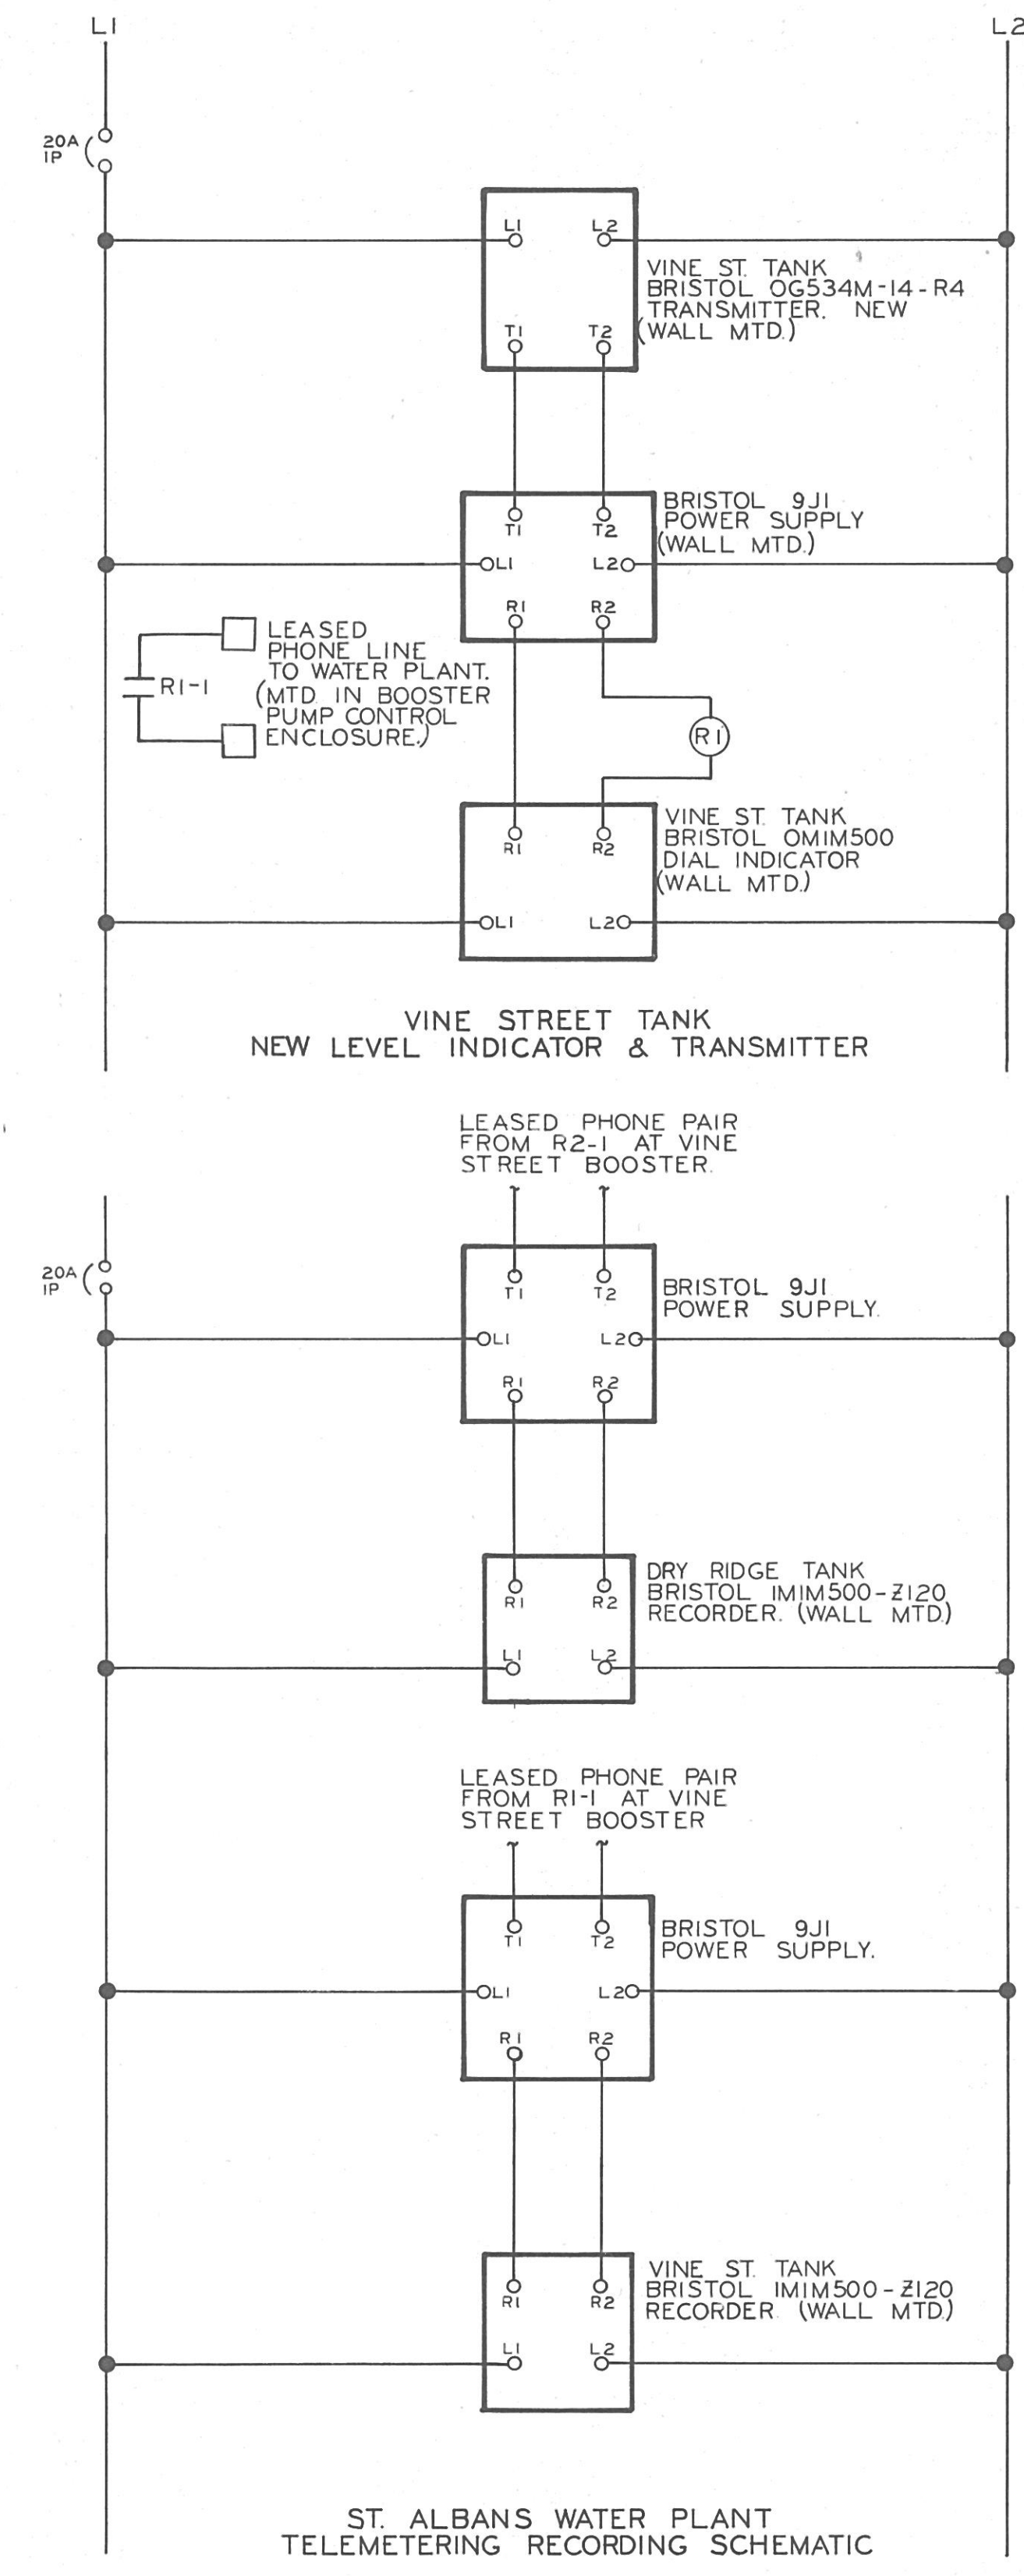


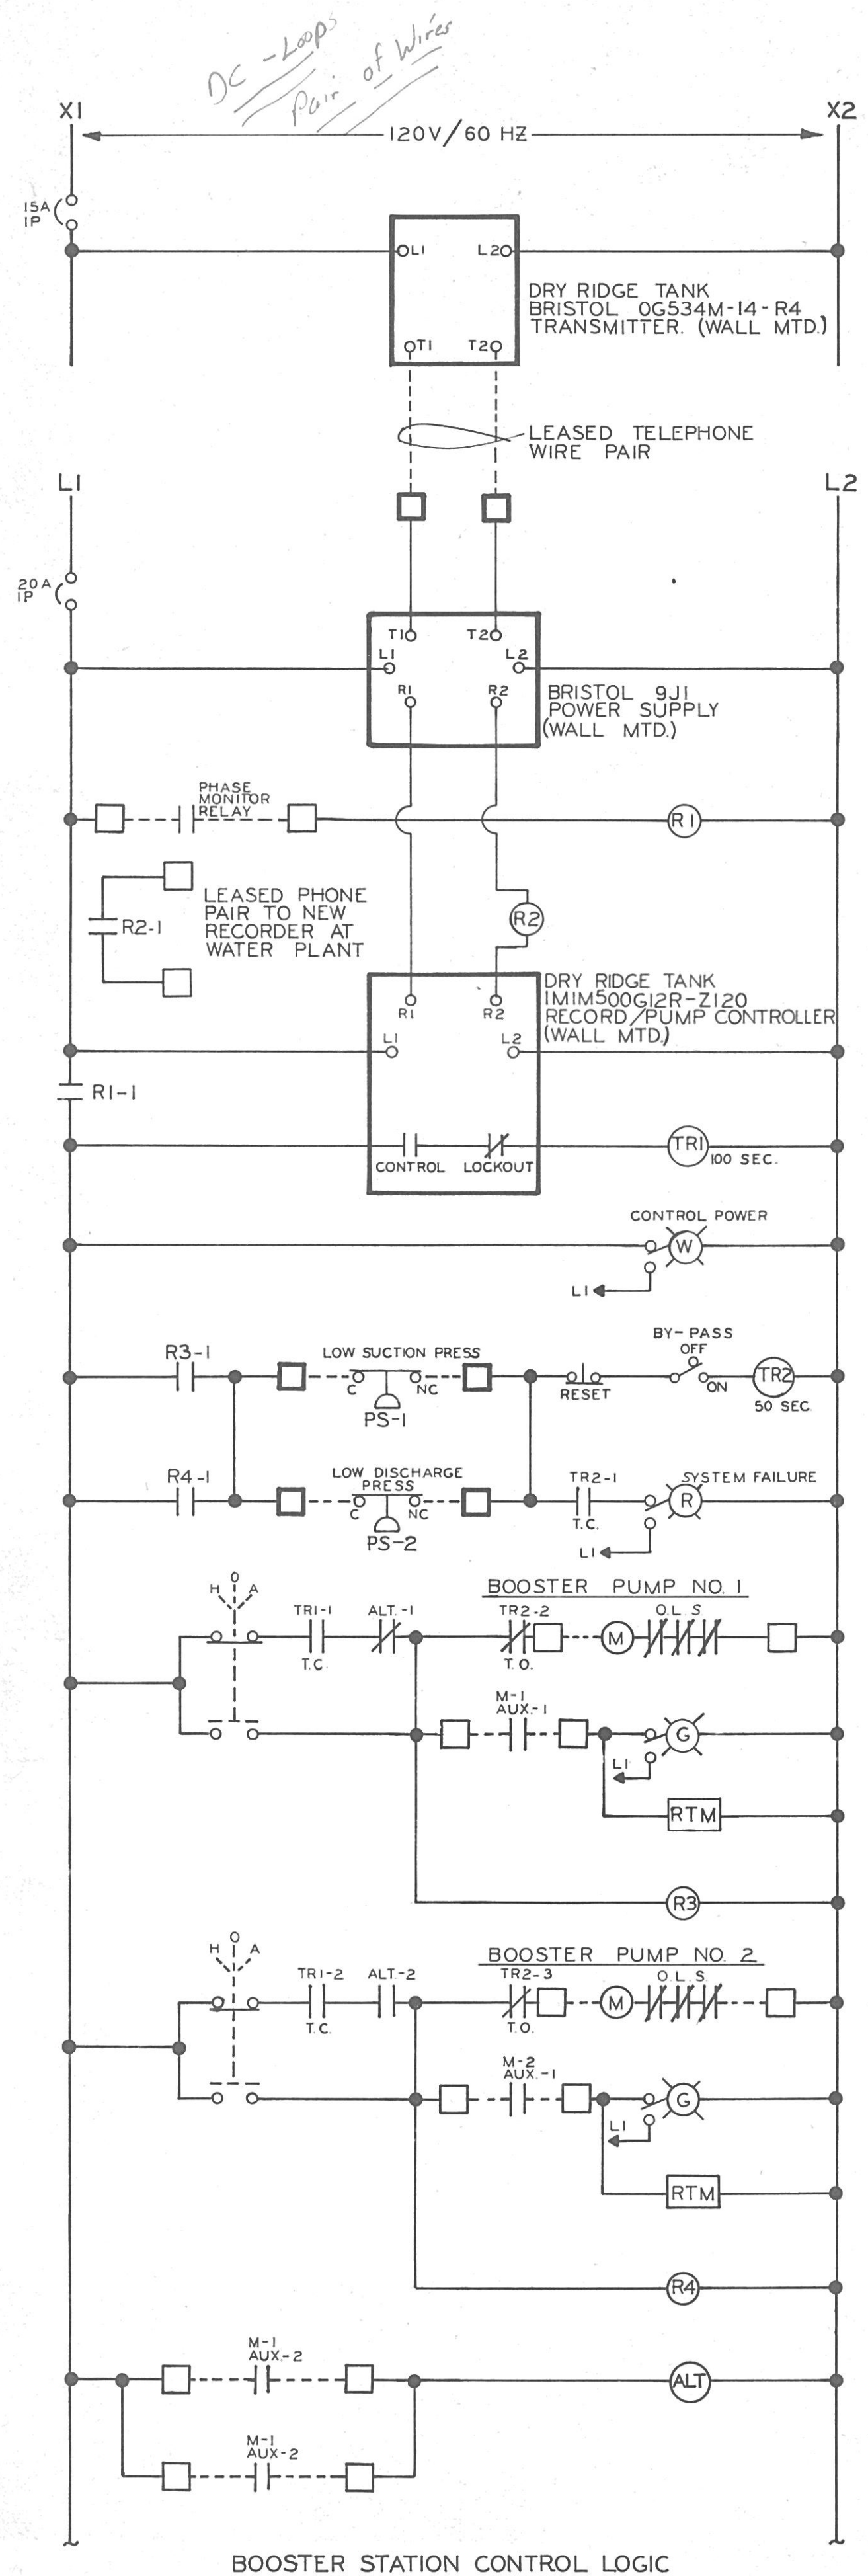

NAMEPLATE SCHEDULE	
NO.	DESCRIPTION
1.	SYSTEM FAILURE
2.	PUMP NO. 1
3.	PUMP NO. 2
4.	CONTROL POWER

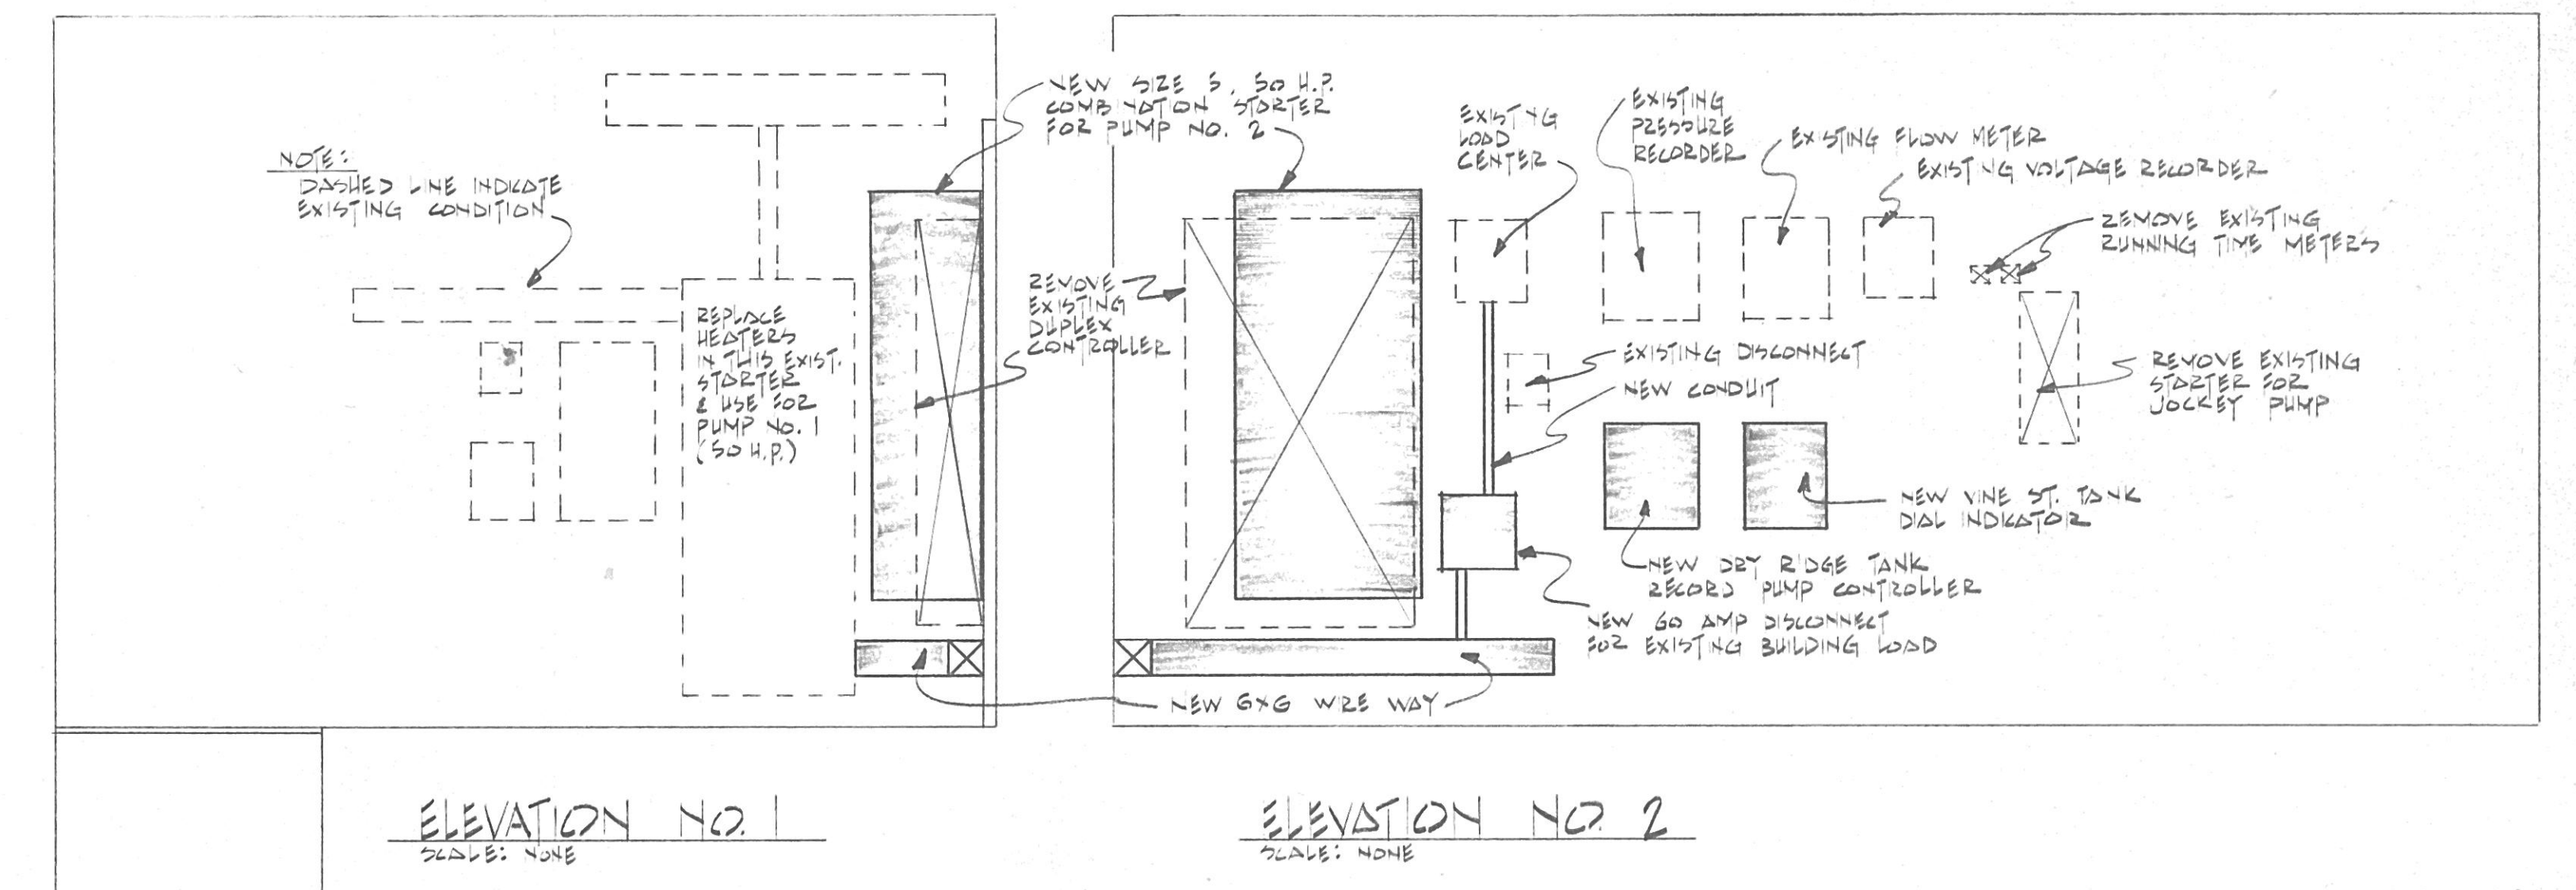

8		KELLEY, GIDLEY, BLAIR & WOLFE, INC. CONSULTING ENGINEERS CHARLESTON, WEST VIRGINIA					
7		CITY OF ST. ALBANS KANAWHA COUNTY, WEST VIRGINIA					
6		VINE STREET BOOSTER STATION ELECTRICAL & CONTROL LOGIC					
5							
4							
3							
2							
1		DRAWN	REG	CHECKED	HRC	PROJECT 72600	DATE DEC. 1980
NO.	DATE	DRAWN		APPROVED	HRC	DRAWING NO.	
REVISIONS		DRAWN		SCALE	NONE	72602	