


RING WALL SECTION (TYP.)
SCALE: 1"=1'-0"

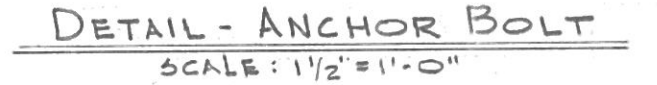

6		KELLEY, GIDLEY, BLAIR & WOLFE, INC.							
7		CONSULTING ENGINEERS							
		CHARLESTON, WEST VIRGINIA							
6		CITY OF ST. ALBANS							
5		KANAWHA COUNTY			WEST VIRGINIA				
4		350,000 GALLON TANK FOUNDATION PIPING REINFORCING & MISC. DETAILS							
3									
2									
1		DRAWN	JRS	CHECKED	DAW	PROJECT	72600	DATE	DEC. 80
NO.	DATE	DRAWN		APPROVED	HRC	DRAWING NO.			
REVISIONS		DRAWN		SCALE AS SHOWN		72604			