
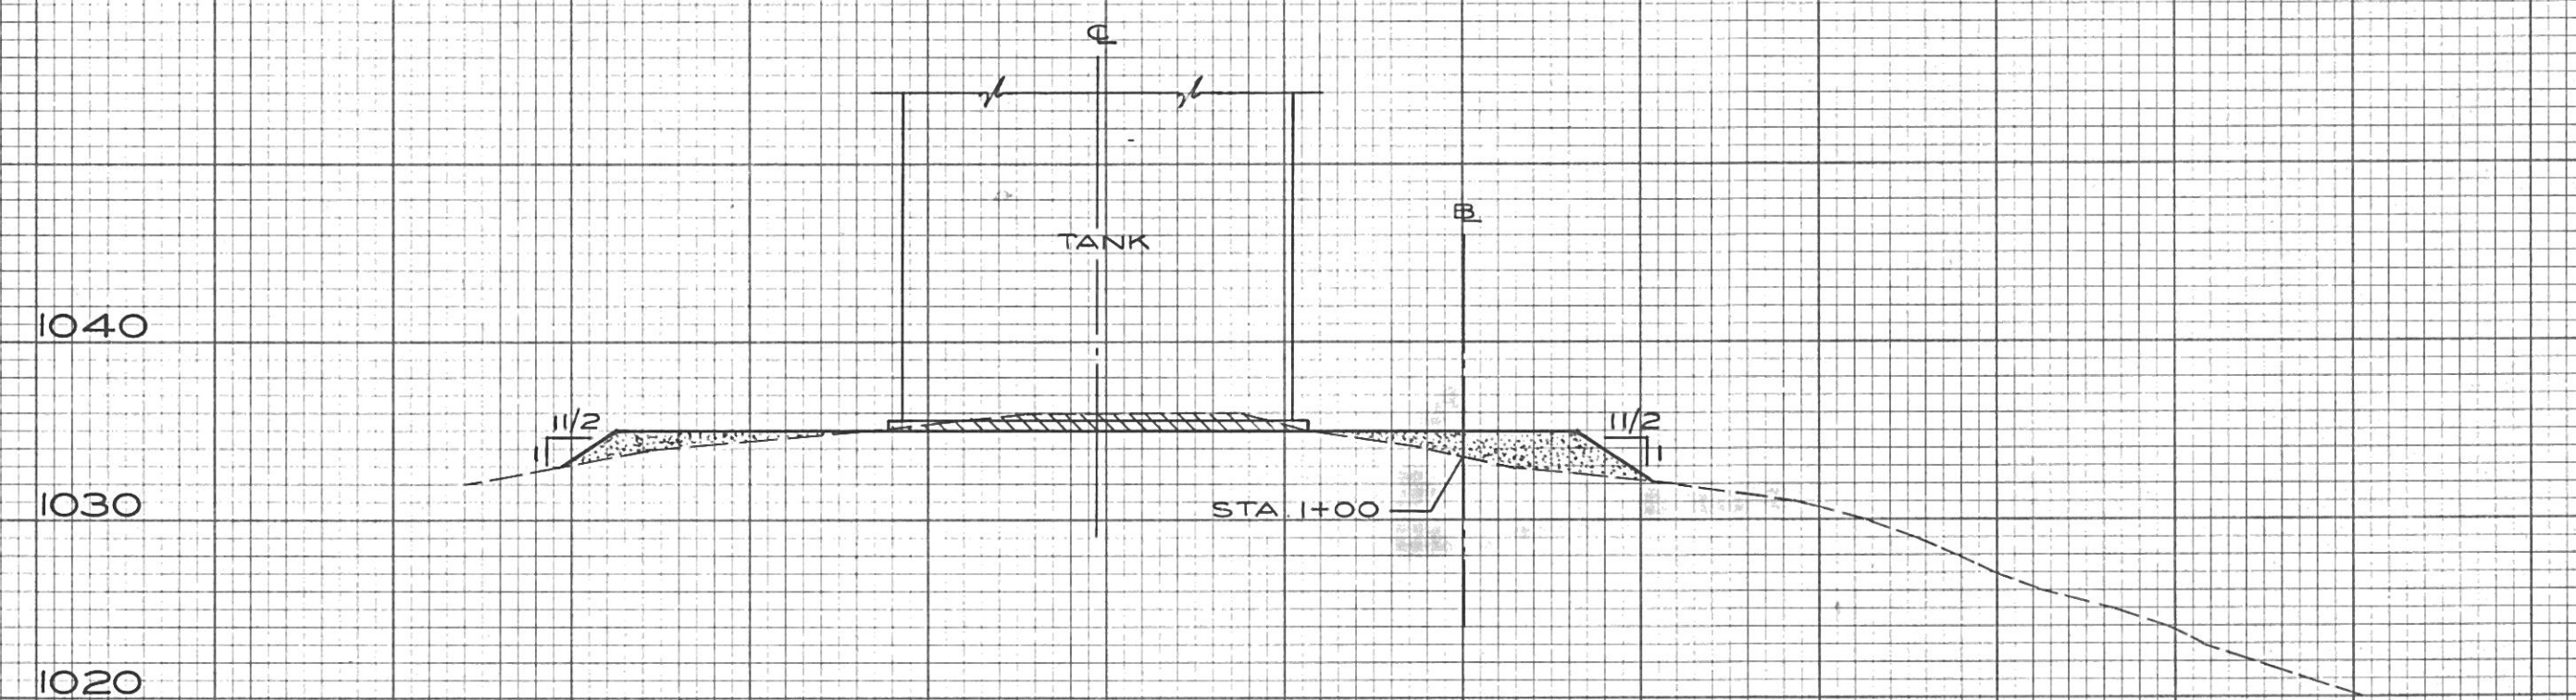
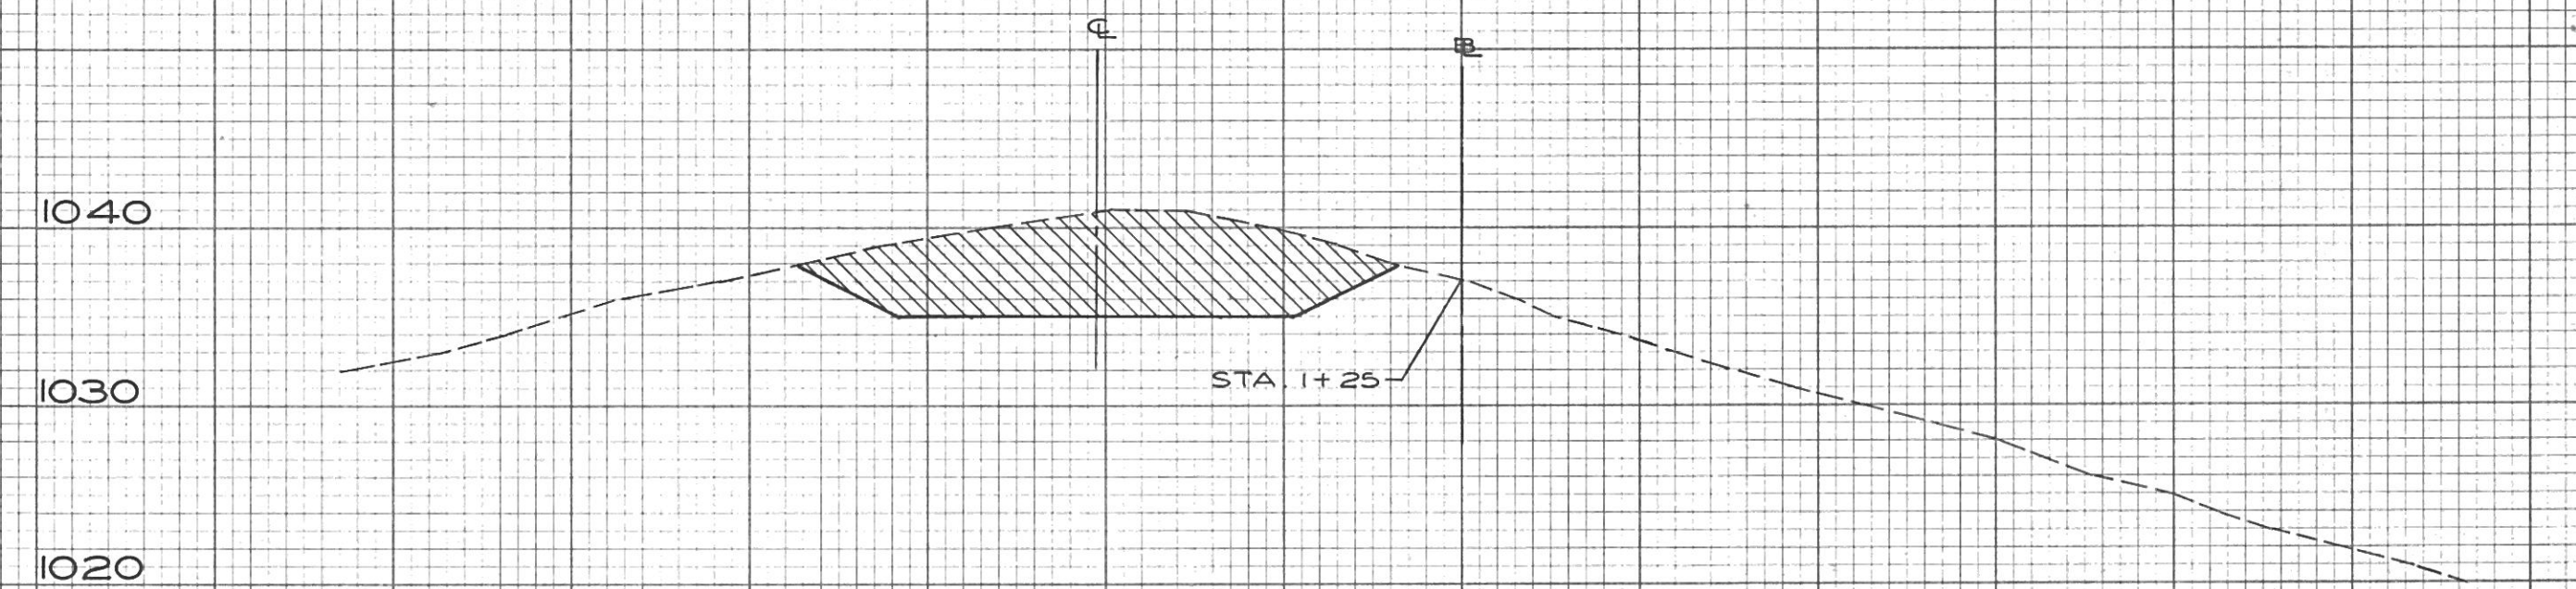
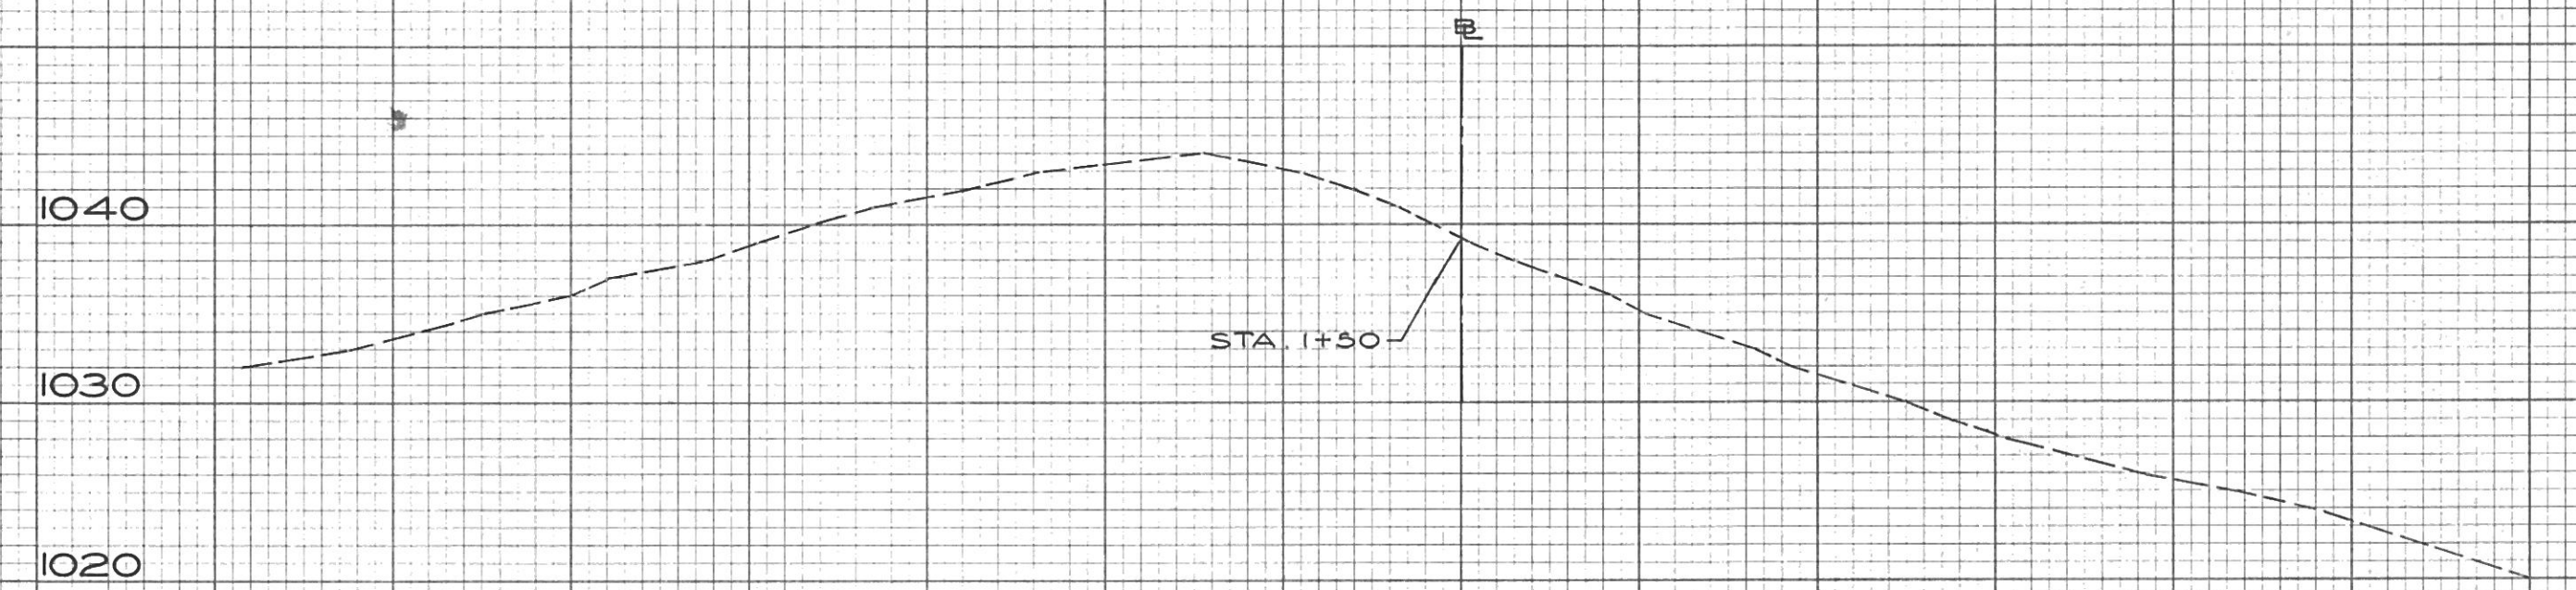
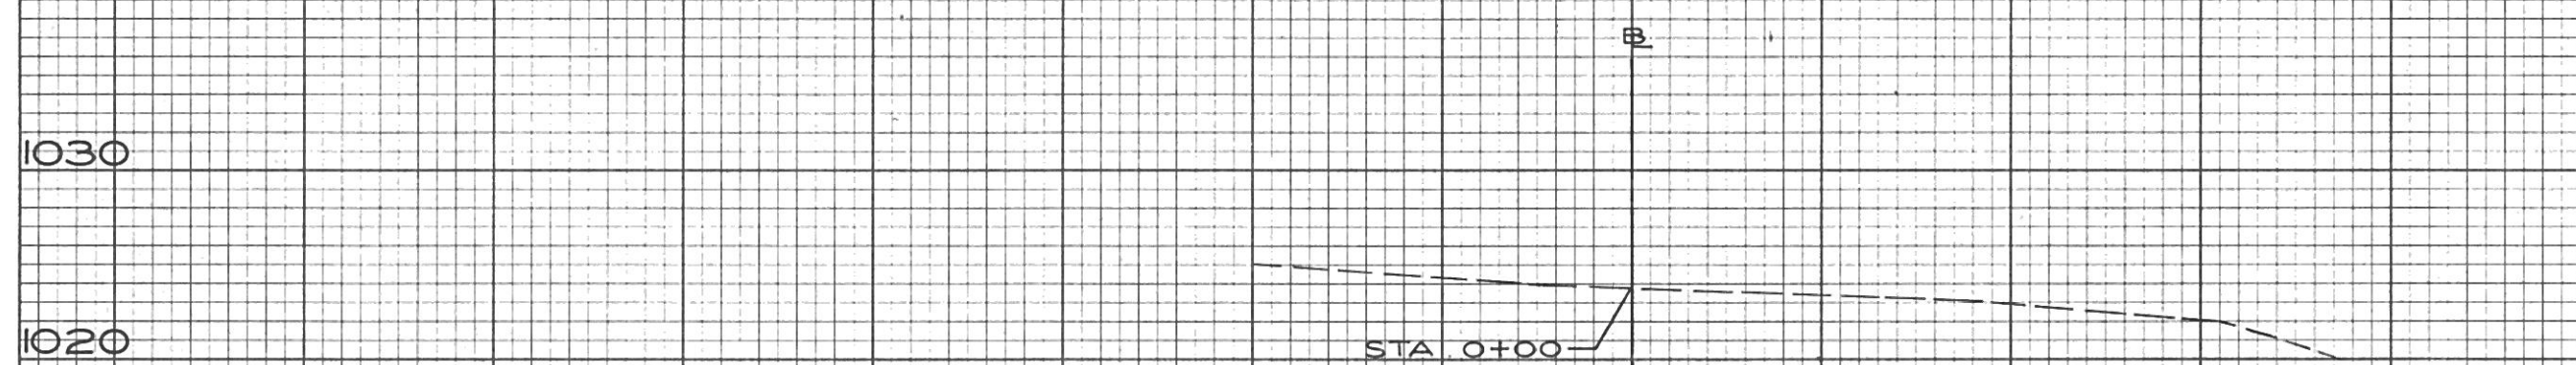
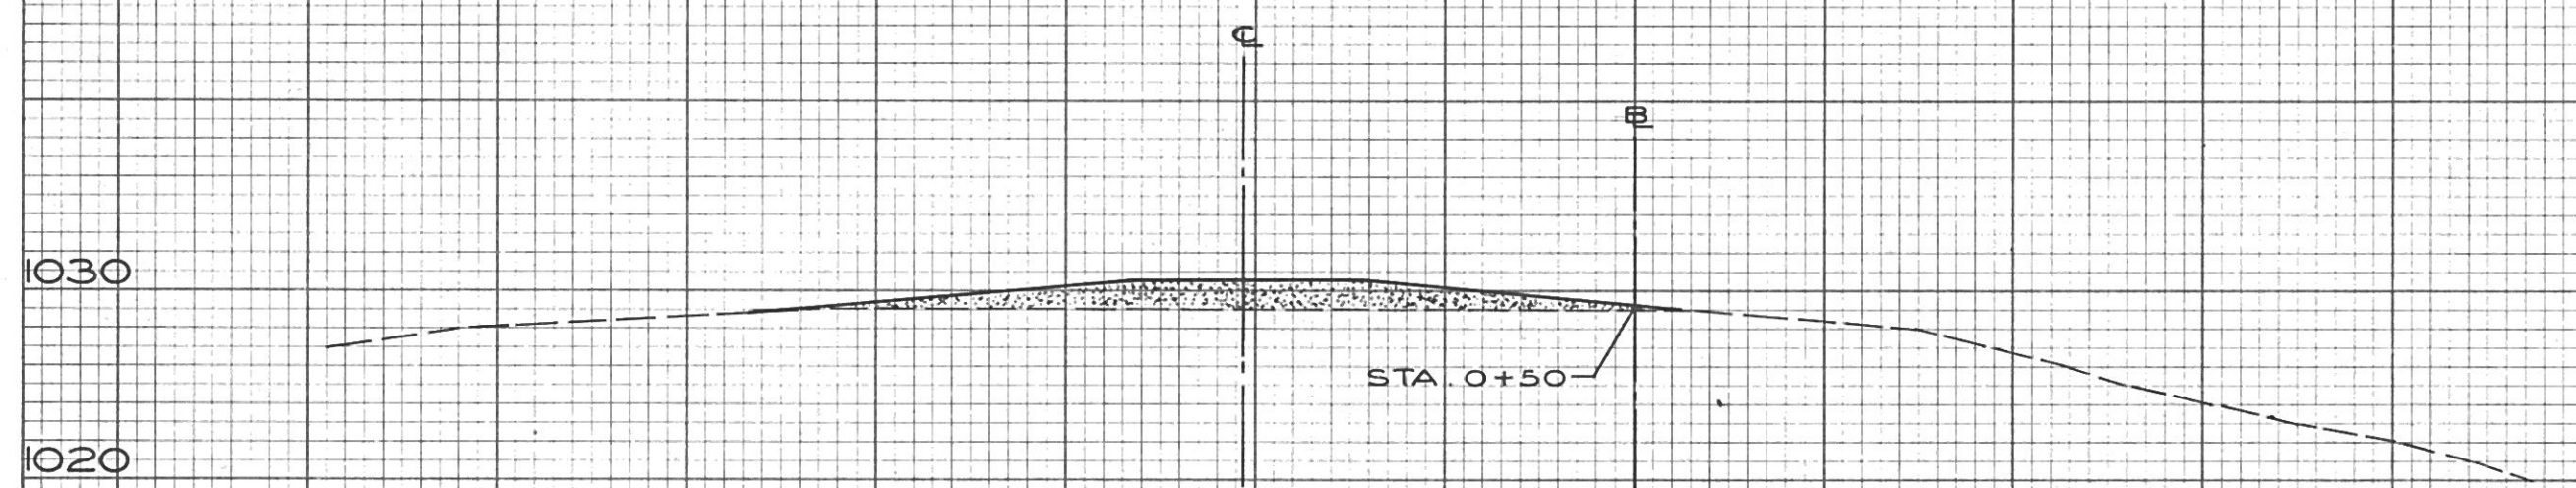


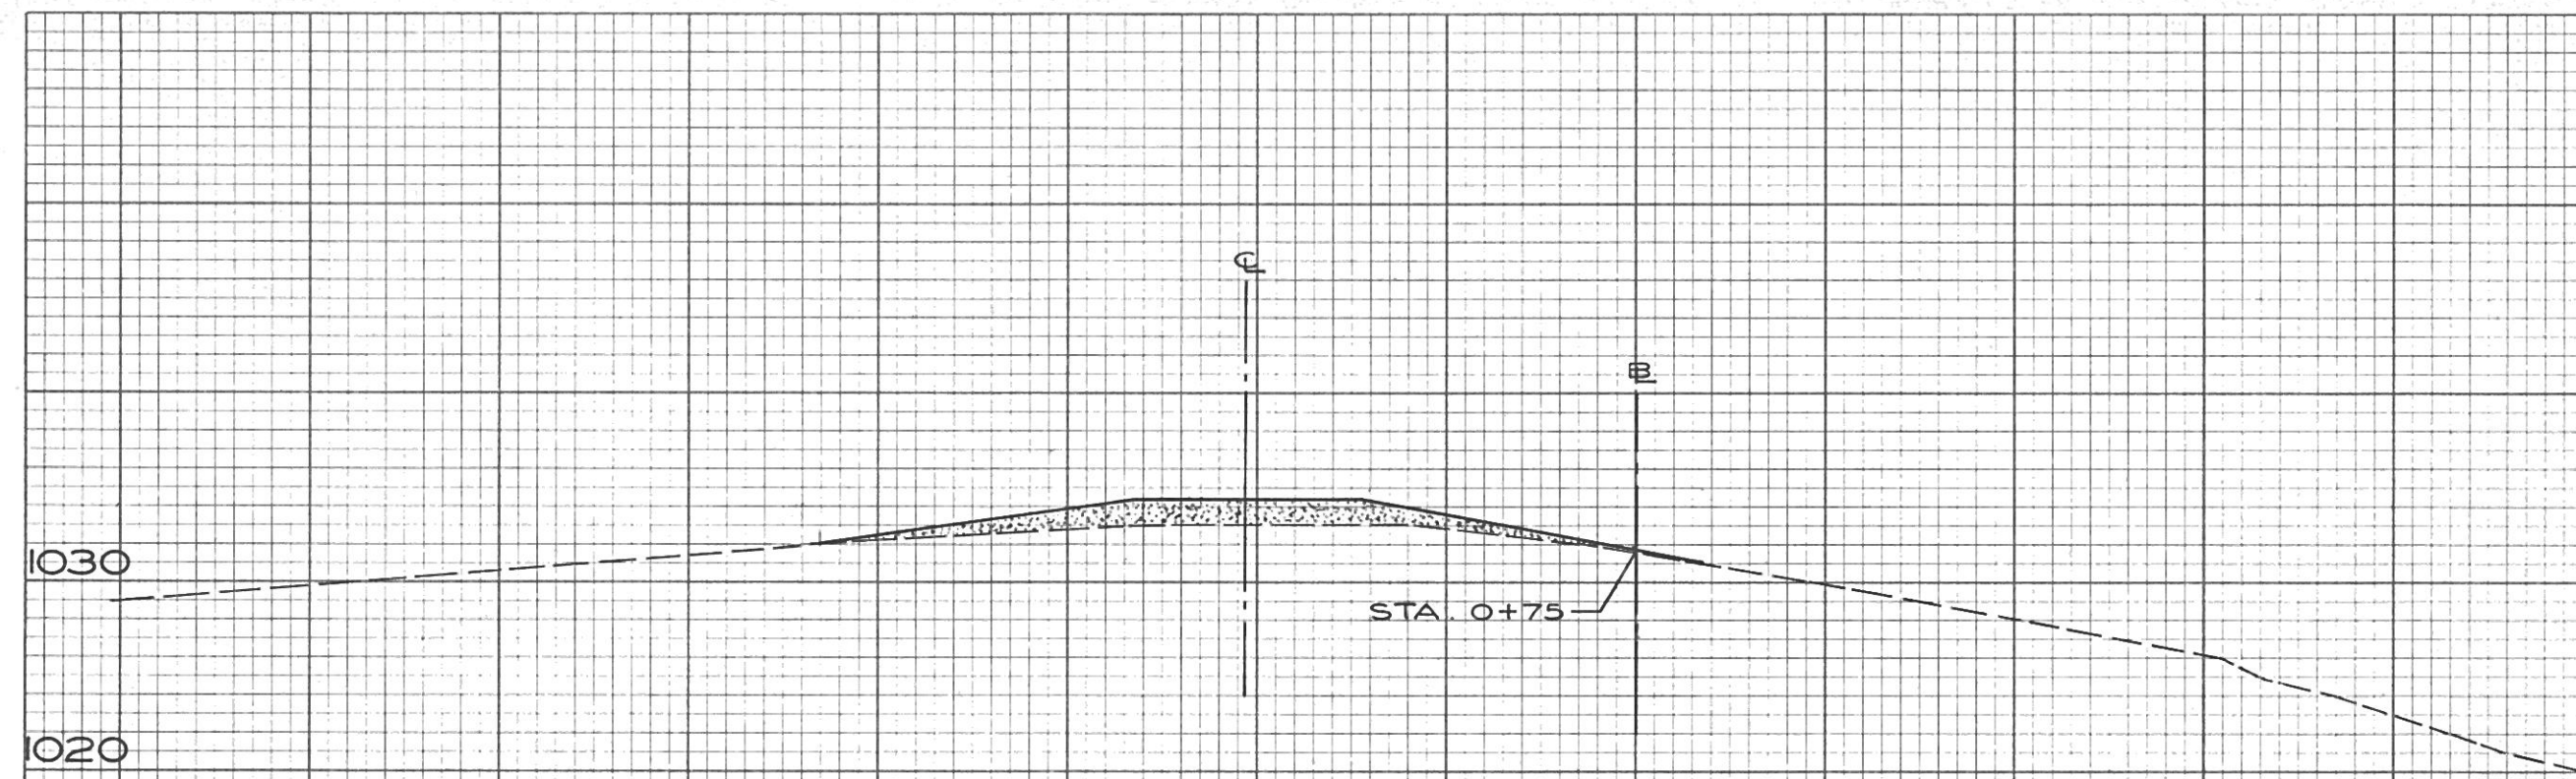

SCALE: HORIZ. 1"=10'
VERT. 1"=10'

CUT
FILL

8		KELLEY, GIDLEY, BLAIR & WOLFE, INC. CONSULTING ENGINEERS CHARLESTON, WEST VIRGINIA					
7		CITY OF ST. ALBANS					
6							
5		KANAWHA COUNTY		WEST VIRGINIA			
4		TANK SITE CROSS-SECTIONS					
3							
2							
1							
		DRAWN	JRS	CHECKED	DAW	PROJECT 72600	DATE DEC. 80
NO.	DATE	DRAWN		APPROVED	HRC	DRAWING NO.	
REVISIONS		DRAWN		SCALE	AS SHOWN	72606	