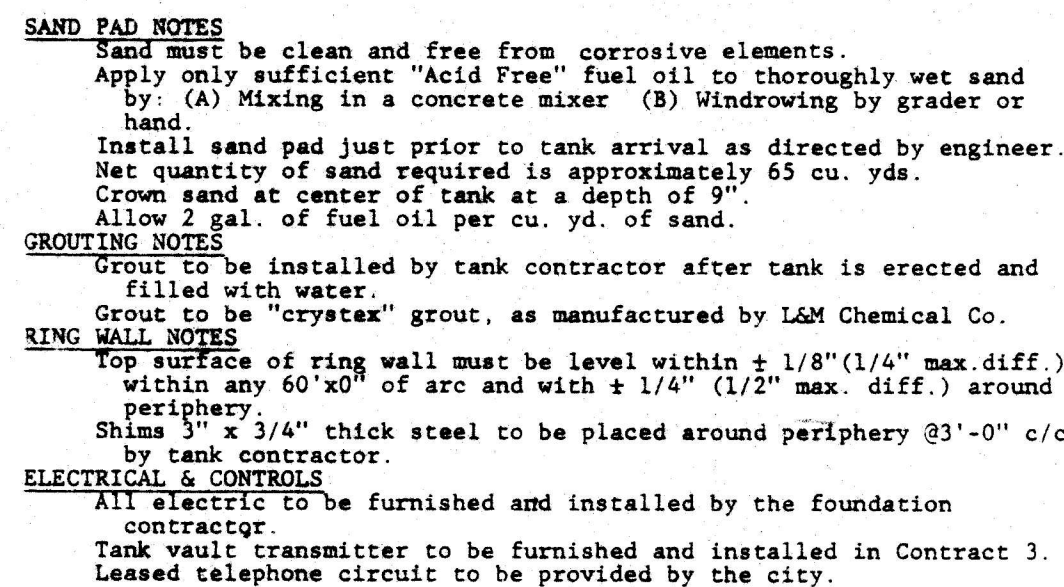


NOTE: 4" DRESSER CPLG. -
MATERIALS & METHODS OF INSTALLATION
OF ALL ELECTRICAL WORK SHALL CONFORM
TO SECTIONS 16010 & 16100 OF THE
SPECIFICATIONS.

8		KELLEY, GIDLEY, BLAIR & WOLFE, INC.					
7		CONSULTING ENGINEERS					
		CHARLESTON, WEST VIRGINIA					
6		CITY OF ST. ALBANS					
5		KANAWHA COUNTY			WEST VIRGINIA		
4		1,500,000 GALLON TANK					
3		FOUNDATION PIPING					
2		REINFORCING & MISC. DETAILS					
1		DRAWN	JRS	CHECKED	DAW	PROJECT 72600	DATE FEB. 81
NO.	DATE	DRAWN		APPROVED	HRC	DRAWING NO.	
REVISIONS		DRAWN		SCALE AS NOTED		72616	