


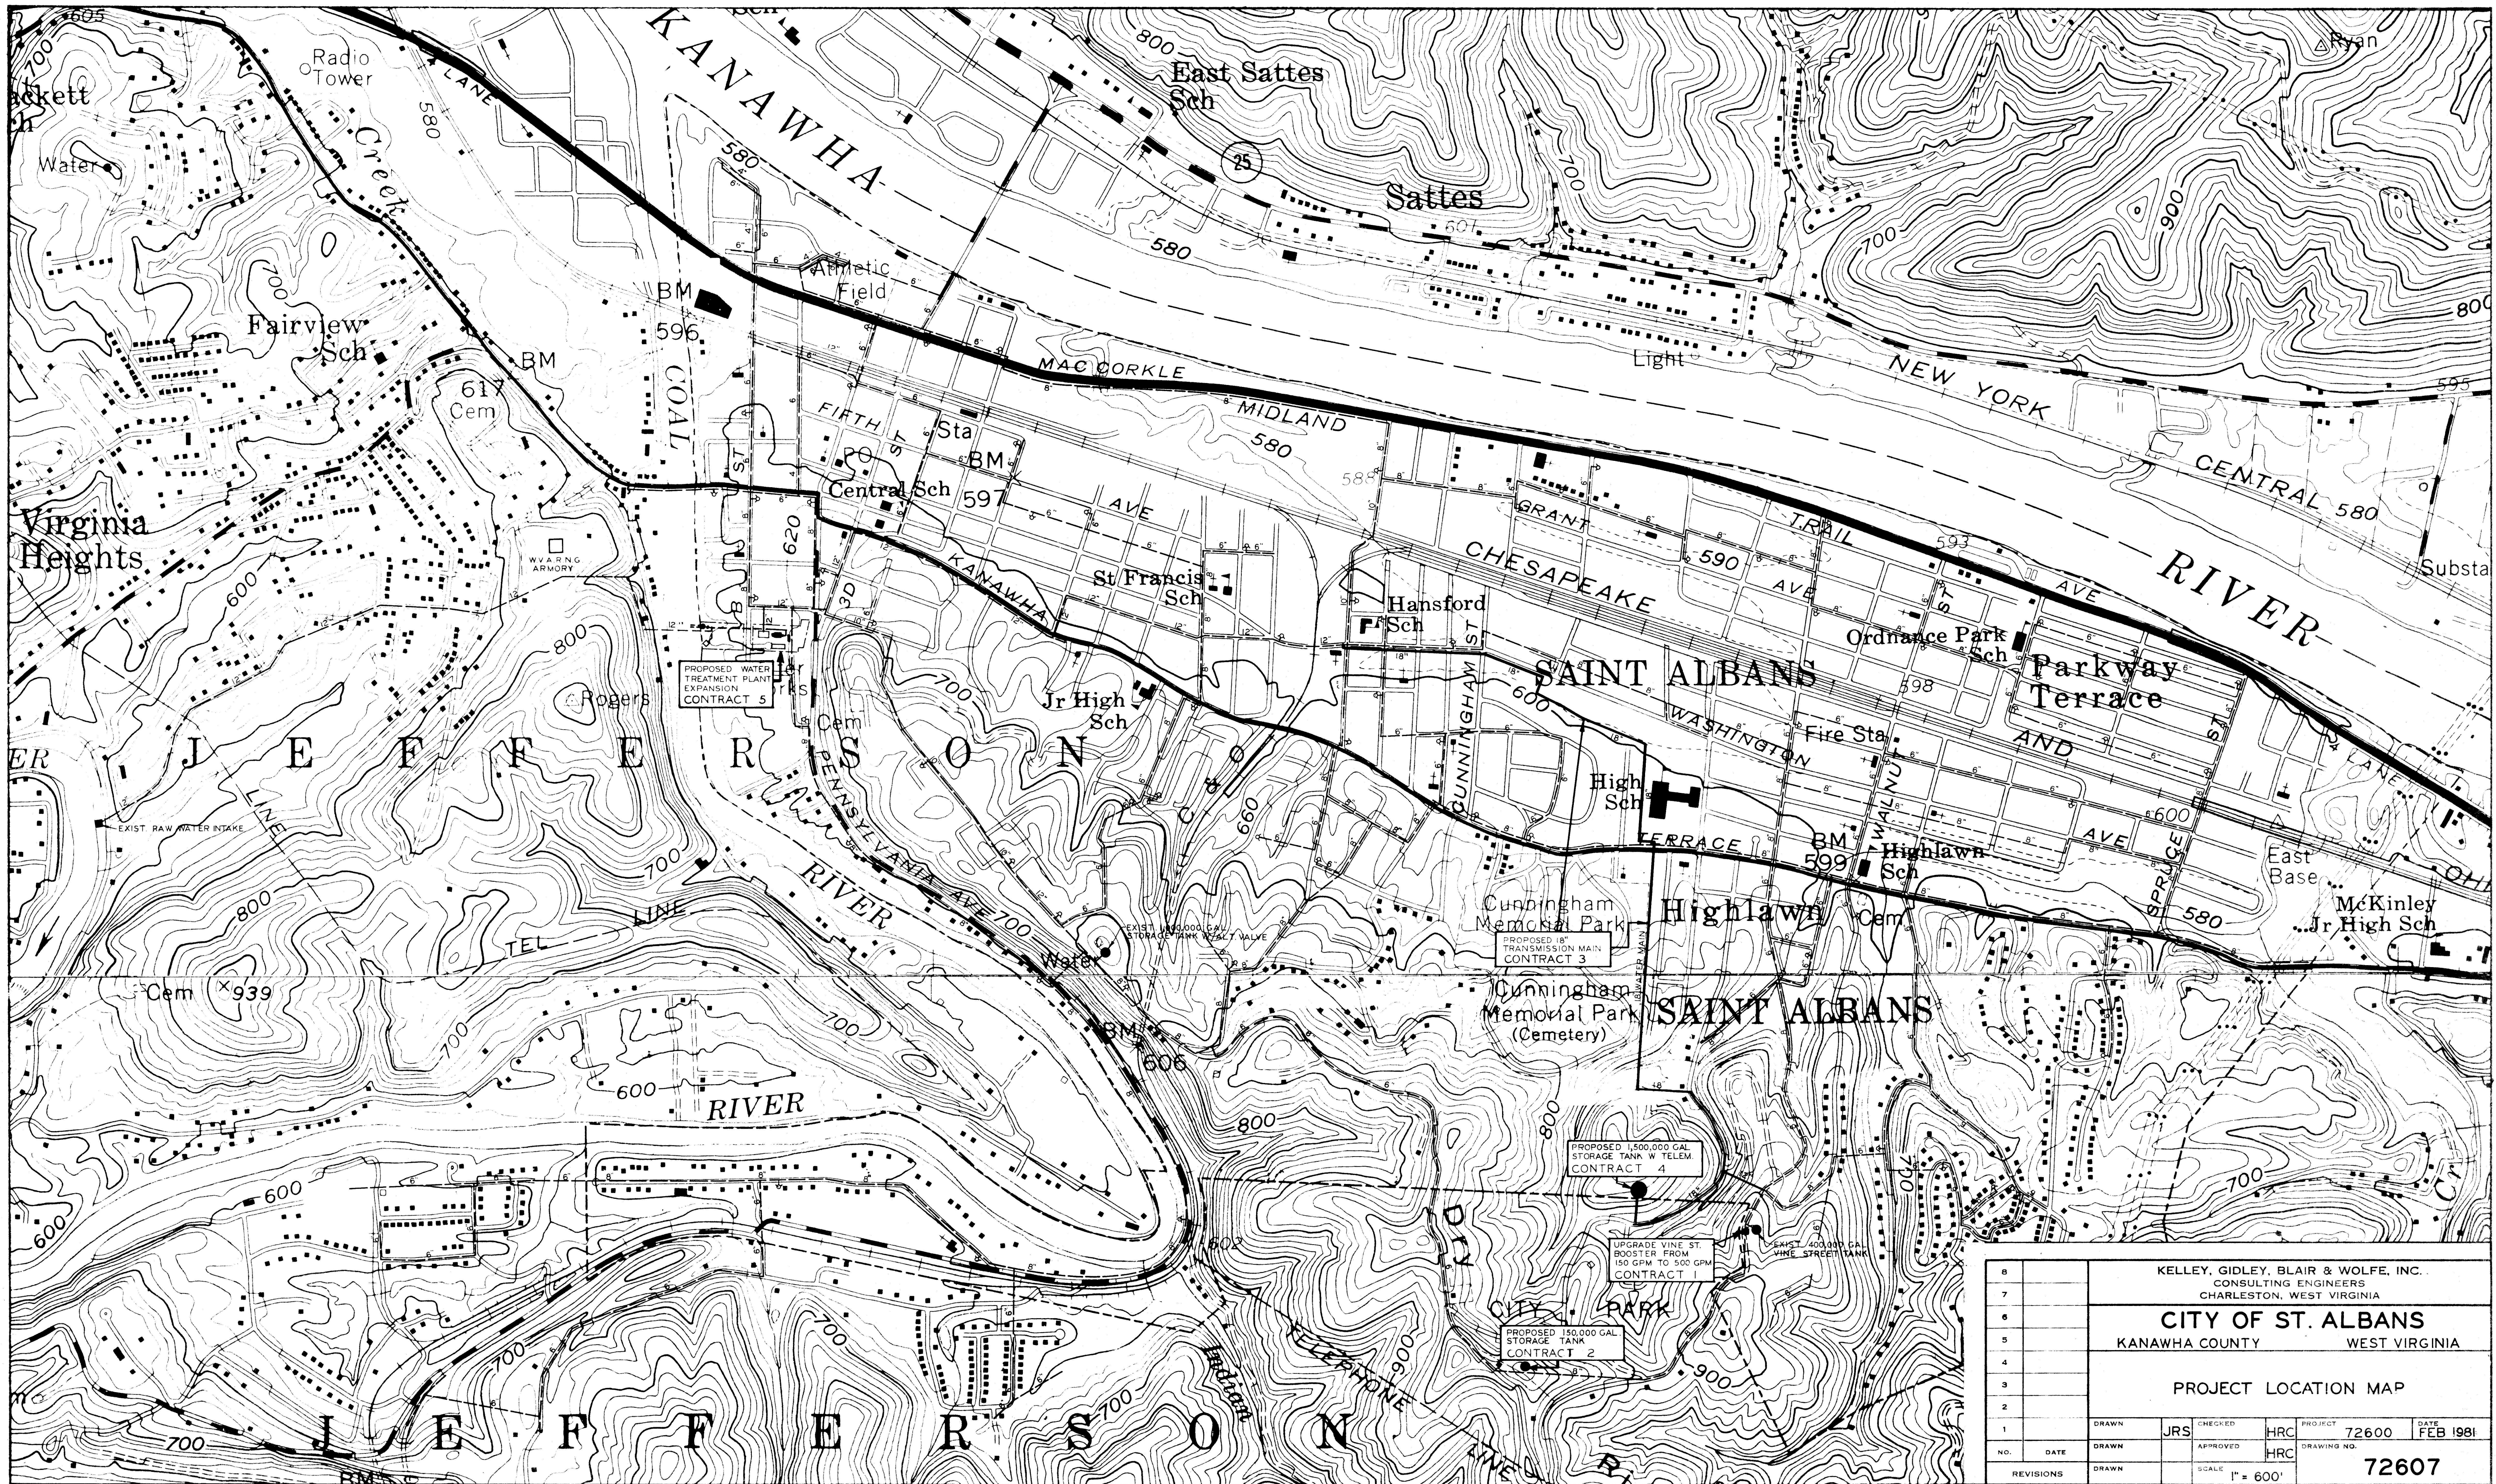

8		KELLEY, GIDLEY, BLAIR & WOLFE, INC.,							
7		CONSULTING ENGINEERS							
		CHARLESTON, WEST VIRGINIA							
6		CITY OF ST. ALBANS							
5		KANAWHA COUNTY		WEST VIRGINIA					
4		PROJECT LOCATION MAP							
3									
2									
1		DRAWN	JRS	CHECKED	HRC	PROJECT	72600	DATE	FEB 1981
	NO.	DATE	DRAWN	APPROVED	HRC	DRAWING NO.			
	REVISIONS		DRAWN	SCALE	1" = 600'				
						72607			