

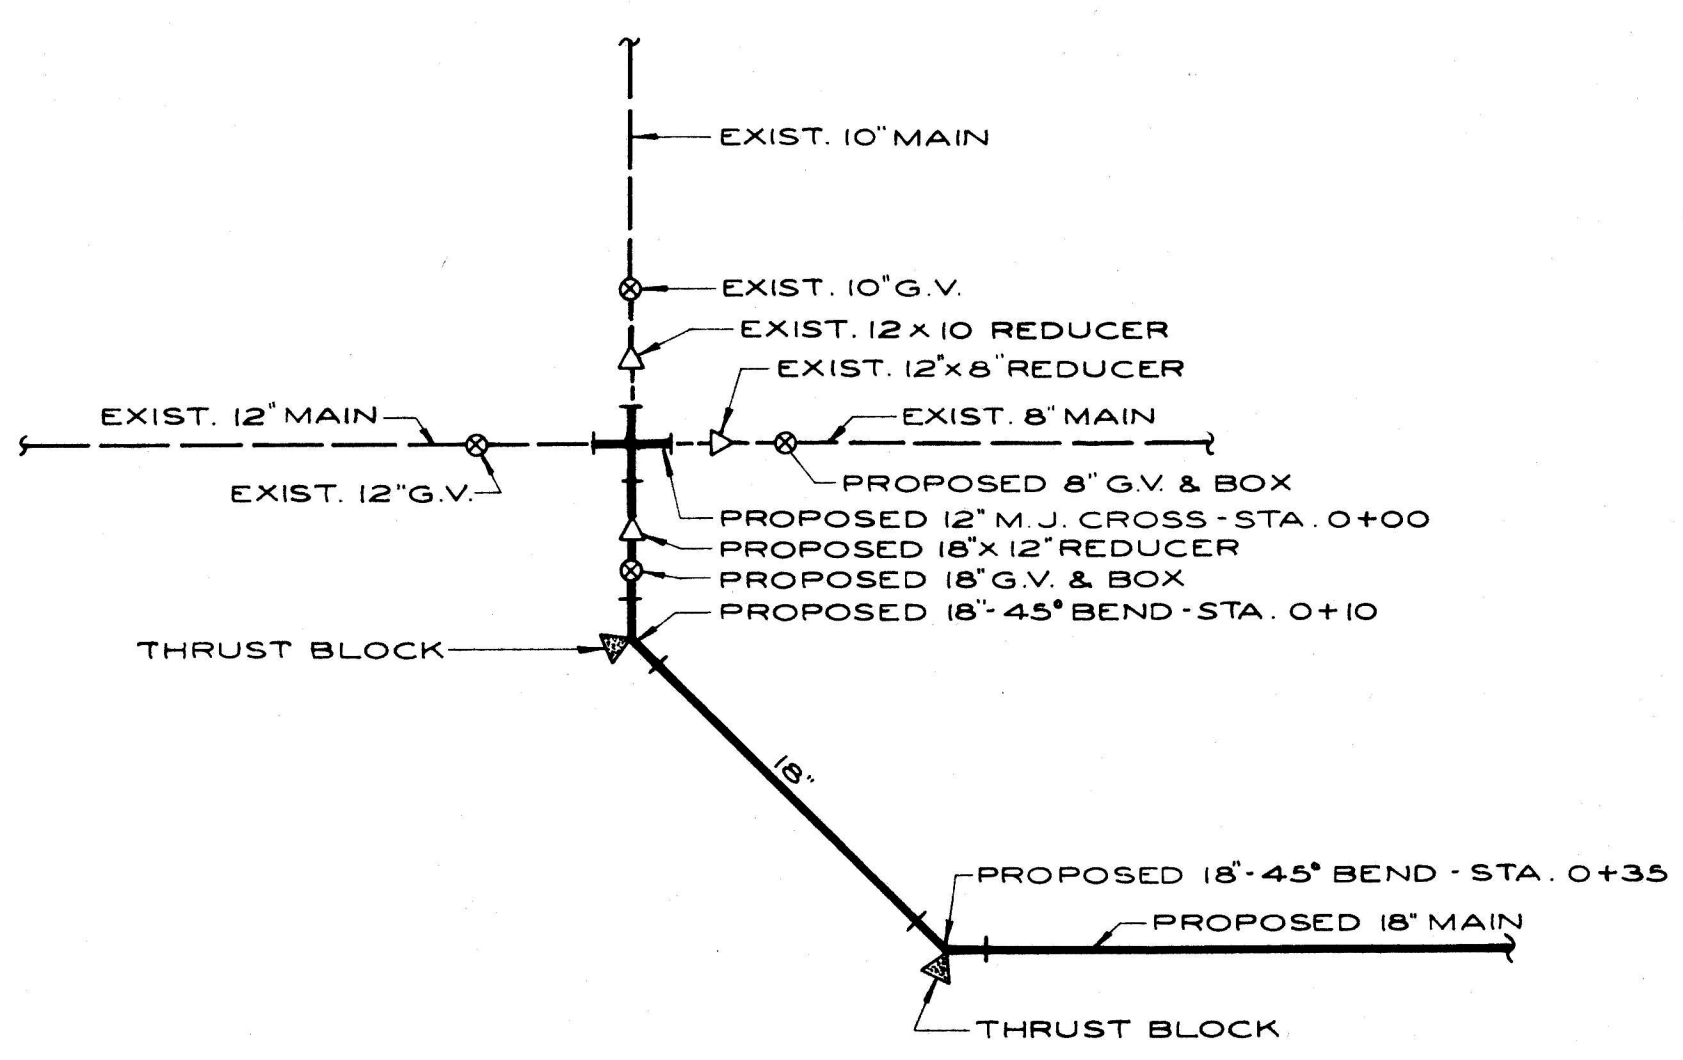


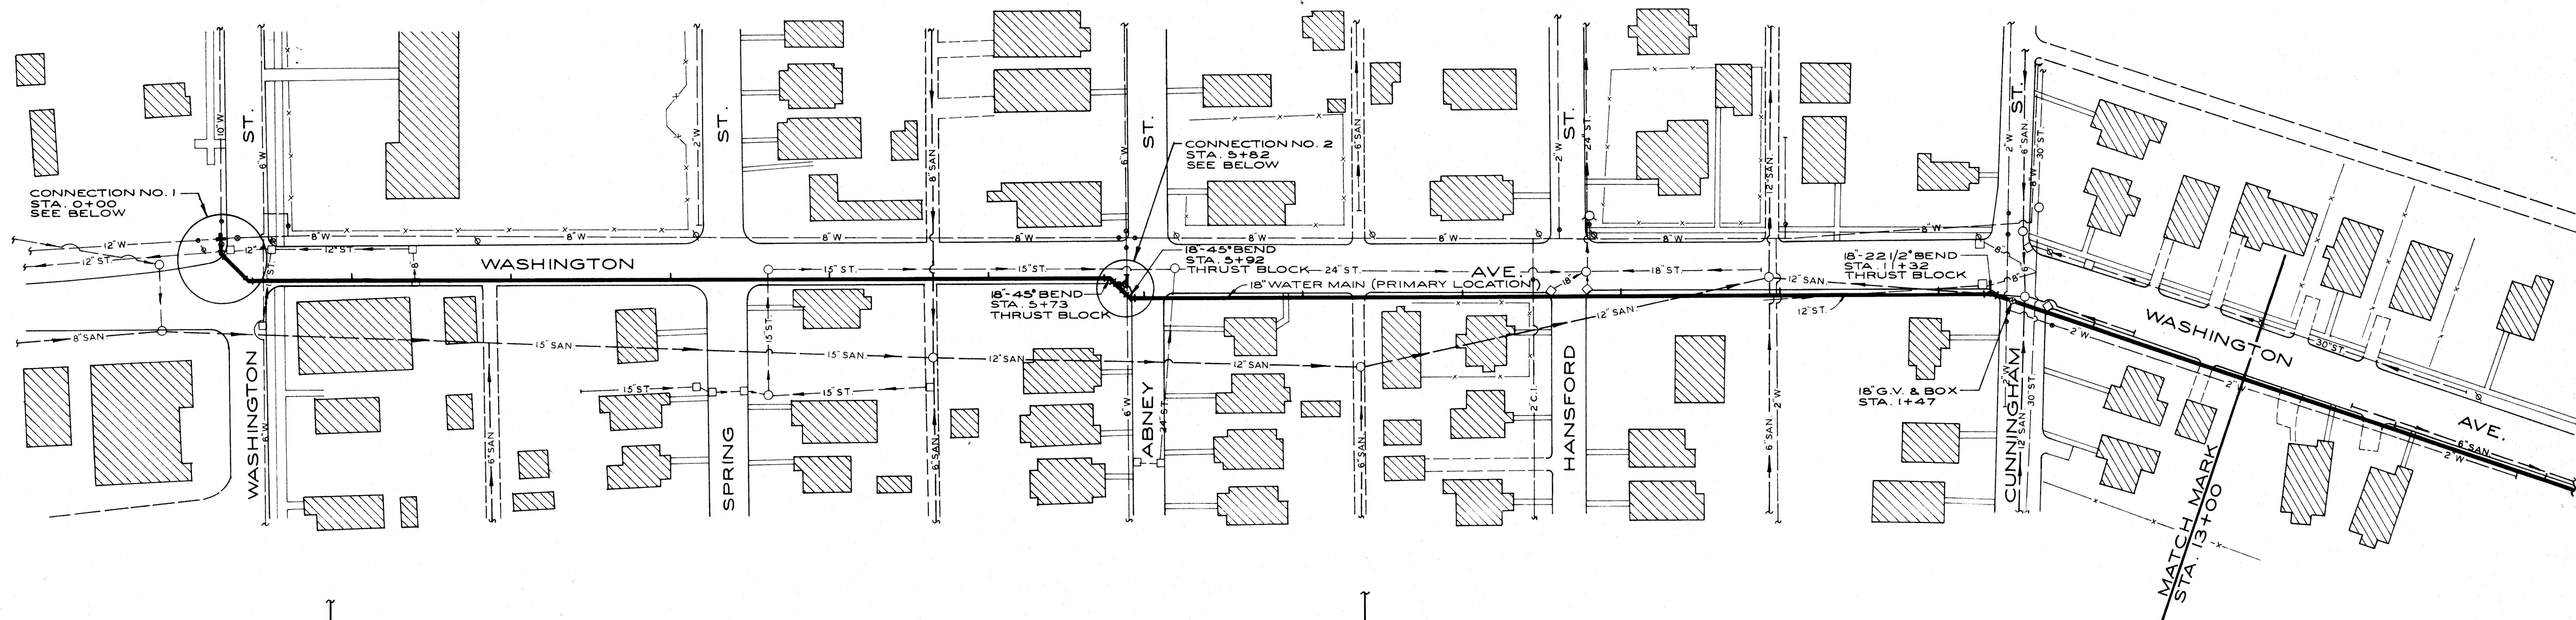

CONNECTION NO. 1

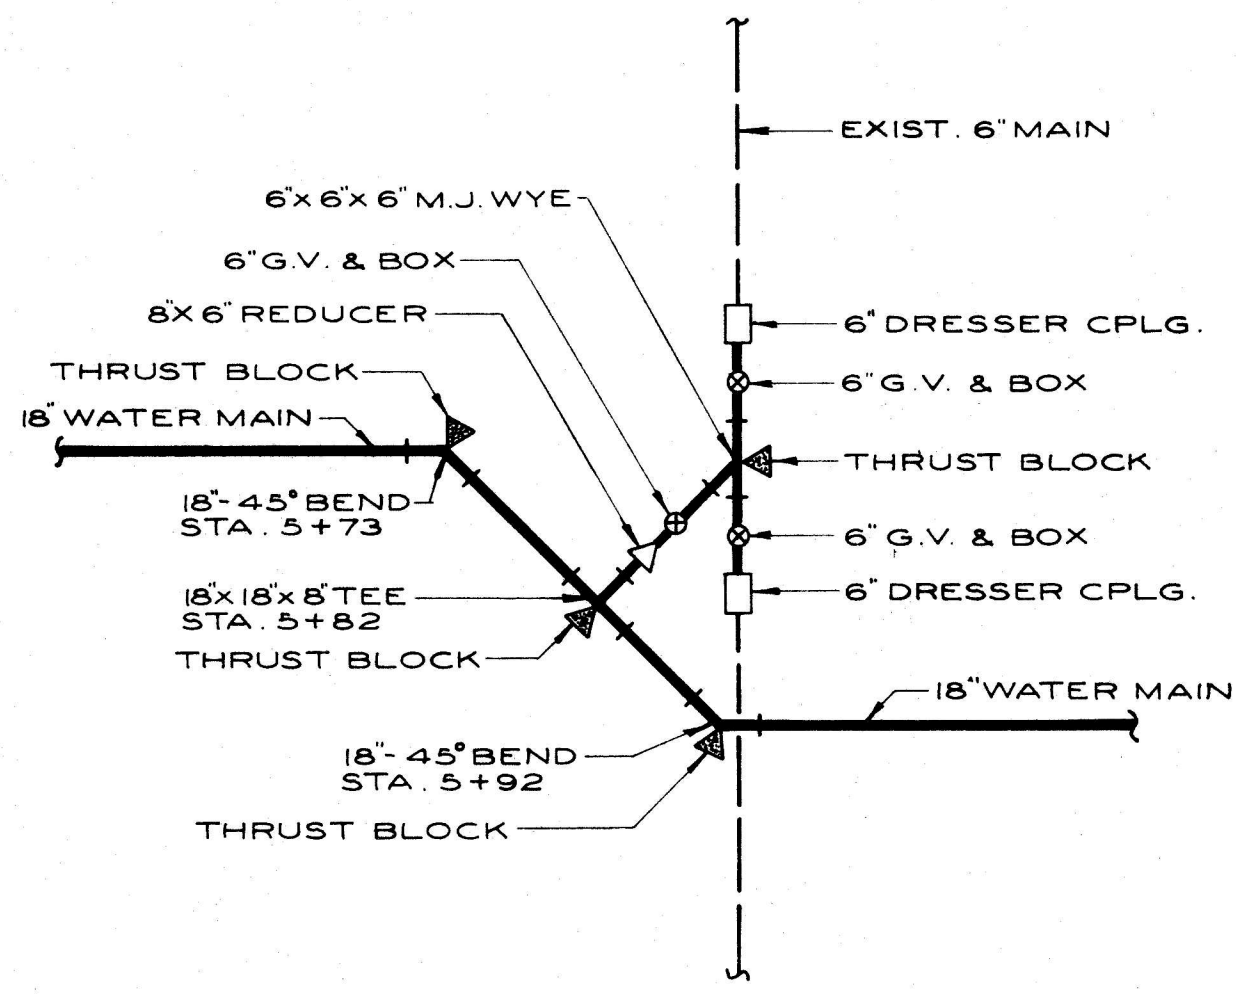

CONNECTION NO. 2

NOTE:
PROVIDE 10' HORIZONTAL AND 18" VERTICAL
SEPARATION FROM EXISTING SEWERS.

8		KELLEY, GIDLEY, BLAIR & WOLFE, INC. CONSULTING ENGINEERS CHARLESTON, WEST VIRGINIA					
7		CITY OF ST. ALBANS					
6		KANAWHA COUNTY WEST VIRGINIA					
5		18" WATER TRANSMISSION MAIN					
4		STA. 0+00 TO STA. 13+00					
3							
2							
1		DRAWN	JRS	CHECKED	DAW	PROJECT	72600
		DATE		APPROVED	HRC	DATE	FEB. 81
		REVISIONS	DRAWN	SCALE	1"=50'	DRAWING NO.	72608