


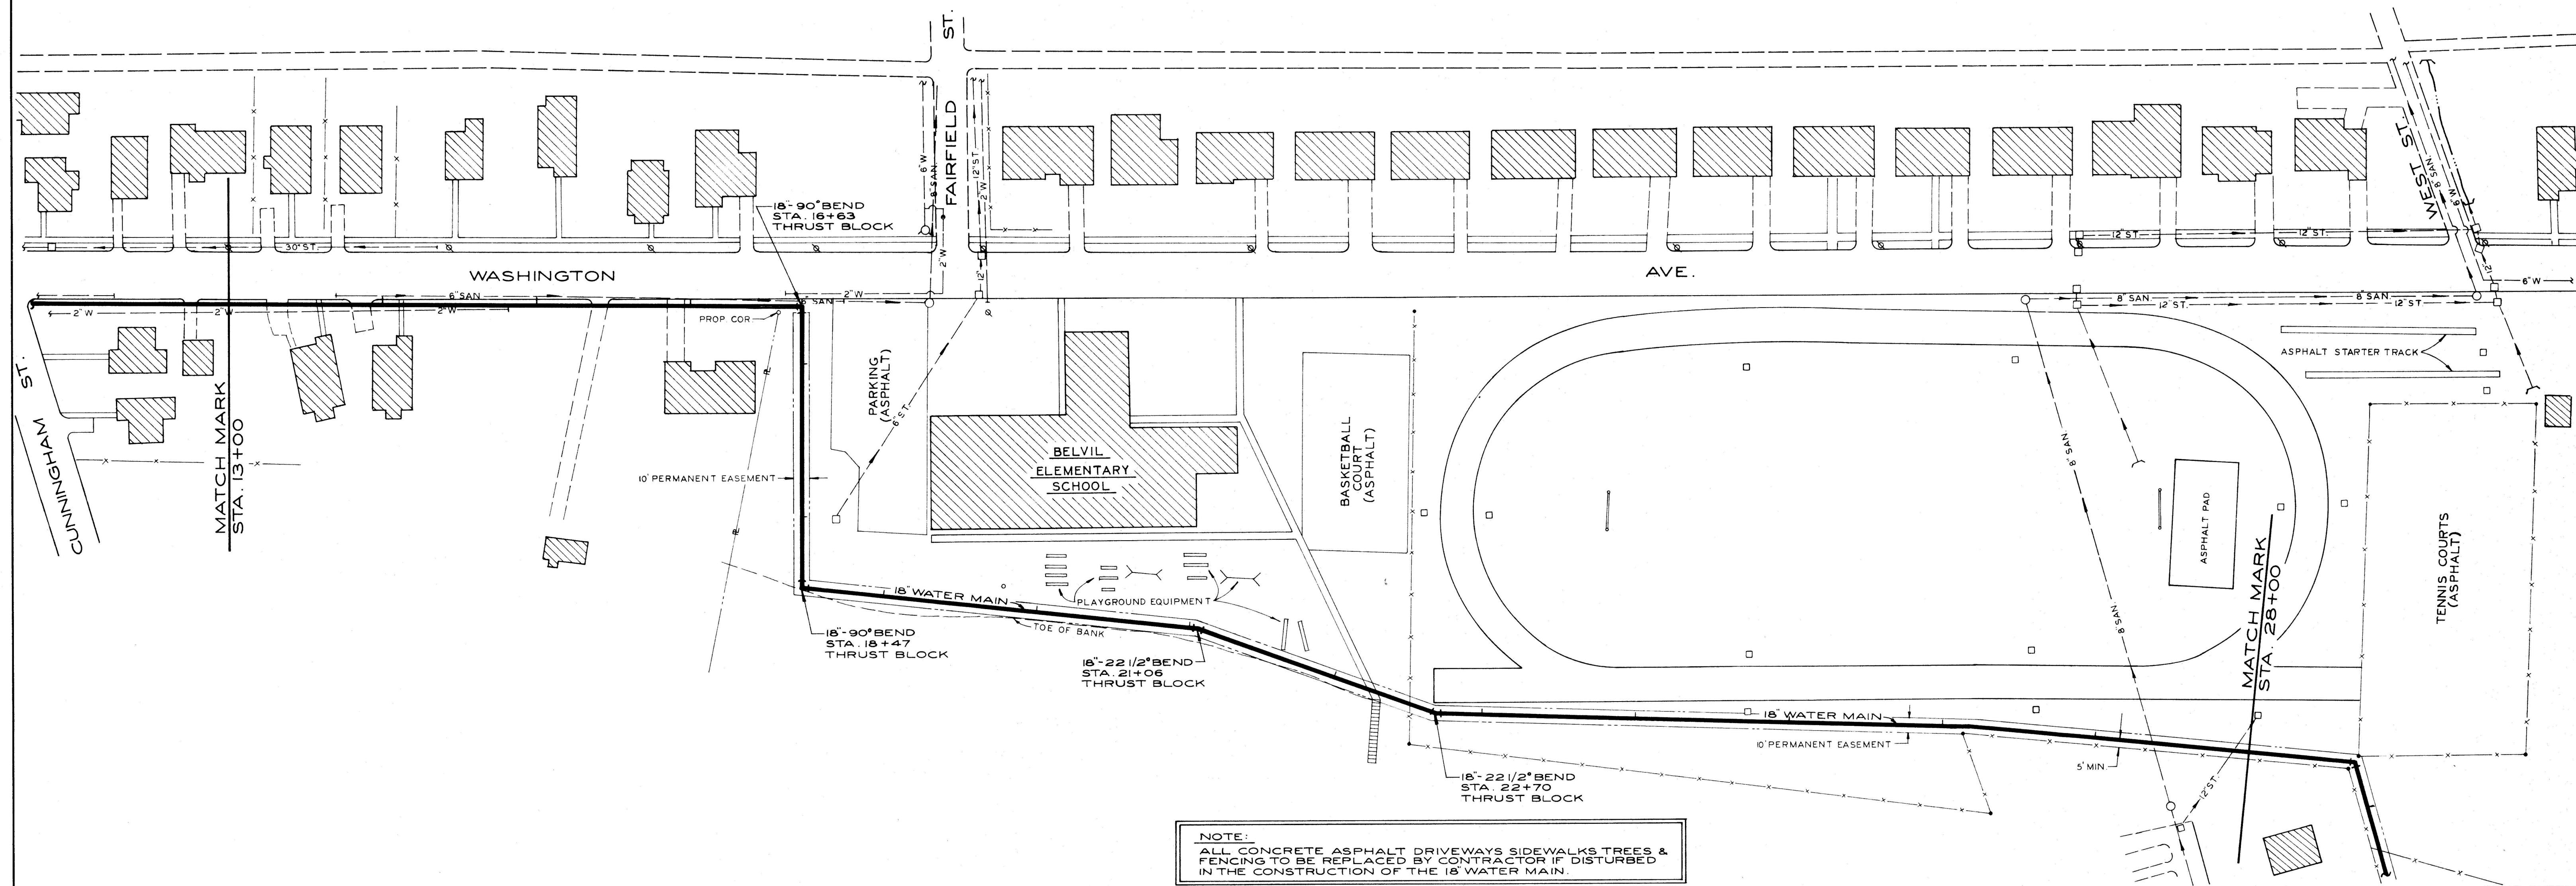

NOTE:
ALL CONCRETE, ASPHALT DRIVEWAYS, SIDEWALKS, TREES & FENCING TO BE REPLACED BY CONTRACTOR IF DISTURBED IN THE CONSTRUCTION OF THE 18" WATER MAIN.

NOTE:
PROVIDE 10' HORIZONTAL AND 18" VERTICAL SEPARATION FROM EXISTING SEWERS.

8		KELLEY, GIDLEY, BLAIR & WOLFE, INC. CONSULTING ENGINEERS CHARLESTON, WEST VIRGINIA					
7							
6		CITY OF ST. ALBANS					
5		KANAWHA COUNTY			WEST VIRGINIA		
4		18" WATER TRANSMISSION MAIN STA. 13+00 TO STA. 28+00					
3							
2							
1		DRAWN	JRS	CHECKED	DAW	PROJECT 72600	DATE FEB. 81
NO.	DATE	DRAWN		APPROVED	HRC	DRAWING NO.	
REVISIONS		DRAWN		SCALE 1"=50'	72609		