
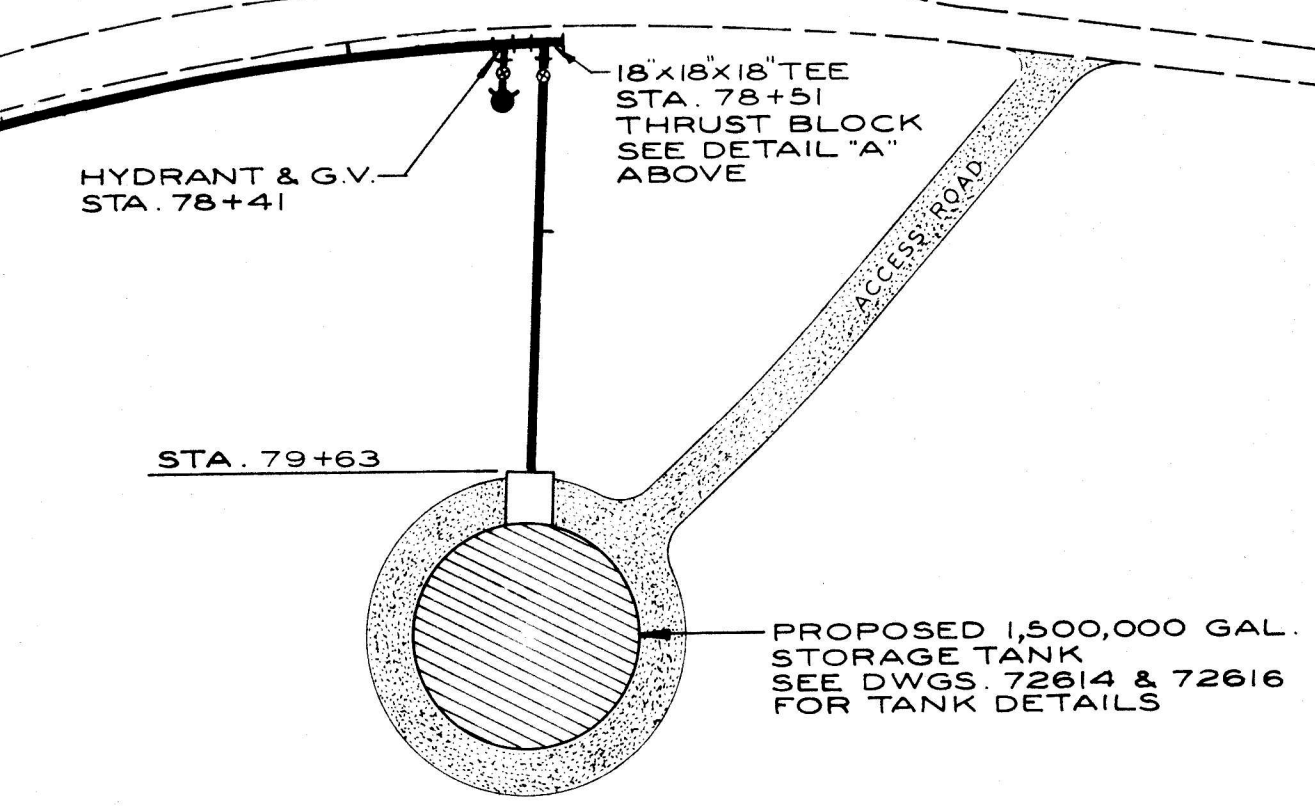
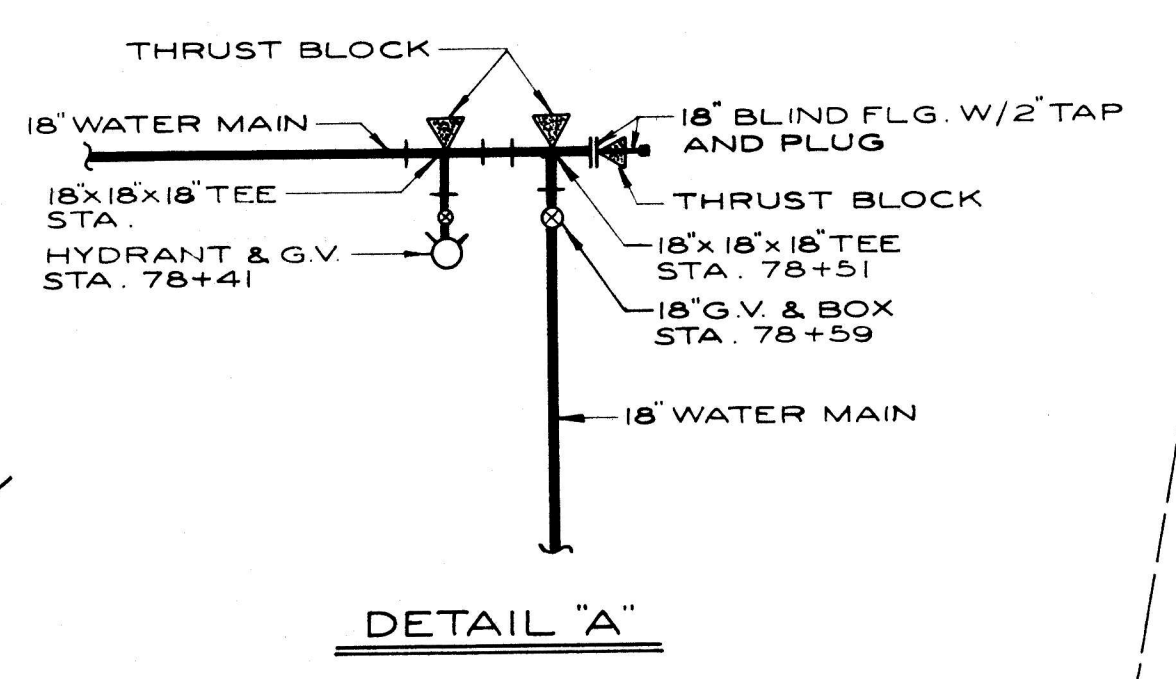


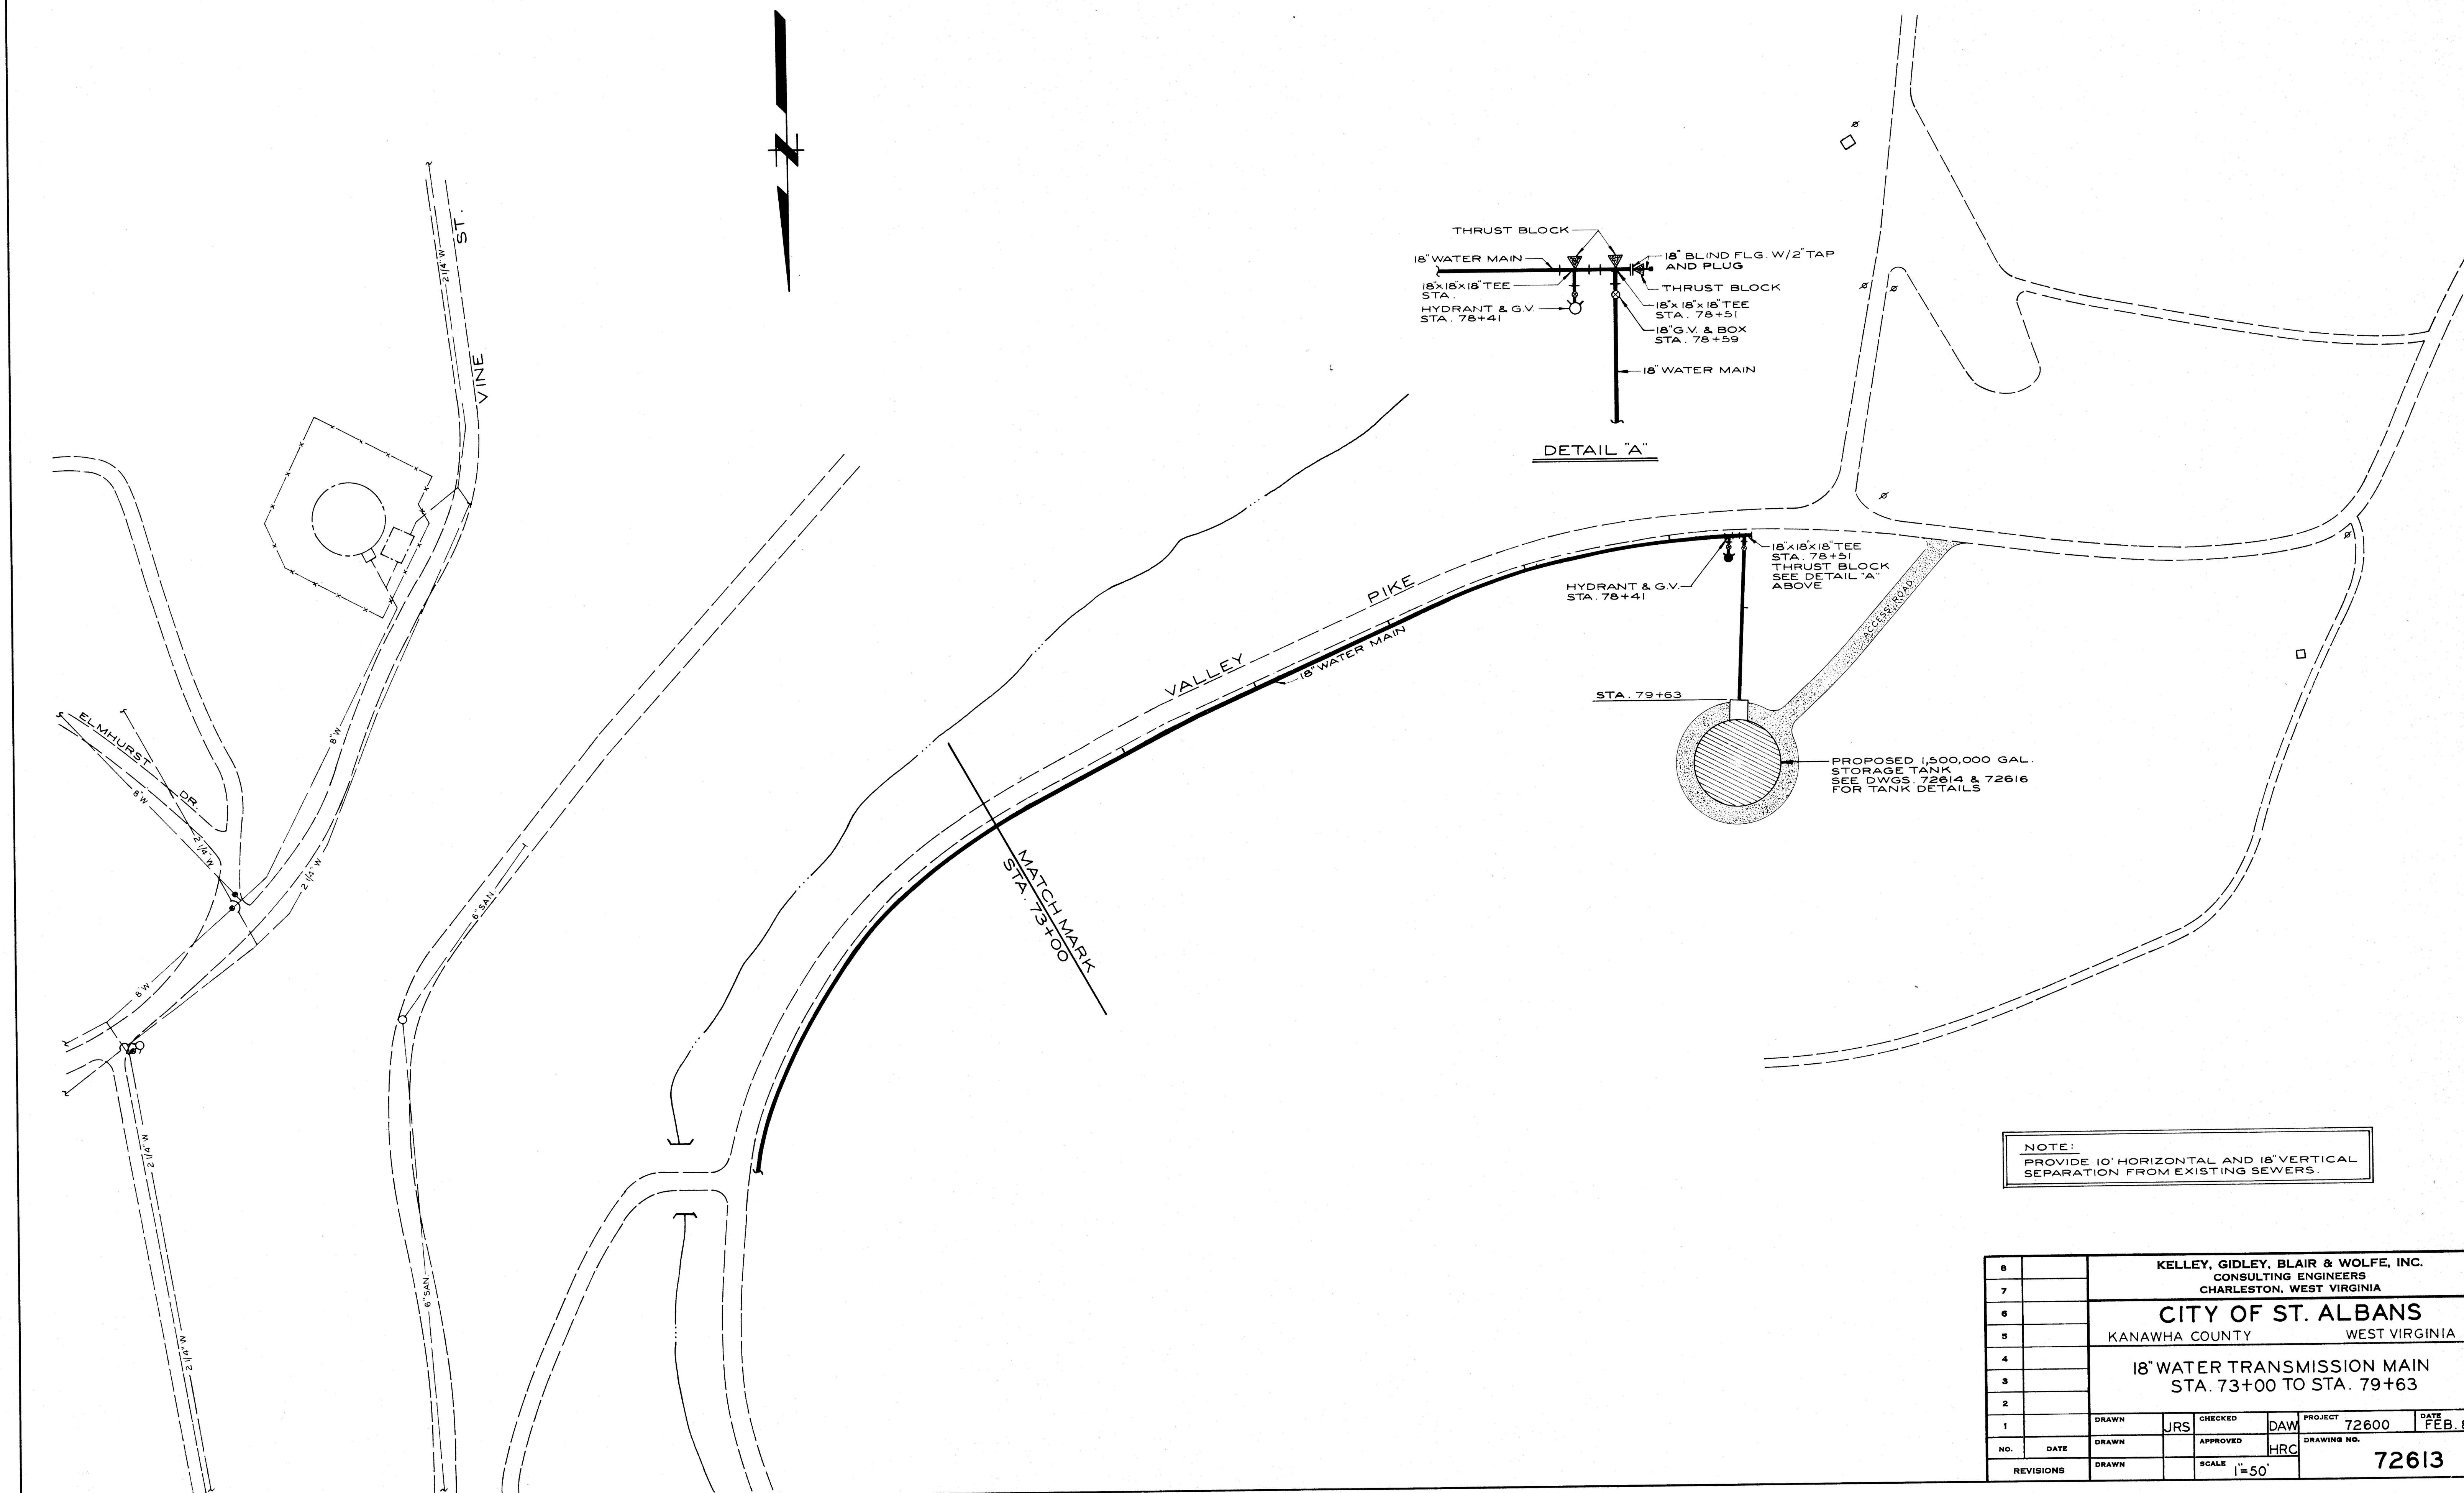

NOTE:
PROVIDE 10' HORIZONTAL AND 18' VERTICAL
SEPARATION FROM EXISTING SEWERS.

8		KELLEY, GIDLEY, BLAIR & WOLFE, INC. CONSULTING ENGINEERS CHARLESTON, WEST VIRGINIA					
7		CITY OF ST. ALBANS KANAWHA COUNTY WEST VIRGINIA					
6							
5							
4		18" WATER TRANSMISSION MAIN STA. 73+00 TO STA. 79+63					
3							
2							
1		DRAWN	JRS	CHECKED	DAW	PROJECT 72600	DATE FEB. 81
NO.	DATE	DRAWN		APPROVED	HRC	DRAWING NO.	
REVISIONS		DRAWN		SCALE	1"=50'	72613	