
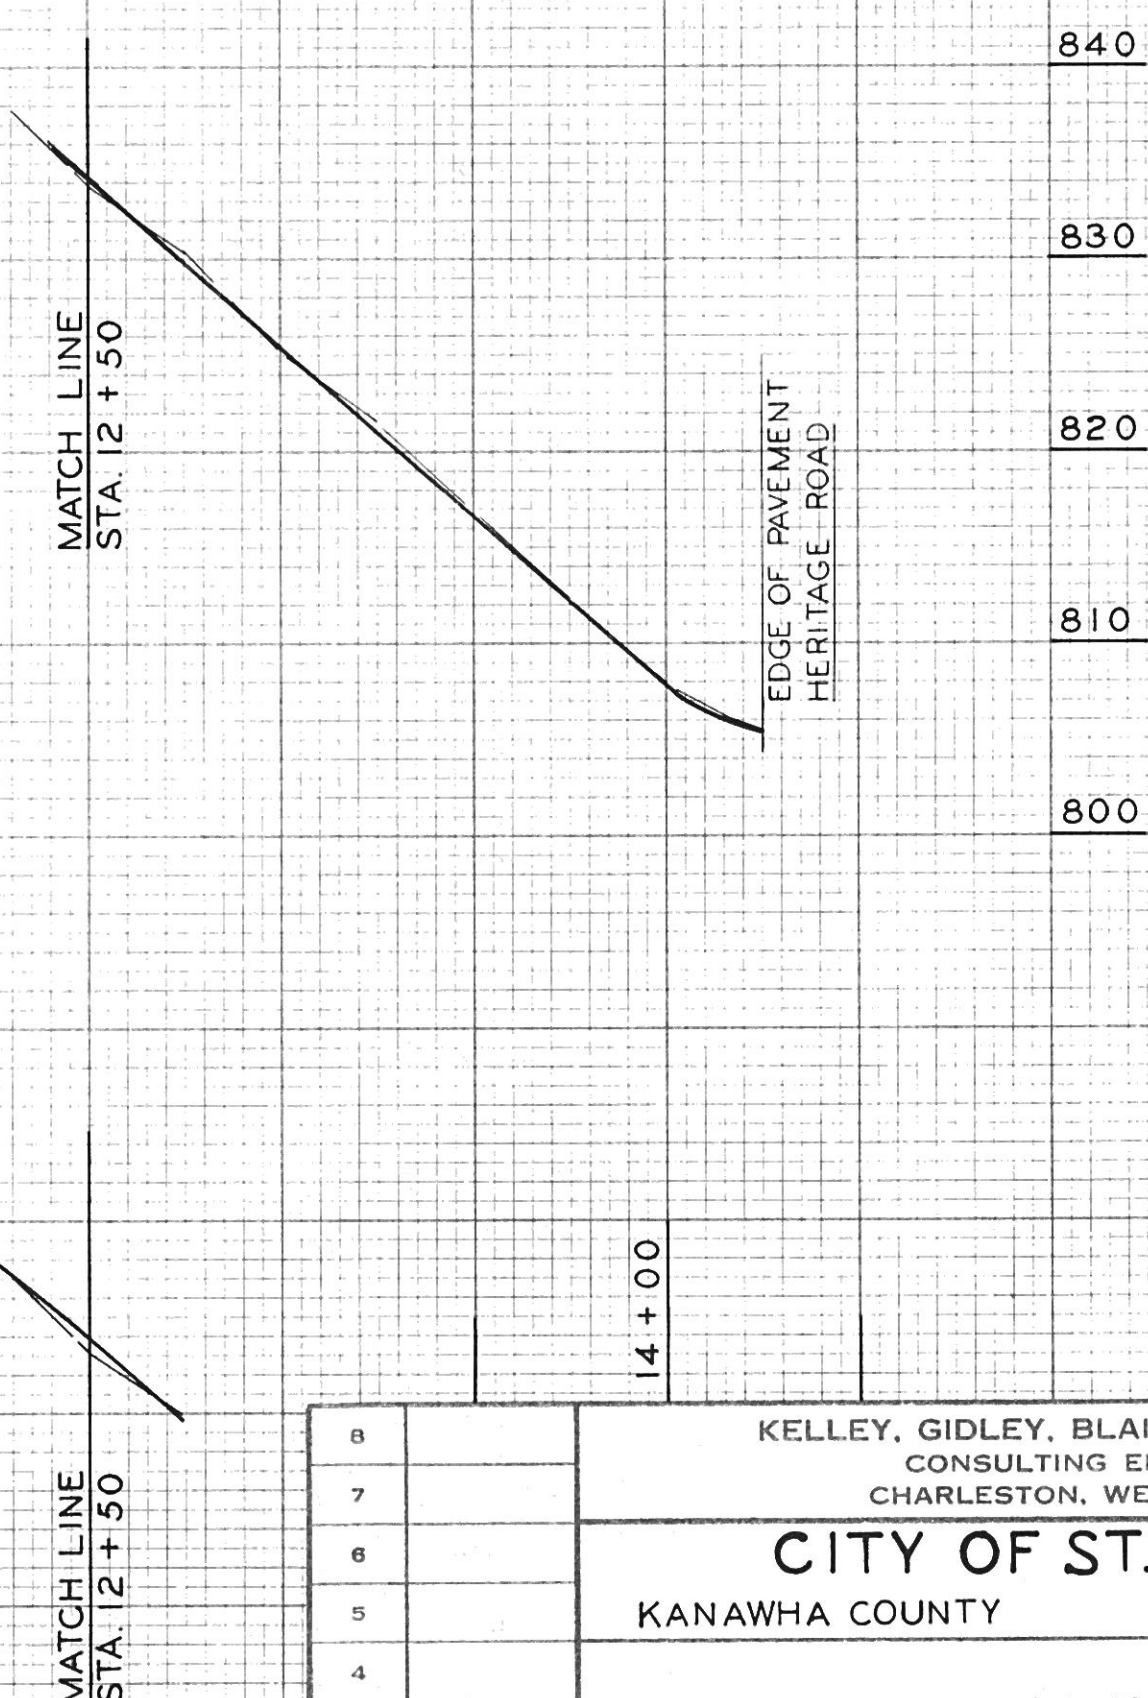
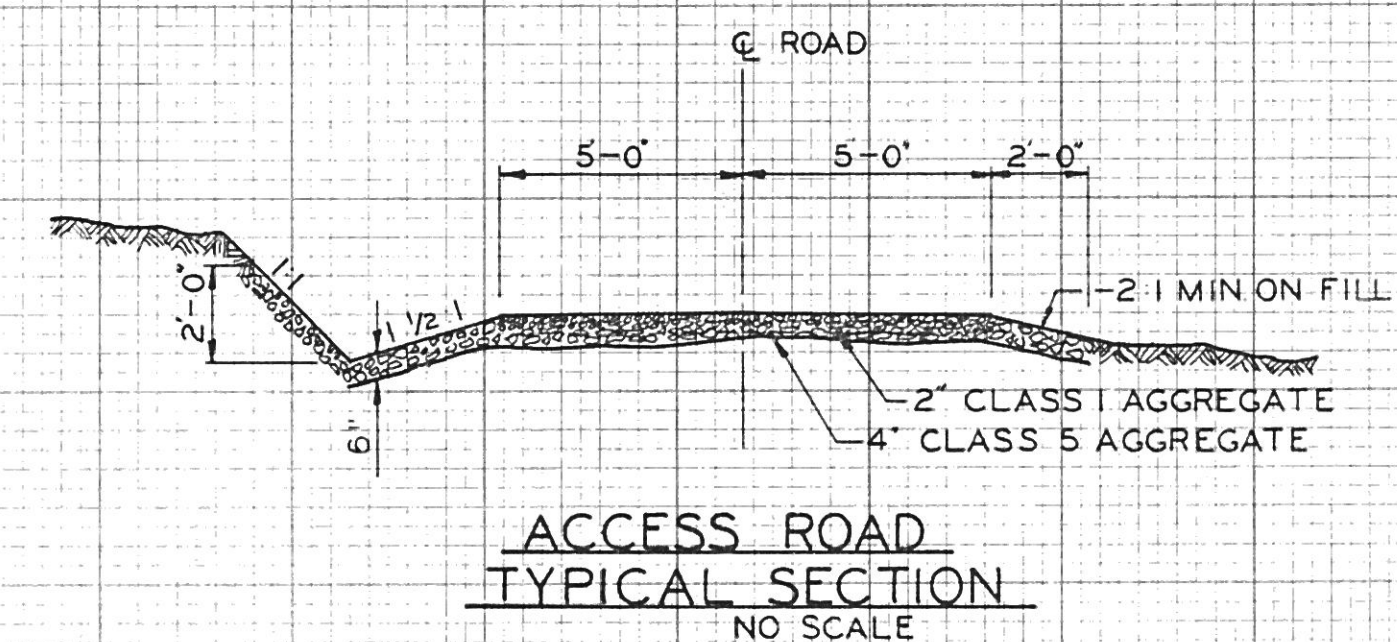


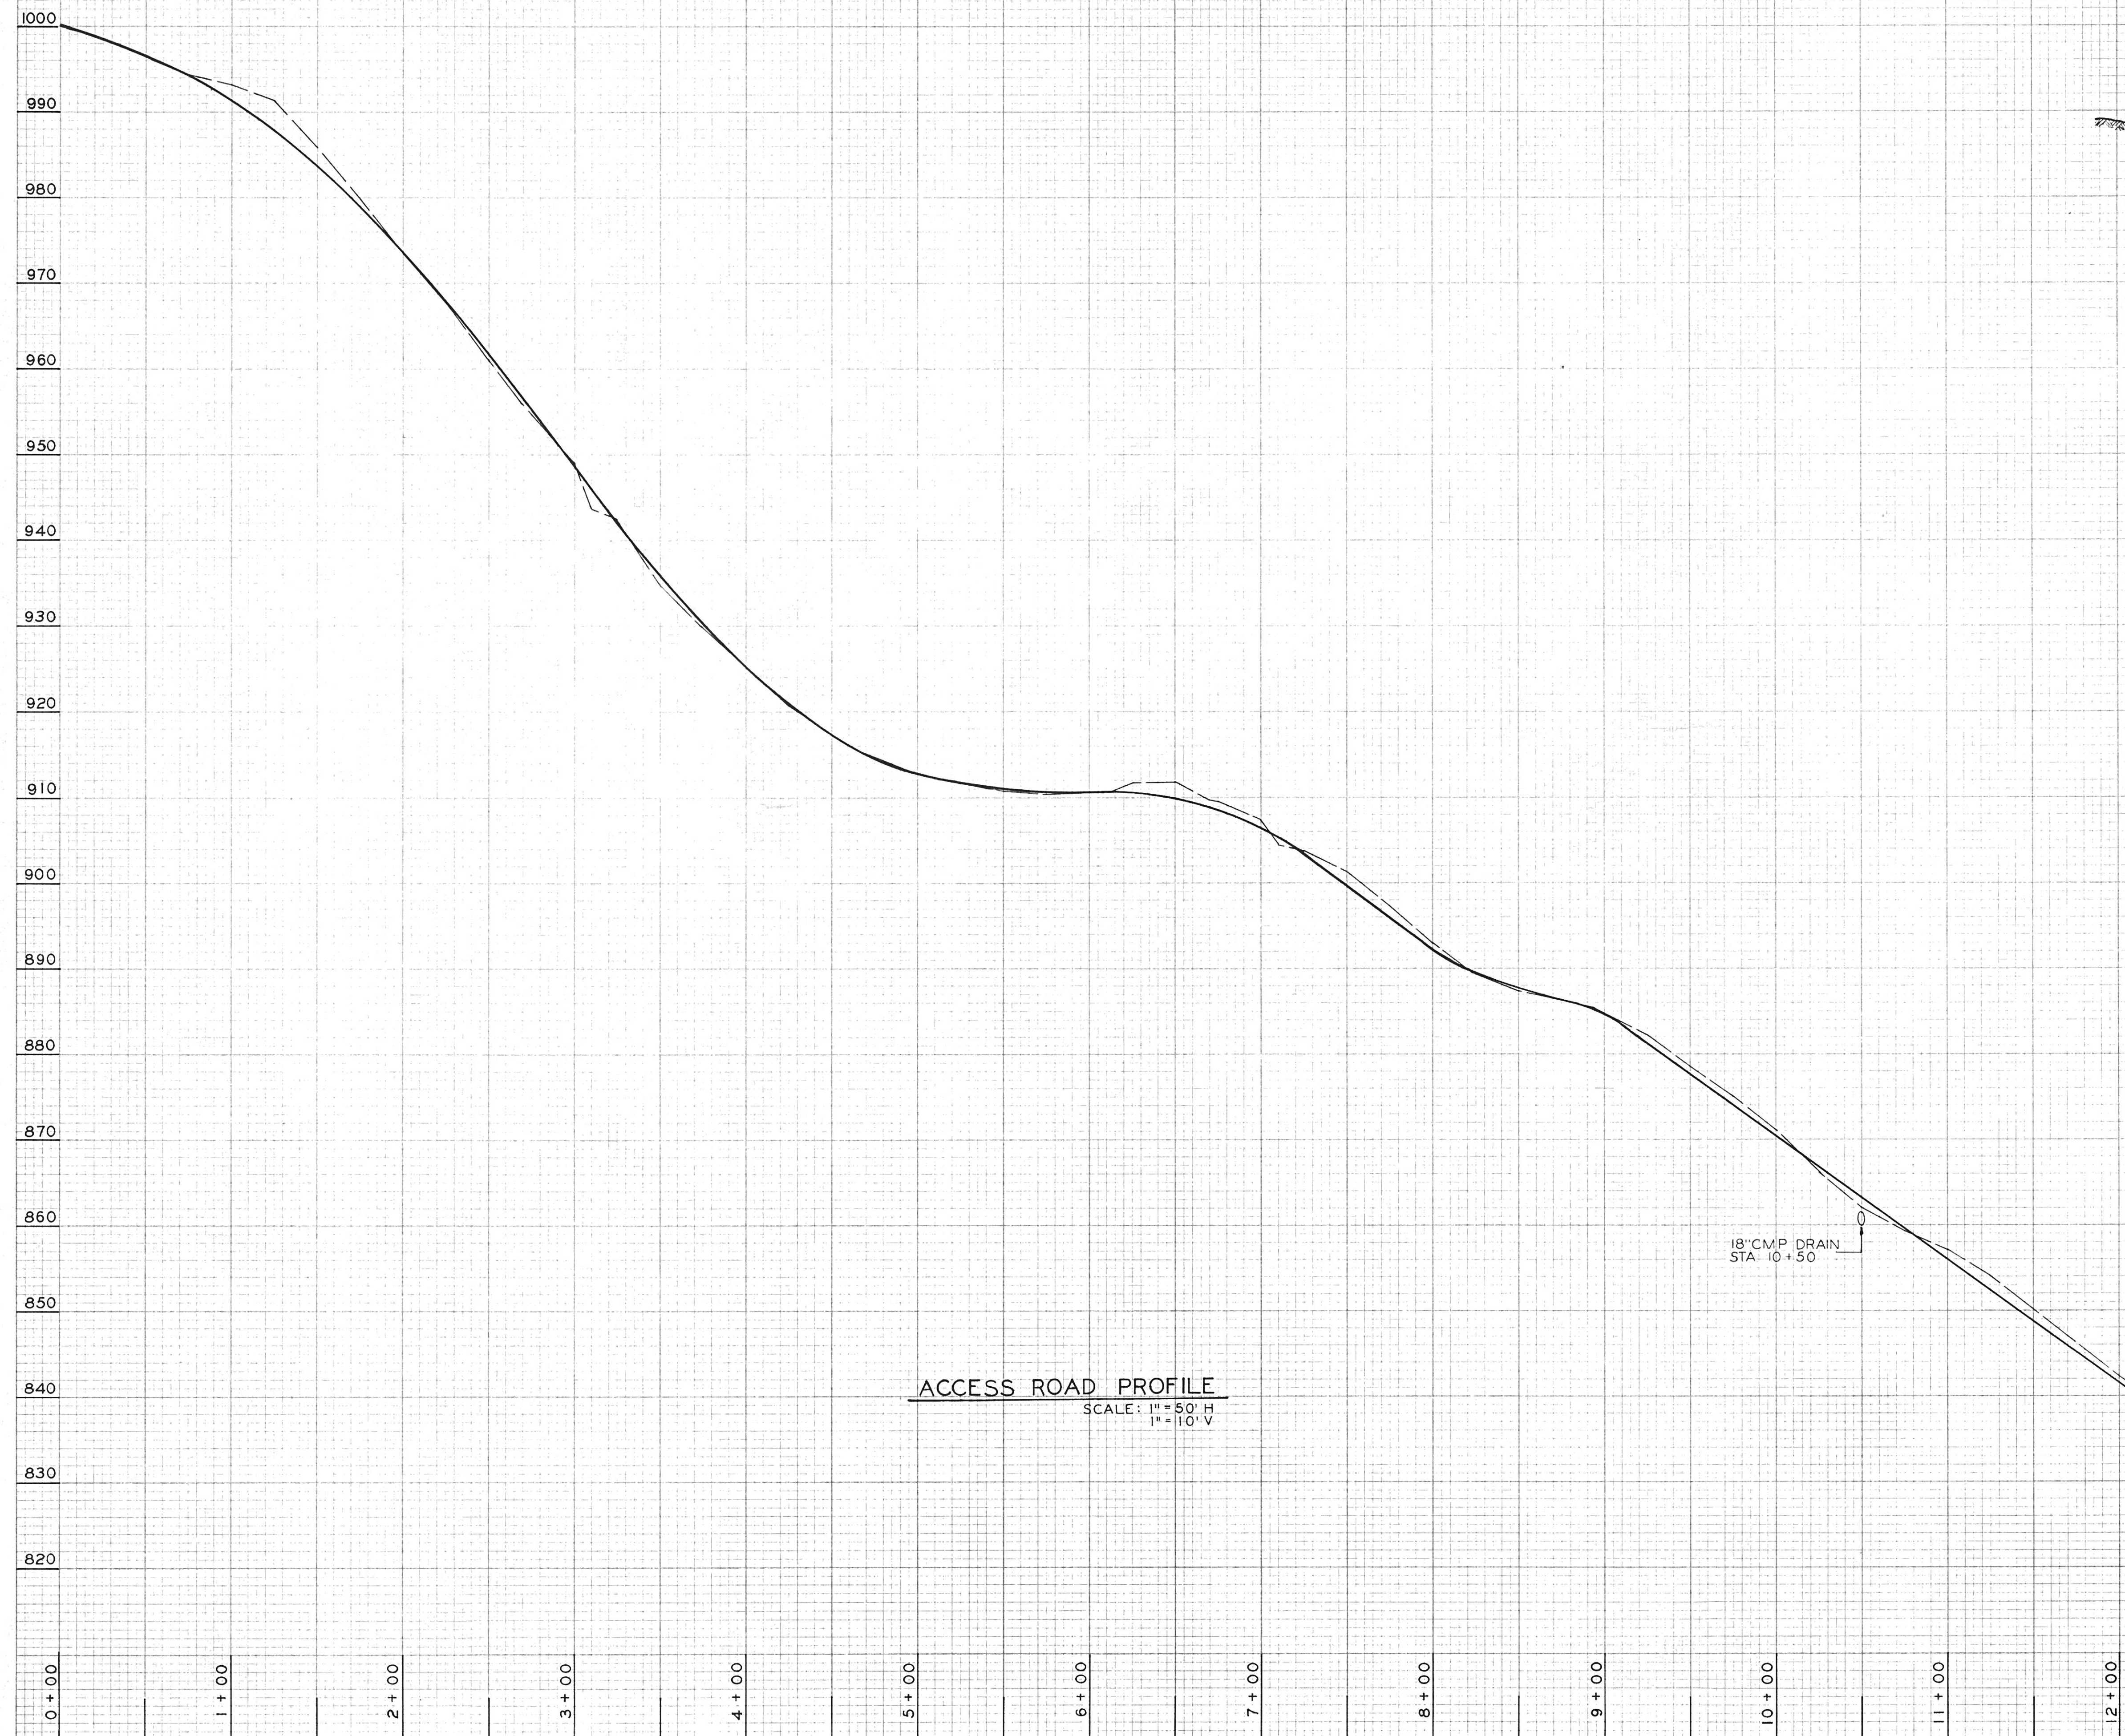

8		KELLEY, GIDLEY, BLAIR & WOLFE, INC.							
7		CONSULTING ENGINEERS							
		CHARLESTON, WEST VIRGINIA							
6		CITY OF ST. ALBANS							
5		KANAWHA COUNTY			WEST VIRGINIA				
4		TANK ACCESS ROAD PROFILE							
3									
2									
1		DRAWN	JRS	CHECKED	DAW	PROJECT	93 400	DATE	NOV. 1982
NO.	DATE	DRAWN		APPROVED	HRC	DRAWING NO.			
REVISIONS		DRAWN		SCALE	AS NOTED				
						93408			