




PIPE SIZE	CRADLE RADIUS
4"	2.40"
6"	3.45"
8"	4.53"
10"	5.56"
12"	6.60"
14"	7.65"
16"	8.70"

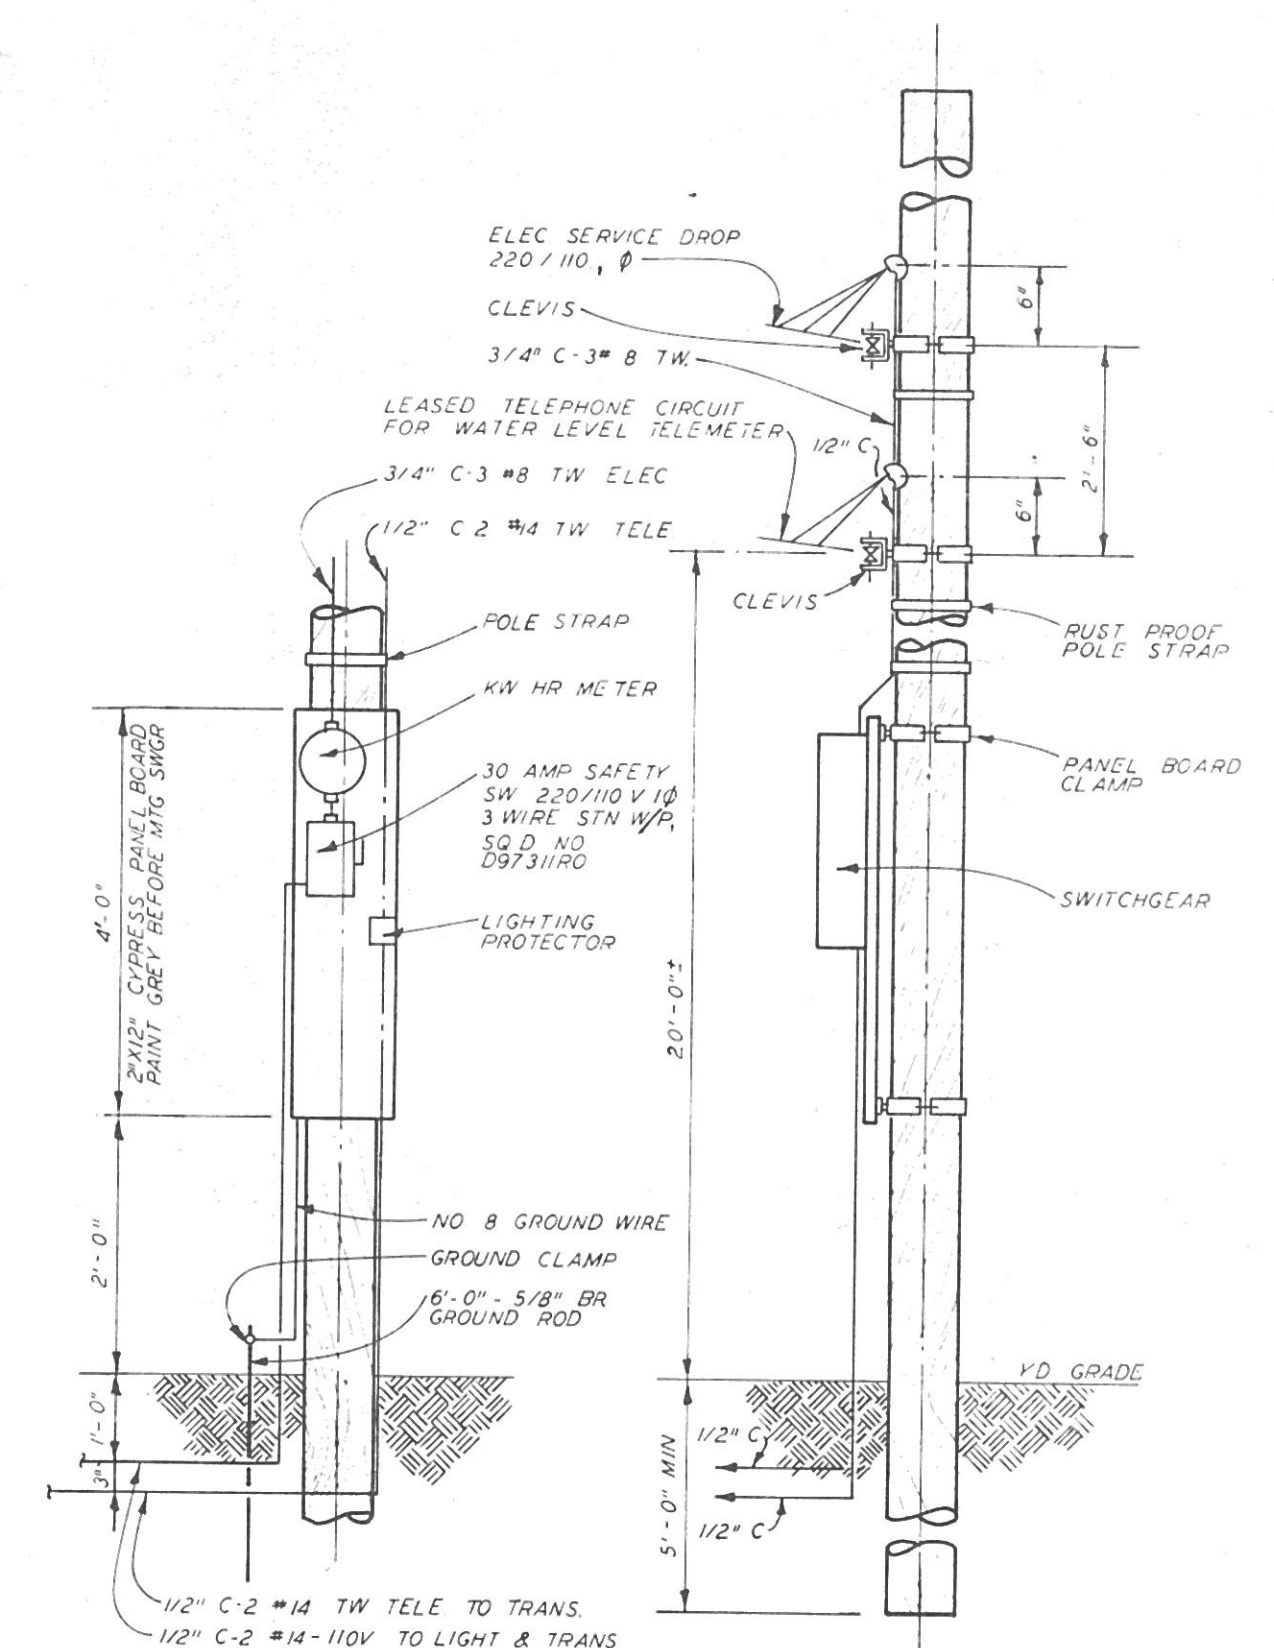

		NO SCALE					
8		KELLEY, GIDLEY, BLAIR & WOLFE, INC. CONSULTING ENGINEERS CHARLESTON, WEST VIRGINIA					
7		CITY OF ST. ALBANS KANAWHA COUNTY WEST VIRGINIA MISCELLANEOUS DETAILS					
6							
5							
4							
3							
2							
1		DRAWN	JRS	CHECKED	DAW	PROJECT 93400	DATE NOV 82
NO.	DATE	DRAWN		APPROVED	HRC	DRAWING NO.	
REVISIONS		DRAWN		SCALE AS SHOWN		93409	