


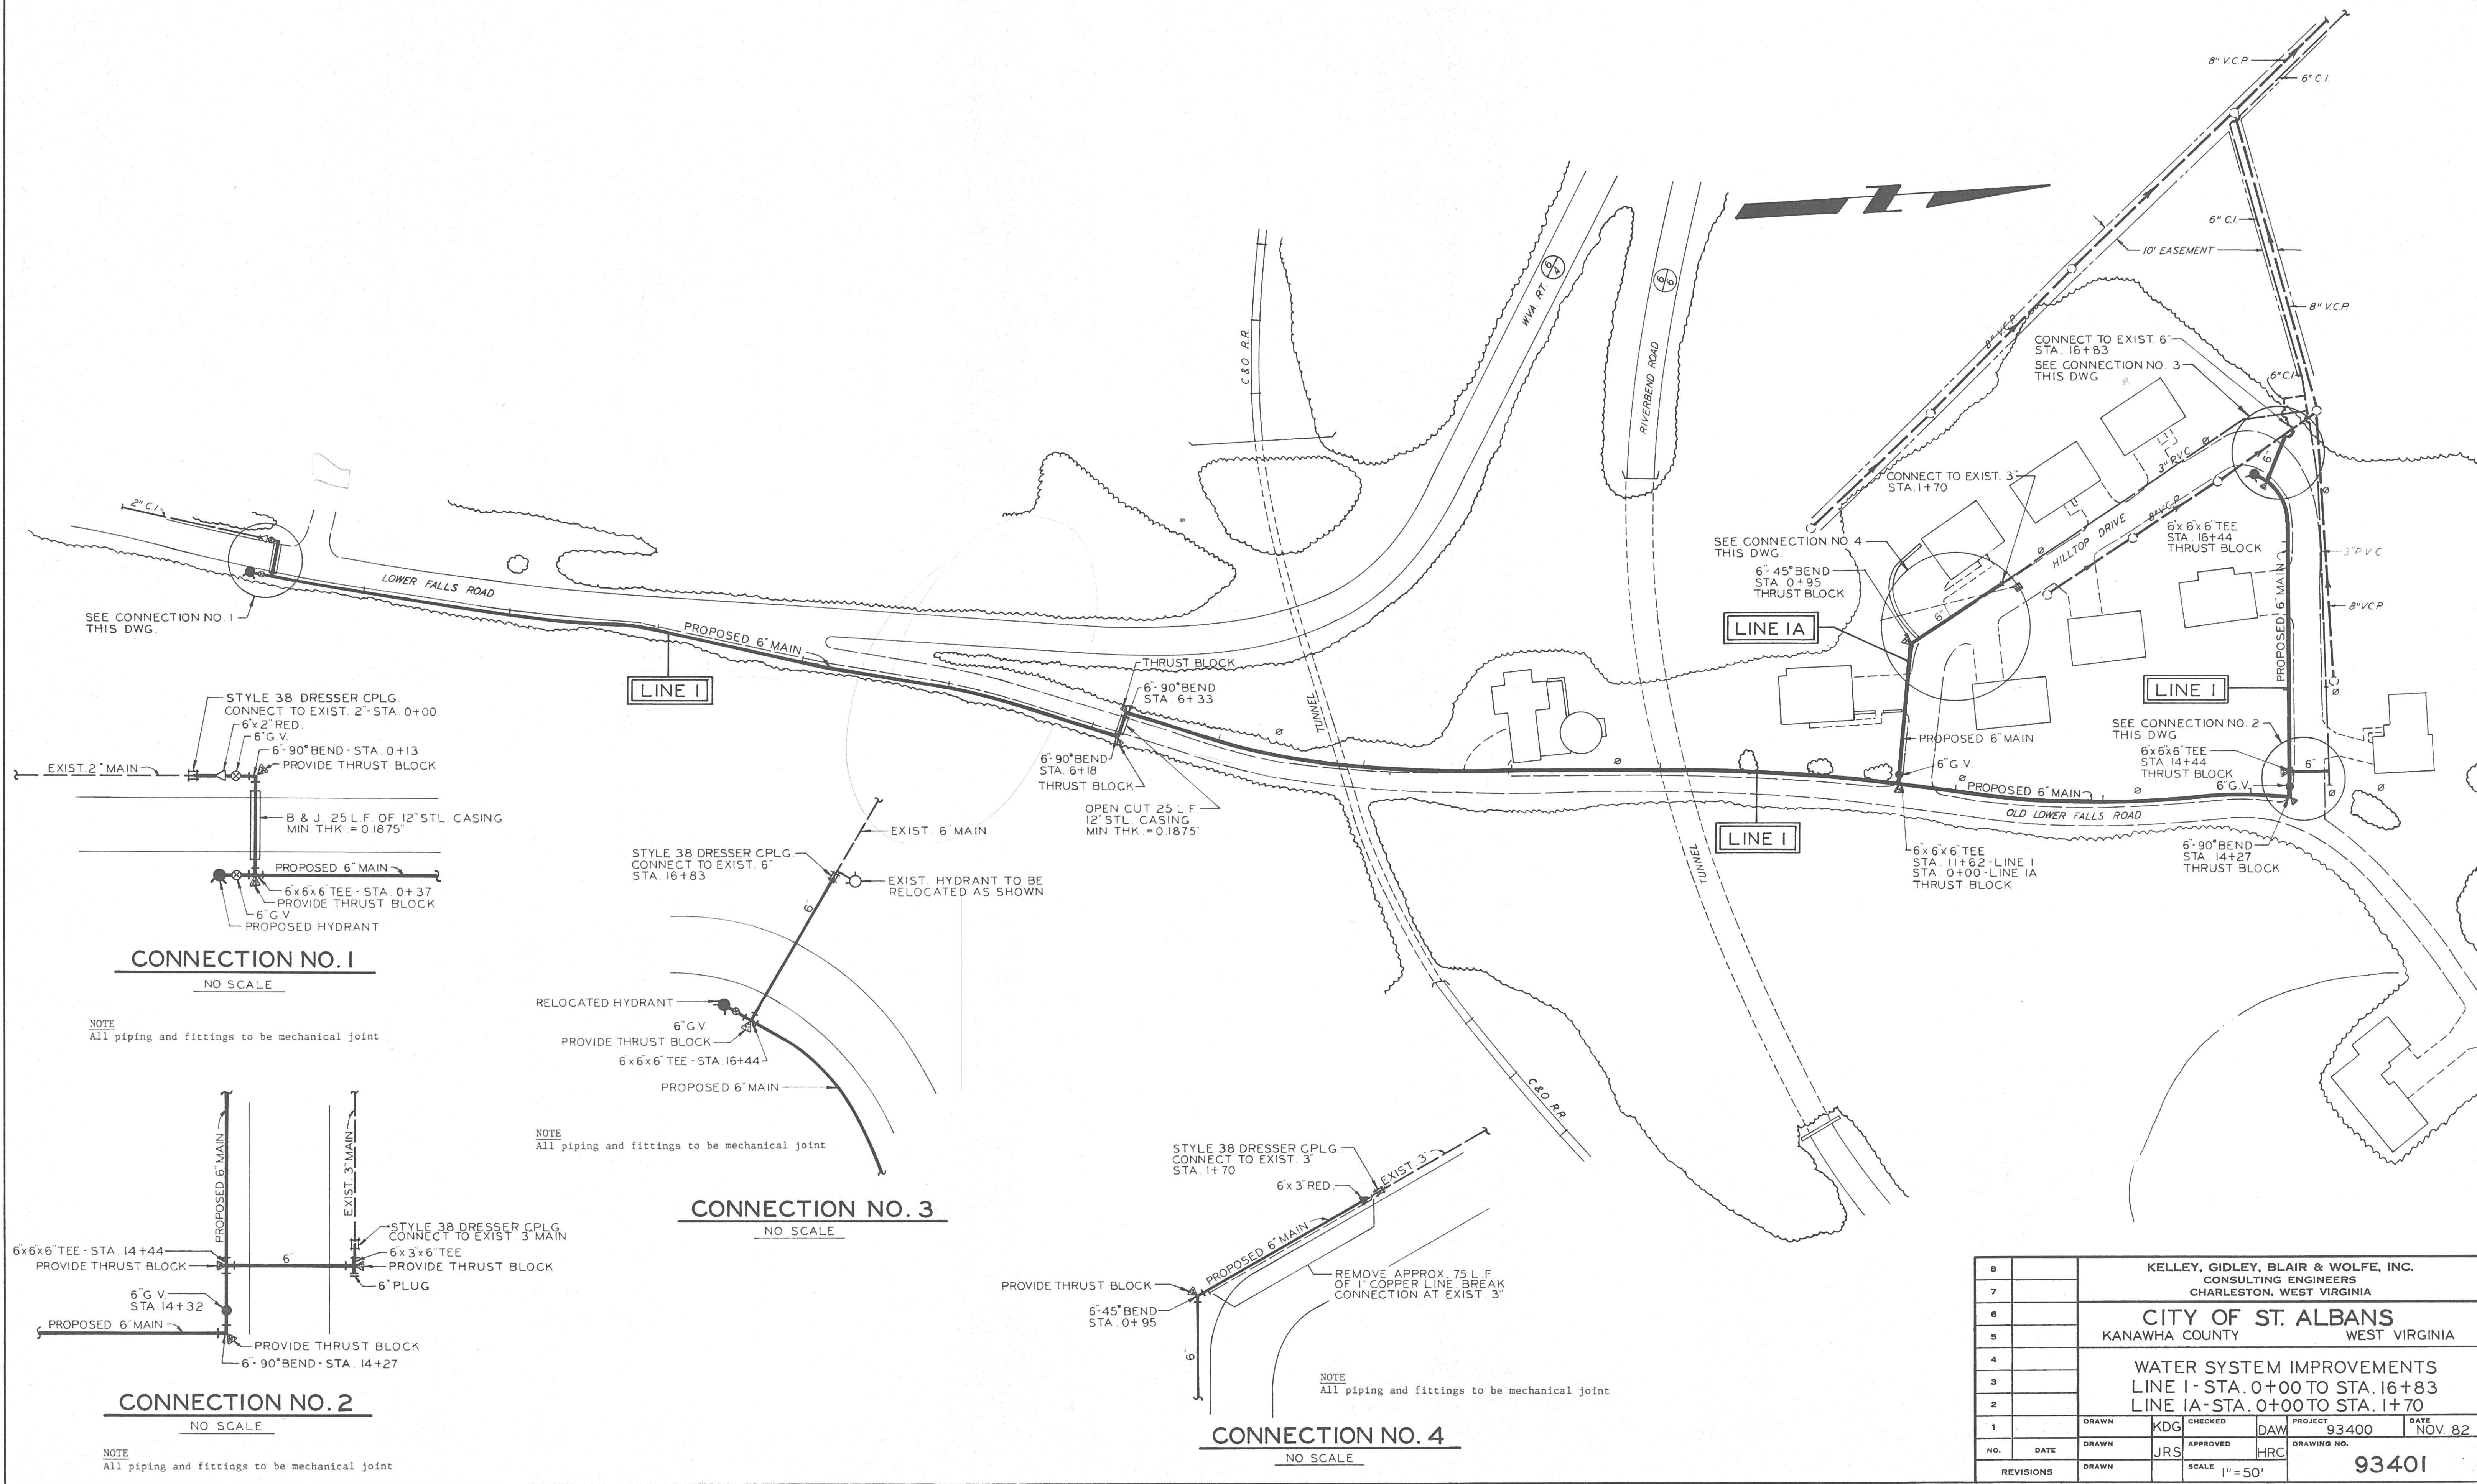

8		KELLEY, GIDLEY, BLAIR & WOLFE, INC. CONSULTING ENGINEERS CHARLESTON, WEST VIRGINIA			
7		CITY OF ST. ALBANS KANAWHA COUNTY WEST VIRGINIA			
6		WATER SYSTEM IMPROVEMENTS LINE 1 - STA. 0+00 TO STA. 16+83 LINE 1A - STA. 0+00 TO STA. 1+70			
5		DRAWN	KDG	CHECKED	DAW
4		PROJECT	93400	DATE	NOV 82
3		DRAWN	JRS	APPROVED	HRC
2		DRAWING NO.	93401		
1		REVISIONS	DRAWN	SCALE	1" = 50'