
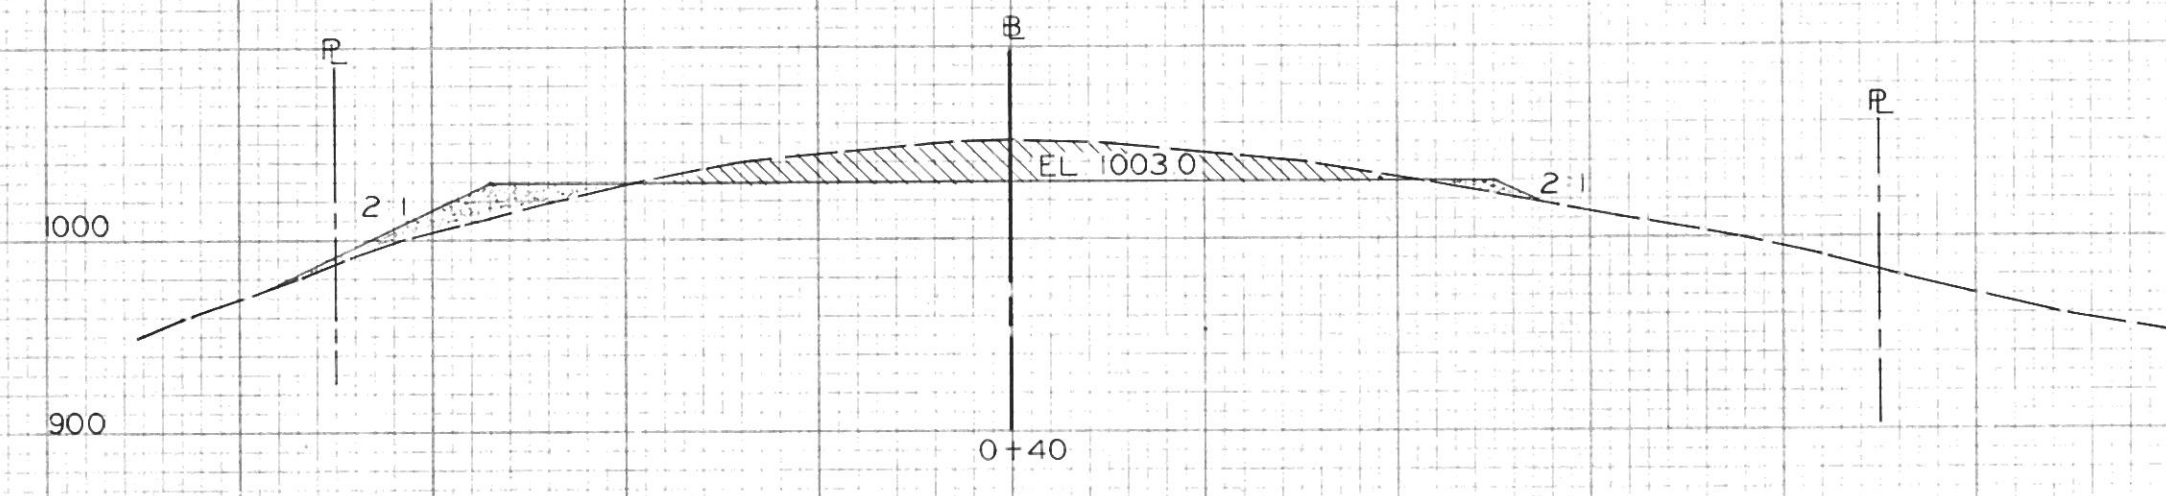
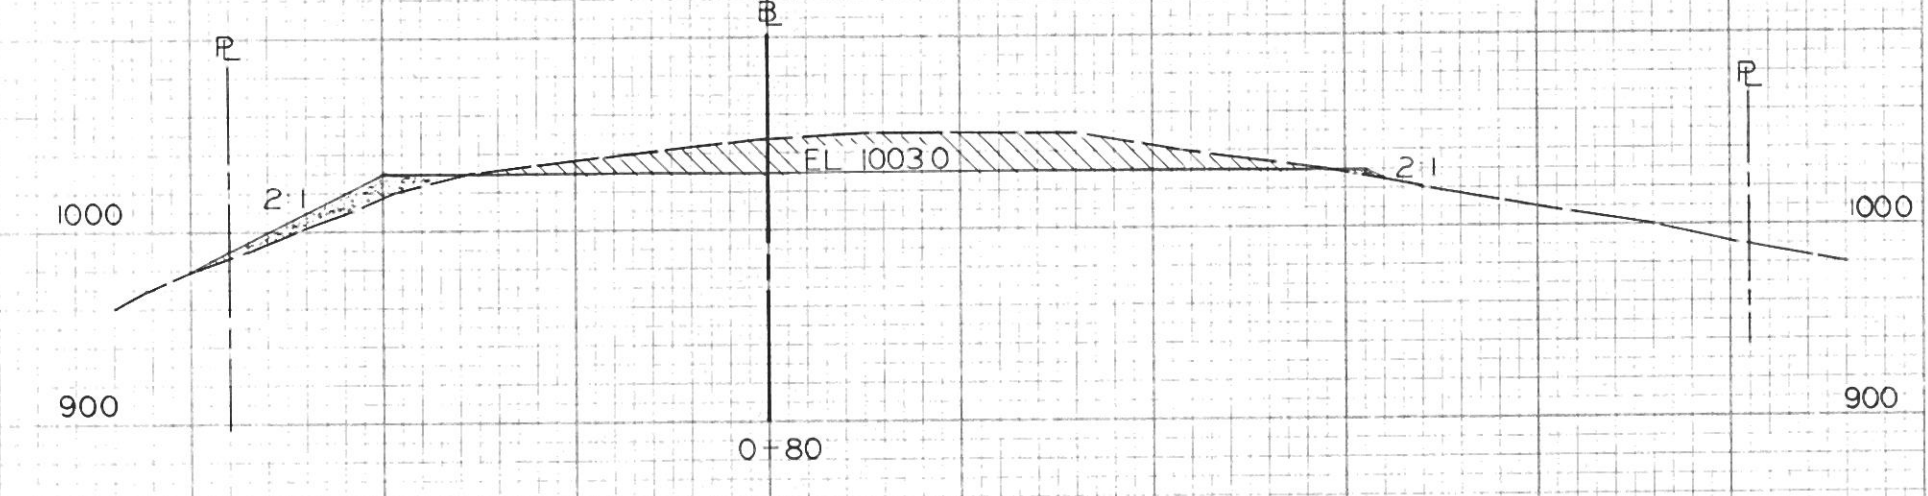
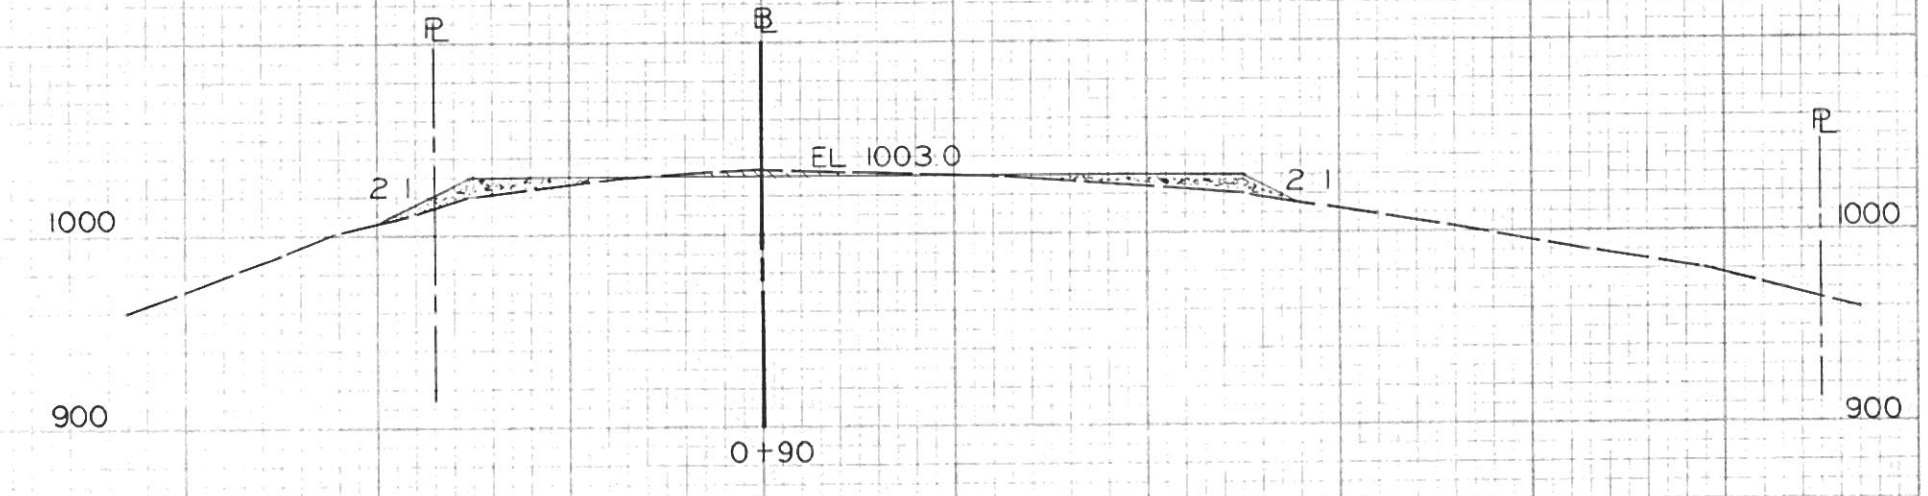


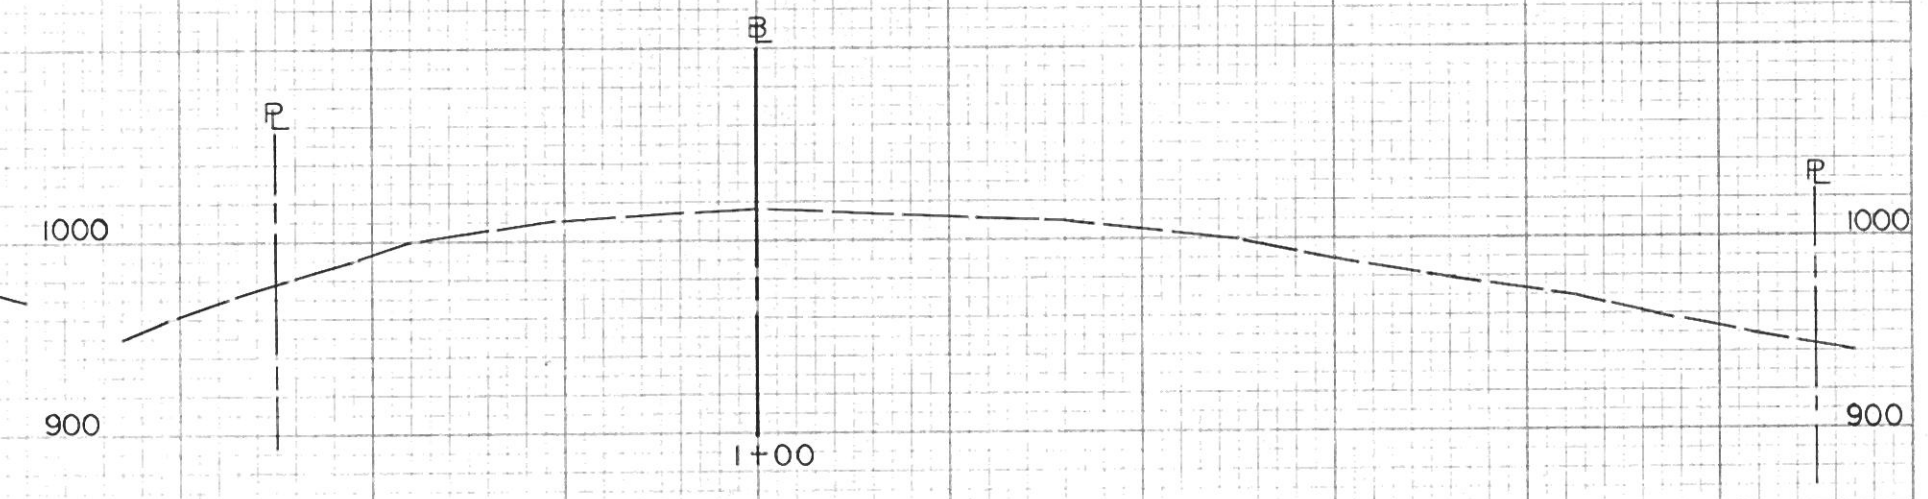

93407