
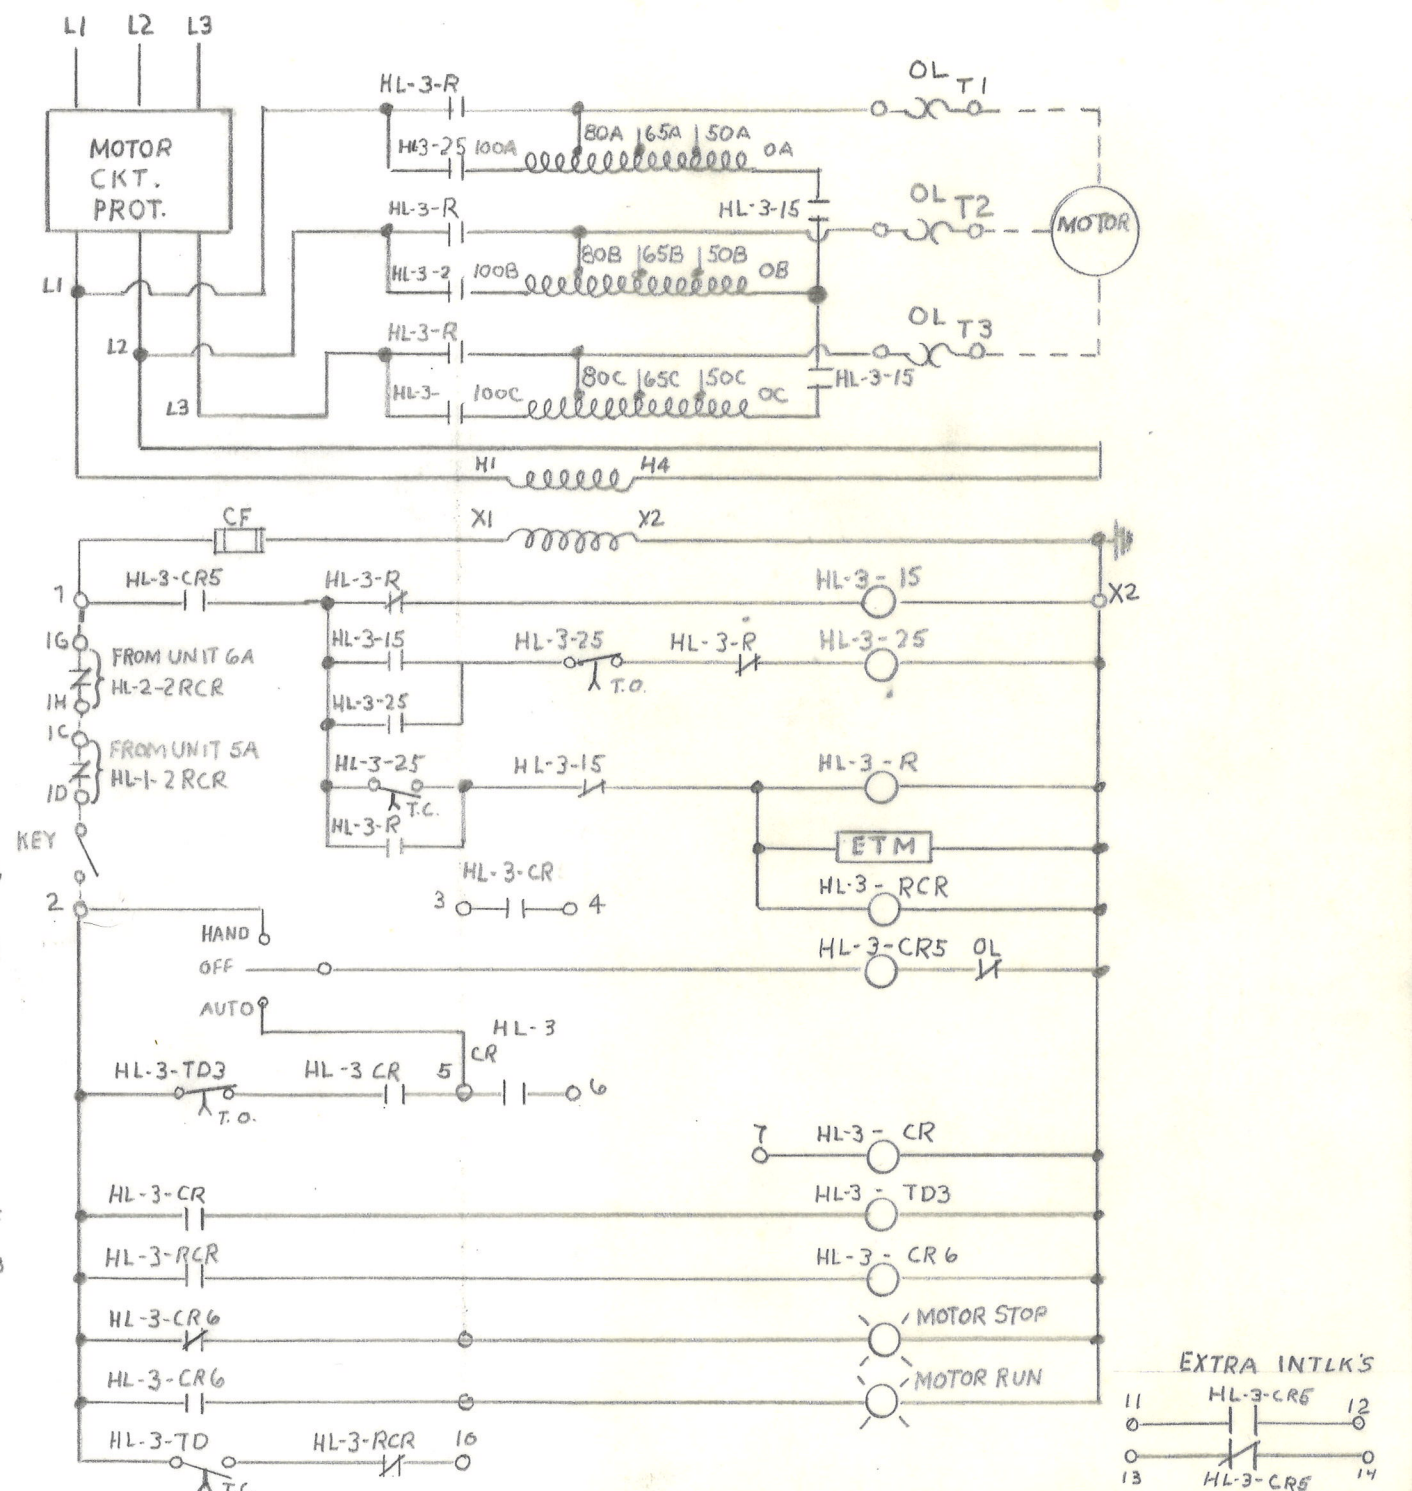


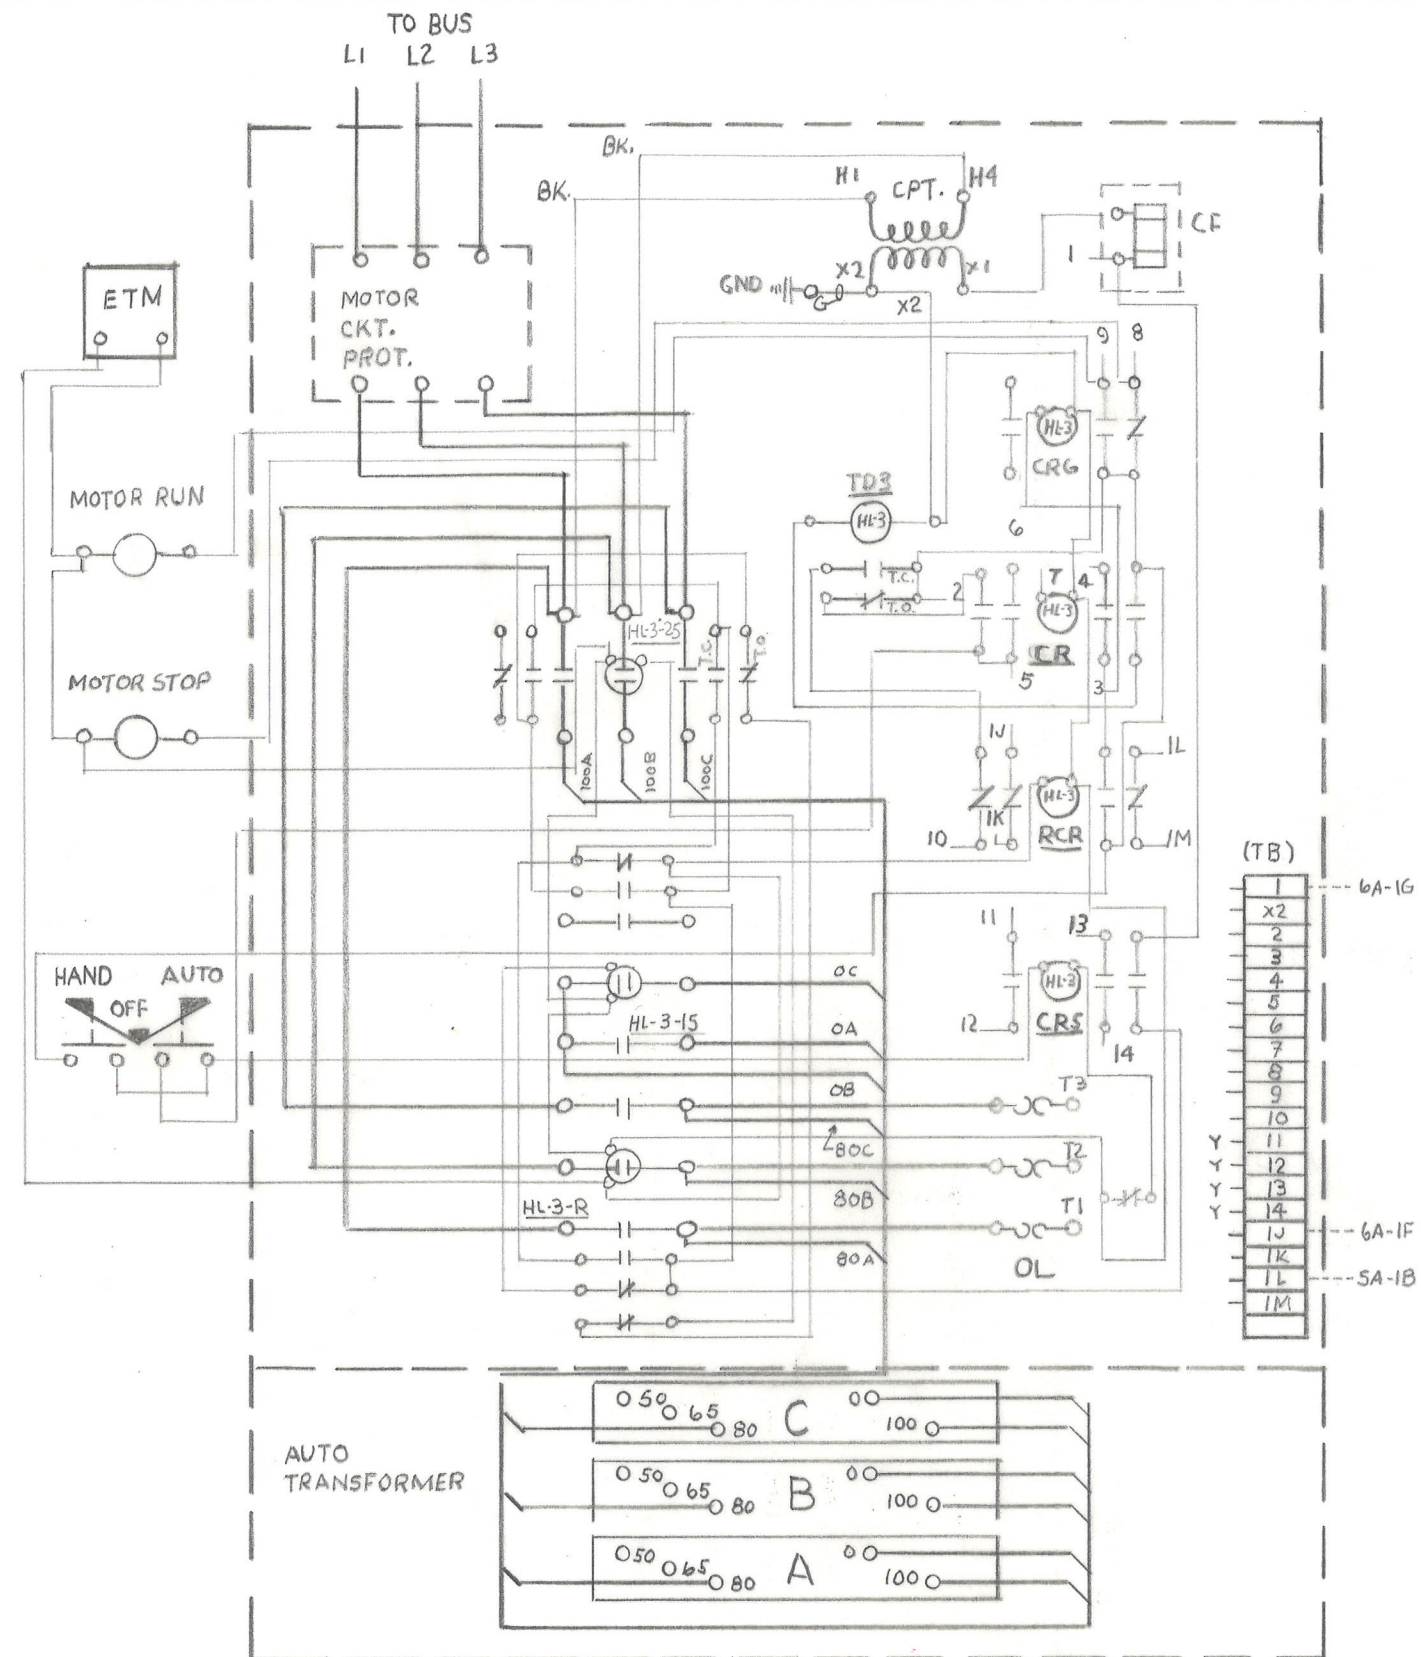

CONNECTIONS FOR UNITROL UNIT 7A HL-3

SCALE: NONE

DATE: 11-7-82

APPROVED BY

DRAWN BY :

DON LANE

DRAWING NUMBER

DRAWING NUMBER
621836 D4 93