


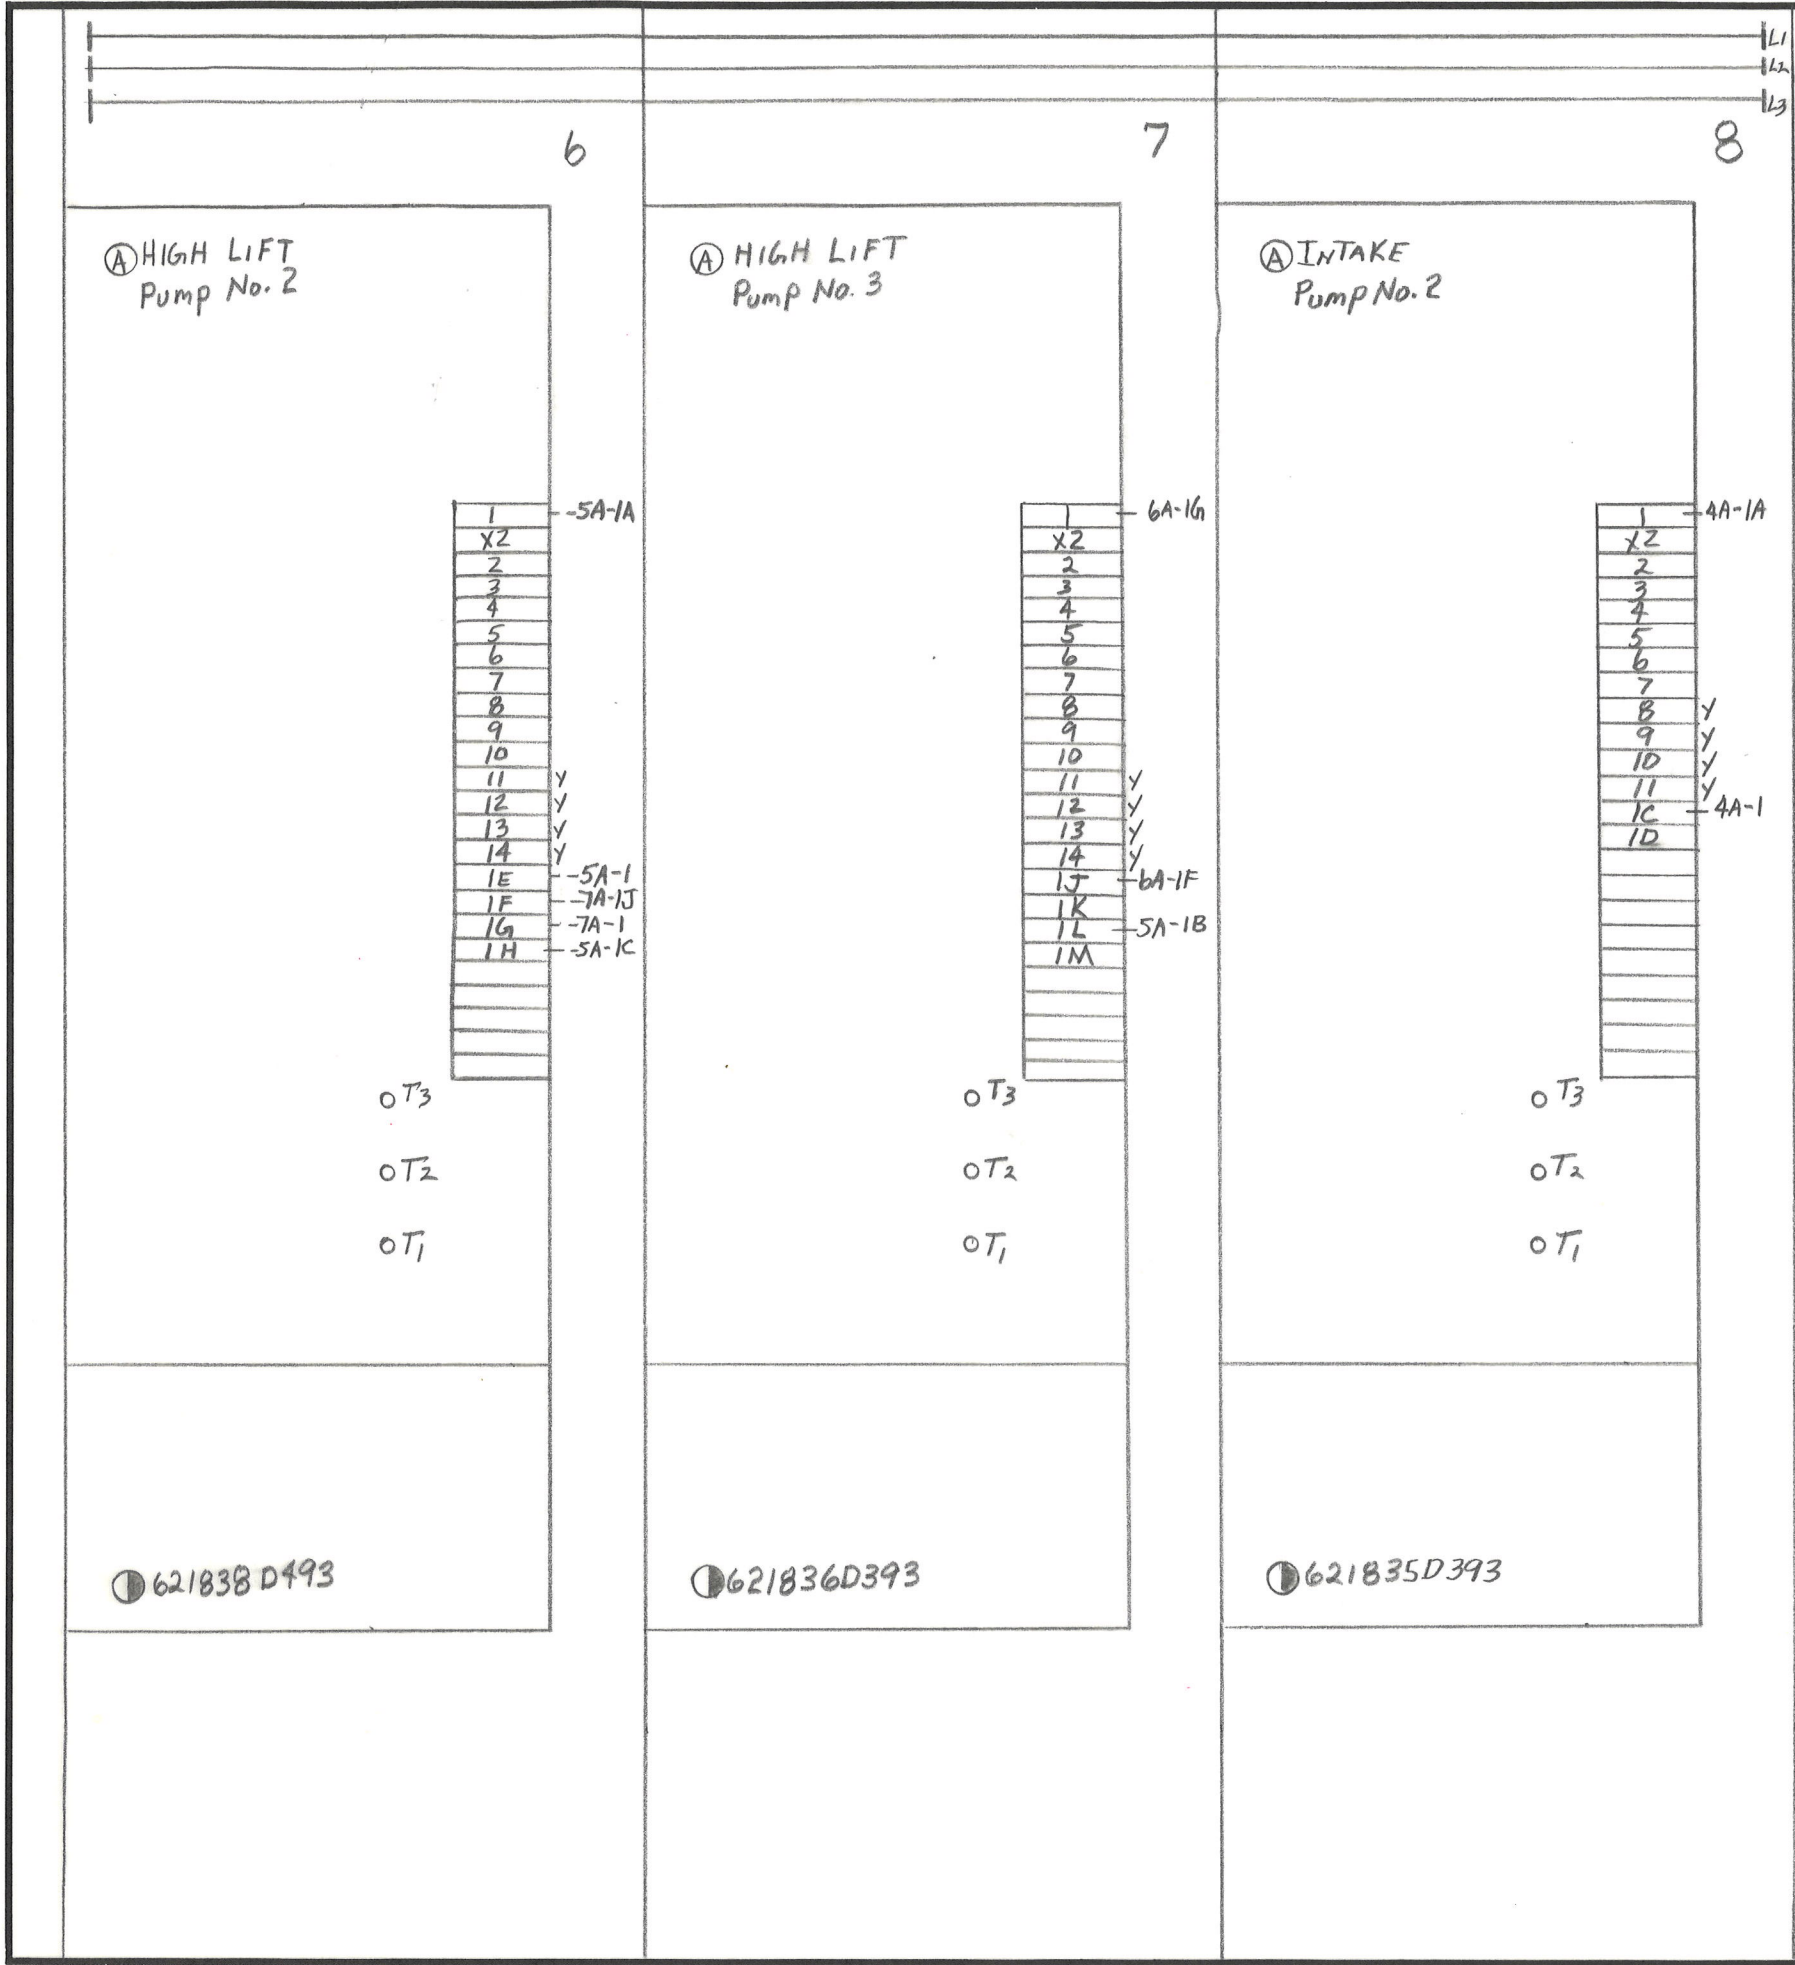

TOLERANCES (EXCEPT AS NOTED)	REVISIONS					
	NO.	DATE	BY			
DECIMAL	1					
±	2					
FRACTIONAL	3			DRAWN BY BISHOP	SCALE	MATERIAL
±	4			CHK'D	DATE 10/29	DRAWING NO.
ANGULAR	5			TRACED	APP'D	2 OF 9
±						