

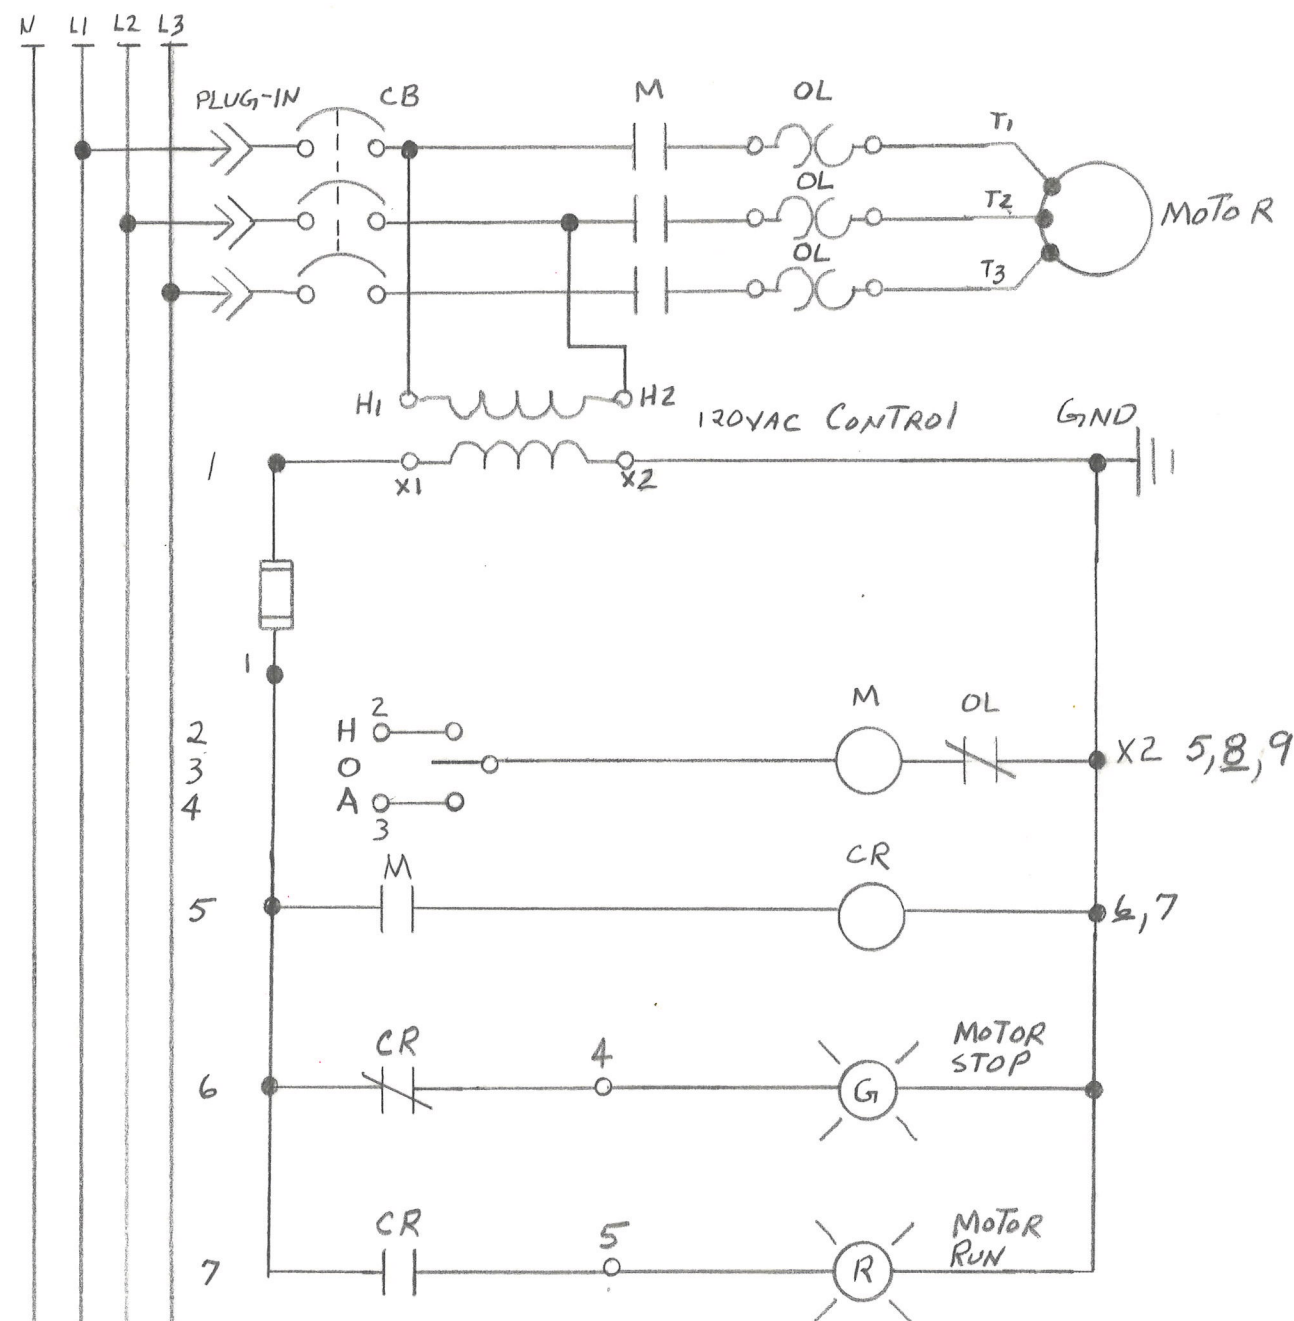


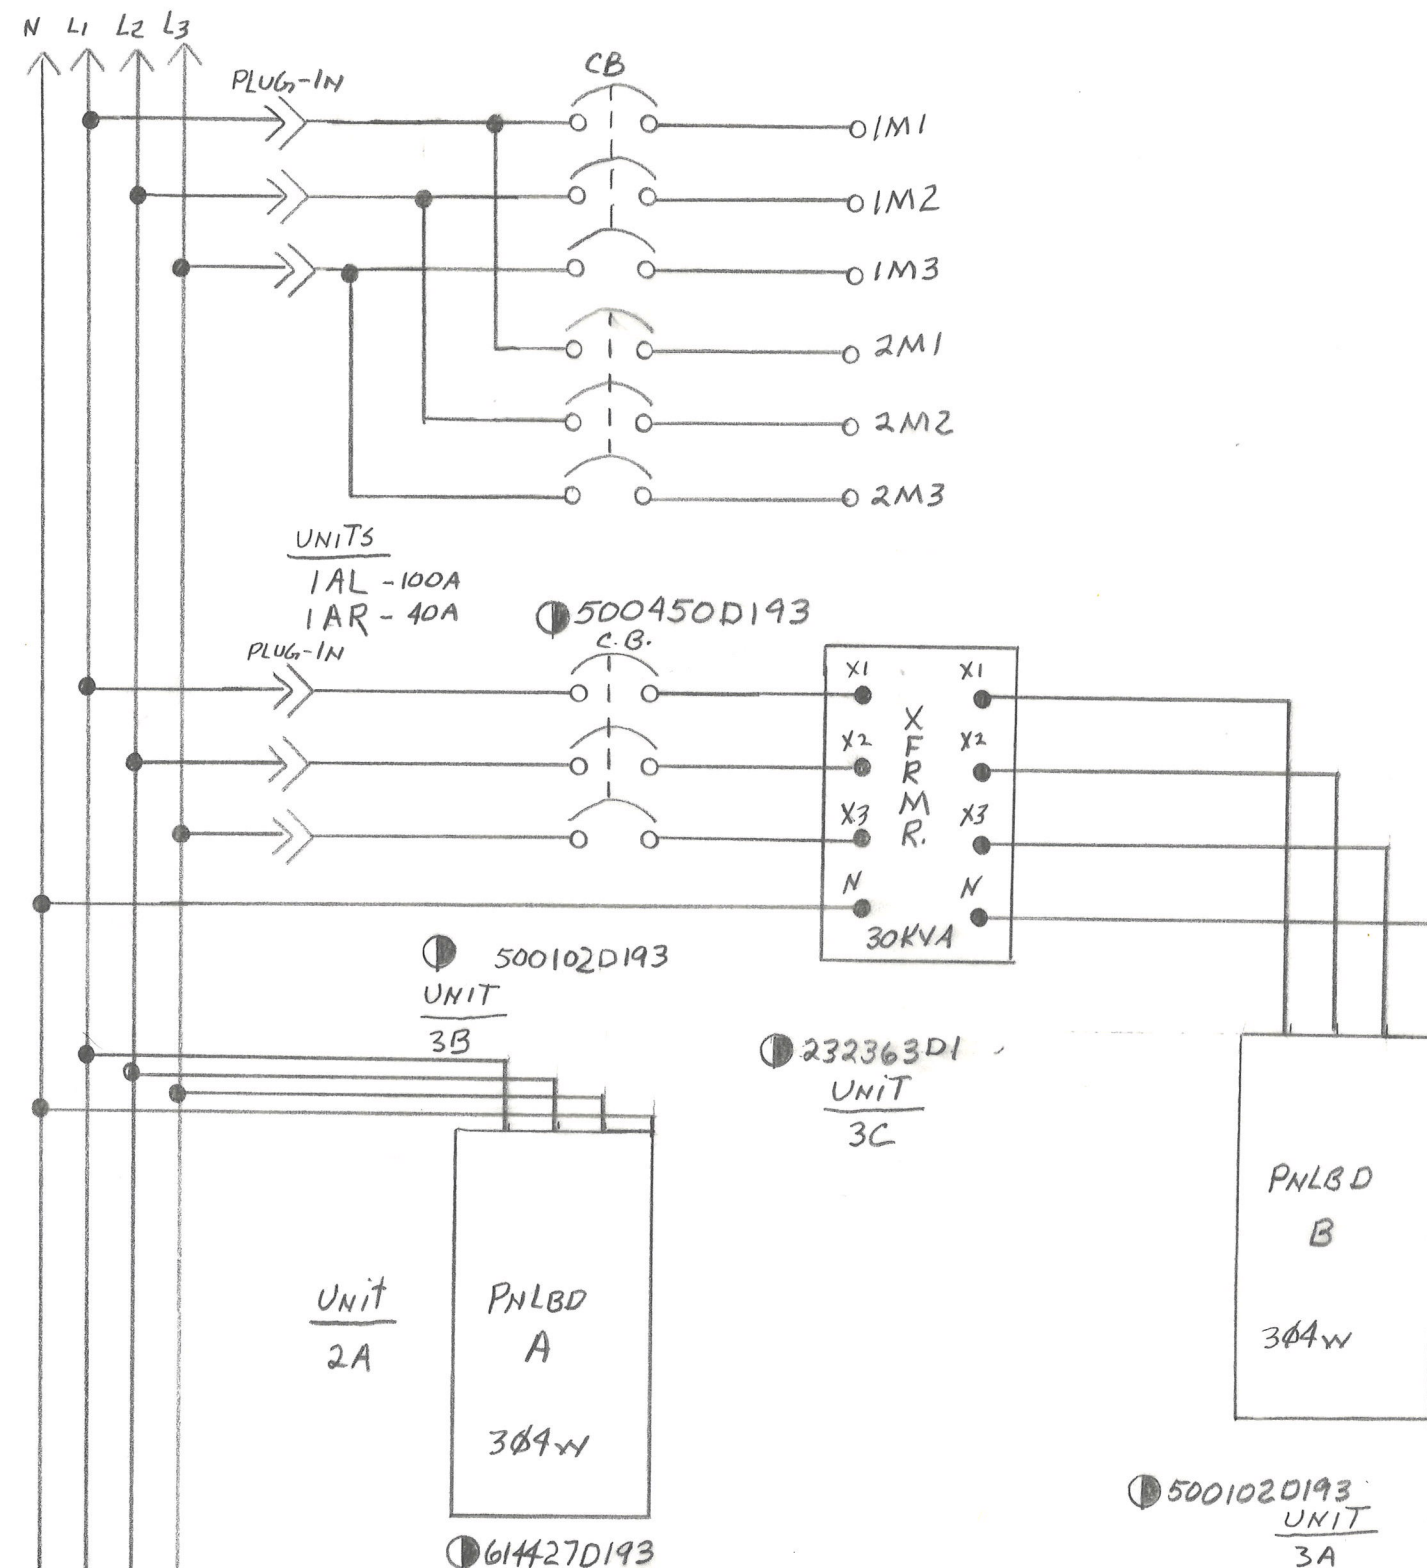

TYPICAL CONNECTIONS
FOR FVNR STARTERS

UNITS
1B 10A
1C 10B
1D
1E
1F
9A
9B
9C
9D
9E
9F

623553D193

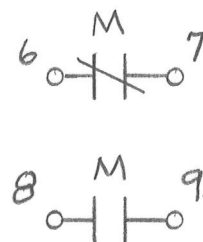

TOLERANCES (EXCEPT AS NOTED)	REVISIONS			DRAWN BY BISHOP	SCALE	MATERIAL
	NO.	DATE	BY			
DECIMAL	1					
±	2					
FRACTIONAL	3					
±	4					
ANGULAR	5					
±						

DATE 11/30/82
APP'D
DRAWING NO. 4 of 9