


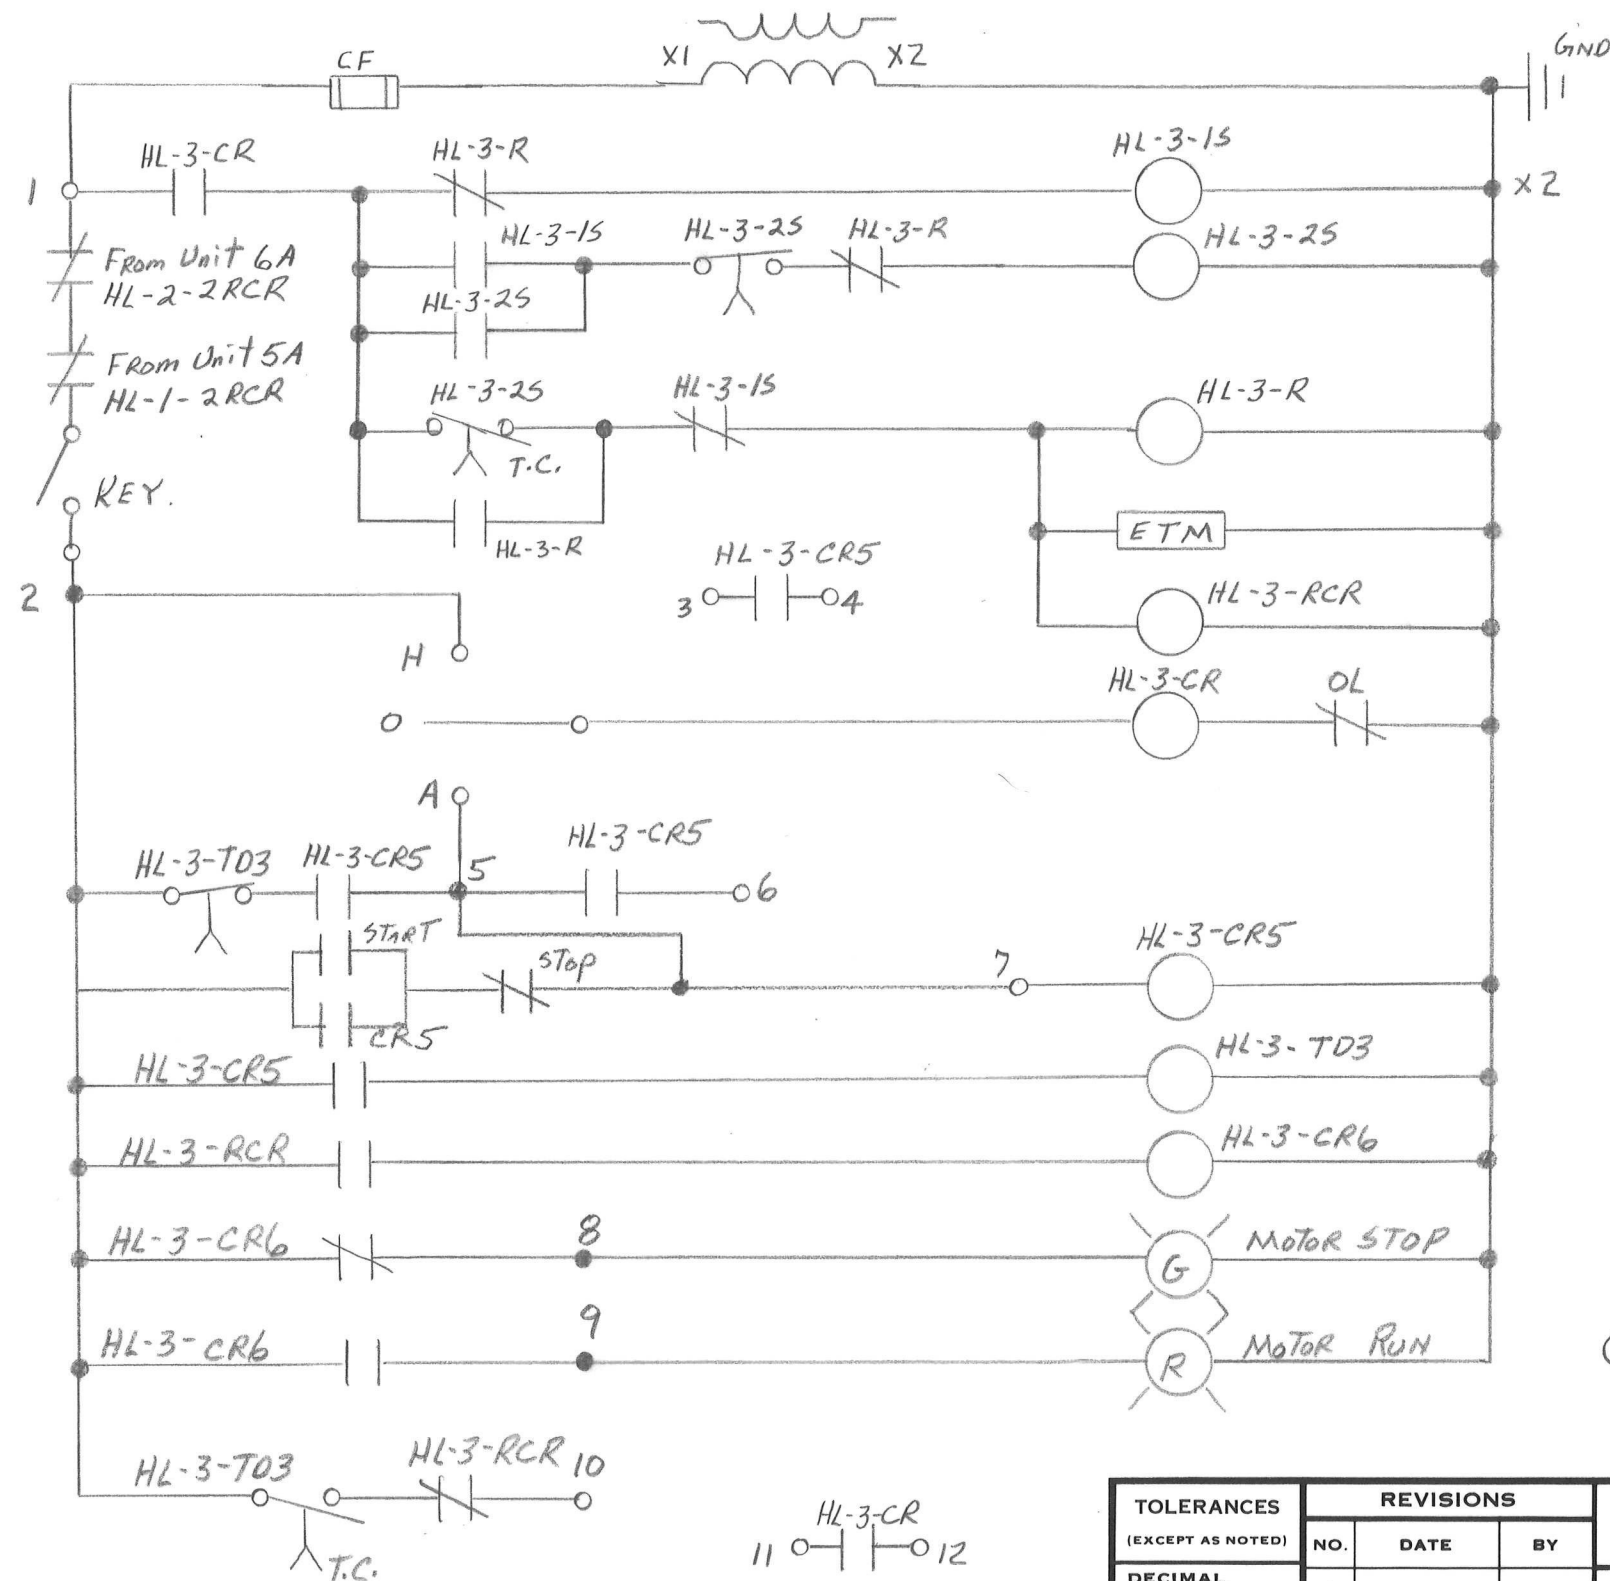

621836D393
Unit
7A

TOLERANCES (EXCEPT AS NOTED)	REVISIONS			DRAWN BY BISHOP	SCALE	MATERIAL
	NO.	DATE	BY			
DECIMAL	1					
±	2					
FRACTIONAL	3					
±	4					
ANGULAR	5					
±						
				CHK'D	DATE 11-1-82	DRAWING NO.
				TRACED	APP'D	6 of 9