


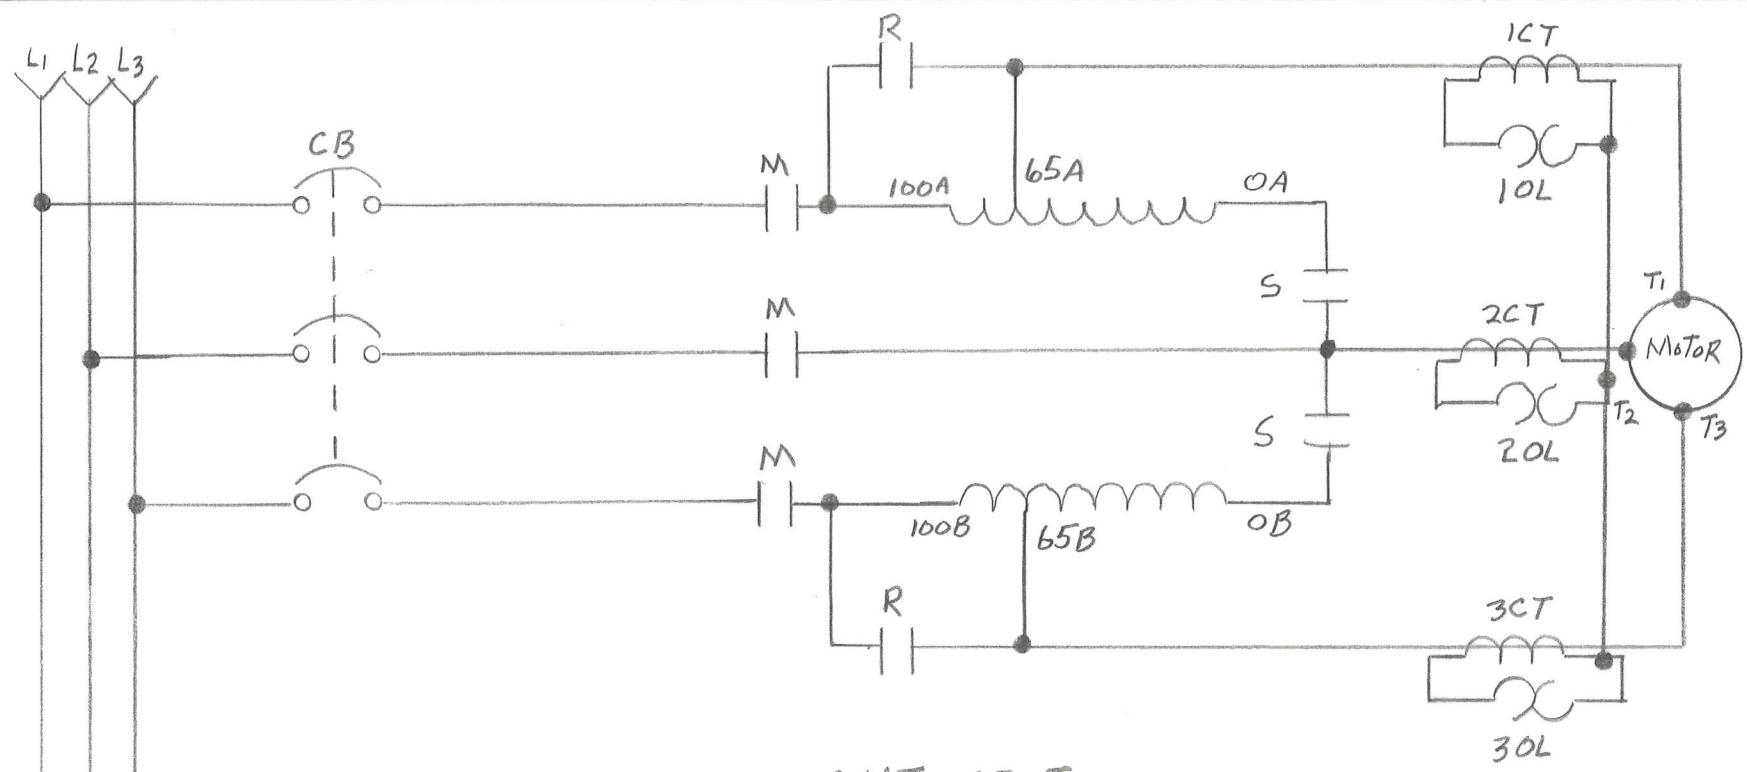

CONTACTORS HL-1-R & HL-1-S ARE
MECHANICALLY INTERLOCKED

TYPICAL CONNECTIONS FOR RVAT STARTERS

UNITS
5A-HL1
6A-HL2

621837D493
621838D493

END

TOLERANCES (EXCEPT AS NOTED)	REVISIONS					
	NO.	DATE	BY			
DECIMAL	1					
±	2					
FRACTIONAL	3			DRAWN BY BISHOP	SCALE	MATERIAL
±	4			CHK'D	DATE 11-1-82	DRAWING NO.
ANGULAR	5			TRACED	APP'D	70F9
±						