


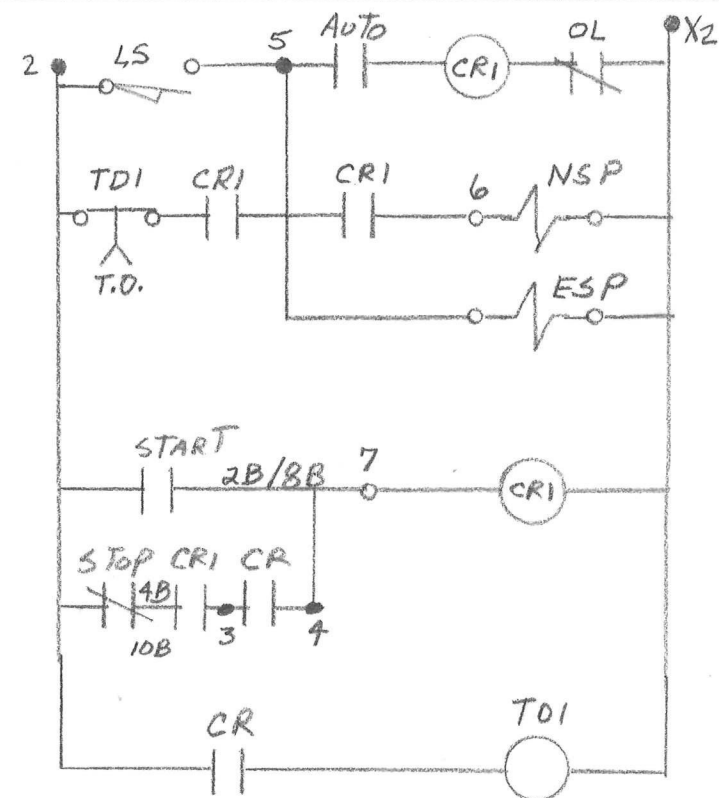

06218370493
06218380493

NATIONAL NO. 185E-11X17