
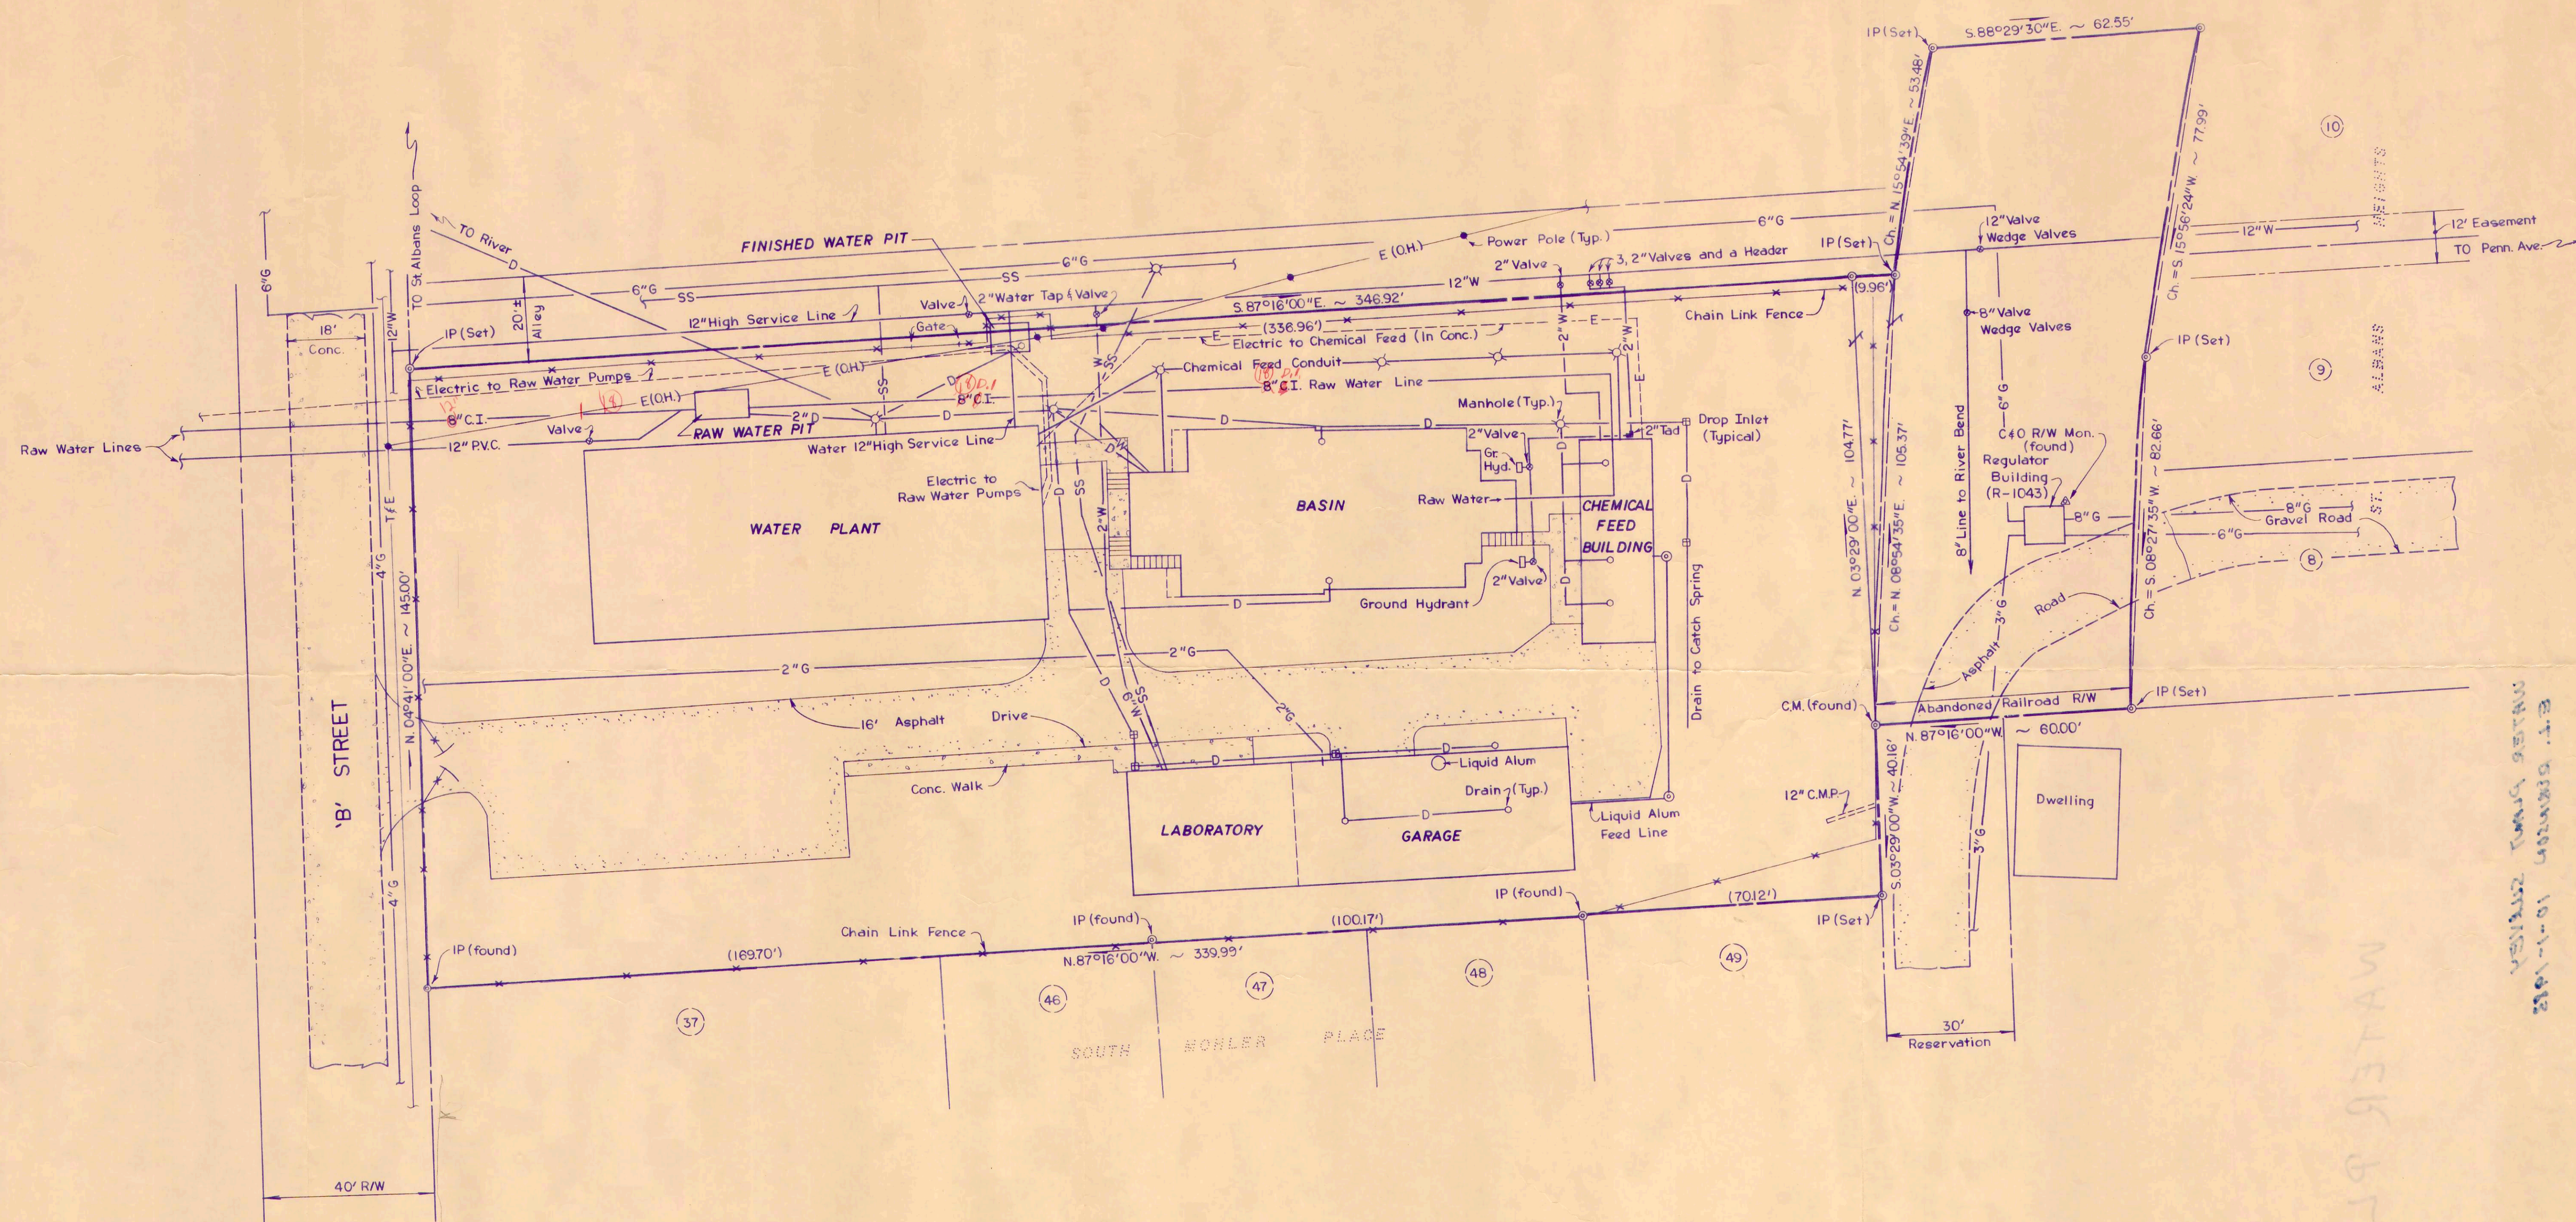


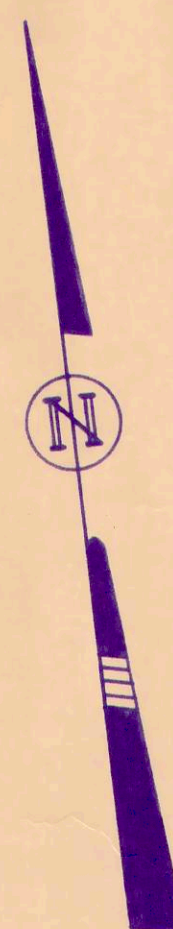


LEGEND

- Power Pole
- ⊕ Manhole
- ⊖ Drop Inlet
- Drain
- SS — Sanitary Sewer
- D — Drainline
- E (OH.) — Overhead Electric
- E — Underground Electric
- G — Gasline
- W — Waterline

MAP SHOWING
A 1.36 ACRE TRACT
OWNED BY
CITY OF SAINT ALBANS
SITUATE
ALONG 'B' STREET
In the City of St. Albans
Kanawha County, West Virginia
Surveyed By ~
E.L. ROBINSON ENGINEERING

E.L. Robinson R.P.E. No. 6918

Scale: 1"=20' Date: Oct. 1, 1983

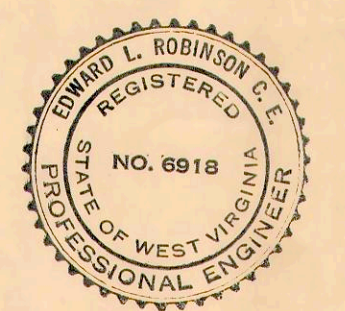

VERIFIED TRUE & SET
10-1-1983
2:00 PM