



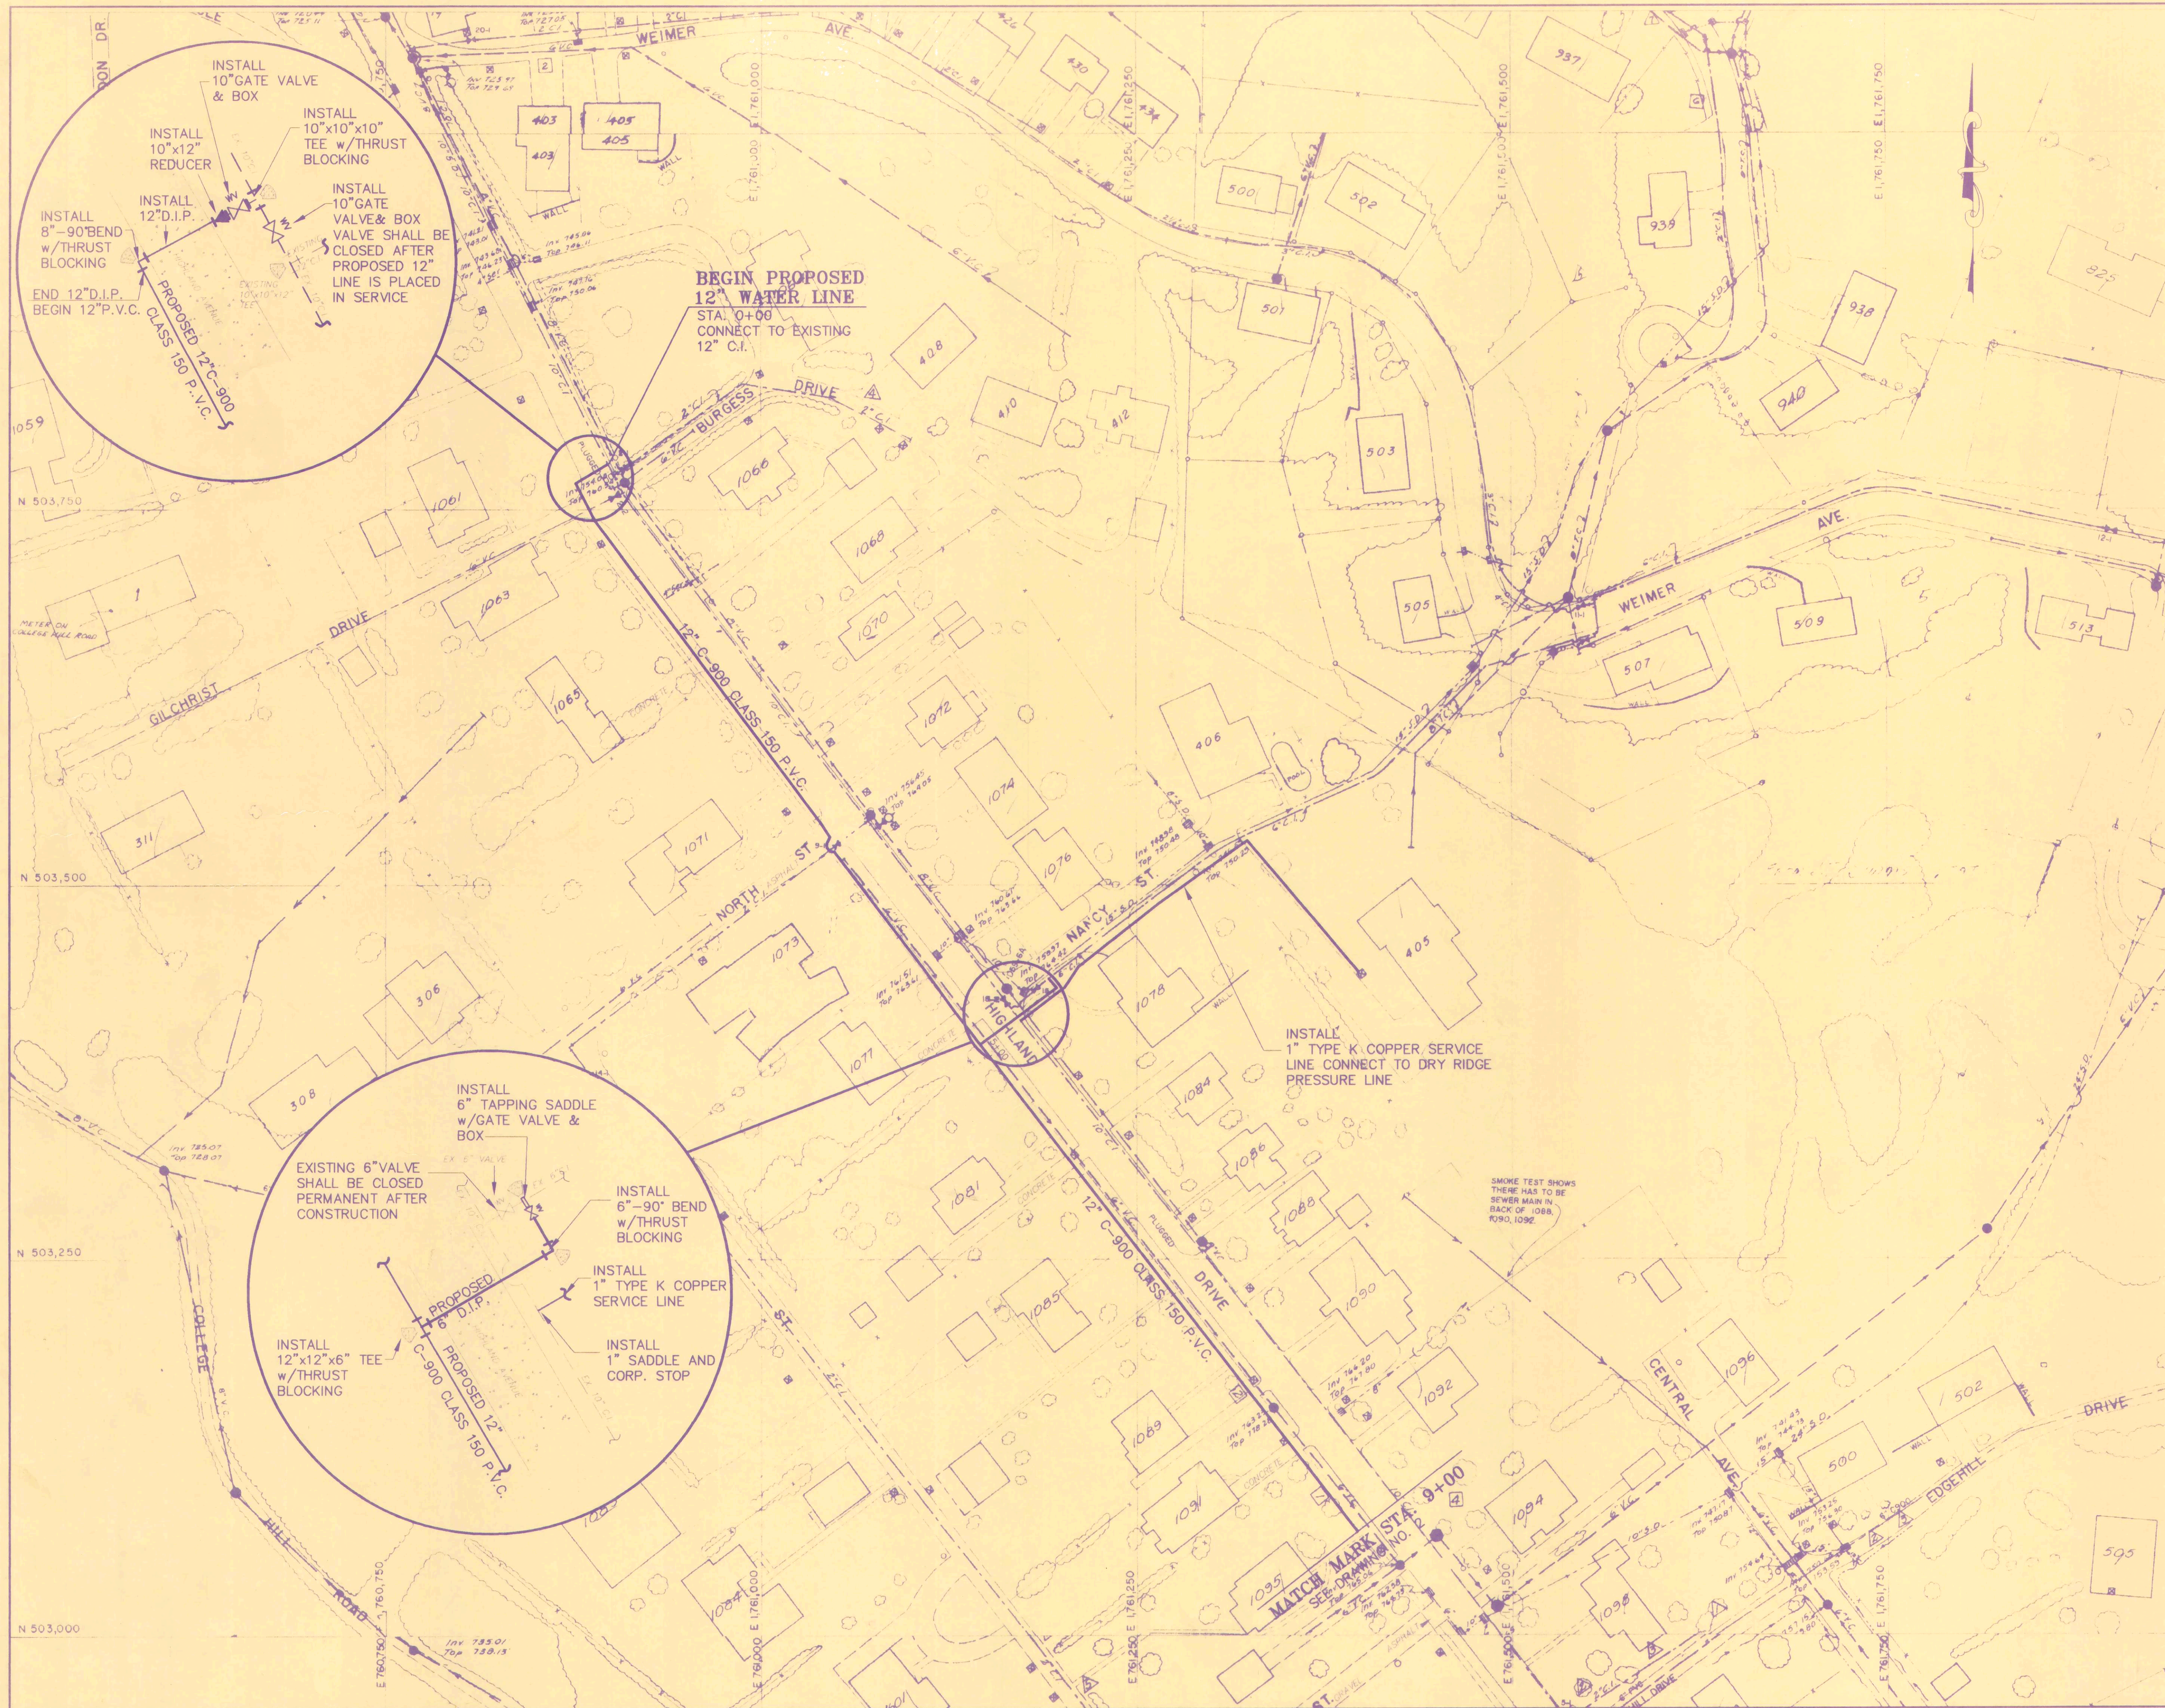

DRAWING INDEX
SCALE N.T.S.

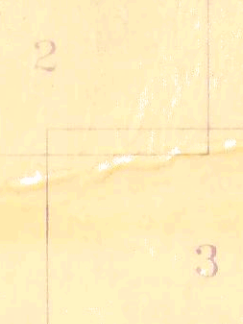

NOTE:
WHERE PROPOSED WATER LINE PARALLELS EXISTING
SEWER A MINIMUM SEPARATION BETWEEN POTABLE
WATER AND SANITARY SEWER OF 10' HORIZONTAL
OR 18" VERTICAL MUST BE KEPT.

REVISIONS		
NO.	DATE	DESCRIPTION
CITY OF ST. ALBANS MUNICIPAL UTILITY COMMISSION		
HIGHLAND DRIVE PRESSURE GRADIENT MODIFICATIONS		
DRAWN BY DP/JER		CHECKED BY F.W.I.
SCALE: 1" = 50'		DATE: AUGUST 1997
DUNN ENGINEERS, INC.		DRAWING 9631
701 VIRGINIA ST. #551 CHARLESTON, W.V. 25302		1

College Hill Tank PRV 12" C900