
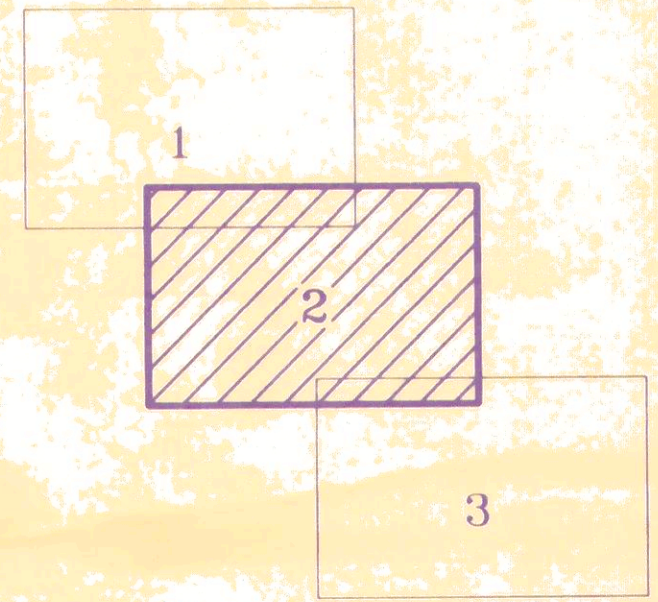


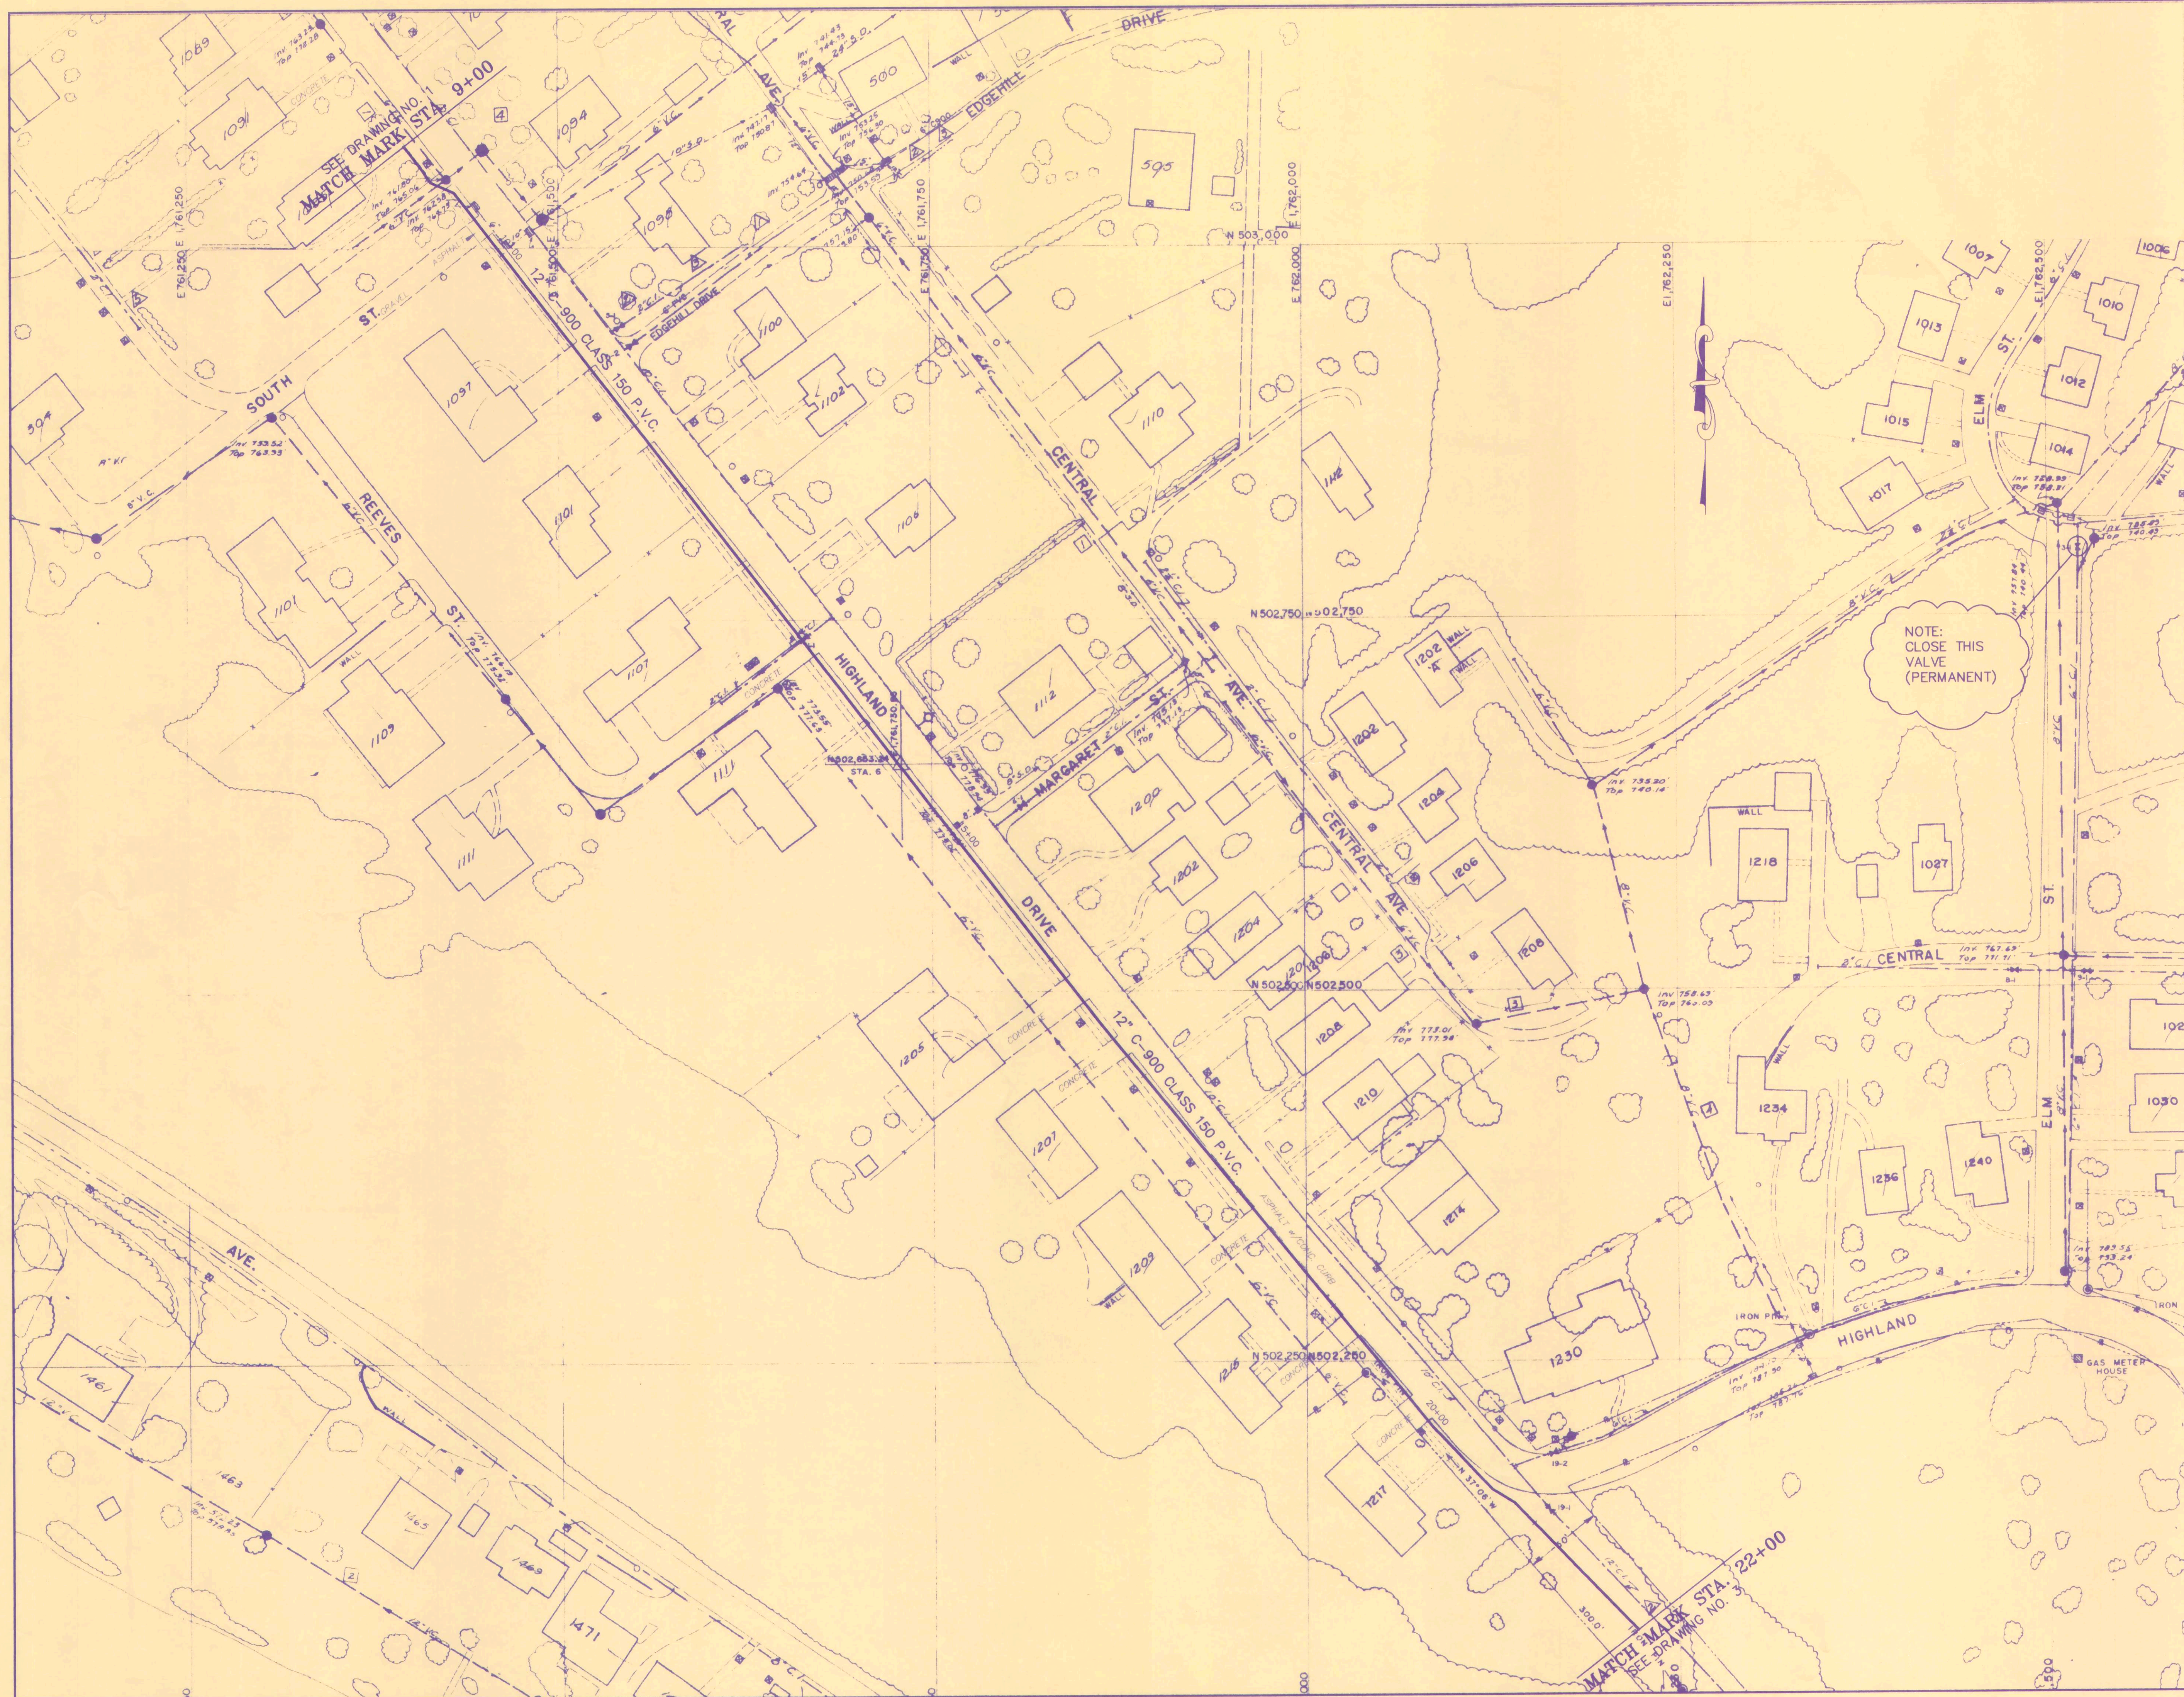

DRAWING INDEX

SCALE: N.T.S.

NOTE:
CLOSE THIS
VALVE
(PERMANENT)

NOTE:
WHERE PROPOSED WATER LINE PARALLELS EXISTING
SEWER A MINIMUM SEPARATION BETWEEN POTABLE
WATER AND SANITARY SEWER OF 10' HORIZONTAL
OR 18" VERTICAL MUST BE KEPT.

NO.	DATE	DESCRIPTION	
REVISIONS			
CITY OF ST. ALBANS MUNICIPAL UTILITY COMMISSION			
HIGHLAND DRIVE PRESSURE GRADIENT MODIFICATIONS			
DRAWN BY: DP/JEH		CHECKED BY: FWH	
SCALE: 1" = 50'		DATE: AUGUST 1997	
		DRAWING 96.31 2	
		DUNN ENGINEERS, INC. 701 VIRGINIA ST. WEST CHARLESTON, W.V. 25302	